

**Appendix F**  
**Utility Plans and Correspondence**

## HWY 50 REGION OF PEEL --- UTILITY CONTACT LIST

Utility / Agency	Contact	Contact Info
City of Vaughan 2141 Major Mackenzie Drive Vaughan, Ontario L6A 1T1	Michael Frieri	Tel: 905.832.8585 ext. 8729
City of Brampton Planning Design and development Dept 2 Wellington Street West., 3rd Floor Brampton, ON L6Y 4R2	Attn: Philip	Tel: 905-874-2522 Fax: 905-874-2499 <a href="mailto:mike.colangelo@brampton.ca">mike.colangelo@brampton.ca</a>
York Region 17250 Yonge Street, Newmarket, Ontario, L3Y 6Z1	Environmental Services	Tel: 905.895.1231 Ext. 5931  <a href="mailto:EnvironmentalServices@york.ca">EnvironmentalServices@york.ca</a>
Peel Region Operations and Maintenance 2 Copper Road Brampton, ON L6T 4W5	Attn: Robert Perkins	Tel: 905-791-5997 X 3221 Fax: 905-450-0288 <a href="mailto:Robert.Perkins@peelregion.ca">Robert.Perkins@peelregion.ca</a>
Bell Canada Municipal Operations Centre C/O Plantec 610 Alden Road., Suite 201 Markham, ON L3R 9Z1	Attn: Sharmila Kumar For utility conflict issues contact the following offices <b>Chris Seaton</b> 5115 Creebank Rd. 3 West Mississauga, ON L4W 5R1  <b>Maureen Marshall</b> Kleinburg Cables 444 Millard Ave. Floor 2 Newmarket, ON L3Y 2A3	Tel: 905-470.2112 <a href="mailto:sharmila.kumar@prestigetel.com">sharmila.kumar@prestigetel.com</a> Send markups to – <a href="mailto:bell.moc@prestigetel.com">bell.moc@prestigetel.com</a>
Hydro One Brampton Network 175 Sandalwood Parkway West Brampton, ON L7A 1E8	Attn: Emil Sampaga	Tel: 905-840-6300 X 3355 Fax: <a href="mailto:esampaga@hydroonebrampton.com">esampaga@hydroonebrampton.com</a>
Rogers Cable TV 3573 Wolfedale Road Mississauga, ON L5C 3T6	Attn: Edgar Henriquez	Tel: 905-897-6457 Fax: <a href="mailto:edgar.henriquez@rci.rogers.com">edgar.henriquez@rci.rogers.com</a>
Enbridge Gas Distribution Record Department Post A2, P.O. Box 650 Scarborough, ON M1K 5E3  Enbridge Gas Distribution Inc. 500 Consumers Road 4th Floor North York, ON M2J 1P8	Attn: Bruno Pereira Or  Jamie Delaney – 416-495- 5160 (press 3, 1 for Jamie Delaney) <a href="mailto:markups@enbridge.com">markups@enbridge.com</a>	Bruno - Tel: 416-758-7906 Fax: 416-758-4373 <a href="mailto:utilitycirculations@enbridge.com">utilitycirculations@enbridge.com</a>
FCI Broadband Now Rogers Cable 280 Hillmount Road., Unit 9 Markham, ON L6C 3A1 In the GTA FCI Broadband is owned by Rogers Cable	Attn: Edgar Henriquez	Tel: 905-897-6457 Fax: <a href="mailto:edgar.henriquez@rci.rogers.com">edgar.henriquez@rci.rogers.com</a>
MTS Allstream 50 Worchester Road Etobicoke, ON M9W 5X2	Attn: Christine Anderson <b>Cory Knight</b>	Tel: 416-649-7527 Fax: 416-649-7500 <b>Cory K. Tel: 416-649-7509</b> <a href="mailto:christine.anderson@mtsallstream.com">christine.anderson@mtsallstream.com</a> <a href="mailto:correy.knight@mtsallstream.com">correy.knight@mtsallstream.com</a> <a href="mailto:utility.circulations@mtsallstream.com">utility.circulations@mtsallstream.com</a>
Hydro One Telecom 65 Kelfield Street Rexdale, ON M9W 5A3	Attn: Ian Mitchell	Tel: 416-240-6701 Fax: 416-240-6790 <a href="mailto:ian.mitchell@hydroone.com">ian.mitchell@hydroone.com</a>
Telus Network 2700 Matheson Blvd East 5th Floor, West Tower Mississauga, ON L4W 4V9  Telus Communications 82 Locust Street Kitchener, ON N2H 1W9	Stephen Hoy  Bob Quick	Tel: 905-804-6223 Fax: 905-804-6104 <a href="mailto:Stephen.hoy@telus.com">Stephen.hoy@telus.com</a>

## Noss, Melissa

---

**From:** Agnew, Tim [Tim.Agnew@york.ca]  
**Sent:** Wednesday, September 07, 2011 2:15 PM  
**To:** Baudais, Nathalie  
**Cc:** Chiu, Edward; Servera, Vinor  
**Subject:** RE: Project #4956 - Highway 50 Road Widening  
**Attachments:** 020.zip

The zip file:

<<020.zip>>

**Tim Agnew, BSc. (Phys.)**  
*Special Projects Technologist  
Infrastructure & Business Management  
Strategy & Business Planning  
Environmental Services Department  
The Regional Municipality of York  
17250 Yonge Street  
Newmarket, ON L3Y 6Z1  
Phone 905-830-4444 ext. 5122  
Toll Free 1-877-464-9675  
Fax 905-952-0982  
e-mail [tim.agnew@york.ca](mailto:tim.agnew@york.ca)*

---

**From:** Agnew, Tim  
**Sent:** Wednesday, September 07, 2011 2:02 PM  
**To:** 'nathalie.baudais@hdrinc.com'  
**Cc:** Chiu, Edward; Servera, Vinor  
**Subject:** Project #4956 - Highway 50 Road Widening

Hi Nathalie,

Attached is a zip file containing plan & profile drawings of all York Region's water/wastewater infrastructure located within the study area.


***The Region of York is not responsible for the accuracy, sufficiency or interpretation of the information on the drawing. This plan is provided for information only. Accuracy of measurements is not guaranteed and should be verified in the field.***

If you have any questions or would like additional drawings please do not hesitate to contact me.

Thanks,

**Tim Agnew, BSc. (Phys.)**  
*Special Projects Technologist  
Infrastructure & Business Management  
Strategy & Business Planning  
Environmental Services Department  
The Regional Municipality of York  
17250 Yonge Street  
Newmarket, ON L3Y 6Z1  
Phone 905-830-4444 ext. 5122  
Toll Free 1-877-464-9675*

# YORK-PEEL FEEDERMAIN PROJECT

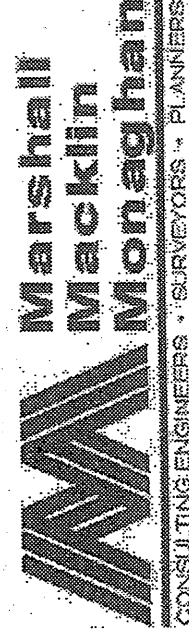


CONSULTING ENGINEERS • SURVEYORS • PLANNERS



EARTH TECH


Markham, Ontario 905.886.7022

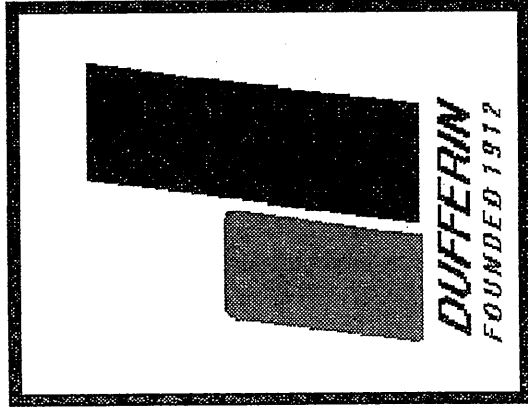

FOUNDED 1912

## AIRPORT ROAD, HUMBER WEST PARKWAY AND CASTLEMORE ROAD

### FEEDERMAIN SHEET INDEX

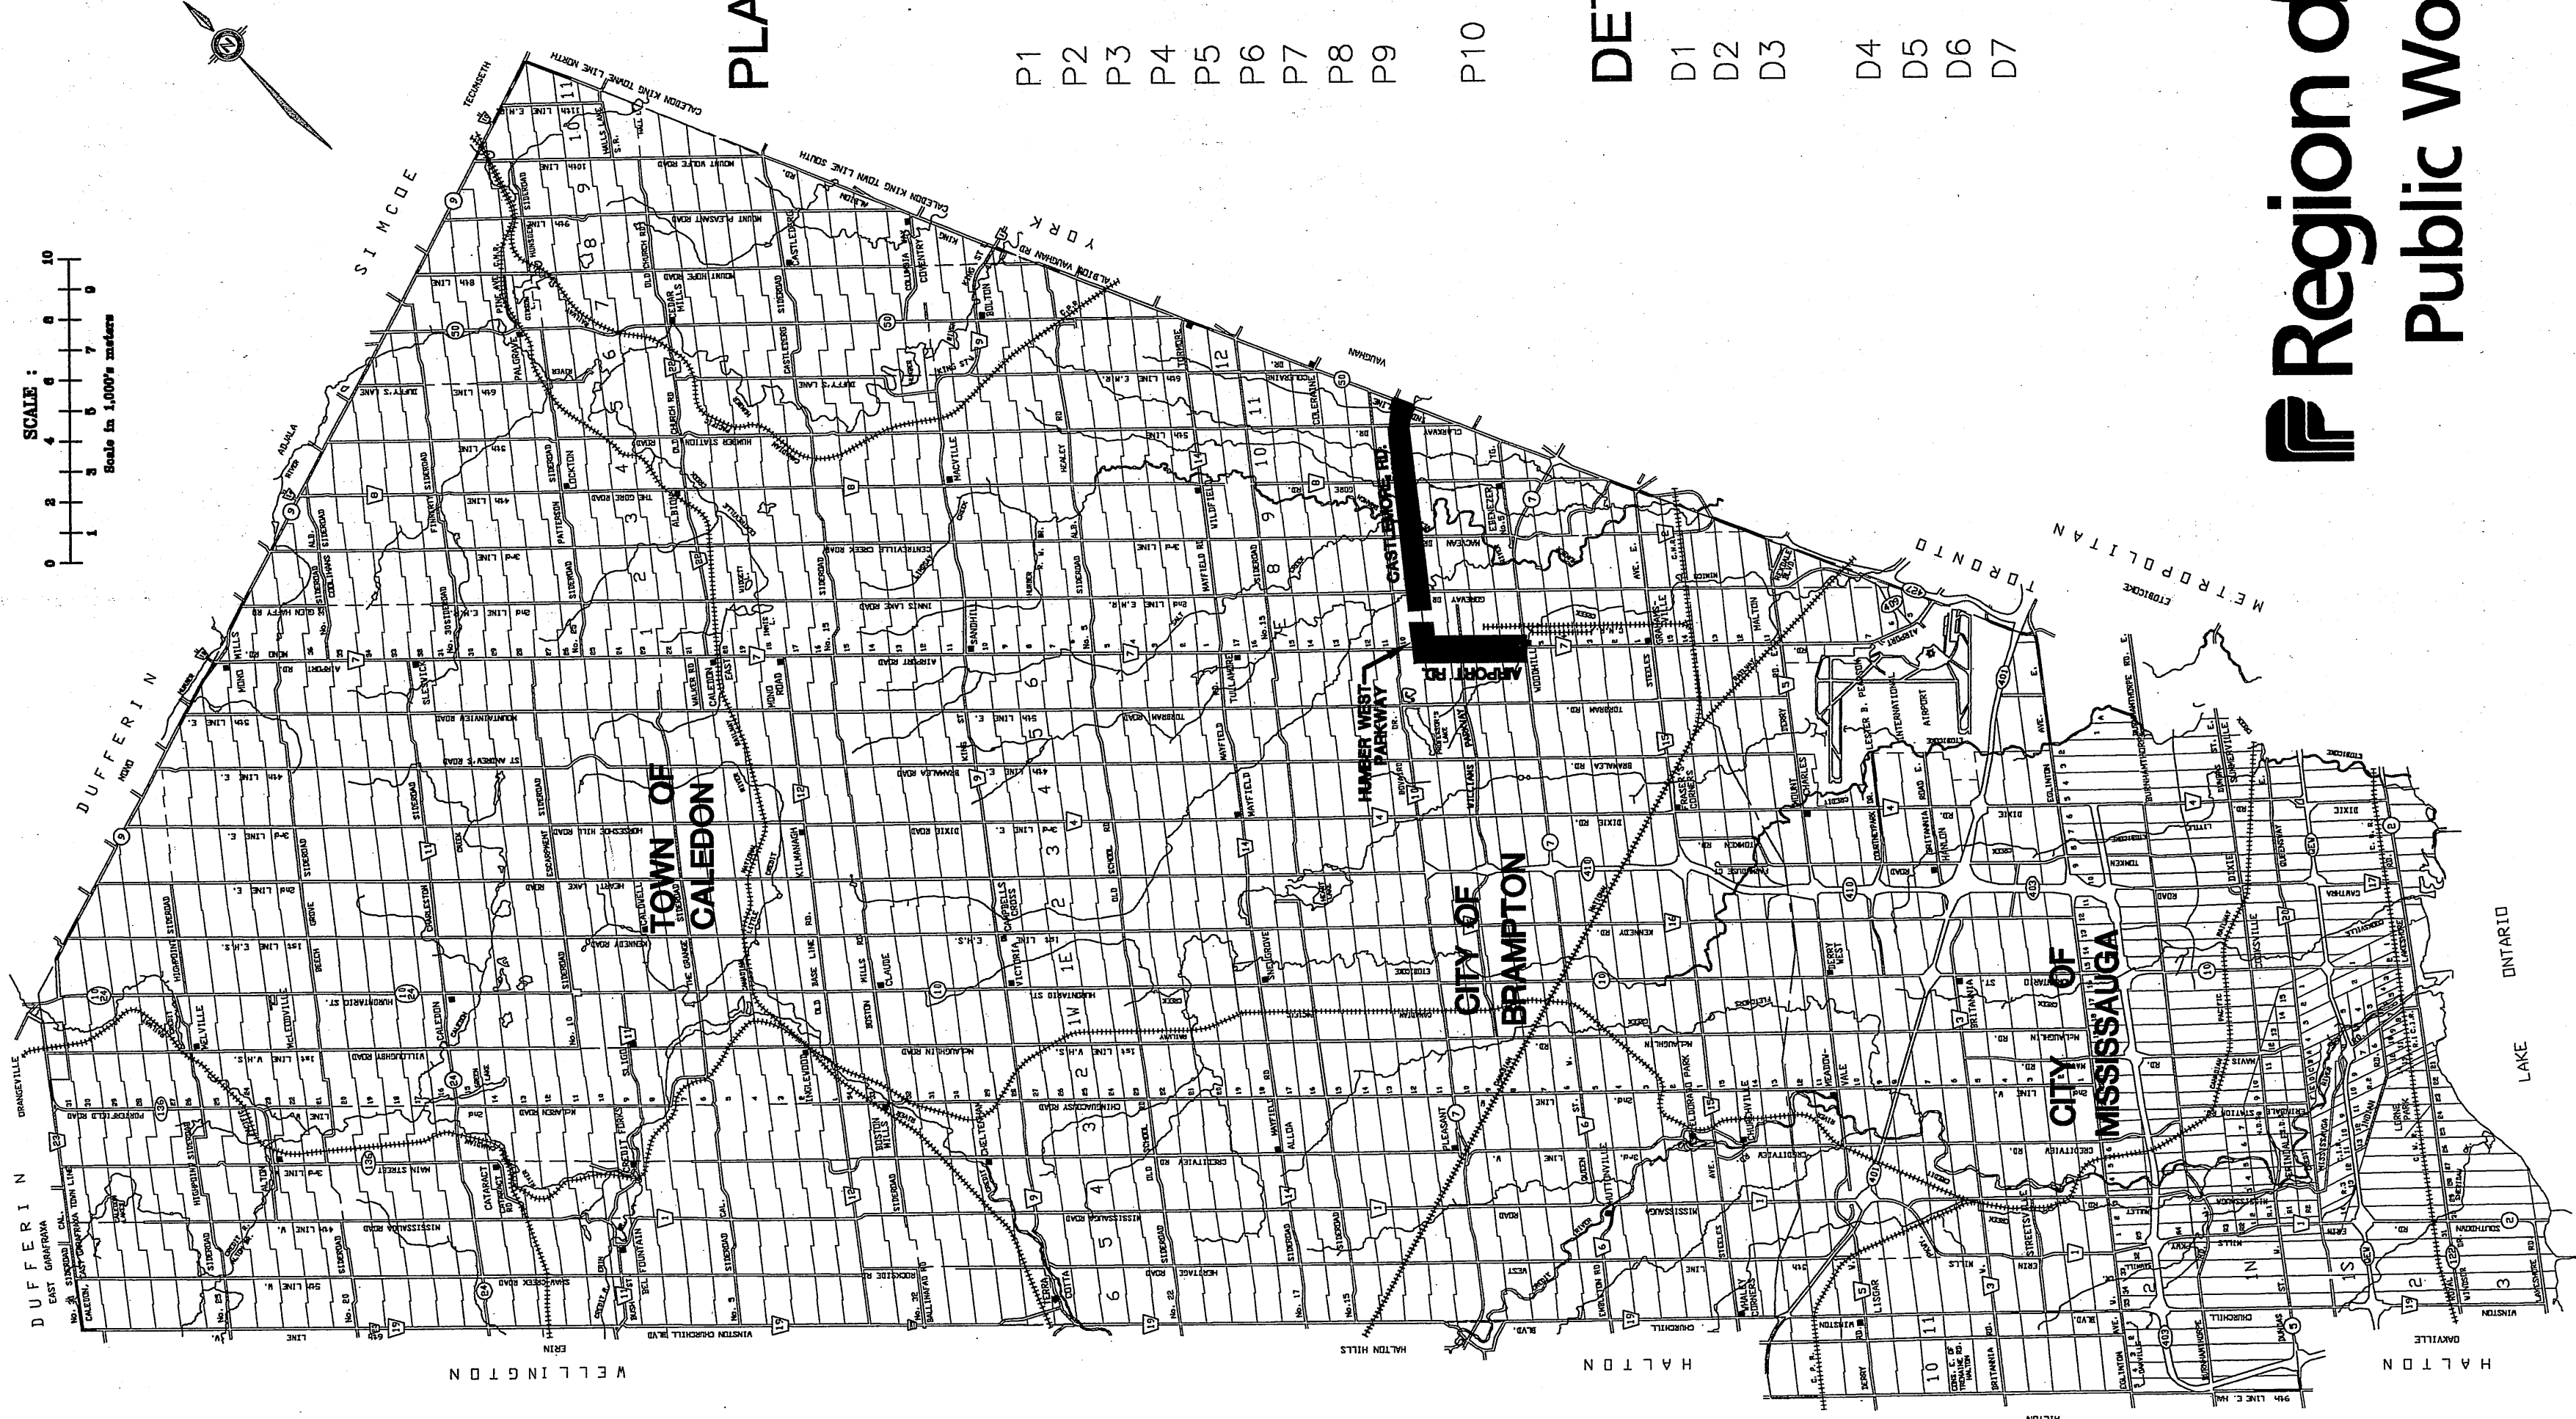

#### PLAN AND PROFILES

**AIRPORT ROAD 2100Ø:**  
FROM QUEEN STREET TO  
AIRPORT ROAD RESERVOIR

- P1 STA. 0+000 TO 0+200 - AIRPORT ROAD
- P2 STA. 0+200 TO 0+480 - AIRPORT ROAD
- P3 STA. 0+480 TO 0+760 - AIRPORT ROAD
- P4 STA. 0+760 TO 1+040 - AIRPORT ROAD
- P5 STA. 1+040 TO 1+320 - AIRPORT ROAD
- P6 STA. 1+320 TO 1+600 - AIRPORT ROAD
- P7 STA. 1+600 TO 1+840 - AIRPORT ROAD
- P8 STA. 1+840 TO 2+100 - AIRPORT ROAD
- P9 STA. 2+100 TO 2+360 - AIRPORT ROAD AND EASEMENT
- P10 STA. 2+360 TO 2+640.829 - EASEMENT

#### DETAILS

- D1 DRAIN VALVE CHAMBER
- D2 AIR RELEASE CHAMBER
- D3 LINE VALVE CHAMBER - PLAN AND BELOW GRADE
- D4 LINE VALVE CHAMBER - SECTIONS
- D5 FLOWMETER CHAMBER
- D6 LINE VALVE INDEX
- D7 DETAILS

**HUMBER WEST PARKWAY 1800Ø:**

- P11 STA. 0+000 TO 0+180 - NORTH PARK DRIVE EXTENSION
- P12 STA. 0+180 TO 0+460 - HUMBER WEST PARKWAY
- P13 STA. 0+460 TO 0+700 - HUMBER WEST PARKWAY
- P14 STA. 0+700 TO 0+877.196 - HUMBER WEST PARKWAY

**CASTLEMORE ROAD 1800Ø:**  
FROM GOREWAY DRIVE TO  
HIGHWAY 50

- P15 STA. 0+000 TO 0+260 - CASTLEMORE ROAD
- P16 STA. 0+260 TO 0+540 - CASTLEMORE ROAD
- P17 STA. 0+540 TO 0+820 - CASTLEMORE ROAD
- P18 STA. 0+820 TO 1+100 - CASTLEMORE ROAD
- P19 STA. 1+100 TO 1+380 - CASTLEMORE ROAD
- P20 STA. 1+380 TO 1+660 - CASTLEMORE ROAD
- P21 STA. 1+660 TO 1+940 - CASTLEMORE ROAD
- P22 STA. 1+940 TO 2+200 - CASTLEMORE ROAD
- P23 STA. 2+200 TO 2+500 - CASTLEMORE ROAD
- P24 STA. 2+500 TO 2+780 - CASTLEMORE ROAD
- P25 STA. 2+780 TO 3+060 - CASTLEMORE ROAD
- P26 STA. 3+060 TO 3+340 - CASTLEMORE ROAD
- P27 STA. 3+340 TO 3+620 - CASTLEMORE ROAD
- P28 STA. 3+620 TO 3+900 - CASTLEMORE ROAD
- P29 STA. 3+900 TO 4+180 - CASTLEMORE ROAD
- P30 STA. 4+180 TO 4+460 - CASTLEMORE ROAD
- P31 STA. 4+460 TO 4+740 - CASTLEMORE ROAD
- P32 STA. 4+740 TO 4+899.188 - CASTLEMORE ROAD

#### EROSION CONTROL DRAWINGS

- ER1 EROSION CONTROL DETAILS
- ER2 EROSION CONTROL DETAILS - CROSSING METHODS
- ER3 PLANTING DETAILS AND BANK RESTORATION
- ER4 CROSSING C19 METHOD RESTORATION
- ER5 CROSSING C17 METHOD RESTORATION

#### STRUCTURAL DRAWINGS

- S0 SPECIFICATIONS & TYPICAL DETAILS
- S1 LINE VALVE CHAMBER DETAILS
- S2 LINE VALVE CHAMBER DETAILS

#### LANDSCAPE / RESTORATION PLAN DRAWINGS


- P1-L AIRPORT ROAD - STA 0+000 TO 0+200
- P13-L HUMBER WEST PARKWAY - STA. 0+460 TO 0+700
- P14C-L HUMBER WEST PARKWAY - STA 0+700 TO 0+877.196
- P14-L HUMBER WEST PARKWAY - STA 0+700 TO 0+877.196
- P20-L CASTLEMORE ROAD - STA 1+380 TO 1+660
- P21-L CASTLEMORE ROAD - STA 1+660 TO 1+940
- P22-L CASTLEMORE ROAD - STA 1+940 TO 2+220
- P24-L CASTLEMORE ROAD - STA 2+500 TO 2+780
- P27-L CASTLEMORE ROAD - STA 3+340 TO 3+620
- P28-L AIRPORT ROAD - STA 0+000 TO 0+200
- P31-L CASTLEMORE ROAD - STA 4+460 TO 4+740
- P32-L CASTLEMORE ROAD - STA 4+740 TO 4+899.188



SERVICE DATA		
SERVICE	DATE	INIT.
SAN SEWERS		
GAS MAINS		
BELL 1/2 CABLE		
HYDRO 1/2 CABLE		
HYDRO		
PARKS & REC.		
INT. CLEAN WATER		

REVISIONS		
NO.	DATE	DETAILS
1	APR. 11, 03	PRELIMINARY DESIGN FOR RFP SUBMISSION
2	OCT. 24, 03	100% SUBMISSION - NOT FOR CONSTRUCTION
3	MAR. 01, 04	100% SUBMISSION - NOT FOR CONSTRUCTION
4	MAY 15, 04	REVISED PER COMMENTS
5	APR. 28, 04	P.I. NO. C93 AND C94 MODIFIED
6	JUNE 23, 04	KMK COMMENTS

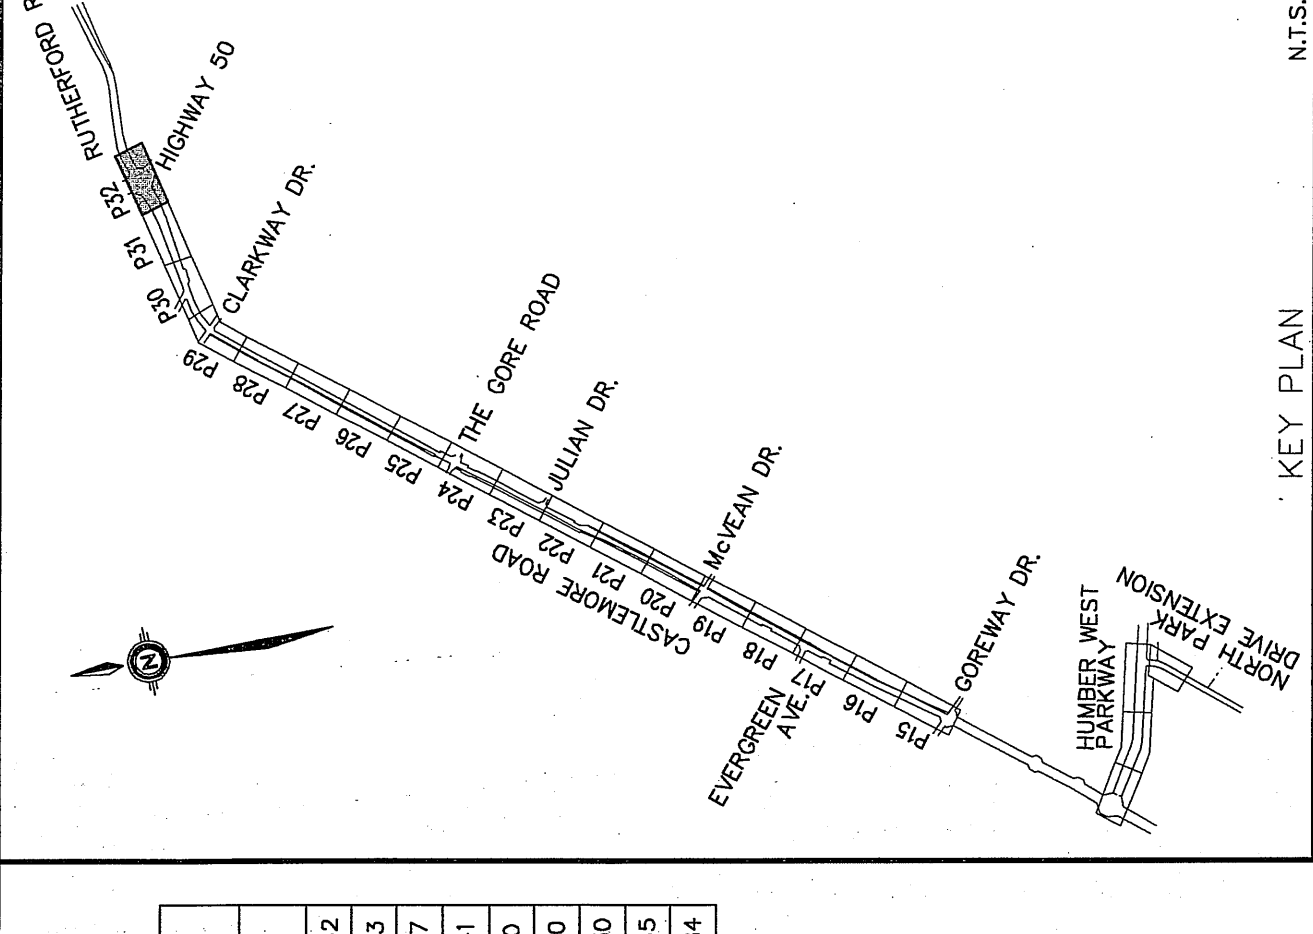


NOTES  
 All dimensions and elevations are in metres unless otherwise noted.  
 Pipe sizes are in millimetres.  
 Restrained joints to be used to resist thrust.  
 Forces at all bends, elbows and tees as indicated on drawings.  
 Topsoil to be removed and replaced with approved topsoil.  
 Contractor is responsible for locating and protecting all utilities during construction. Gas, Hydro and Telephone or other utilities shall be located and marked by the contractor by his own agencies and verified prior to construction.  
 Refer to P.I. Layout Information on this sheet.  
 BENCHMARKS REFER TO LIST OF BENCHMARKS ON INDEX SHEET.  
 N.T.S.

**NOTICE TO CONTRACTOR**  
 48 HOURS PRIOR TO COMMENCING WORK NOTIFY THE FOLLOWING:  
 THE REGIONAL MUNICIPALITY OF PEEL  
 CITY OF MISSISSAUGA WORKS DEPT.  
 CITY OF BRAMPTON WORKS DEPT.  
 TOWN OF CALEDON WORKS DEPT.  
 MISSISSAUGA GAS COMPANY  
 CONSUMERS GAS COMPANY  
 MINISTRY OF TRANSPORTATION  
 ONTARIO CLEAN WATER AGENCY  
 ONTARIO HYDRO  
 HYDRO ELECTRIC POWER COMM. CITY OF MISSISSAUGA  
 HYDRO ELECTRIC POWER COMM. CITY OF BRAMPTON  
 CABLE TELEVISION


**York Peel Design Build**  
**EARTH**  
**URS**  
 166 Commerce Valley Dr. West, Markham, Ontario  
 (905) 784-4300

PROJECT NO.	02-1970D
DRAWN BY	J.S.
CHECKED BY	J.S.
DATE	
SHEET	OF
PLAN NO.	P32
CHAINAGE	


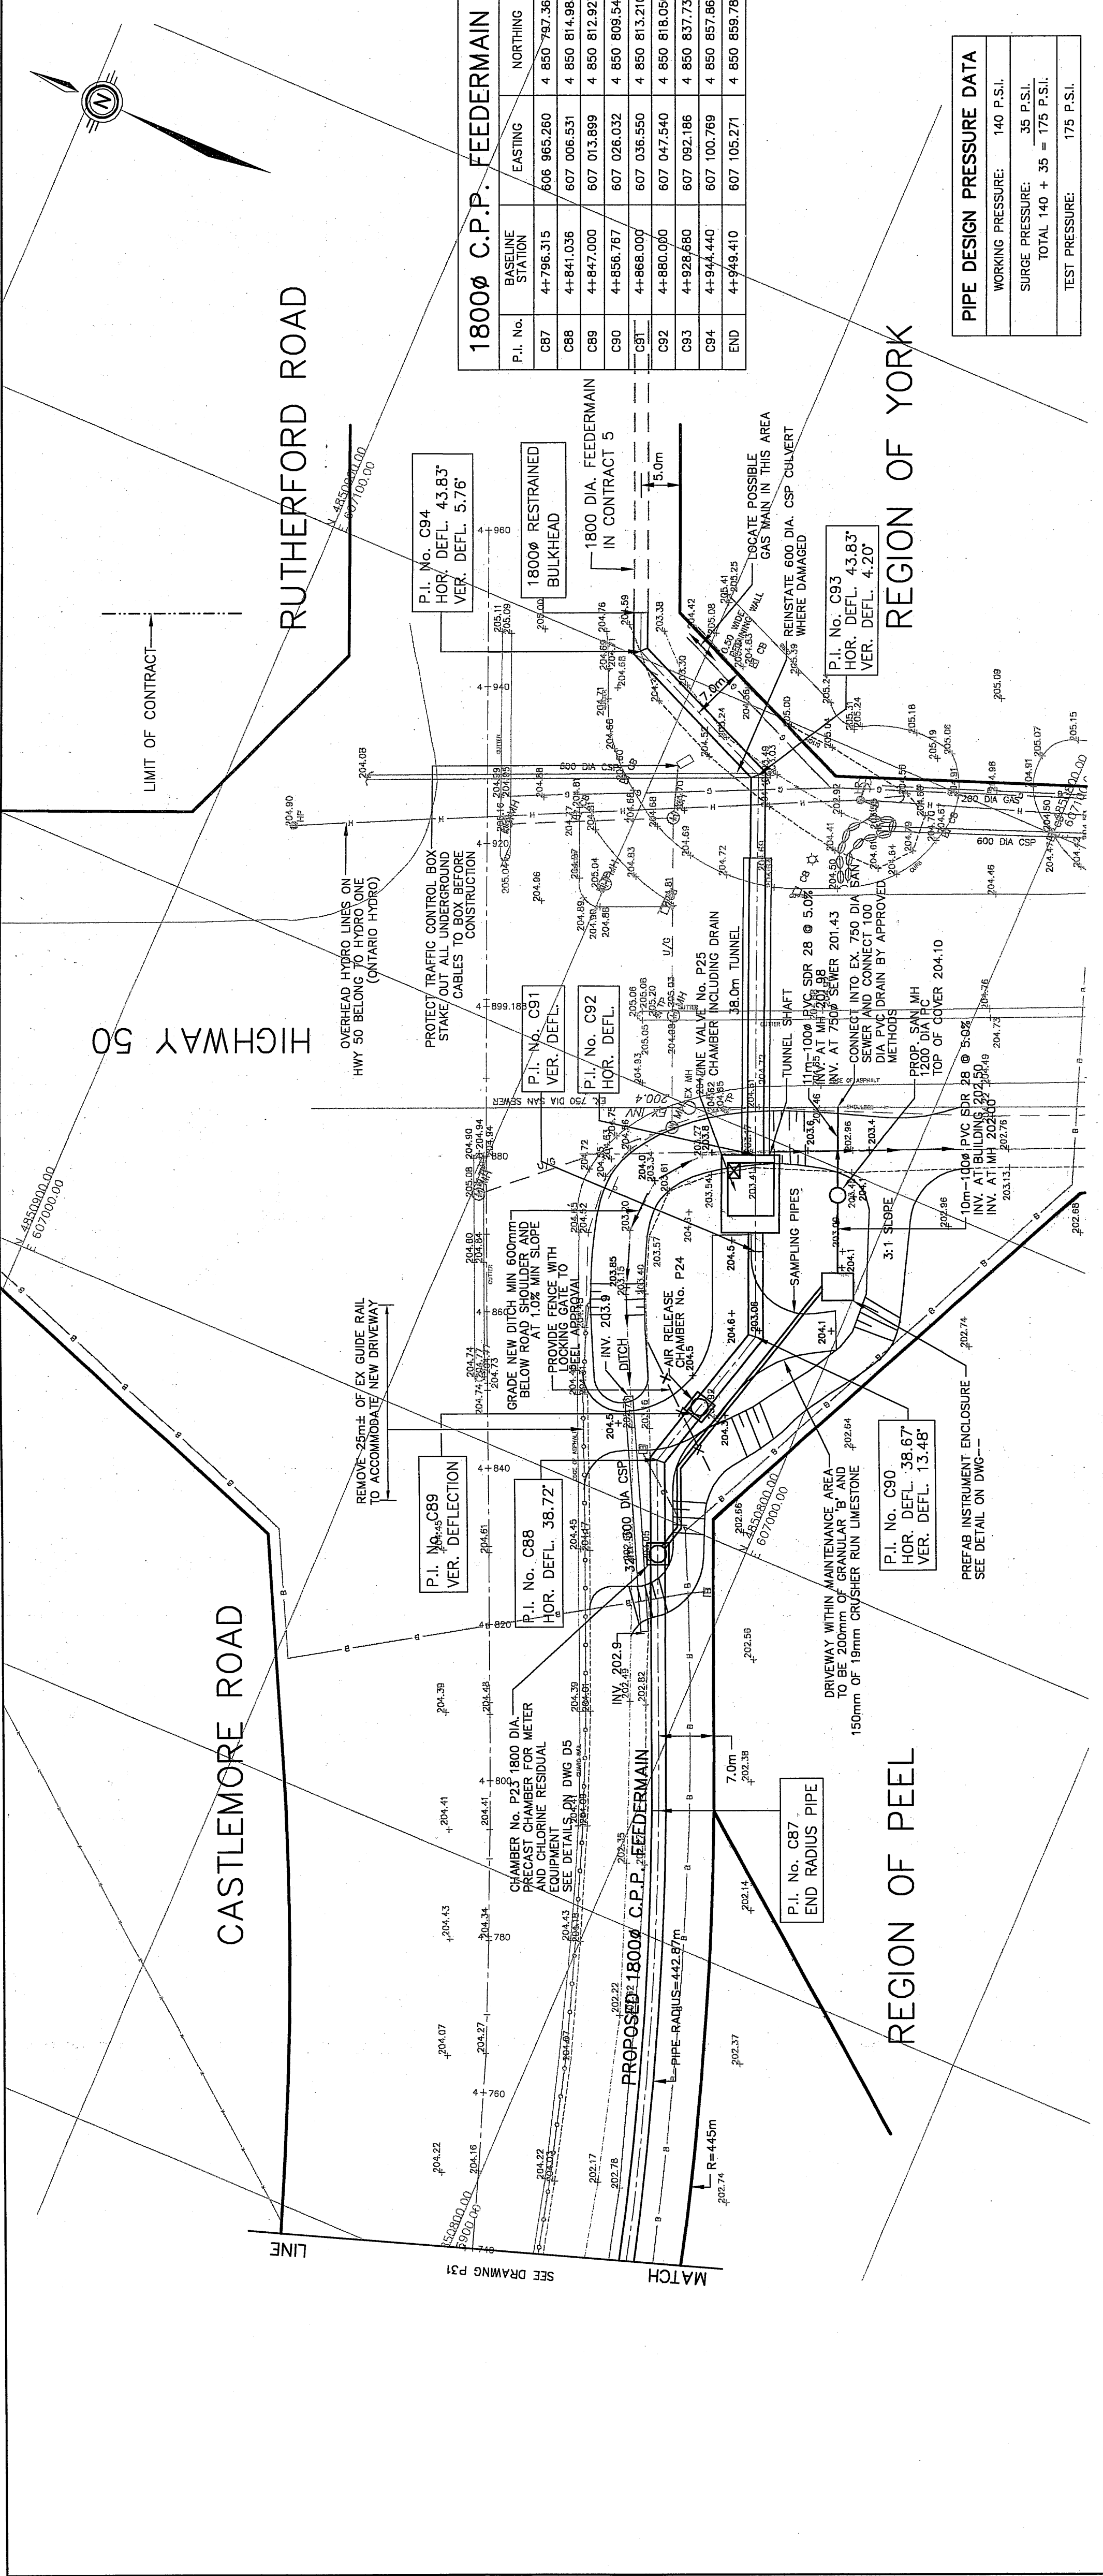


1800Ø C.P.P. FEEDERMAIN			
P.I. No.	BASILINE STATION	EASTING	NORTHING
C87	4+796.315	608 965.260	4 850 787.362
C88	4+844.036	607 006.531	4 850 814.983
C89	4+847.000	607 013.899	4 850 812.927
C90	4+856.767	607 026.032	4 850 809.541
C91	4+868.000	607 036.550	4 850 813.210
C92	4+880.000	607 047.540	4 850 818.050
C93	4+929.680	607 092.186	4 850 837.730
C94	4+944.440	607 100.769	4 850 857.865
END	4+949.410	607 105.271	4 850 859.784

PIPE DESIGN PRESSURE DATA		
WORKING PRESSURE:	140 P.S.I.	
SURGE PRESSURE:	35 P.S.I.	
TOTAL 140 + 35 =	175 P.S.I.	
TEST PRESSURE:	175 P.S.I.	

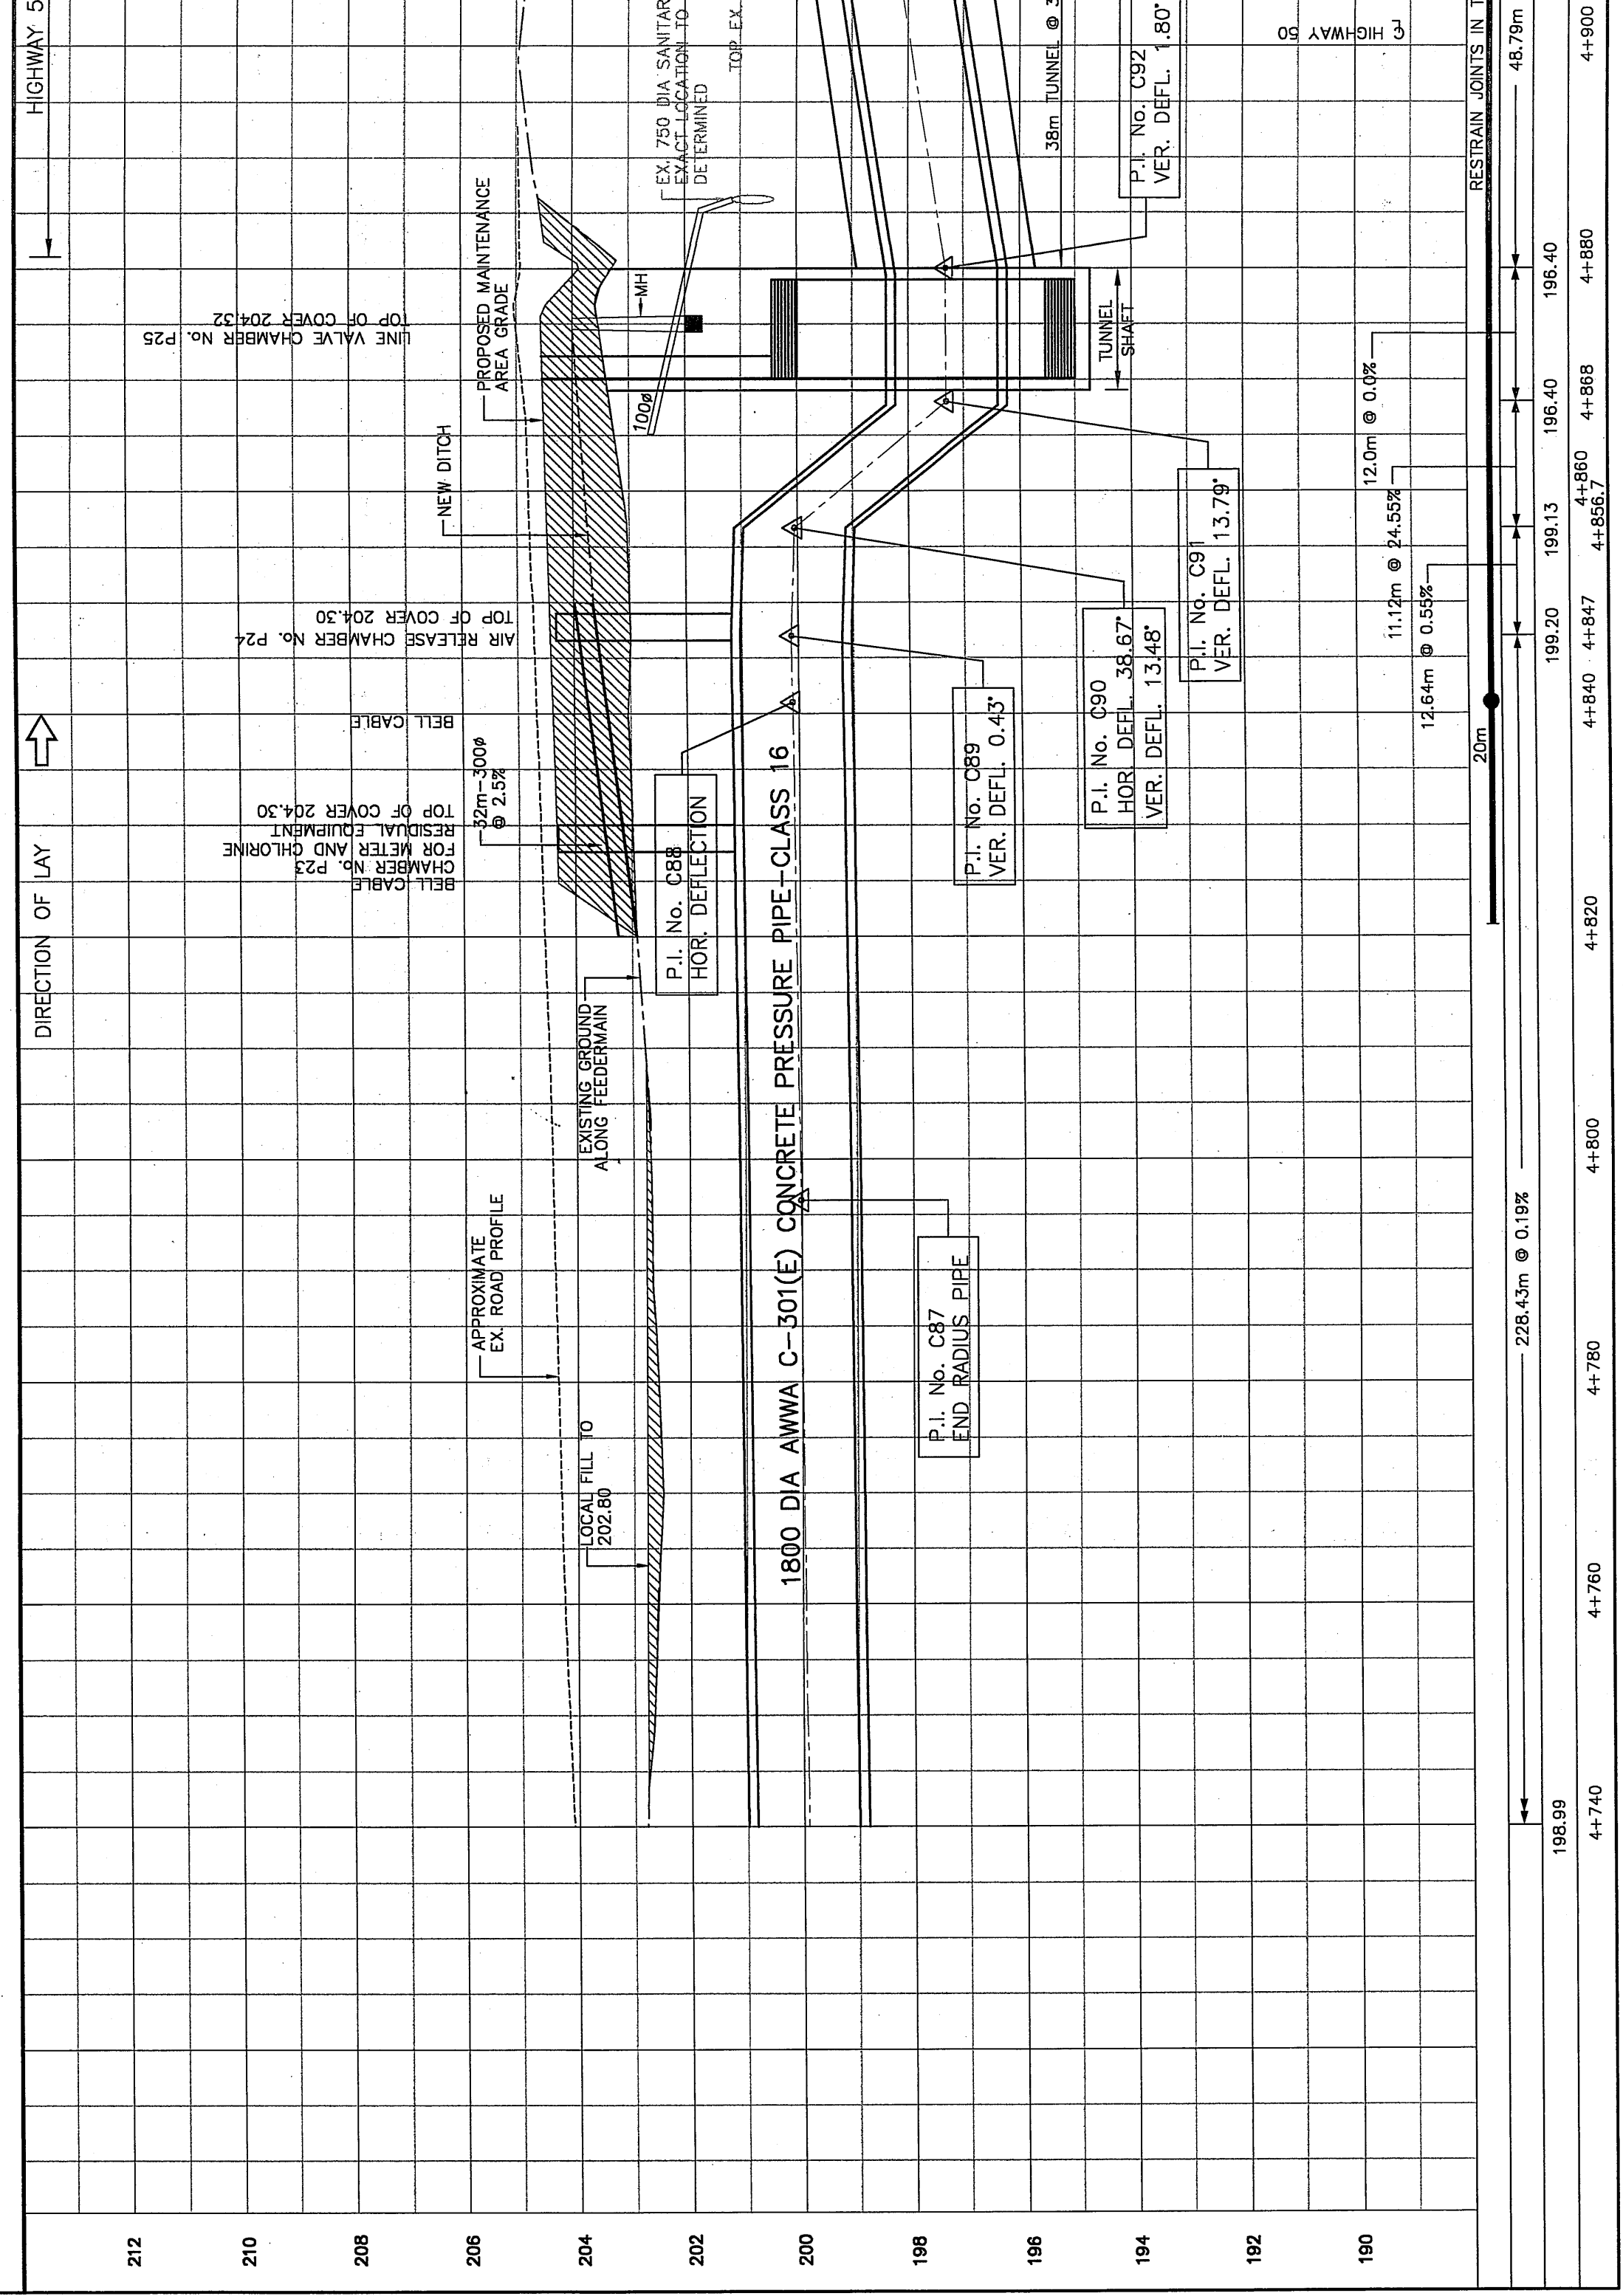

RESTRAINED JOINT LENGTHS	PLAN LENGTH & SLOPE	INV. EL. OF WM.	CHAINAGE
			188.99
			4+760
			4+780
			4+800
			4+820
			4+840
			4+860
			4+880
			4+900
			4+920
			4+940
			4+960

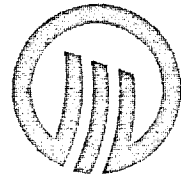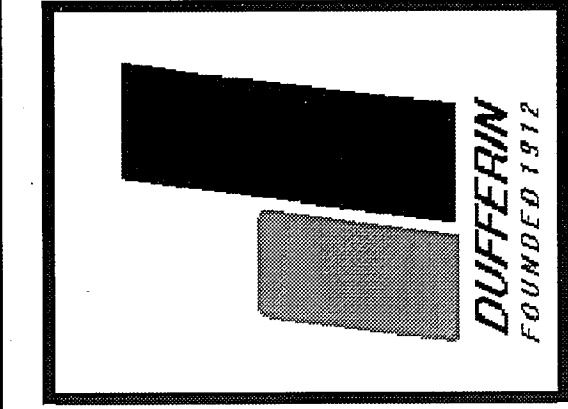

EarthTech  
A Tyco International Ltd. Company

URS

Marshall  
Macklin  
Monaghan  
CONSULTING ENGINEERS - SURVEYORS - PLANNERS

METRIC

# YORK-PEEL FEEDERMAIN PROJECT AS-BUILT RUTHERFORD ROAD, WESTON ROAD, BLOCK 33 & TESTON ROAD

## FEEDERMAIN SHEET INDEX

### PLAN AND PROFILES

#### RUTHERFORD ROAD 1800Ø: FROM C.P.R. TO 200m WEST OF NAPA VALLEY DRIVE

- P1 STA. 0+000 TO 0+200
- P2 STA. 0+200 TO 0+500
- P3 STA. 0+500 TO 0+800
- P4 STA. 0+800 TO 1+100
- P5 STA. 1+100 TO 1+400
- P6 STA. 1+400 TO 1+700
- P7 STA. 1+700 TO 2+000
- P8 STA. 2+000 TO 2+300
- P9 STA. 2+300 TO 2+600
- P10 STA. 2+600 TO 2+900
- P11 STA. 2+900 TO 3+100
- P12 STA. 3+100 TO 3+280
- P13 STA. 3+280 TO 3+460
- P14 STA. 3+460 TO 3+660
- P15 STA. 3+660 TO 3+940
- P16 STA. 3+940 TO 4+190±

#### WESTON ROAD 1800Ø: FROM RUTHERFORD ROAD TO 480m NORTH OF MAJOR MACKENZIE DRIVE

- P17 STA. 20+000 TO 20+280
- P18 STA. 20+280 TO 20+580
- P19 STA. 20+580 TO 21+880
- P20 STA. 20+880 TO 21+180
- P21 STA. 21+180 TO 21+480
- P22 STA. 21+480 TO 21+780
- P23 STA. 21+780 TO 22+080
- P24 STA. 22+080 TO 22+380
- P25 STA. 21+380 TO 21+680

#### BLOCK 33 1800Ø: STREET 'E' AND STREET 'A' FROM WESTON ROAD TO TESTON ROAD

- P26 STA. 22+680 TO 22+980
- P27 STA. 22+980 TO 23+240
- P28 STA. 23+240 TO 23+460
- P29 STA. 23+460 TO 23+760
- P30 STA. 23+760 TO 24+060
- P31 STA. 24+060 TO 24+360
- P32 STA. 24+360 TO 24+660
- P33 STA. 24+660 TO 24+960

#### TESTON ROAD 1800Ø: BLOCK 33 TO KEELE STREET FROM 150m WEST OF HWY 400 TO KEELE STREET

- P34 STA. 24+960 TO 25+260
- P35 STA. 25+260 TO 25+560
- P36 STA. 25+560 TO 25+860
- P37 STA. 25+860 TO 26+140
- P38 STA. 26+140 TO 26+400
- P39 STA. 26+400 TO 26+700
- P40 STA. 26+700 TO 27+000
- P41 STA. 27+000 TO 27+300
- P42 STA. 27+300 TO 27+600
- P43 STA. 27+600 TO 27+900
- P44 STA. 27+900 TO 28+200
- P45-E STA. 0+000 TO 0+220
- P46-E STA. 0+220 TO 0+413.796

### EROSION CONTROL DRAWINGS


- ER1 EROSION CONTROL DETAILS
- ER2 EROSION CONTROL DETAILS - CROSSING METHODS
- ER3 PLANTING DETAILS AND BANK RESTORATION
- ER4 EROSION CONTROL DETAILS

### DETAILS





- D1 AIR RELEASE CHAMBER DETAILS
- D2 DRAIN CHAMBER DETAILS
- D3 1800Ø LINE VALVE CHAMBER - PLAN AT AND BELOW GRADE
- D4 1800Ø LINE VALVE CHAMBER - SECTIONS
- D5 MAPLE RESERVOIR INLET CHAMBER NO. Y21 DETAILS PLAN BELOW GRADE
- D6 MAPLE RESERVOIR INLET CHAMBER NO. Y21 DETAILS PLAN SECTION AND DETAILS
- D7 MAPLE RESERVOIR INLET CHAMBER NO. Y21 DETAILS PLAN ABOVE GRADE AND SECTIONS
- D8 1800Ø LINE VALVE CHAMBER WITH 600Ø OR 750Ø BRANCH PLAN AT AND BELOW GRADE
- D9 1800Ø LINE VALVE CHAMBER WITH 600Ø OR 750Ø BRANCH SECTIONS
- D10 VALVE CHAMBER WITH 750Ø BRANCH PLANS, SECTIONS AND DETAILS- (DELETED)
- D11 VALVE CHAMBER WITH 300Ø BRANCH PLANS, SECTIONS AND DETAILS
- D12 PD7 WATERMAIN - VALVE CHAMBER V1
- D13 PD7 WATERMAIN - VALVE CHAMBER V2
- D14 PD7 WATERMAIN - VALVE CHAMBER V3
- D15 PD7 WATERMAIN - VALVE CHAMBER V4
- D16 PD7 WATERMAIN - VALVE CHAMBER V5, V6, & V7
- D17 DETAILS
- D18 DETAILS
- D19 DETAILS
- D20 DETAILS
- D21 1800Ø LINE VALVE CHAMBER NO. Y3 PLAN BELOW GRADE
- D22 1800Ø LINE VALVE CHAMBER NO. Y3 PLAN AT GRADE
- D23 1800Ø LINE VALVE CHAMBER NO. Y3 PLAN AT AND BELOW GRADE
- D24 1800Ø LINE VALVE CHAMBER NO. Y3 SECTION
- D25 LINE VALVE INDEX
- D26 PRESSURE REDUCING VALVE CHAMBER NO.1
- D27 PRESSURE REDUCING VALVE CHAMBER NO.1
- D28 HUNTERS GLEN GOLF COURSE WATER SERVICE CONNECTION
- S0 SPECIFICATIONS & TYPICAL DETAILS
- S1 AIR RELEASE CHAMBER DETAILS
- S2 DRAIN CHAMBER DETAILS
- S3 1800Ø LINE VALVE CHAMBER - PLAN AT AND BELOW GRADE
- S4 1800Ø LINE VALVE CHAMBER - SECTIONS
- S5A 1800Ø LINE VALVE CHAMBER WITH 750Ø BRANCH AT AND BELOW GRADE
- S5B 1800Ø LINE VALVE CHAMBER WITH 750Ø BRANCH SECTIONS
- S6A 1800Ø LINE VALVE CHAMBER WITH 600Ø BRANCH PLAN AT AND BELOW GRADE
- S6B 1800Ø LINE VALVE CHAMBER WITH 600Ø BRANCH SECTIONS
- S8 VALVE CHAMBER WITH 300Ø BRANCH PLANS, SECTIONS AND DETAILS
- S12 PD7 WATERMAIN - VALVE CHAMBER V1
- S15 PD7 WATERMAIN - VALVE CHAMBER V4
- S21 1800Ø LINE VALVE CHAMBER WITH 600Ø OR 700Ø BRANCH PLAN AT GRADE
- S22 1800Ø LINE VALVE CHAMBER WITH 600Ø OR 750Ø BRANCH SECTIONS AND DETAILS
- S25 KEELE RESERVOIR INLET CHAMBER DETAILS & SECTION
- S26 KEELE RESERVOIR INLET CHAMBER DETAILS & SECTION
- S27 MAPLE RESERVOIR CONNECTION

### STRUCTURAL DRAWINGS

- S0 SPECIFICATIONS & TYPICAL DETAILS
- S1 AIR RELEASE CHAMBER DETAILS
- S2 DRAIN CHAMBER DETAILS
- S3 1800Ø LINE VALVE CHAMBER - PLAN AT AND BELOW GRADE
- S4 1800Ø LINE VALVE CHAMBER - SECTIONS
- S5A 1800Ø LINE VALVE CHAMBER WITH 750Ø BRANCH AT AND BELOW GRADE
- S5B 1800Ø LINE VALVE CHAMBER WITH 750Ø BRANCH SECTIONS
- S6A 1800Ø LINE VALVE CHAMBER WITH 600Ø BRANCH PLAN AT AND BELOW GRADE
- S6B 1800Ø LINE VALVE CHAMBER WITH 600Ø BRANCH SECTIONS
- S8 VALVE CHAMBER WITH 300Ø BRANCH PLANS, SECTIONS AND DETAILS
- S12 PD7 WATERMAIN - VALVE CHAMBER V1
- S15 PD7 WATERMAIN - VALVE CHAMBER V4
- S21 1800Ø LINE VALVE CHAMBER WITH 600Ø OR 700Ø BRANCH PLAN AT GRADE
- S22 1800Ø LINE VALVE CHAMBER WITH 600Ø OR 750Ø BRANCH SECTIONS AND DETAILS
- S25 KEELE RESERVOIR INLET CHAMBER DETAILS & SECTION
- S26 KEELE RESERVOIR INLET CHAMBER DETAILS & SECTION
- S27 MAPLE RESERVOIR CONNECTION

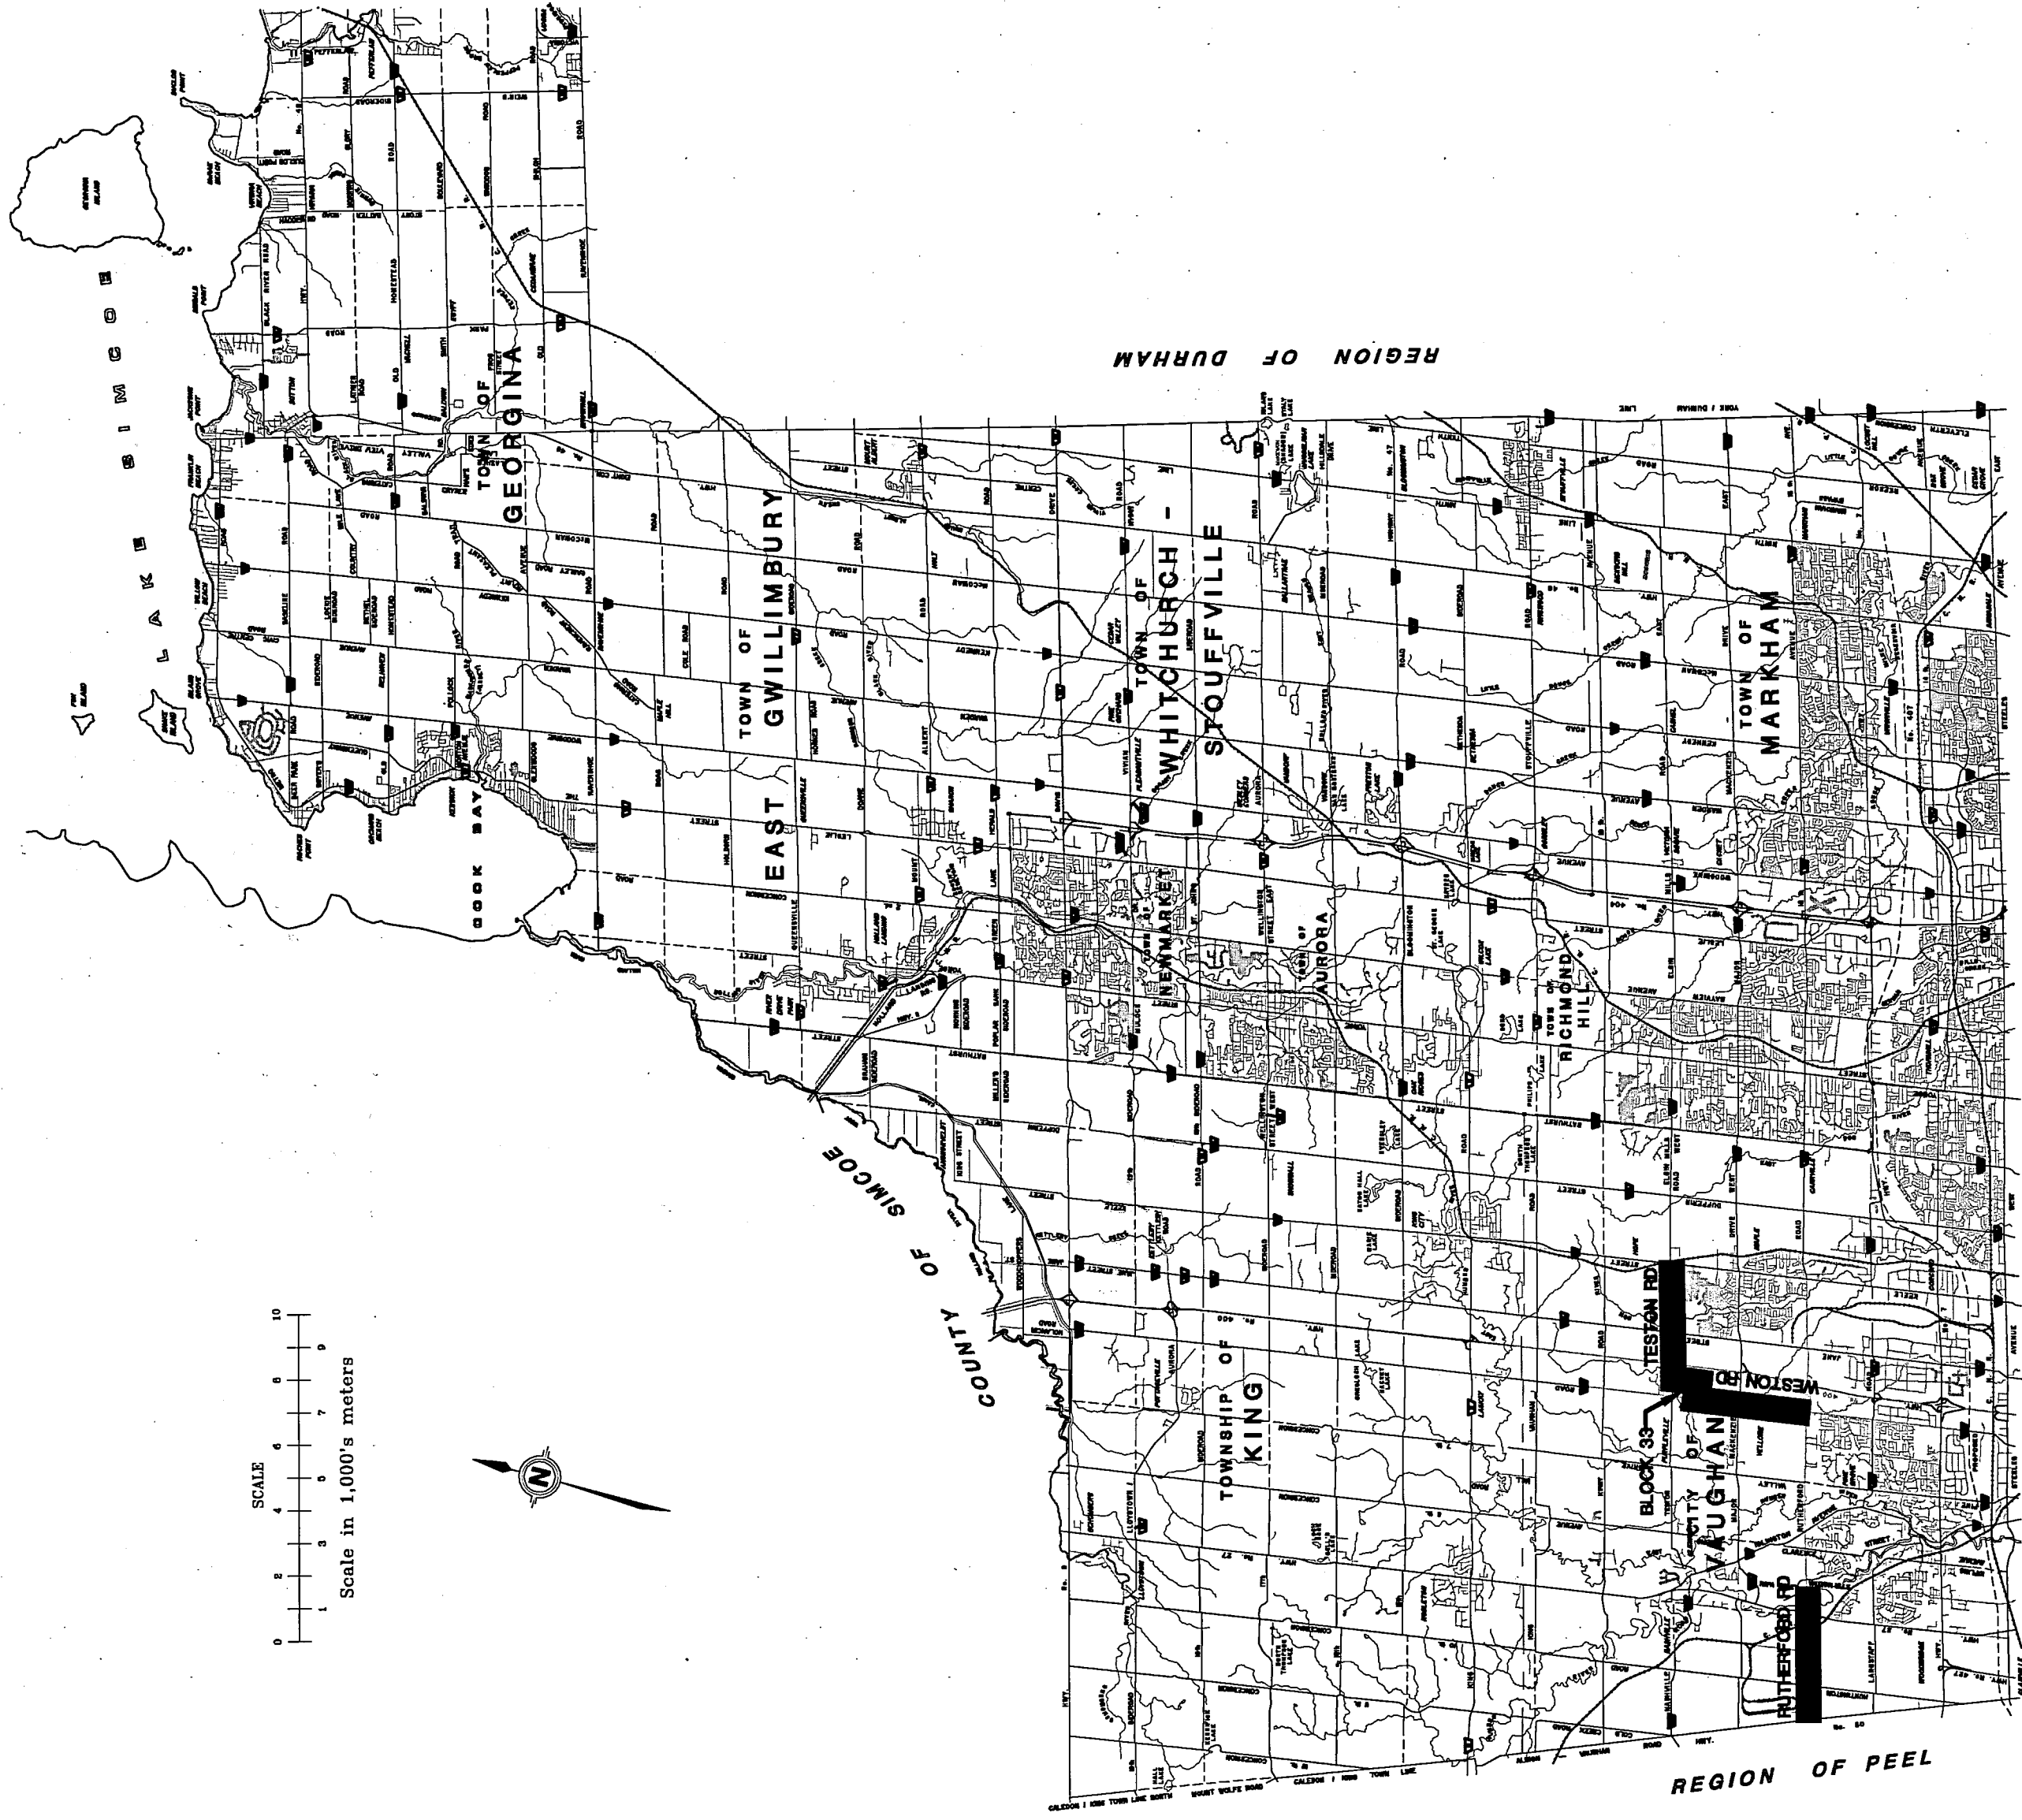

BY	DATE	REVISIONS
J.S.	SEP. 26/03	60% SUBMISSION - NOT FOR CONSTRUCTION
J.S.	DEC. 22/03	85% SUBMISSION - NOT FOR CONSTRUCTION
J.S.	MAR. 2/04	GENERAL REVISIONS
J.B.	MAY/06	AS BUILT

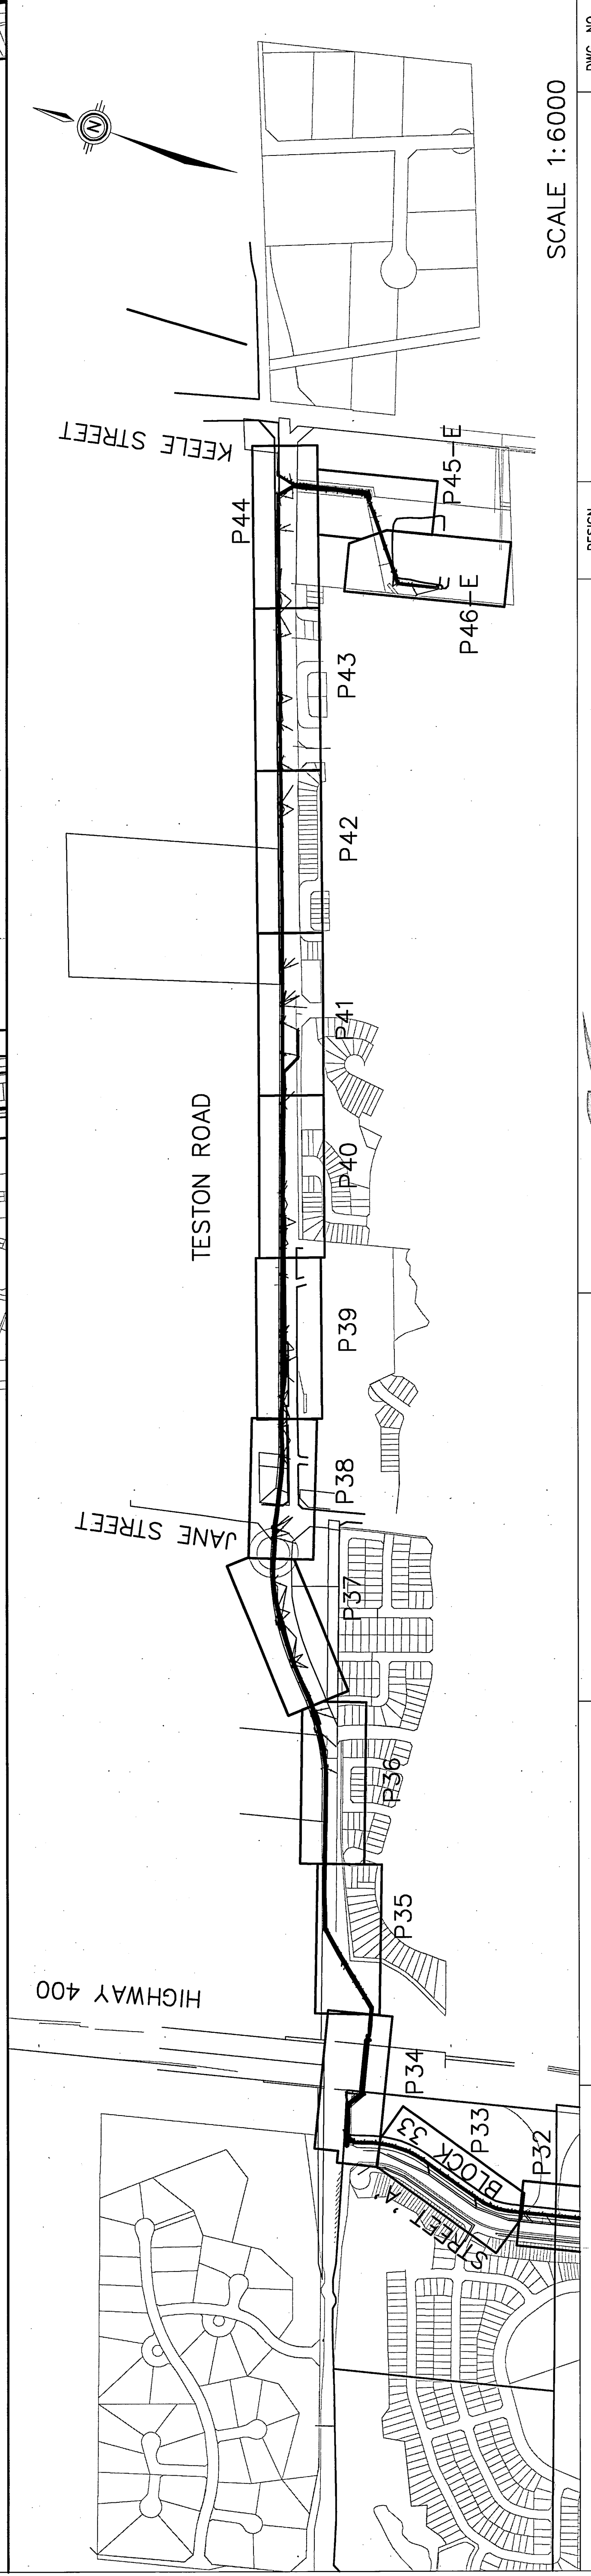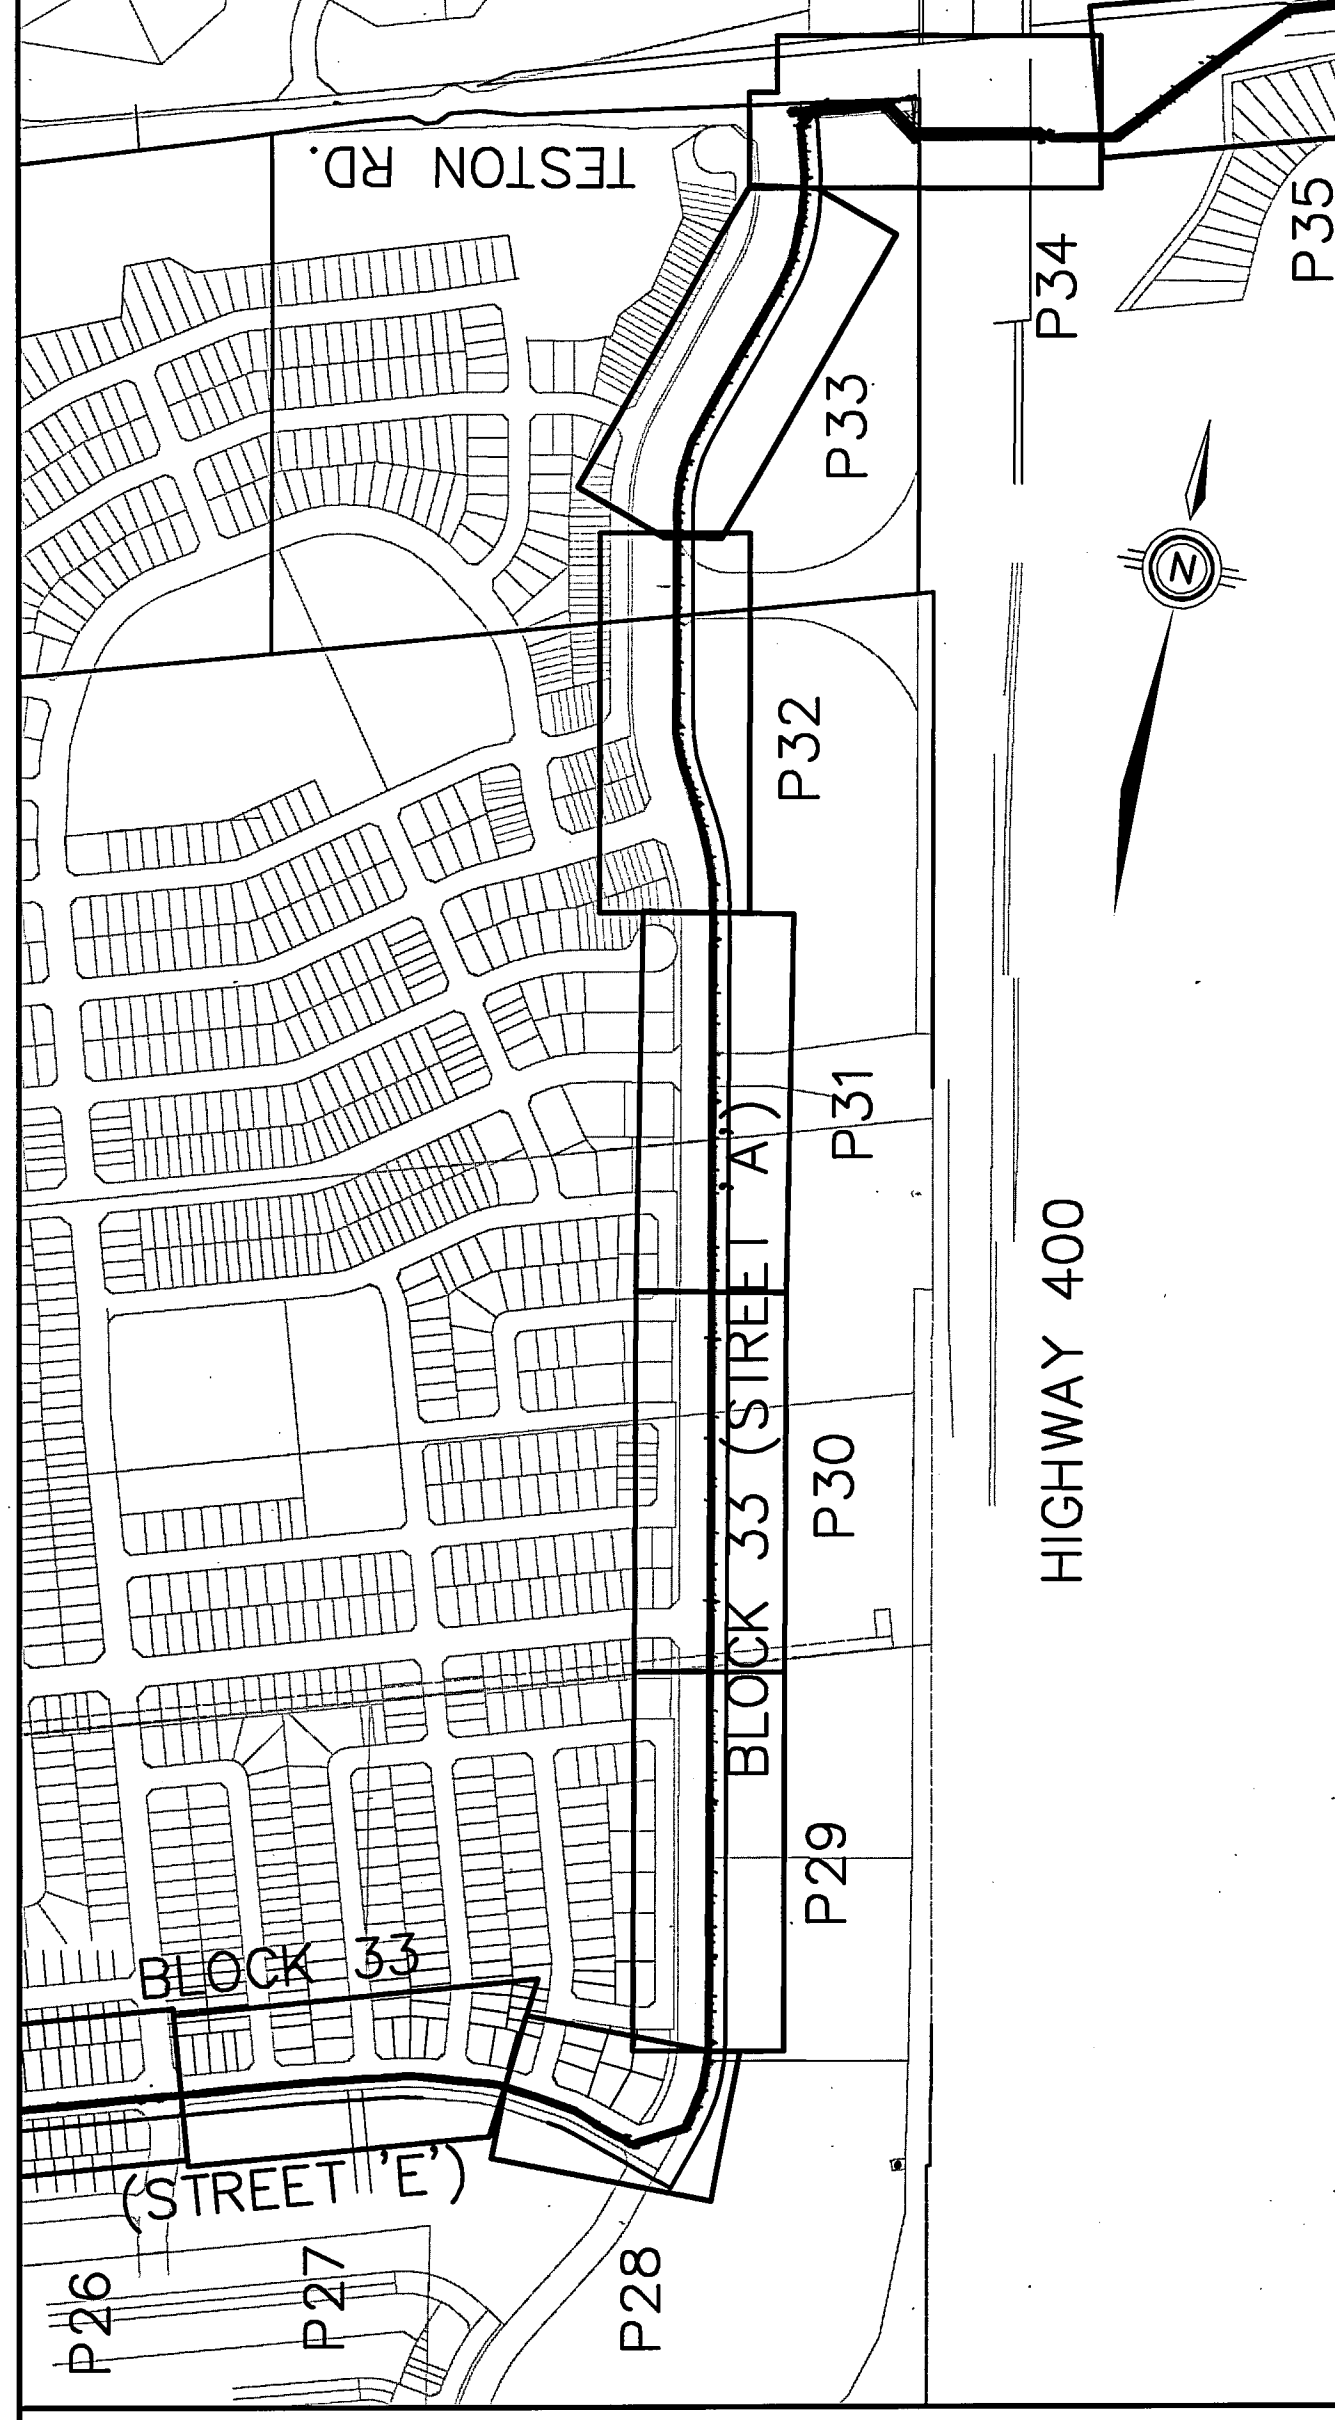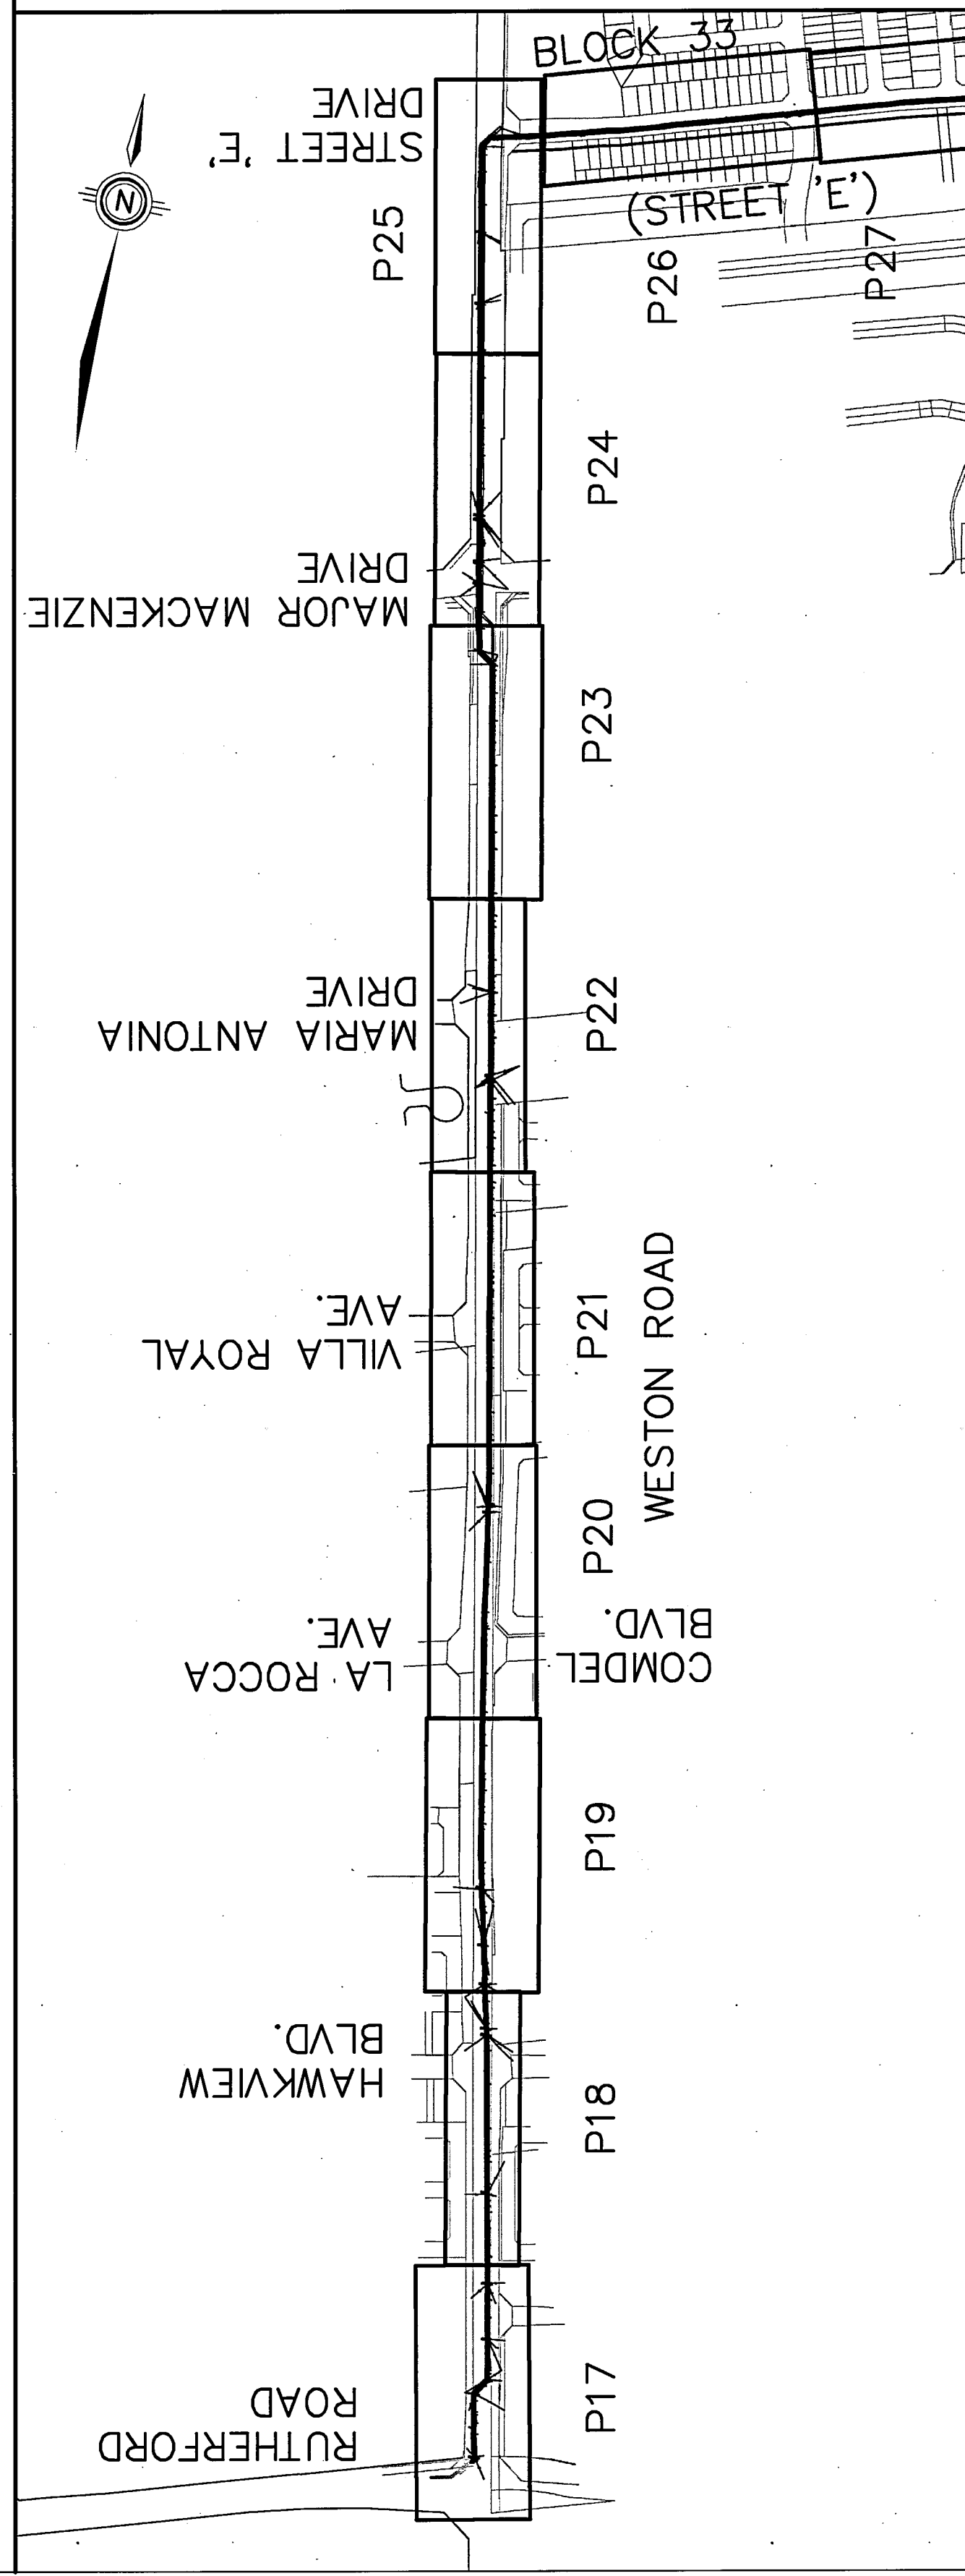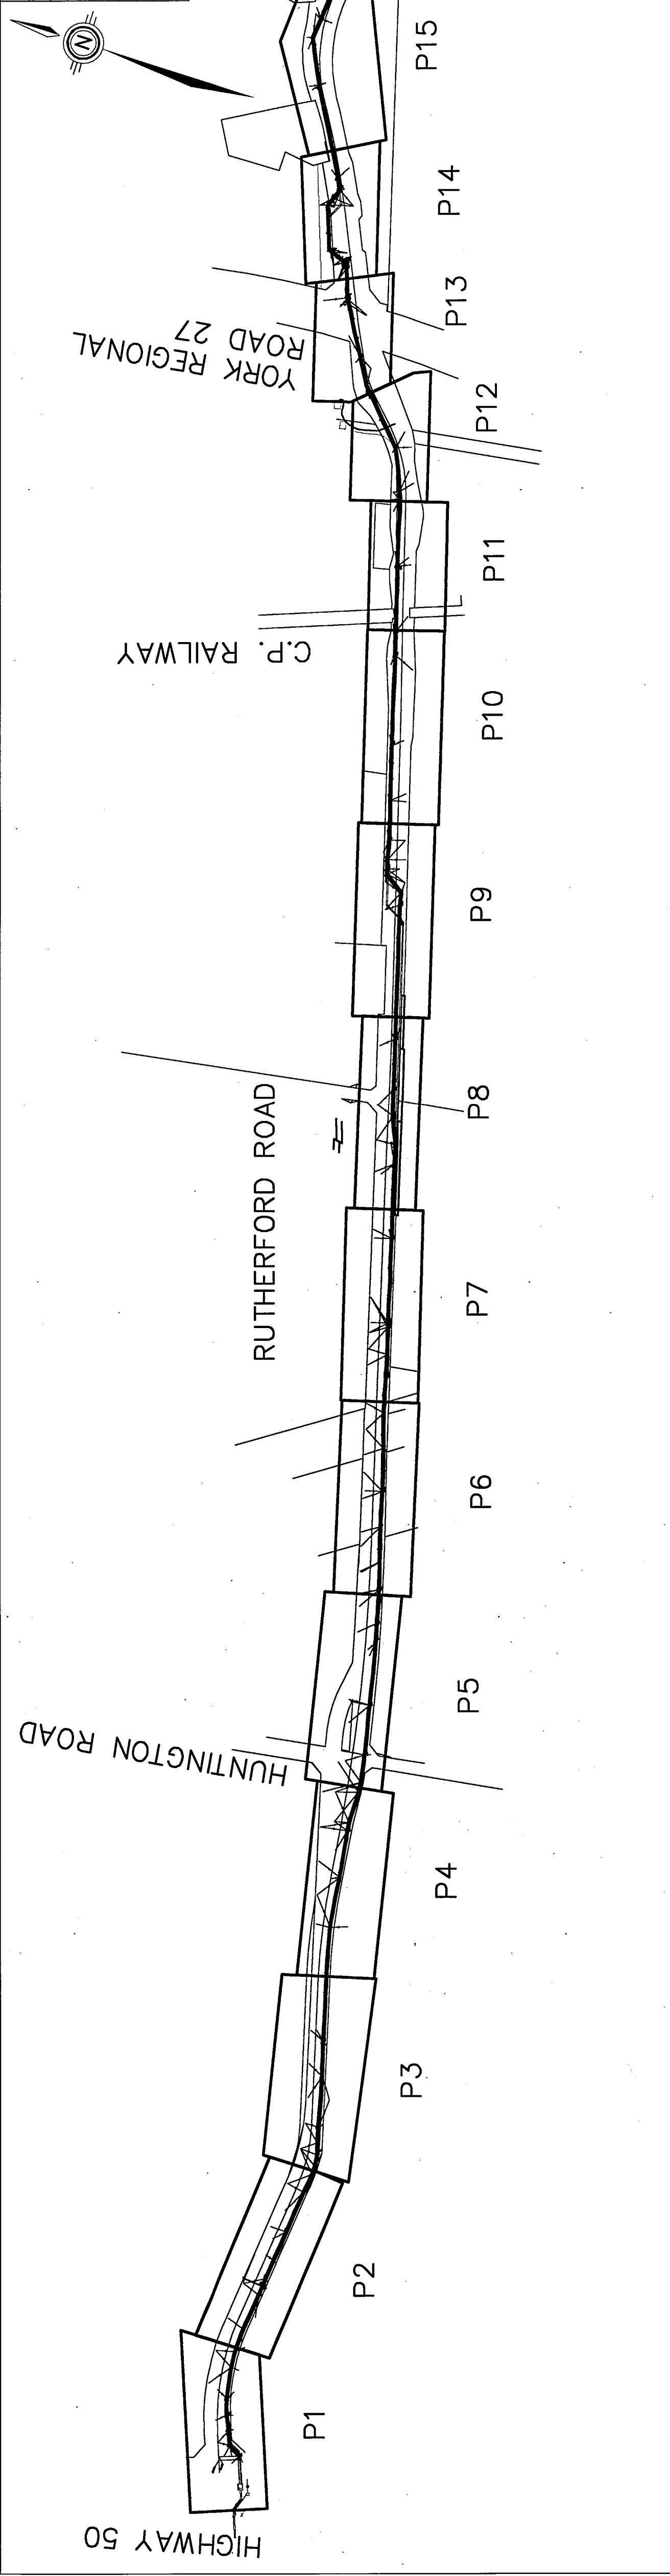

SCALE 1:6000

METRIC

**York Region**

**Transportation and Works**

DESIGN: B.G.  
DRAWN: L.B.  
CHECKED: J.S.

YORK PEEL FEEDERMAIN  
YORK INDEX SHEET

DWG. NO. INDEX  
CONT. NO. P-03-04  
SHEET NO. INDEX

York Peel Design Build  
EARTH TECH URS  
165 Commerce Valley Dr. West, Markham, Ontario (905) 784-4300







Bell Canada Municipal Operations Centre - C/O PRESTIGE TELECOM  
200 Town Centre Blvd., Suite #300  
Markham, Ontario L3R 8G5  
Ph: (905) 470-2112 Fax: (905) 460-8956

## **APPLICATION FOR PLANT LOCATION AND CONSENT**

**Applicant:** HDR | iTRANS

**Mark Up #:**30879

**Applicant Ref #:** 4956

**Location:** Mayfield Rd from Coleraine Dr to Hwy 50; Hwy 50 from Mayfield Rd to Castlemore Rd

**SwitchingCenter/NNX:** BRAMPTON-WALKER DR/458 BOLTON/857 KLEINBURG/893

**Date Received From Applicant:** 2011-08-15

**Marked By:** Ryan Su

## **APPLICATION FOR PLANT LOCATION AND REQUEST**

- Existing and/or proposed Bell Canada underground plant are indicated on the attached plan
- Our records show no existing and / or proposed underground plant within 2m of your proposed installation
- Conflict indicated
- Meets with our approval
- Not for PUCC approval - Mark up only
- If within 1 metre of bell plant, hand dig

**REMARKS:** Call for locates 1.800.400.2255. Maintain clearance of 0.6m. Hand dig when crossing Bell plant.


### PROCEDURES TO FOLLOW:

- 1. Request locates prior to construction 1-800-400-2255**
- 2. If exact location and depth are critical - test pits are recommended**
- 3. Bell Canada plant location information is approximate**
- 4. If the location of your proposed design changes, it will be necessary to re-apply**
- 5. Permits expire six(6) months from approval date**

Signature:  
Ryan Su

Date:  
August 19, 2011

---

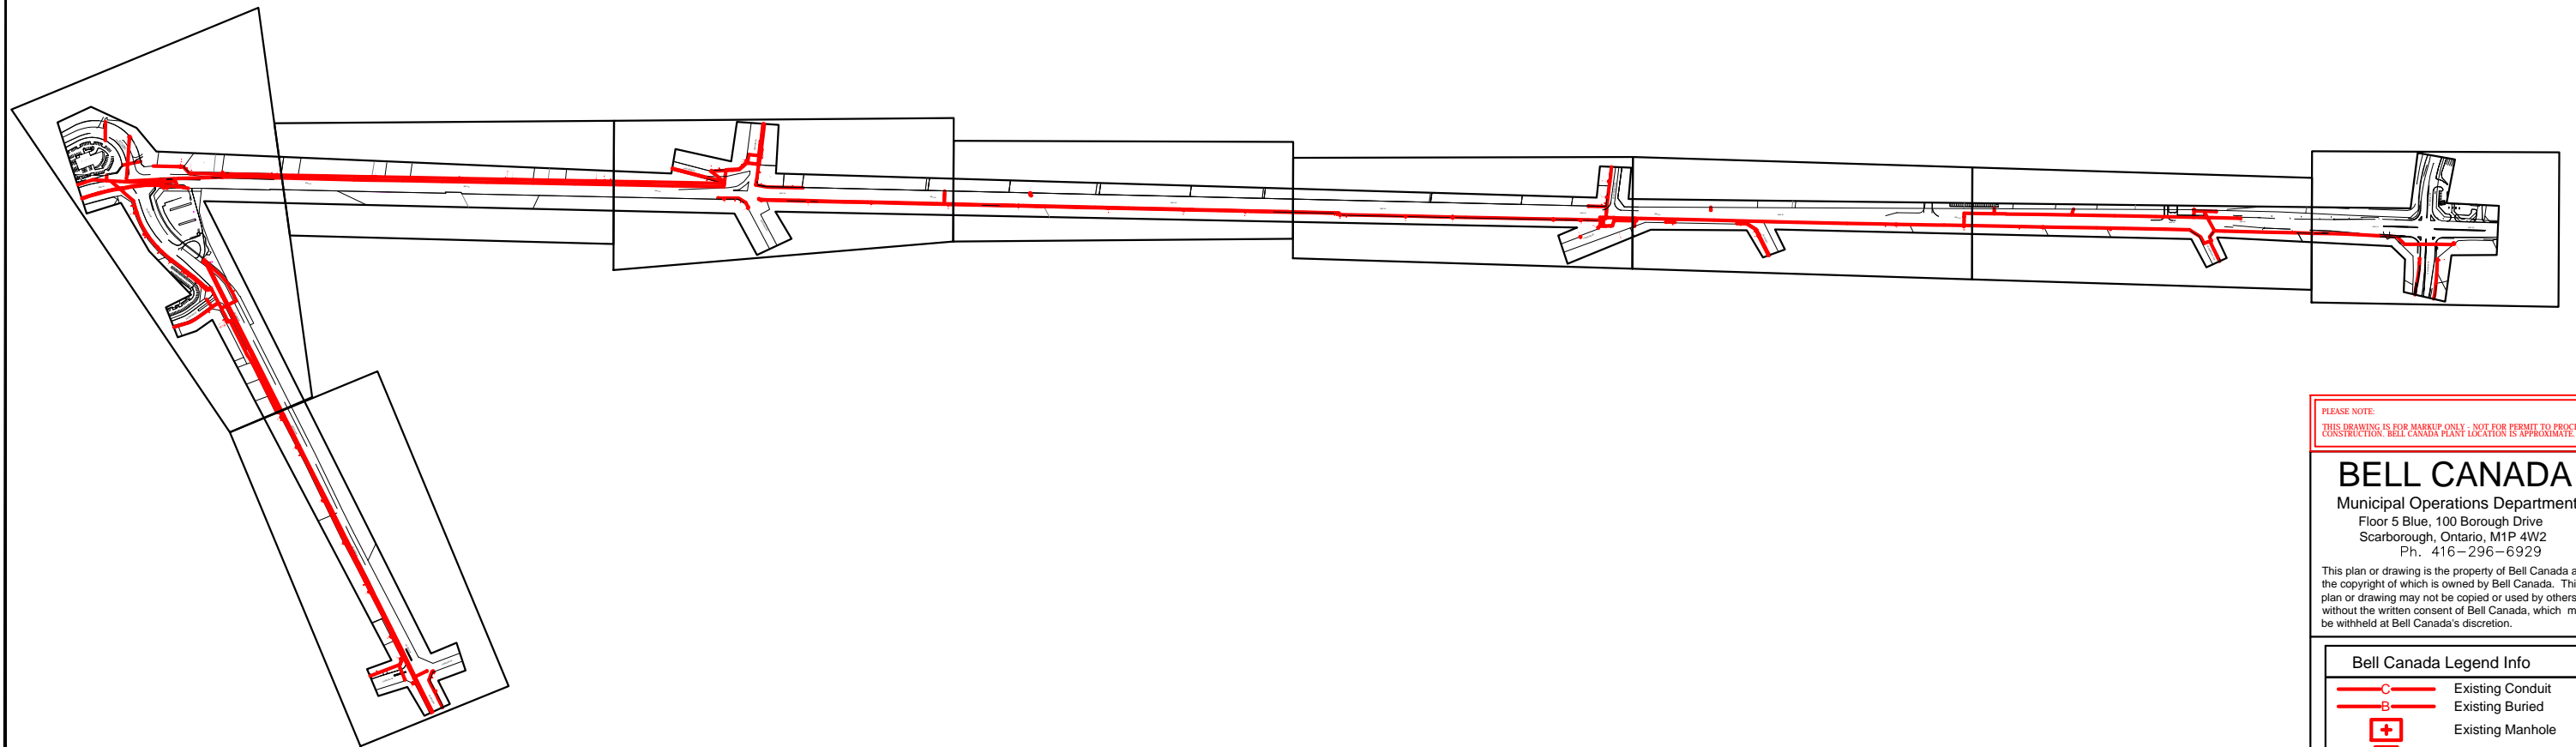






 
PLEASE NOTE:  
 THIS DRAWING IS FOR MARKUP ONLY - NOT FOR PERMIT TO PROCEED  
 CONSTRUCTION. BELL CANADA PLANT LOCATION IS APPROXIMATE.

## BELL CANADA

Municipal Operations Department  
 Floor 5 Blue, 100 Borough Drive  
 Scarborough, Ontario, M1P 4W2  
 Ph. 416-296-6929

This plan or drawing is the property of Bell Canada and the copyright of which is owned by Bell Canada. This plan or drawing may not be copied or used by others without the written consent of Bell Canada, which may be withheld at Bell Canada's discretion.

### Bell Canada Legend Info

-  Existing Conduit
-  Existing Buried
-  Existing Manhole
-  Existing Interface
-  Existing Bell Pole
-  Existing Pedestal

CALL FOR LOCATES  
 1-800-400-2255

HAND DIG  
 if within 1m of Bell plant

HAND DIG  
 when crossing Bell plant

Maintain clearance of 0.6m


If further details required  
 You must acquire Locates or Test Pits

KEY PLAN



Mark Up # - 30879

Designer - RSU

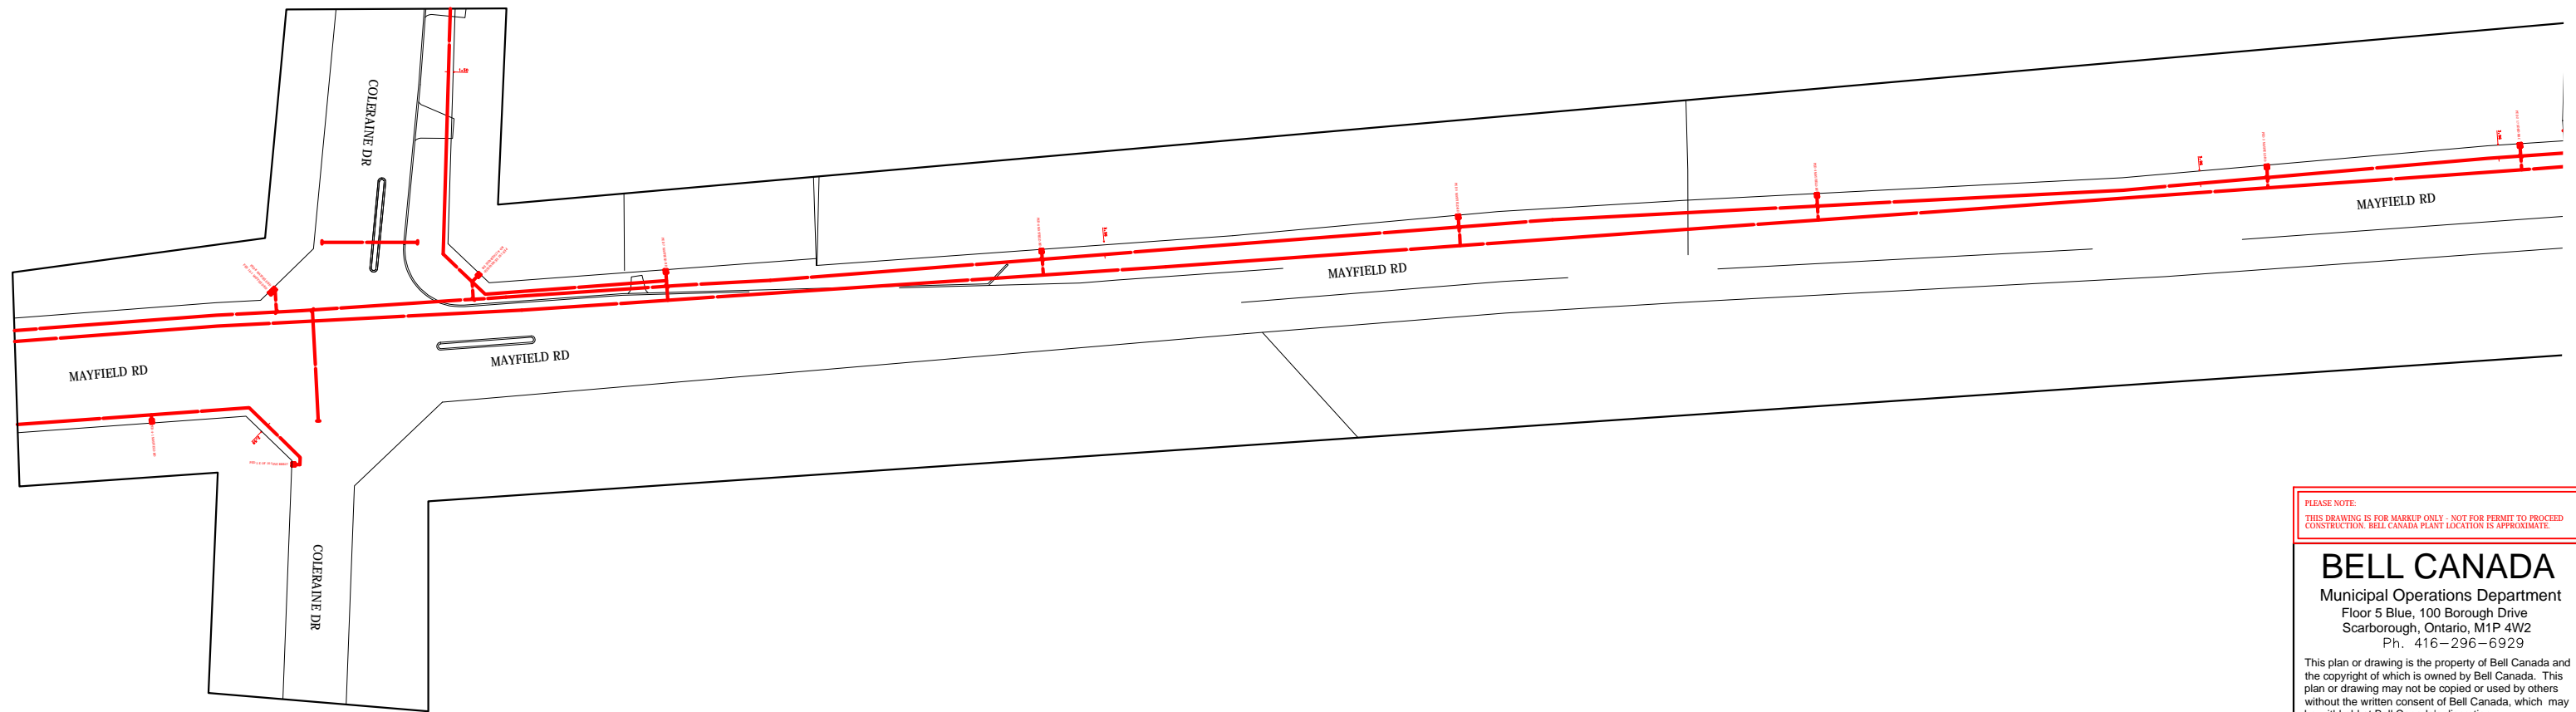

PLEASE NOTE:  
 THIS DRAWING IS FOR MARKUP ONLY - NOT FOR PERMIT TO PROCEED  
 CONSTRUCTION. BELL CANADA PLANT LOCATION IS APPROXIMATE.

## BELL CANADA

Municipal Operations Department  
 Floor 5 Blue, 100 Borough Drive  
 Scarborough, Ontario, M1P 4W2  
 Ph. 416-296-6929

This plan or drawing is the property of Bell Canada and the copyright of which is owned by Bell Canada. This plan or drawing may not be copied or used by others without the written consent of Bell Canada, which may be withheld at Bell Canada's discretion.

### Bell Canada Legend Info

	Existing Conduit
	Existing Buried
	Existing Manhole
	Existing Interface
	Existing Bell Pole
	Existing Pedestal

CALL FOR LOCATES  
 1-800-400-2255

HAND DIG  
 if within 1m of Bell plant

HAND DIG  
 when crossing Bell plant

Maintain clearance of 0.6m


If further details required  
 You must acquire Locates or Test Pits

Dwg # - 1

Mark Up # - 30879

Designer - RSU



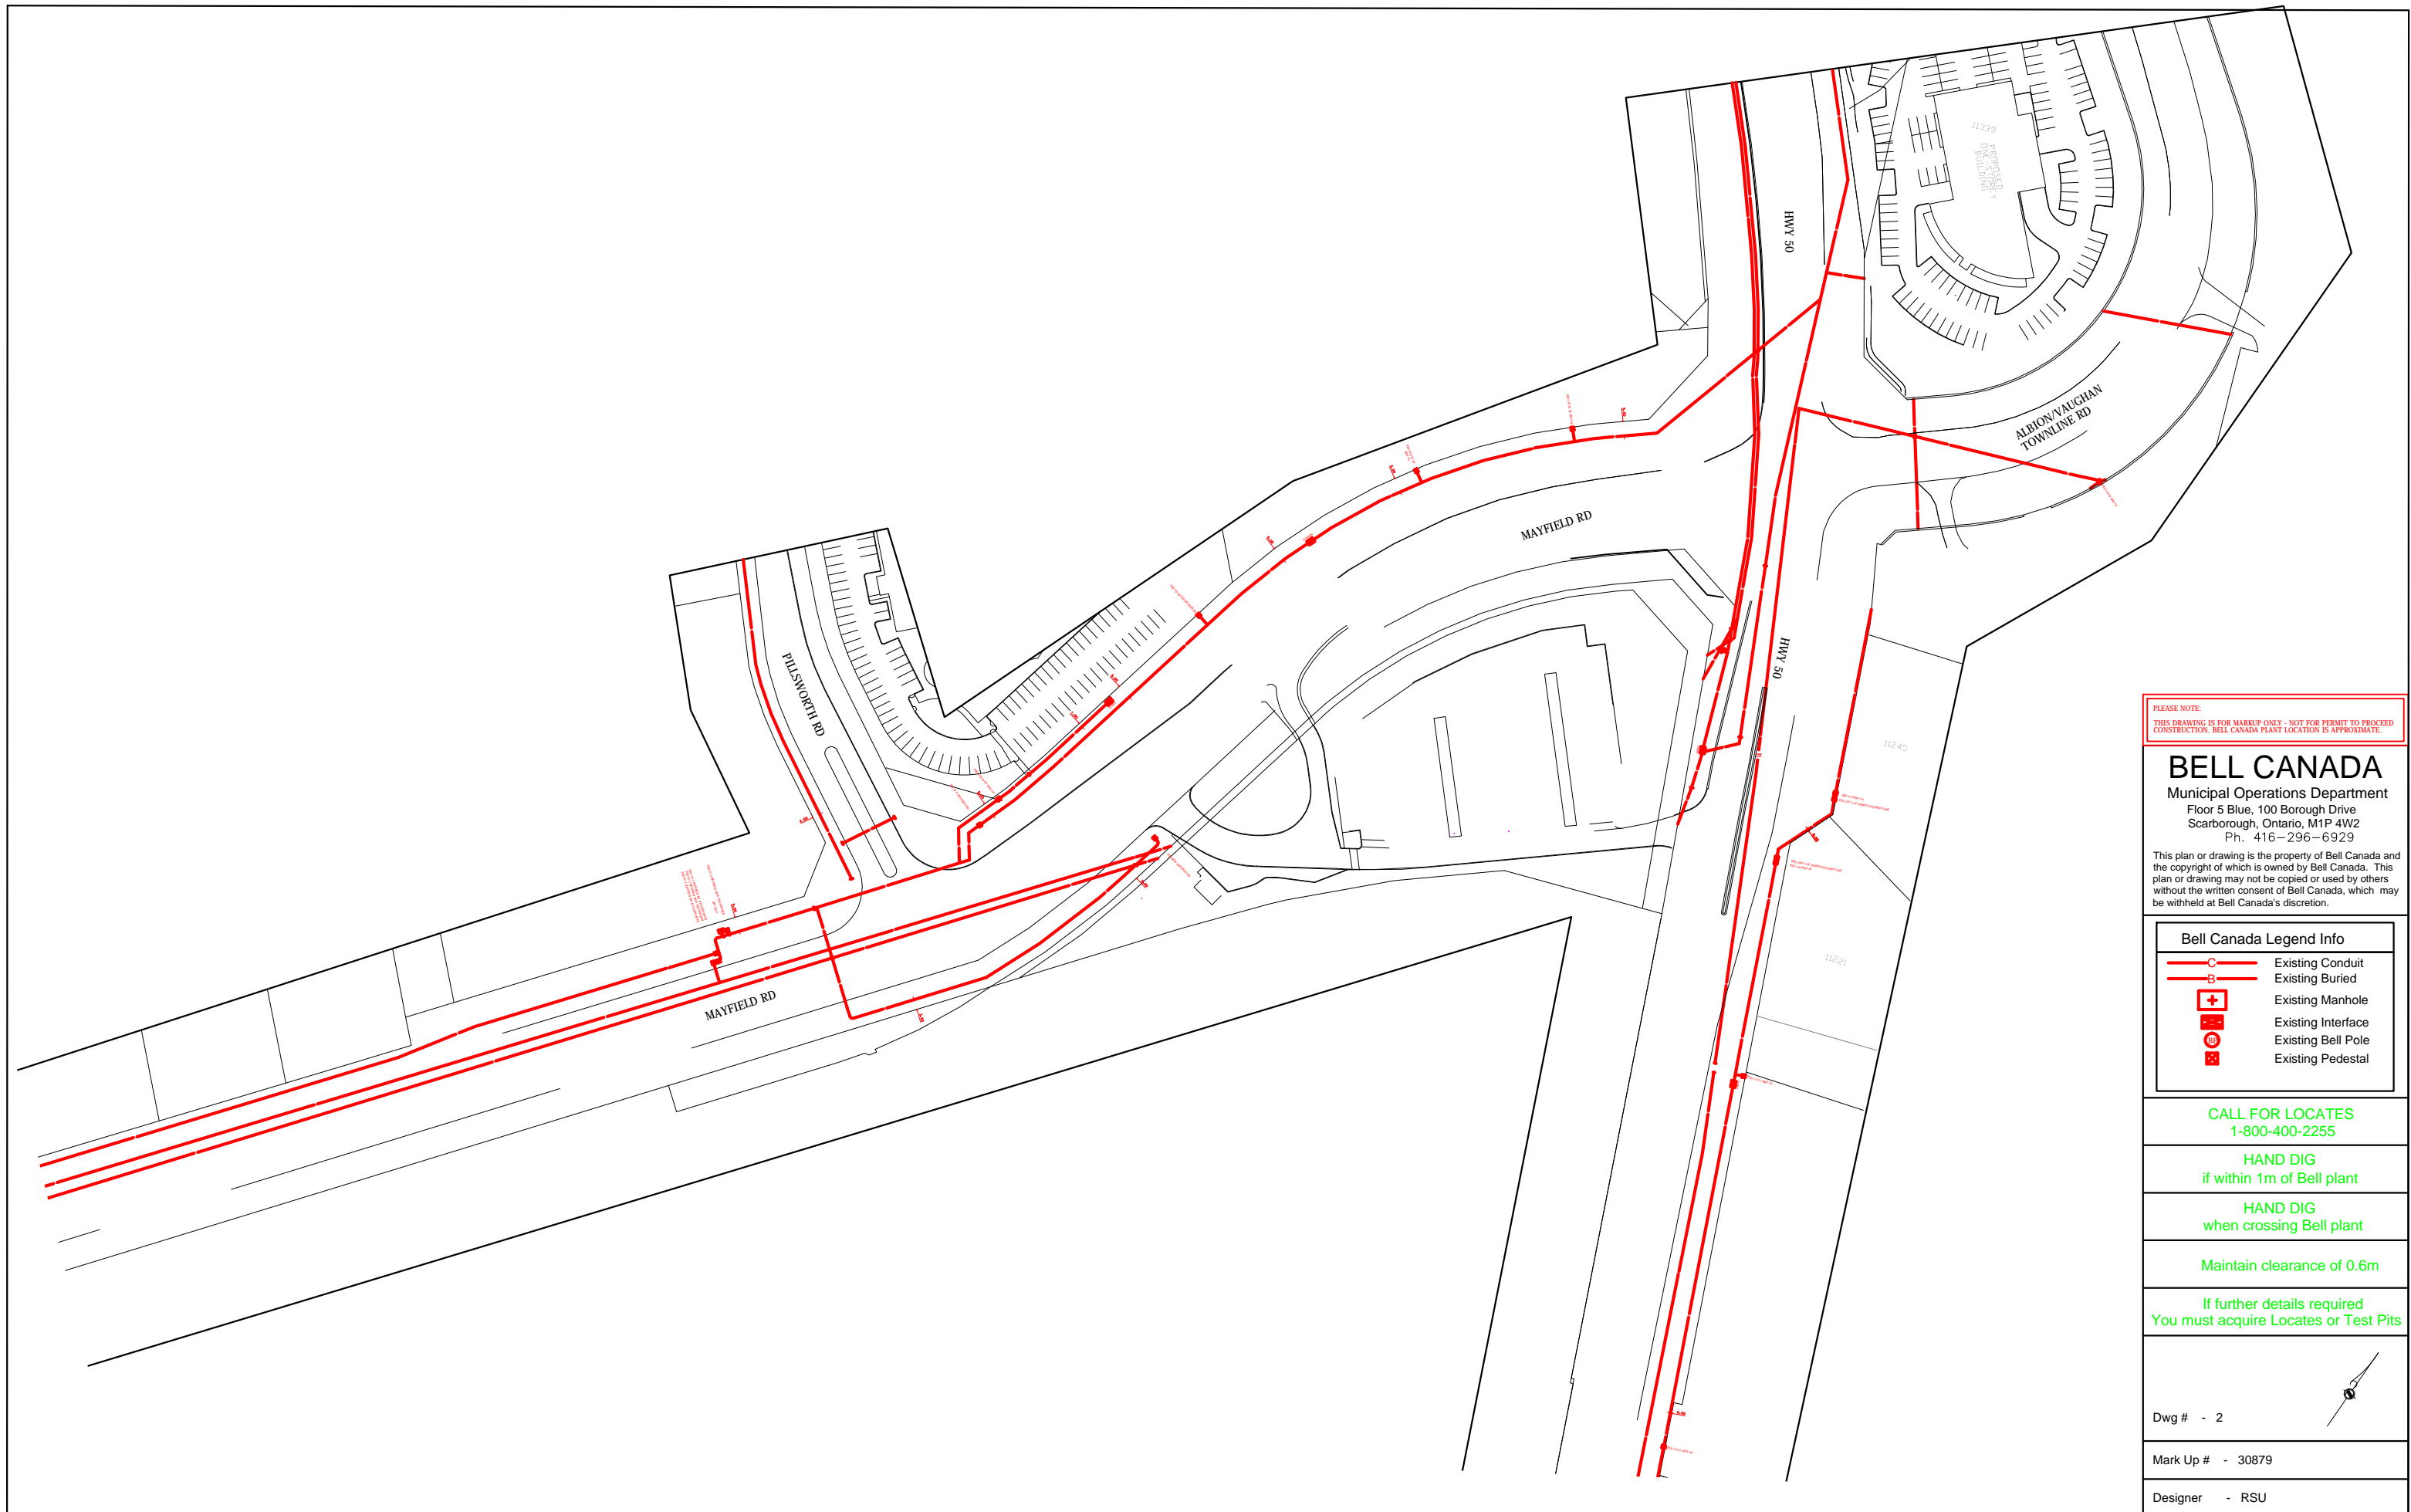

PLEASE NOTE:  
 THIS DRAWING IS FOR MARKUP ONLY - NOT FOR PERMIT TO PROCEED  
 CONSTRUCTION. BELL CANADA PLANT LOCATION IS APPROXIMATE.

**BELL CANADA**  
 Municipal Operations Department  
 Floor 5 Blue, 100 Borough Drive  
 Scarborough, Ontario, M1P 4W2  
 Ph. 416-296-6929

This plan or drawing is the property of Bell Canada and the copyright of which is owned by Bell Canada. This plan or drawing may not be copied or used by others without the written consent of Bell Canada, which may be withheld at Bell Canada's discretion.

Bell Canada Legend Info	
	Existing Conduit
	Existing Buried
	Existing Manhole
	Existing Interface
	Existing Bell Pole
	Existing Pedestal

CALL FOR LOCATES  
 1-800-400-2255

HAND DIG  
 if within 1m of Bell plant

HAND DIG  
 when crossing Bell plant


Maintain clearance of 0.6m

If further details required  
 You must acquire Locates or Test Pits

Dwg # - 2

Mark Up # - 30879

Designer - RSU

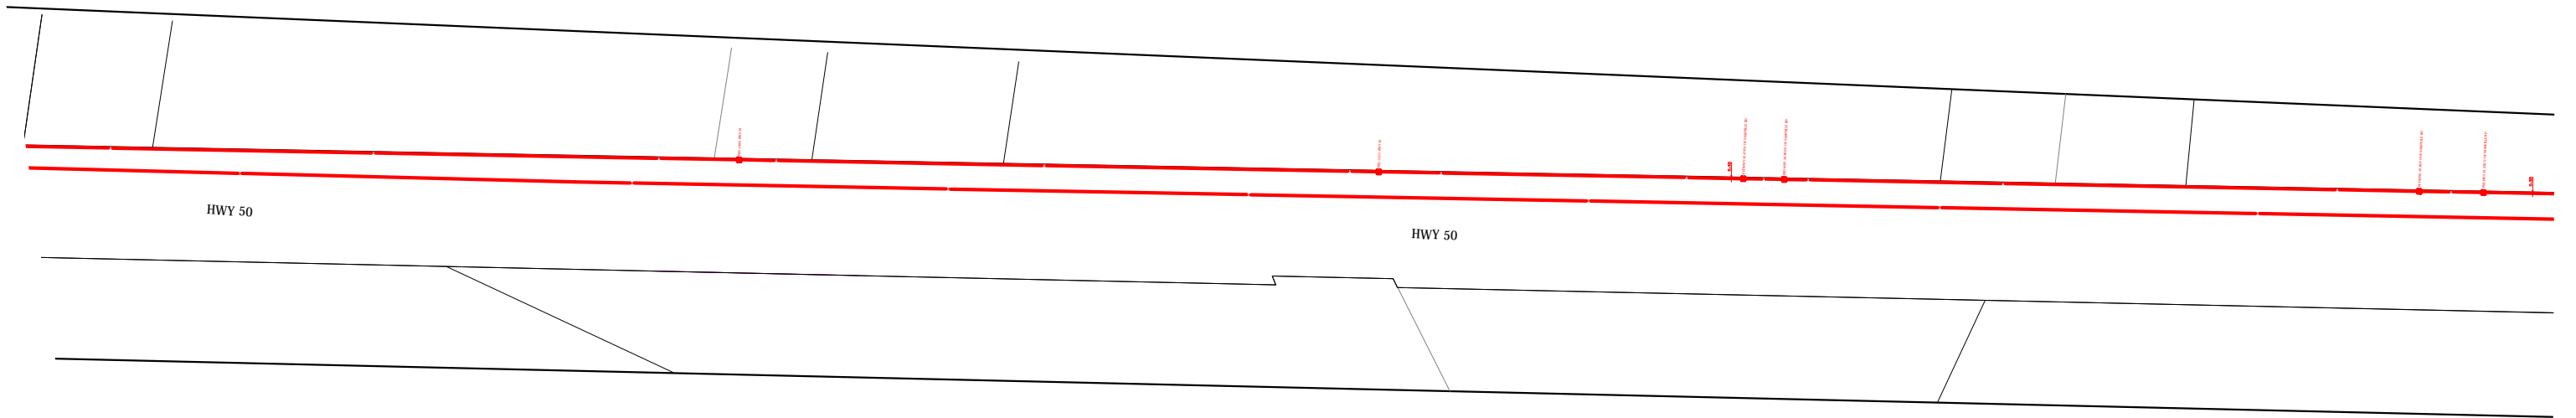

PLEASE NOTE:  
THIS DRAWING IS FOR MARKUP ONLY - NOT FOR PERMIT TO PROCEED  
CONSTRUCTION. BELL CANADA PLANT LOCATION IS APPROXIMATE.

## BELL CANADA

Municipal Operations Department  
Floor 5 Blue, 100 Borough Drive  
Scarborough, Ontario, M1P 4W2  
Ph. 416-296-6929

This plan or drawing is the property of Bell Canada and the copyright of which is owned by Bell Canada. This plan or drawing may not be copied or used by others without the written consent of Bell Canada, which may be withheld at Bell Canada's discretion.

### Bell Canada Legend Info

	Existing Conduit
	Existing Buried
	Existing Manhole
	Existing Interface
	Existing Bell Pole
	Existing Pedestal

CALL FOR LOCATES  
1-800-400-2255

HAND DIG  
if within 1m of Bell plant

HAND DIG  
when crossing Bell plant

Maintain clearance of 0.6m

If further details required  
You must acquire Locates or Test Pits



Dwg # - 3

Mark Up # - 30879

Designer - RSU



PLEASE NOTE:  
 THIS DRAWING IS FOR MARKUP ONLY - NOT FOR PERMIT TO PROCEED  
 CONSTRUCTION. BELL CANADA PLANT LOCATION IS APPROXIMATE.

**BELL CANADA**  
 Municipal Operations Department  
 Floor 5 Blue, 100 Borough Drive  
 Scarborough, Ontario, M1P 4W2  
 Ph. 416-296-6929

This plan or drawing is the property of Bell Canada and the copyright of which is owned by Bell Canada. This plan or drawing may not be copied or used by others without the written consent of Bell Canada, which may be withheld at Bell Canada's discretion.

Bell Canada Legend Info	
	Existing Conduit
	Existing Buried
	Existing Manhole
	Existing Interface
	Existing Bell Pole
	Existing Pedestal

CALL FOR LOCATES  
 1-800-400-2255

HAND DIG  
 if within 1m of Bell plant

HAND DIG  
 when crossing Bell plant


Maintain clearance of 0.6m

If further details required  
 You must acquire Locates or Test Pits

Dwg # - 4

Mark Up # - 30879

Designer - RSU

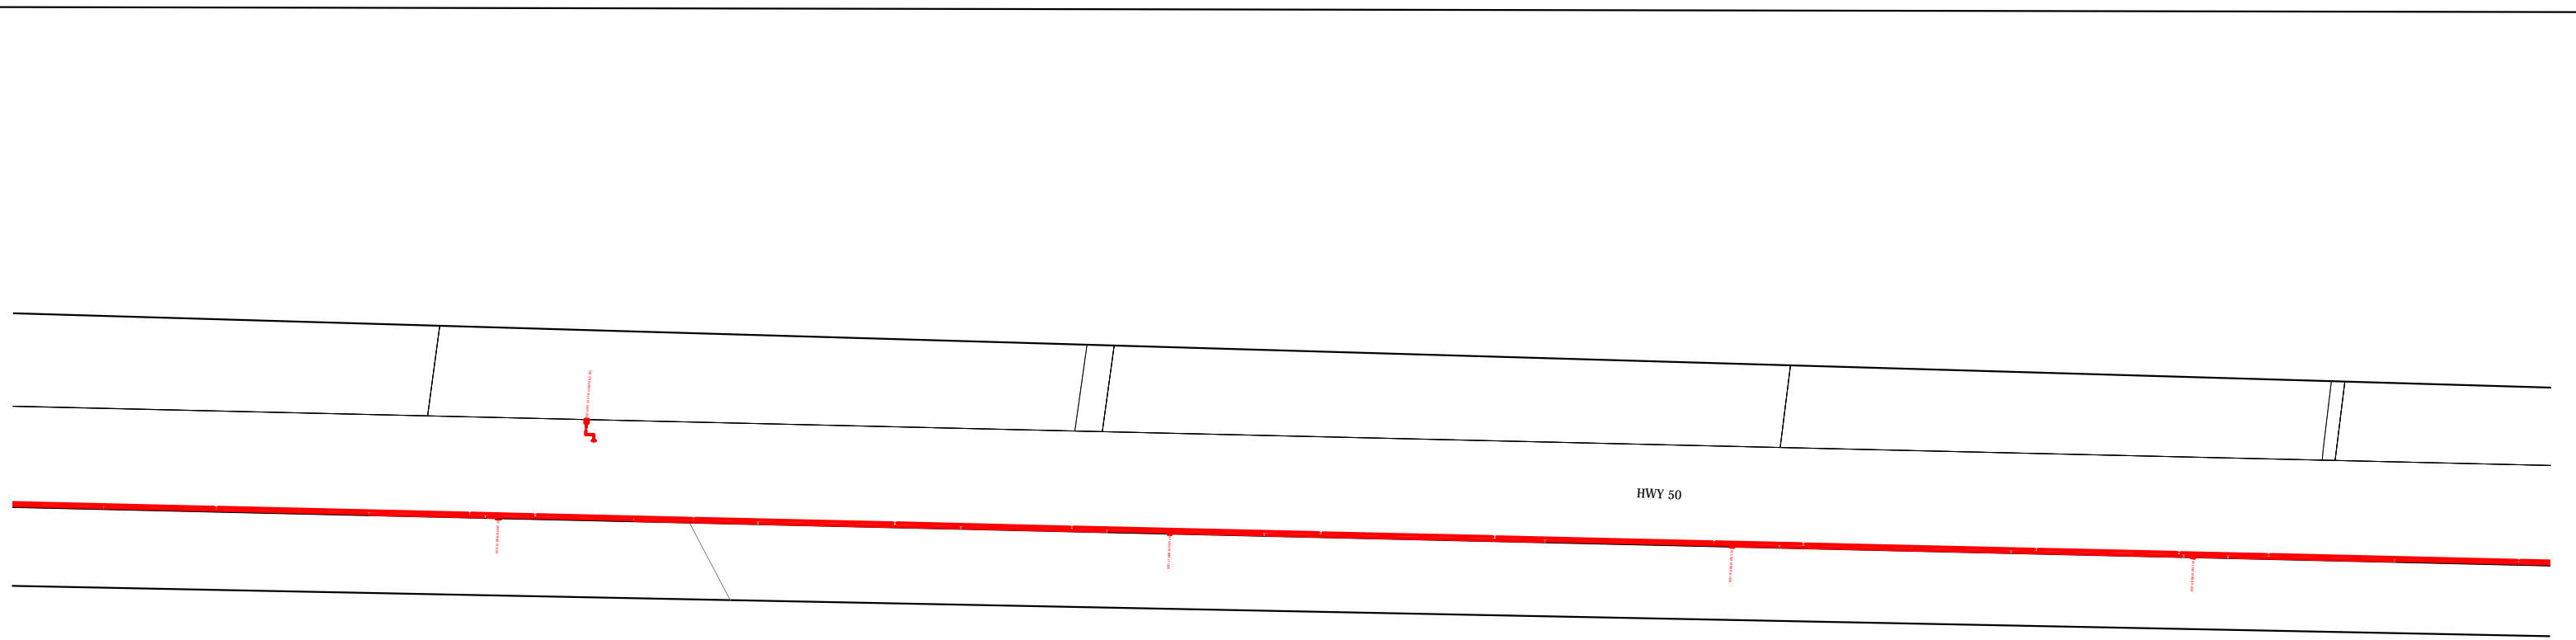

PLEASE NOTE:  
 THIS DRAWING IS FOR MARKUP ONLY - NOT FOR PERMIT TO PROCEED  
 CONSTRUCTION. BELL CANADA PLANT LOCATION IS APPROXIMATE.

## BELL CANADA

Municipal Operations Department  
 Floor 5 Blue, 100 Borough Drive  
 Scarborough, Ontario, M1P 4W2  
 Ph. 416-296-6929

This plan or drawing is the property of Bell Canada and the copyright of which is owned by Bell Canada. This plan or drawing may not be copied or used by others without the written consent of Bell Canada, which may be withheld at Bell Canada's discretion.

### Bell Canada Legend Info

	Existing Conduit
	Existing Buried
	Existing Manhole
	Existing Interface
	Existing Bell Pole
	Existing Pedestal

CALL FOR LOCATES  
 1-800-400-2255

HAND DIG  
 if within 1m of Bell plant

HAND DIG  
 when crossing Bell plant

Maintain clearance of 0.6m


If further details required  
 You must acquire Locates or Test Pits



Dwg # - 5

Mark Up # - 30879

Designer - RSU

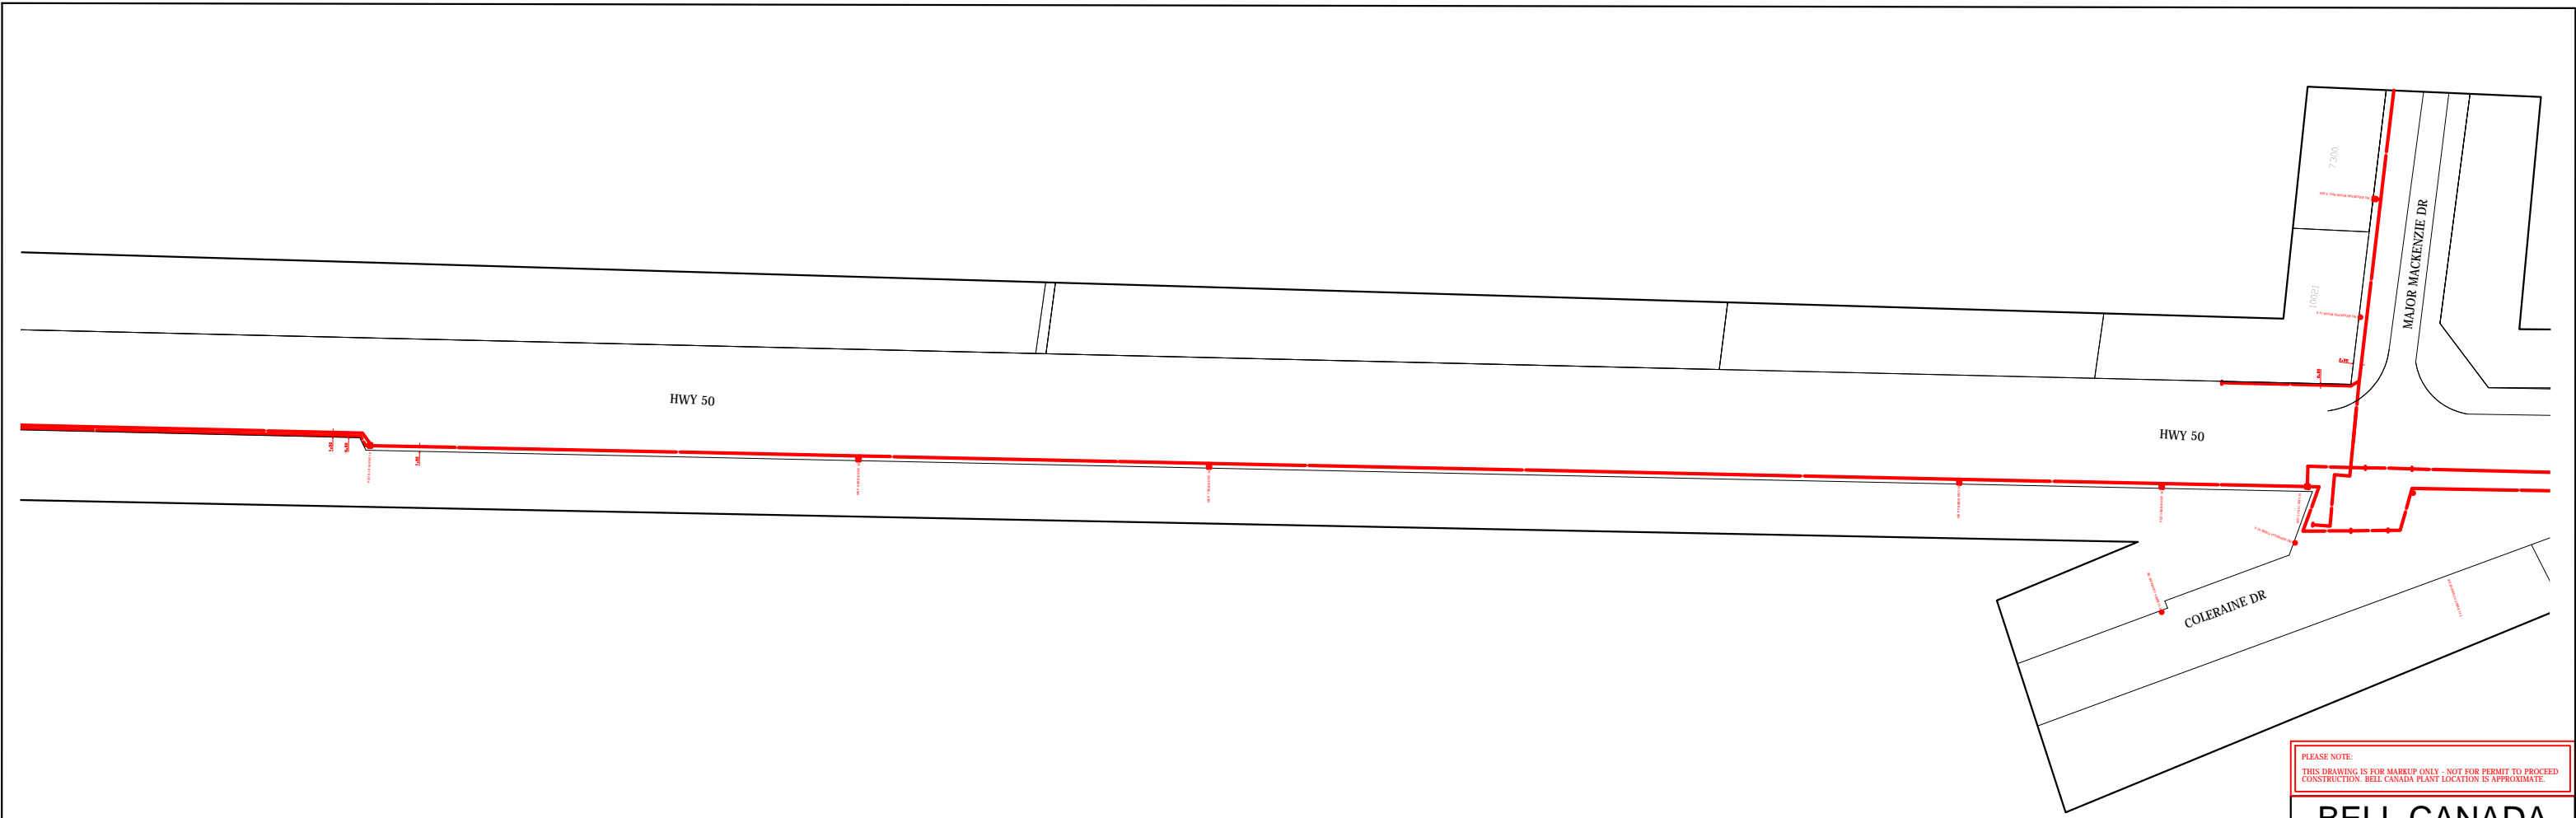

PLEASE NOTE:  
 THIS DRAWING IS FOR MARKUP ONLY - NOT FOR PERMIT TO PROCEED  
 CONSTRUCTION. BELL CANADA PLANT LOCATION IS APPROXIMATE.

**BELL CANADA**  
 Municipal Operations Department  
 Floor 5 Blue, 100 Borough Drive  
 Scarborough, Ontario, M1P 4W2  
 Ph. 416-296-6929

This plan or drawing is the property of Bell Canada and the copyright of which is owned by Bell Canada. This plan or drawing may not be copied or used by others without the written consent of Bell Canada, which may be withheld at Bell Canada's discretion.

Bell Canada Legend Info	
	Existing Conduit
	Existing Buried
	Existing Manhole
	Existing Interface
	Existing Bell Pole
	Existing Pedestal

CALL FOR LOCATES  
 1-800-400-2255

HAND DIG  
 if within 1m of Bell plant

HAND DIG  
 when crossing Bell plant

Maintain clearance of 0.6m


If further details required  
 You must acquire Locates or Test Pits

Dwg # - 6

Mark Up # - 30879

Designer - RSU



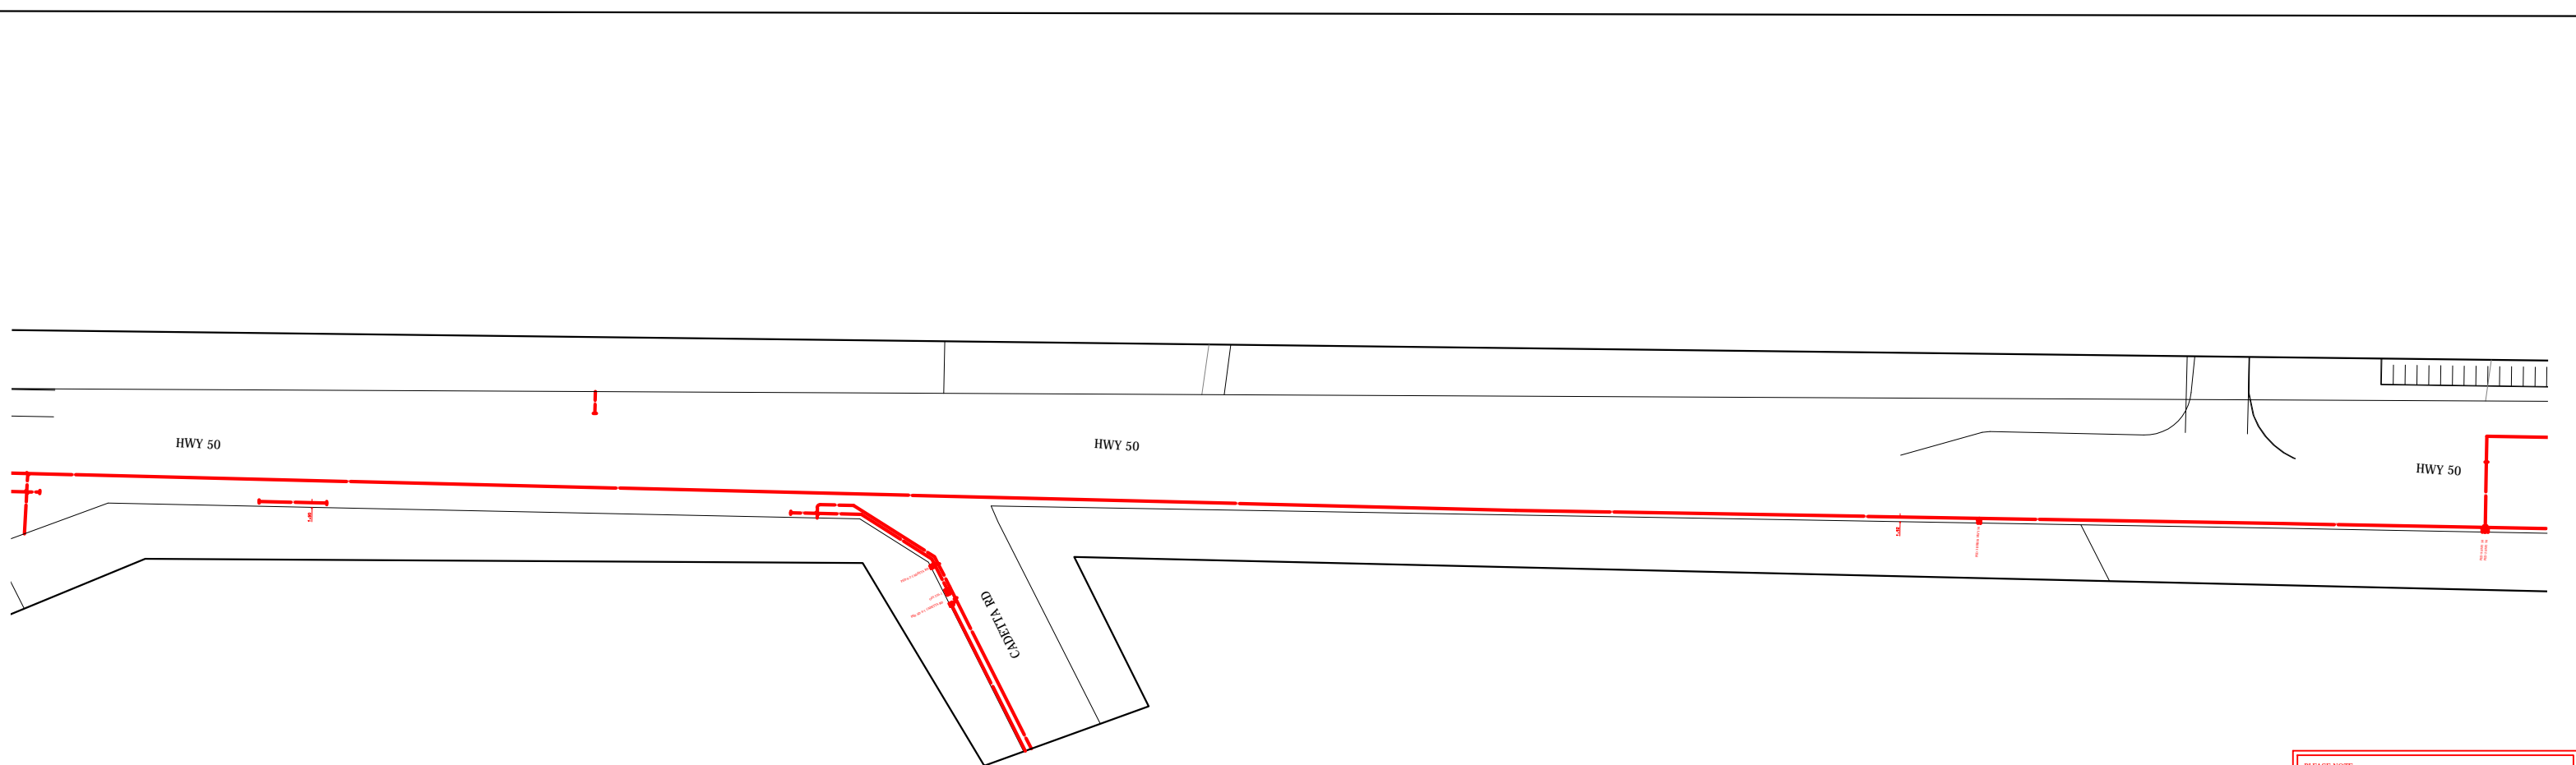







PLEASE NOTE:  
 THIS DRAWING IS FOR MARKUP ONLY - NOT FOR PERMIT TO PROCEED  
 CONSTRUCTION. BELL CANADA PLANT LOCATION IS APPROXIMATE.

## BELL CANADA

Municipal Operations Department  
 Floor 5 Blue, 100 Borough Drive  
 Scarborough, Ontario, M1P 4W2  
 Ph. 416-296-6929

This plan or drawing is the property of Bell Canada and the copyright of which is owned by Bell Canada. This plan or drawing may not be copied or used by others without the written consent of Bell Canada, which may be withheld at Bell Canada's discretion.

### Bell Canada Legend Info

-  Existing Conduit
-  Existing Buried
-  Existing Manhole
-  Existing Interface
-  Existing Bell Pole
-  Existing Pedestal

CALL FOR LOCATES  
 1-800-400-2255

HAND DIG  
 if within 1m of Bell plant

HAND DIG  
 when crossing Bell plant

Maintain clearance of 0.6m


If further details required  
 You must acquire Locates or Test Pits



Dwg # - 7

Mark Up # - 30879

Designer - RSU

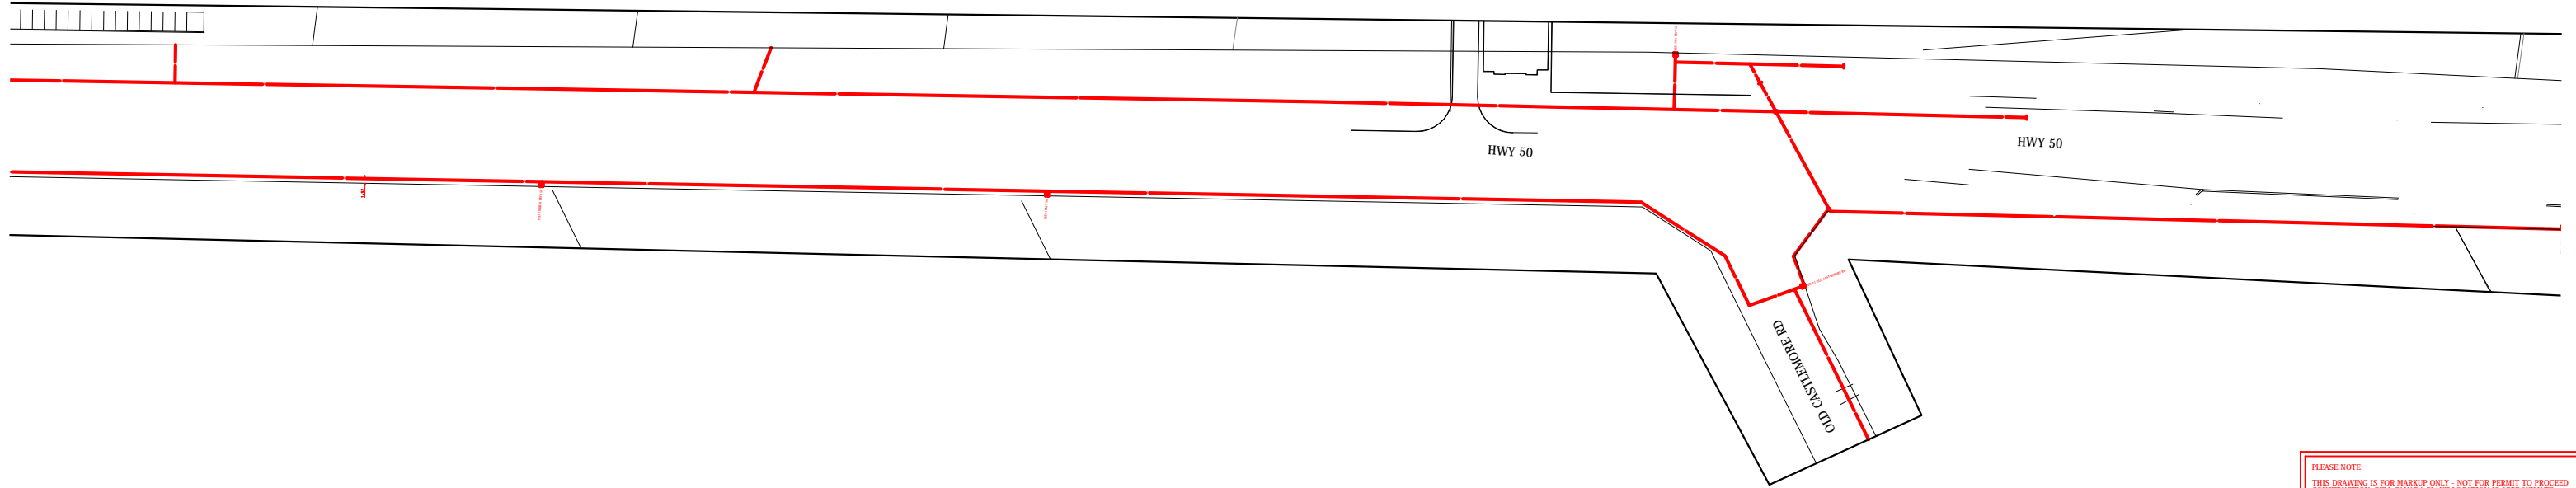







PLEASE NOTE:  
 THIS DRAWING IS FOR MARKUP ONLY - NOT FOR PERMIT TO PROCEED  
 CONSTRUCTION. BELL CANADA PLANT LOCATION IS APPROXIMATE.

### BELL CANADA

Municipal Operations Department  
 Floor 5 Blue, 100 Borough Drive  
 Scarborough, Ontario, M1P 4W2  
 Ph. 416-296-6929

This plan or drawing is the property of Bell Canada and the copyright of which is owned by Bell Canada. This plan or drawing may not be copied or used by others without the written consent of Bell Canada, which may be withheld at Bell Canada's discretion.

#### Bell Canada Legend Info

-  Existing Conduit
-  Existing Buried
-  Existing Manhole
-  Existing Interface
-  Existing Bell Pole
-  Existing Pedestal

CALL FOR LOCATES  
 1-800-400-2255

HAND DIG  
 if within 1m of Bell plant

HAND DIG  
 when crossing Bell plant

Maintain clearance of 0.6m


If further details required  
 You must acquire Locates or Test Pits



Dwg # - 8

Mark Up # - 30879

Designer - RSU

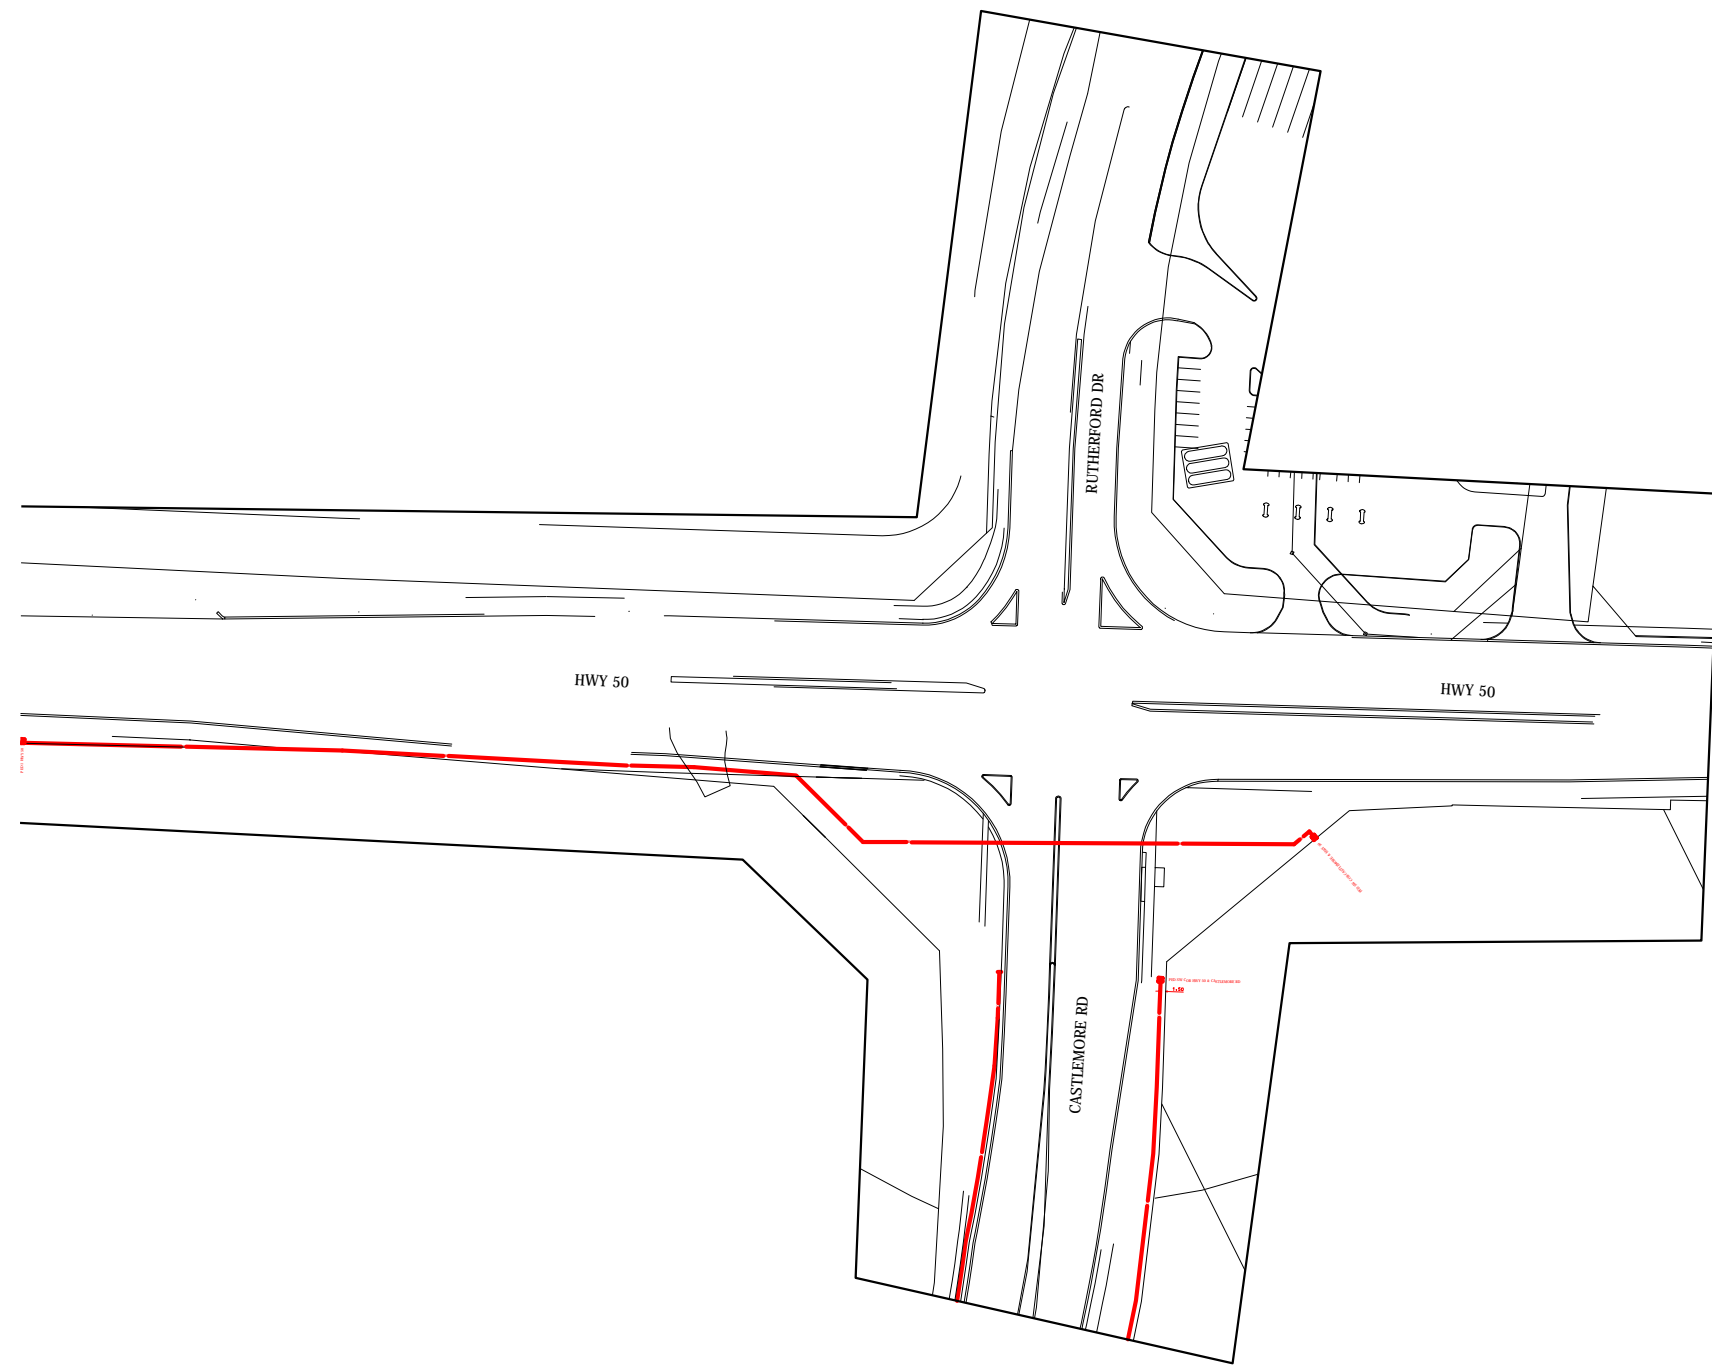

PLEASE NOTE:  
 THIS DRAWING IS FOR MARKUP ONLY - NOT FOR PERMIT TO PROCEED  
 CONSTRUCTION. BELL CANADA PLANT LOCATION IS APPROXIMATE.

### BELL CANADA

Municipal Operations Department  
 Floor 5 Blue, 100 Borough Drive  
 Scarborough, Ontario, M1P 4W2  
 Ph. 416-296-6929

This plan or drawing is the property of Bell Canada and the copyright of which is owned by Bell Canada. This plan or drawing may not be copied or used by others without the written consent of Bell Canada, which may be withheld at Bell Canada's discretion.

#### Bell Canada Legend Info

	Existing Conduit
	Existing Buried
	Existing Manhole
	Existing Interface
	Existing Bell Pole
	Existing Pedestal

CALL FOR LOCATES  
 1-800-400-2255

HAND DIG  
 if within 1m of Bell plant

HAND DIG  
 when crossing Bell plant

Maintain clearance of 0.6m

If further details required  
 You must acquire Locates or Test Pits

Dwg # - 9

Mark Up # - 30879

Designer - RSU



Bell Canada Municipal Operations Centre  
c/o Plantec Consulting Engineers  
200 Town Centre Blvd, Suite #300  
Markham, Ontario L3R 8G5  
Tel no. 905-470-2112 Fax no. 905-470-8956

## **APPLICATION FOR PLANT LOCATION AND CONSENT**

**Applicant:** HDR Corporation

**Mark Up #:**32187

**Applicant Ref #:** 4956

**Location:** Mayfield Rd from Coleratine Dr to Hwy 50; Hwy 50 from Mayfield Rd to Castlemore Rd

**SwitchingCenter/NNX:** 458 Brampton – Walker Dr; 857 Bolton; 893 Kleinburg

**Date Received From Applicant:** 2011-10-12

**Marked By:** Keizerling

## **APPLICATION FOR PLANT LOCATION AND REQUEST**

- Existing and/or proposed Bell Canada underground plant are indicated on the attached plan
- Our records show no existing and/or proposed underground plant within 2m of your proposed installation
- Conflict indicated
- Meets with our approval
- Not for PUCC approval - Mark up only
- If within 1 metre of bell plant, hand dig

**REMARKS:** Caution

Call for locates 1.800.400.2255. Maintain clearance of 0.6m. Hand dig when crossing Bell plant. Bell has existing plant within 2m of proposed.

PROCEDURES TO FOLLOW:

1. Request locates prior to construction 1-800-400-2255
2. If exact location and depth are critical - test pits are recommended
3. Bell Canada plant location information is approximate
4. If the location of your proposed design changes, it will be necessary to re-apply
5. Permits expire six(6) months from approval date

Signature:

Keizerling Lau

Date:

Nov 16, 2011



## Meeting Minutes

Project: Highway 50 / Mayfield Road Class EA  
 Subject: Hydro One Brampton Liaison Meeting

Meeting Date: 2:30 p.m., Monday, November 22, 2010  
 Location: TRCA Office, 5 Shoreham Drive  
 Prepared by: Stephen Keen – HDR|iTRANS  
 Attendees: Solmaz Zia – Peel Region  
 Robert Evangelista, Hydro One Brampton

**Distribution** □ Solmaz Zia  
 Robert Evangelista

	Item	Action
<b>1.0</b>	<b>Background</b>	
1.1	Robert provided a plan with hydro utility locations (mainly west side of Hwy. 50) to HDR and will forward a CAD file of same.  Closer to Mayfield Road, Hydro One Network, Power Stream (Vaughan) and Hydro One Brampton (HOB) all use the same poles.	R. Evangelista
<b>2.0</b>	<b>Expansion</b>	
2.1	HOB has no current plans for expansion – future development will change that of course.	
<b>3.0</b>	<b>Clear Zone</b>	
	HOB requires a 5 m clear zone behind the poles. The current cross-section shows 2.25 m of ROW available resulting in a potential 2.75 aerial easement. This easement is usually obtained in the City's requirement for a 4.5 m buffer strip in front of any future development.	
<b>4.0</b>	<b>Illumination</b>	
	Illumination brackets need to be 0.15 m below the neutral line i.e. no more than 7.45 m above ground.	

<b>5.0</b>	<b>Other Issues/Further Actions</b>	
5.1	HOB would like to know where the exact municipal boundary is in relation to Mayfield Road.	Solmaz Zia
5.2	HOB may require a permanent easement for cable supports for the poles. Locations of poles will need to be determined by HOB once a plan of the 30% design is received. This will take HOB approximately 4 to 6 weeks to provide this information.	HDR R. Evangelista
5.3	For the tight cross-section adjacent to the watercourse at Mayfield Road, the pole could be placed behind the proposed barrier which would then need a 4m space behind the barrier to accommodate both the sidewalk and pole.	HDR
	Meeting adjourned at 3:45 PM	

## Noss, Melissa

---

**From:** Edgar Henriquez [Edgar.Henriquez@rci.rogers.com]  
**Sent:** Friday, August 13, 2010 9:19 AM  
**To:** Lamontagne, Larry  
**Subject:** RE: HWY 50 Rogers Utility Markup Request  
**Attachments:** M103726\_Hwy 50 from Mayfield Rd to Rutherford Rd\_HDR iTRANS.dwg; ATT00001..txt

**Follow Up Flag:** Follow up  
**Flag Status:** Completed

Hi Larry,  
Please find attached the mark-up drawing for the area under your study.  
Rogers has aerial fiber TV plant in this area.  
Rogers File M103726  
Thanks

**Edgar Henriquez**  
**Mark-up Coordinator GTAW**  
**OPE - GTA West**  
**Rogers Cable System Inc**  
**3573 Wolfedale Road**  
**Mississauga, On. L5C 3T6**  
**Tel: 905 897 6457**  
**Fax: 905 273 5233**

-----Original Message-----

**From:** Lamontagne, Larry [<mailto:Laurent.Lamontagne@hdrinc.com>]  
**Sent:** Wednesday, May 19, 2010 10:37 AM  
**To:** Edgar Henriquez  
**Cc:** Keen, Stephen; Glofcheskie, Chris  
**Subject:** HWY 50 Rogers Utility Markup Request

Hi Edgar

As per our conversation today please find attached the AutoCadd file of our EA study limits. Please markup all existing and future Rogers Cable plant.

Study limits:

- Hwy 50 (Mayfield Road to Rutherford Road)
- Mayfield Road (Hwy 50 to Coleraine Drive)

Could you please let me know the turnaround time for my request.

If you have any questions regarding my request please don't hesitate to contact me.

Thank you

**Larry Lamontagne. Dipl.T.**  
Transportation Designer

**HDR | iTRANS**

100 York Boulevard, Suite 300 | Richmond Hill, ON | L4B 1J8  
Phone: 905.882.4100 x 5348 | Fax: 905.882.1557 | Email: [llamontagne@itransconsulting.com](mailto:llamontagne@itransconsulting.com)  
[www.hdrinc.com](http://www.hdrinc.com)  
[www.itransconsulting.com](http://www.itransconsulting.com)

## Noss, Melissa

---

**From:** Keen, Stephen  
**Sent:** Thursday, May 20, 2010 4:28 PM  
**To:** McLaughlin, Barry  
**Cc:** Ngau, Guinevere  
**Subject:** FW: Notice of Public Information

**Follow Up Flag:** Follow up  
**Flag Status:** Completed

Barry - for your action  
Guin - fyi

---

**From:** Marilou Ignacio [mignacio@enersource.com]  
**Sent:** May 20, 2010 3:42 PM  
**To:** [solmaz.zia@peelregion.ca](mailto:solmaz.zia@peelregion.ca); [nick.colarusso@york.ca](mailto:nick.colarusso@york.ca); Keen, Stephen  
**Cc:** Dal Cheema  
**Subject:** Notice of Public Information

*Hello -*

*Effective immediately, please forward all Environmental Assessment Study notices to the same address c/o:*

*Mr. Dal Cheema, Senior Manager, Customer Engineering Department*

*Your cooperation is greatly appreciated.*



*M. B. (Lou) Ignacio / Project Coordinator, Customer Engineering / Tel: (905) 283-4088 / Fax: (905) 566-2737 / Email: [mignacio@enersource.com](mailto:mignacio@enersource.com)*

*3240 Mavis Road, Mississauga, Ontario L5C 3K1*



## Noss, Melissa

---

**From:** Keen, Stephen  
**Sent:** Monday, May 31, 2010 2:05 PM  
**To:** Lamontagne, Larry  
**Subject:** FW: 80058 - PROJECT 09-4390 - CLASS ENVIRONMENTAL ASSESSMENT STUDY - GENERAL LOCATION  
**Attachments:** ap\_AG128.pdf; ap\_MV3.pdf; ap\_MV4.pdf; ap\_MV5.pdf; ap\_MV6.pdf; ap\_MV7.pdf; ap\_MV8.pdf; 2007- 2008 Third Party Requirements .pdf

Larry  
Did you get all this info in your utilities search?

### Stephen Keen, M.Sc., P.Eng.

Senior Project Manager

### HDR | iTRANS

144 Front Street W, Suite 655 | Toronto, ON | M5H 2L7  
Phone: 416.847.0005 x 5557 | Fax: 416.857.3127 | Email: [stephen.keen@hdrinc.com](mailto:stephen.keen@hdrinc.com)  
[www.hdrinc.com](http://www.hdrinc.com)  
[www.itransconsulting.com](http://www.itransconsulting.com)

---

**From:** Zia, Solmaz [<mailto:Solmaz.Zia@peelregion.ca>]  
**Sent:** Monday, May 31, 2010 9:02 AM  
**To:** Keen, Stephen; McLaughlin, Barry  
**Subject:** FW: 80058 - PROJECT 09-4390 - CLASS ENVIRONMENTAL ASSESSMENT STUDY - GENERAL LOCATION

To be incorporated into the base plan

### Solmaz Zia, P.Eng.

Project Manager  
Transportation Program Planning  
Public Works, Region of Peel  
Tel: (905) 791-7800 ext. 7845  
[Solmaz.Zia@peelregion.ca](mailto:Solmaz.Zia@peelregion.ca)

---

**From:** Jamie Delaney [<mailto:Jamie.Delaney@enbridge.com>]  
**Sent:** May 25, 2010 10:27 AM  
**To:** Zia, Solmaz  
**Subject:** 80058 - PROJECT 09-4390 - CLASS ENVIRONMENTAL ASSESSMENT STUDY - GENERAL LOCATION

PROJECT 09-4390 - CLASS ENVIRONMENTAL ASSESSMENT STUDY - HWY 50 FROM  
CASTLEMORE RD/RUTHERFORD RD TO MAYFIELD RD/ALBION VAUGHAN; AND  
MAYFIELD RD FROM HWY 50 TO COLERAINE DR

Attached is the information you had requested.  
Should you require anything further please let me know.

Kind Regards,

Jamie Delaney  
Distribution Planning  
Enbridge Gas Distribution Inc  
500 Consumers Road  
4th Floor - Post A2 - VPC

North York, ON  
M2J 1P8  
Tel# 416-495-6321  
866-326-2924  
Fax# 416-758-4373  
[jamie.delaney@enbridge.com](mailto:jamie.delaney@enbridge.com)

-----  
Enbridge Gas Distribution cannot provide information regarding the depth of cover over our gas infrastructure. We suggest that a field locate be performed through Ontario One Call (1800 400-2255). If further details are still required, it is suggested that test holes be performed by an outside party in order to determine the actual Enbridge Infrastructure depth.

-----  
**NOTICE OF CONFIDENTIALITY:** This information transmitted is intended for the person or entity to which it is addressed and may contain confidential and / or privileged material. Any review, re-transmission, dissemination or other use of, or taking of any action in reliance upon, this information by persons or entities other than the intended recipient is prohibited. If you received this in error, please contact the sender immediately by return electronic transmission and then immediately delete this transmission, including any attachments, without copying, distributing or disclosing same.

## Noss, Melissa

---

**From:** Keen, Stephen  
**Sent:** Friday, October 15, 2010 3:44 PM  
**To:** Lamontagne, Larry  
**Subject:** Fw: Highway 50 EA - Request for Gasmain Installation  
**Attachments:** Enbridge 1.TIF; Enbridge 2.TIF; Enbridge 3.TIF

**Follow Up Flag:** Follow up  
**Flag Status:** Flagged

Fyi

---

**From:** Chiu, Edward [<mailto:Edward.Chiu@york.ca>]  
**Sent:** Friday, October 15, 2010 01:56 PM  
**To:** Zia, Solmaz <[Solmaz.Zia@peelregion.ca](mailto:Solmaz.Zia@peelregion.ca)>; Keen, Stephen  
**Cc:** Scott, Christopher <[Christopher.Scott@york.ca](mailto:Christopher.Scott@york.ca)>; Qiu, Julie <[Julie.Qiu@york.ca](mailto:Julie.Qiu@york.ca)>  
**Subject:** Highway 50 EA - Request for Gasmain Installation

Solmaz/Steve,

Attached please proposed gasmain installation from Enbridge. As per the current agreement, Peel Region is the responsible proponent for utility coordination and approvals with York Region providing input. We will inform Enbridge accordingly.

I will find out from others if there are any comments and forward them to you.



<<Enbridge 1.TIF>> <<Enbridge 2.TIF>> <<Enbridge 3.TIF>>

**Edward Chiu, P.Eng.**  
*Sr. Project Manager  
Capital Delivery - Roads  
Transportation Services*

**The Regional Municipality of York**  
90 Bales Dr. E.  
East Gwillimbury, Ont. L0G 1V0  
P# 905-830-4444 x5908  
F# 905-836-4590  
email: [edward.chiu@york.ca](mailto:edward.chiu@york.ca)

Plate: MV2

Plate: MV1B

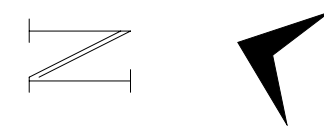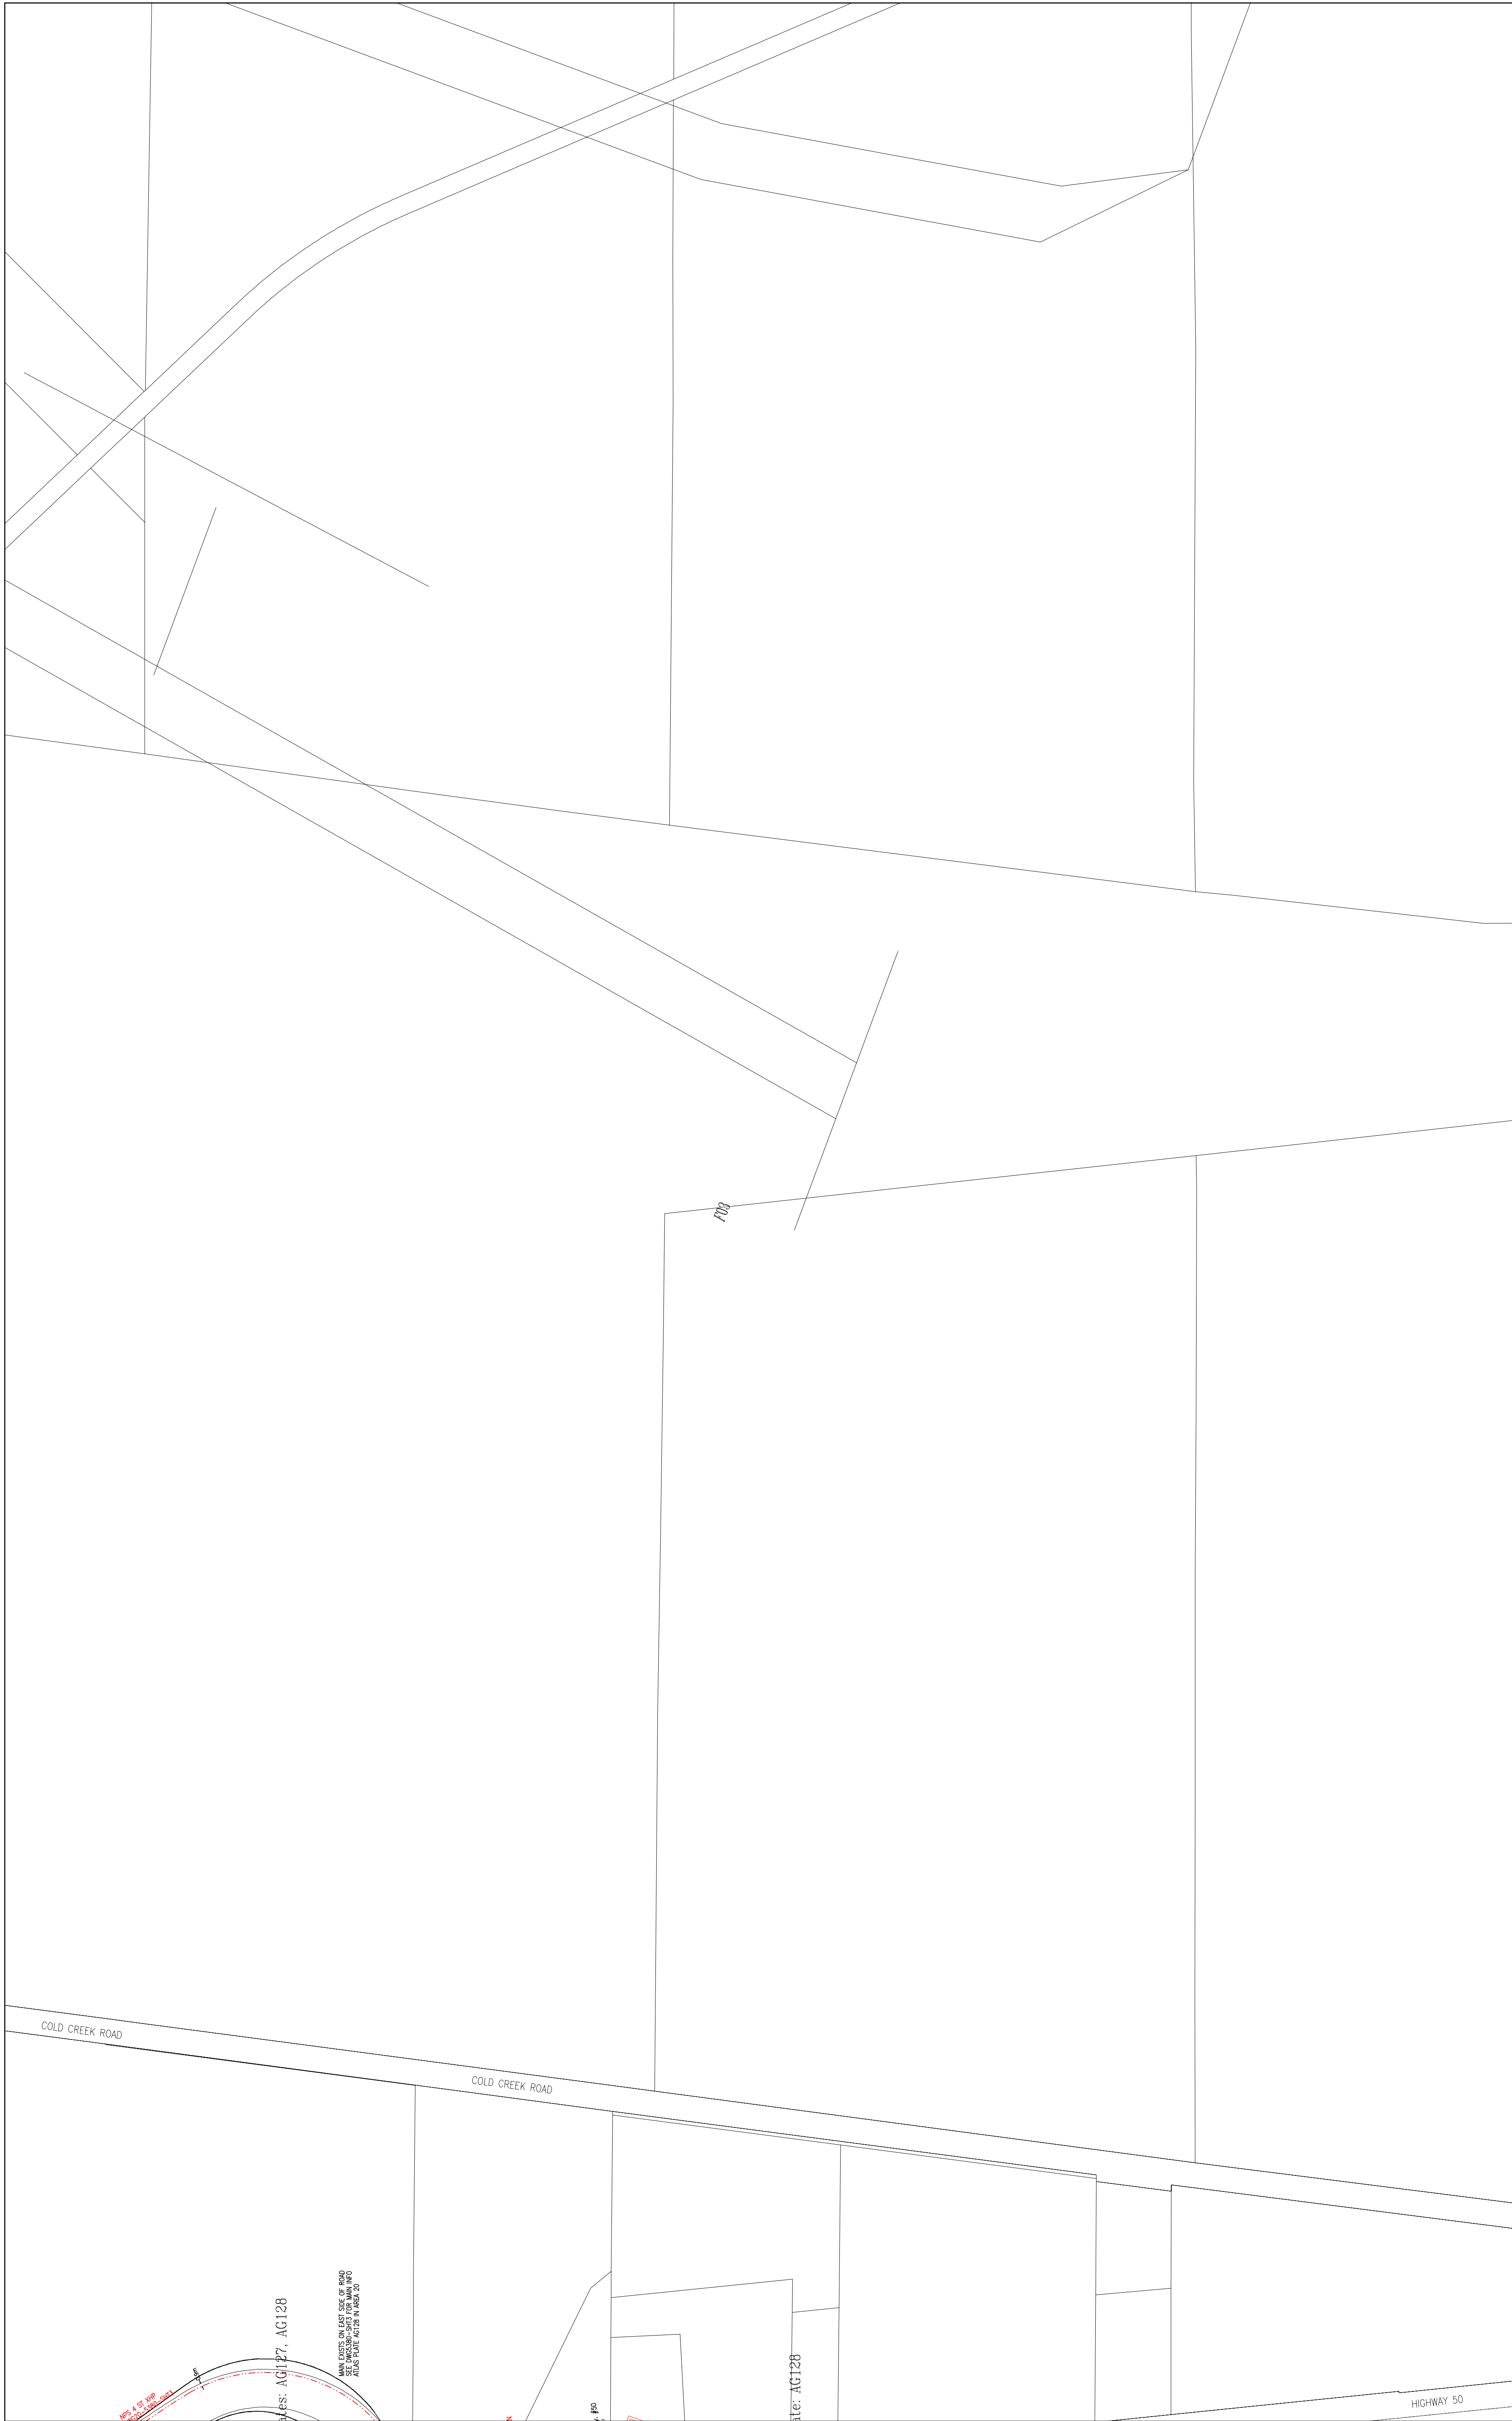

Network Numbers and Pressure Types:  
2182-XHP

Plate: MV4

Atlas Plate Record

Plotted By: Amy Brenham	Date of Last Revision: 2006 Dec 01	Date Plotted: 2006 Dec 05
Scale: 1:2400	Revised By: hameeda	Plate Number: MV3
	Region: Area 20 - Mis	

Plate: MW3

Plate: MV19


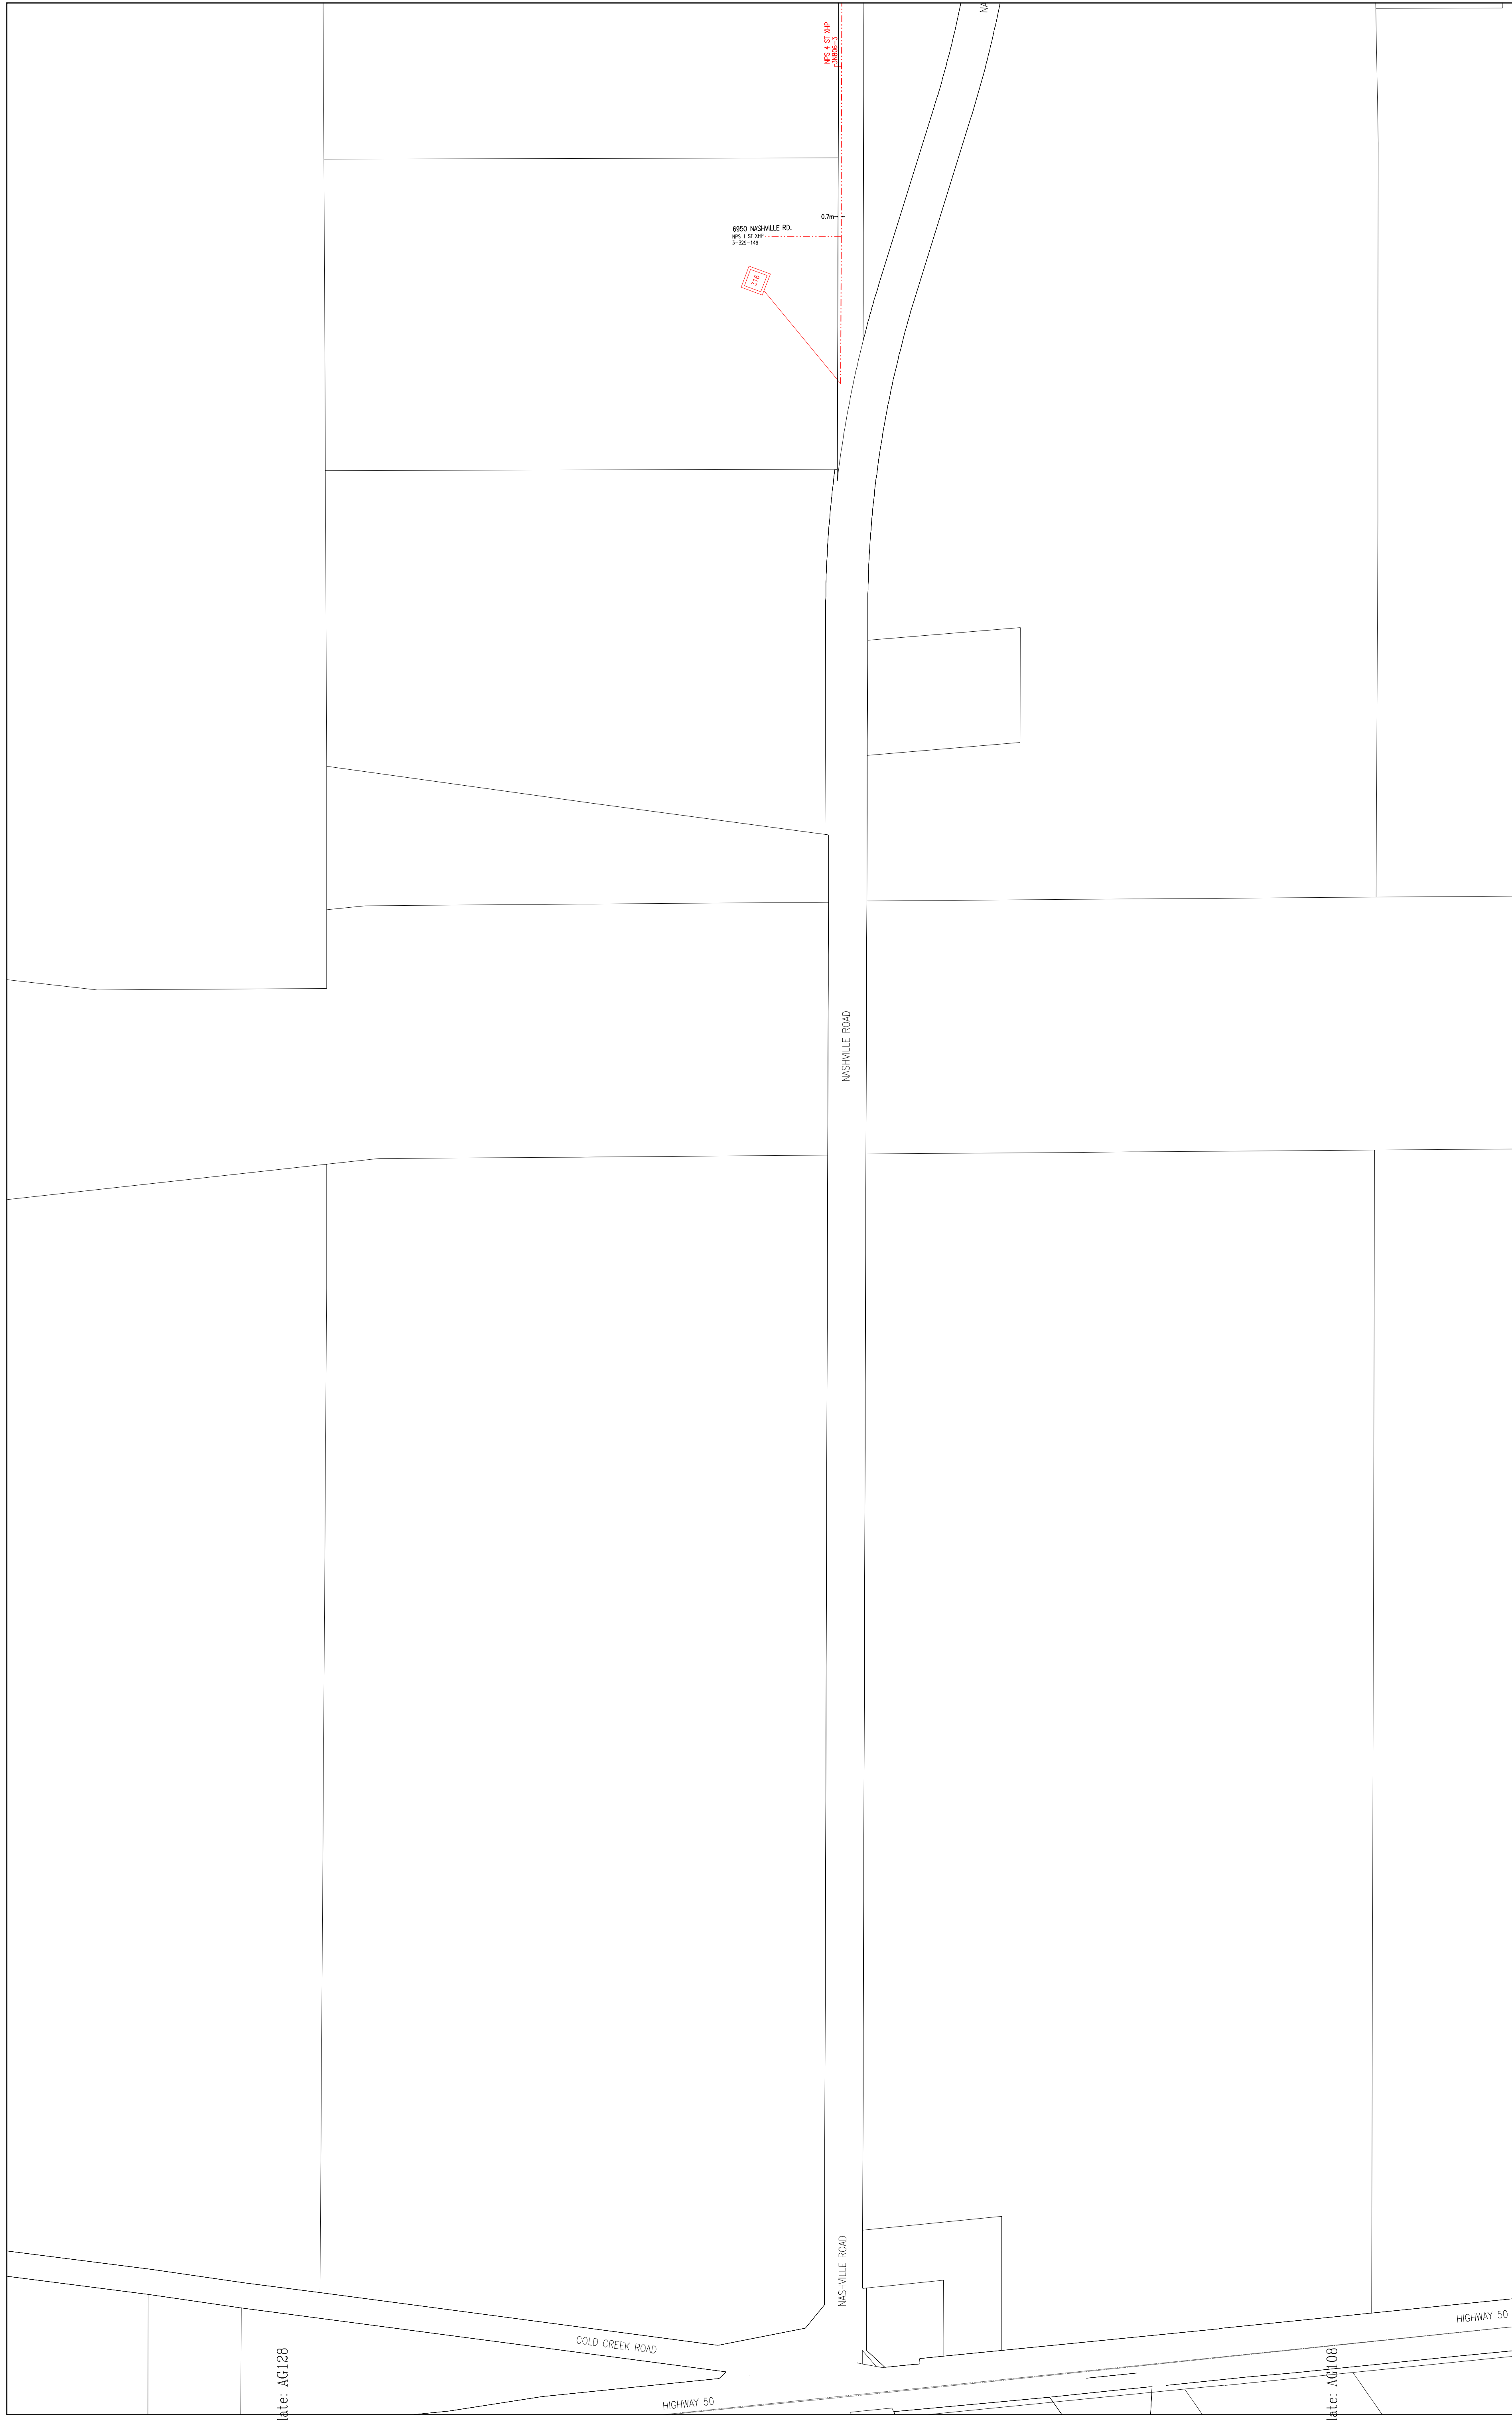


Plate: AG128

Plate: AG108

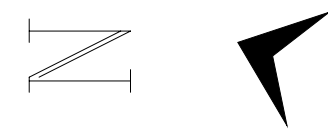

Network Numbers and Pressure Types:  
2182-XHP

Plate: MV5


### Atlas Plate Record

Plotted By: Amy Brenham	Date of Last Revision: 2006 Dec 01	Date Plotted: 2006 Dec 05
Scale: 1:2400	Revised By: hameeda	Plate Number: MV4
	Region: Area 20 - Mis	



Plate: MV4

Plate: MV20

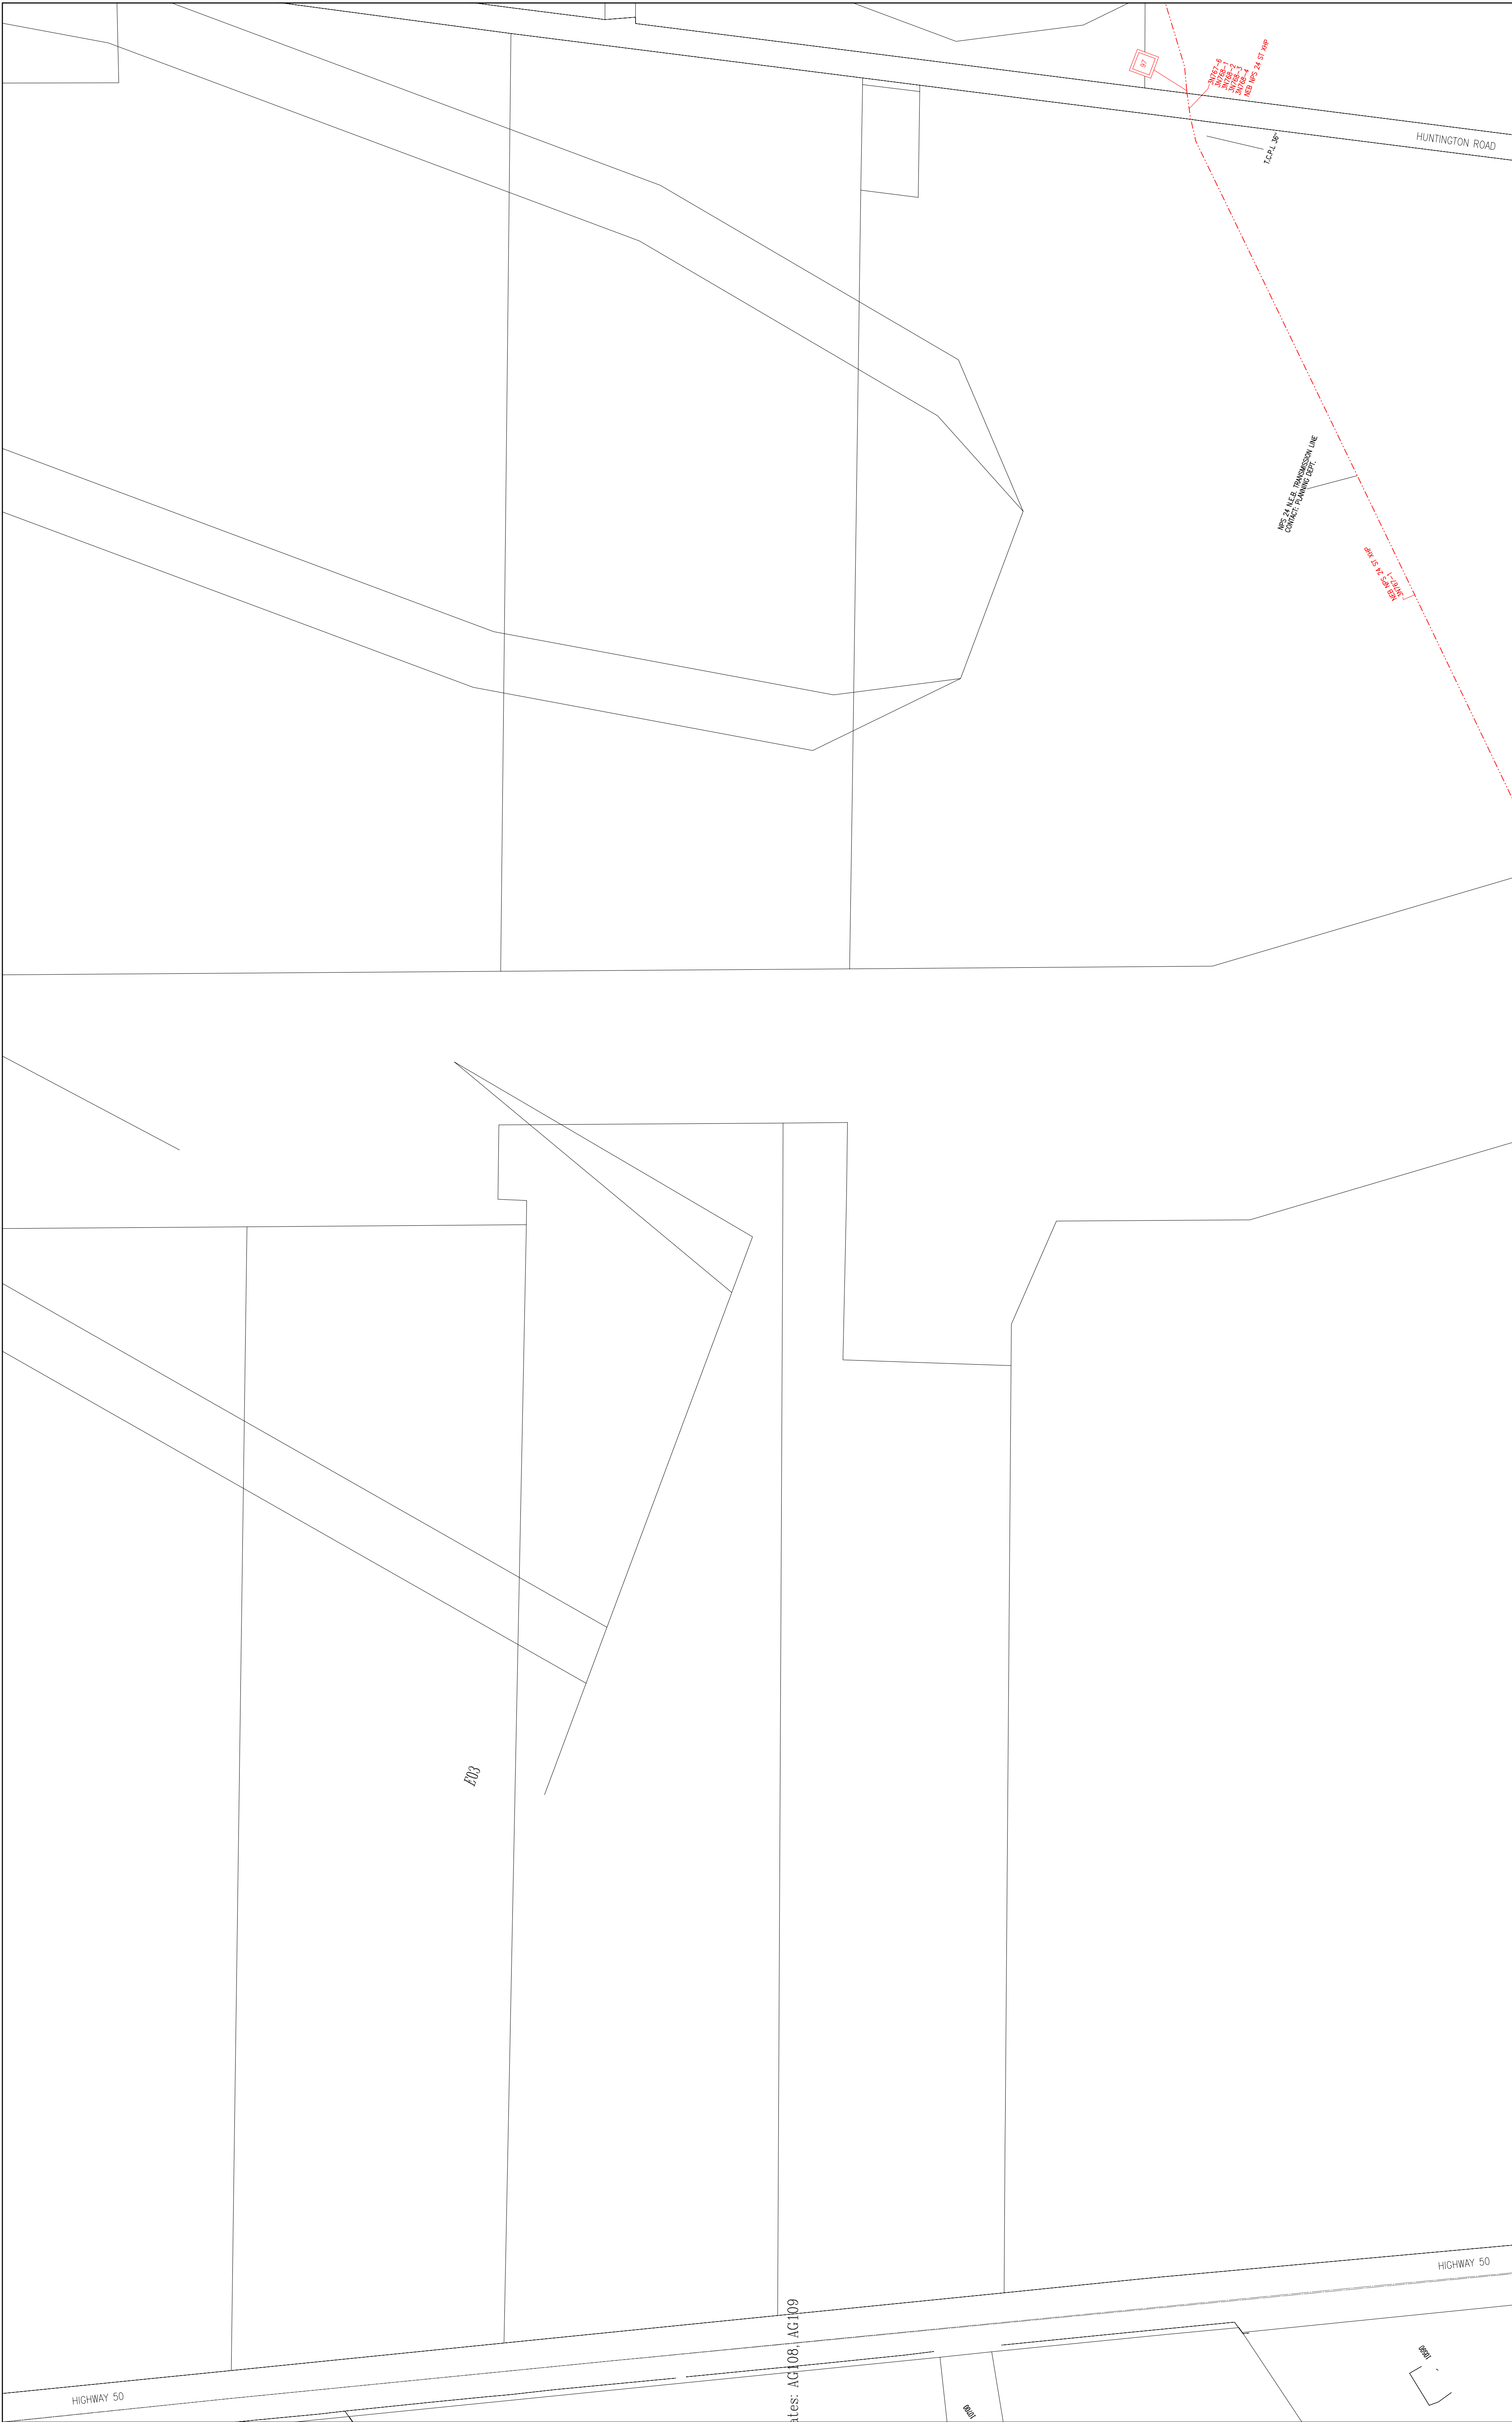

Plates: AG108, AG109


Plate: MV6


### Atlas Plate Record

Plotted By:	Any Brenham	Date of Last Revision:	2006 Dec 01	Date Plotted:	2006 Dec 05
Scale:	1:2400	Revised By:	hameeda	Plate Number:	MV5
		Region:	Area 20 - Mis		



Network Numbers and Pressure Types:  
2182-XHP

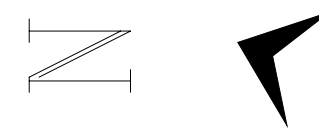

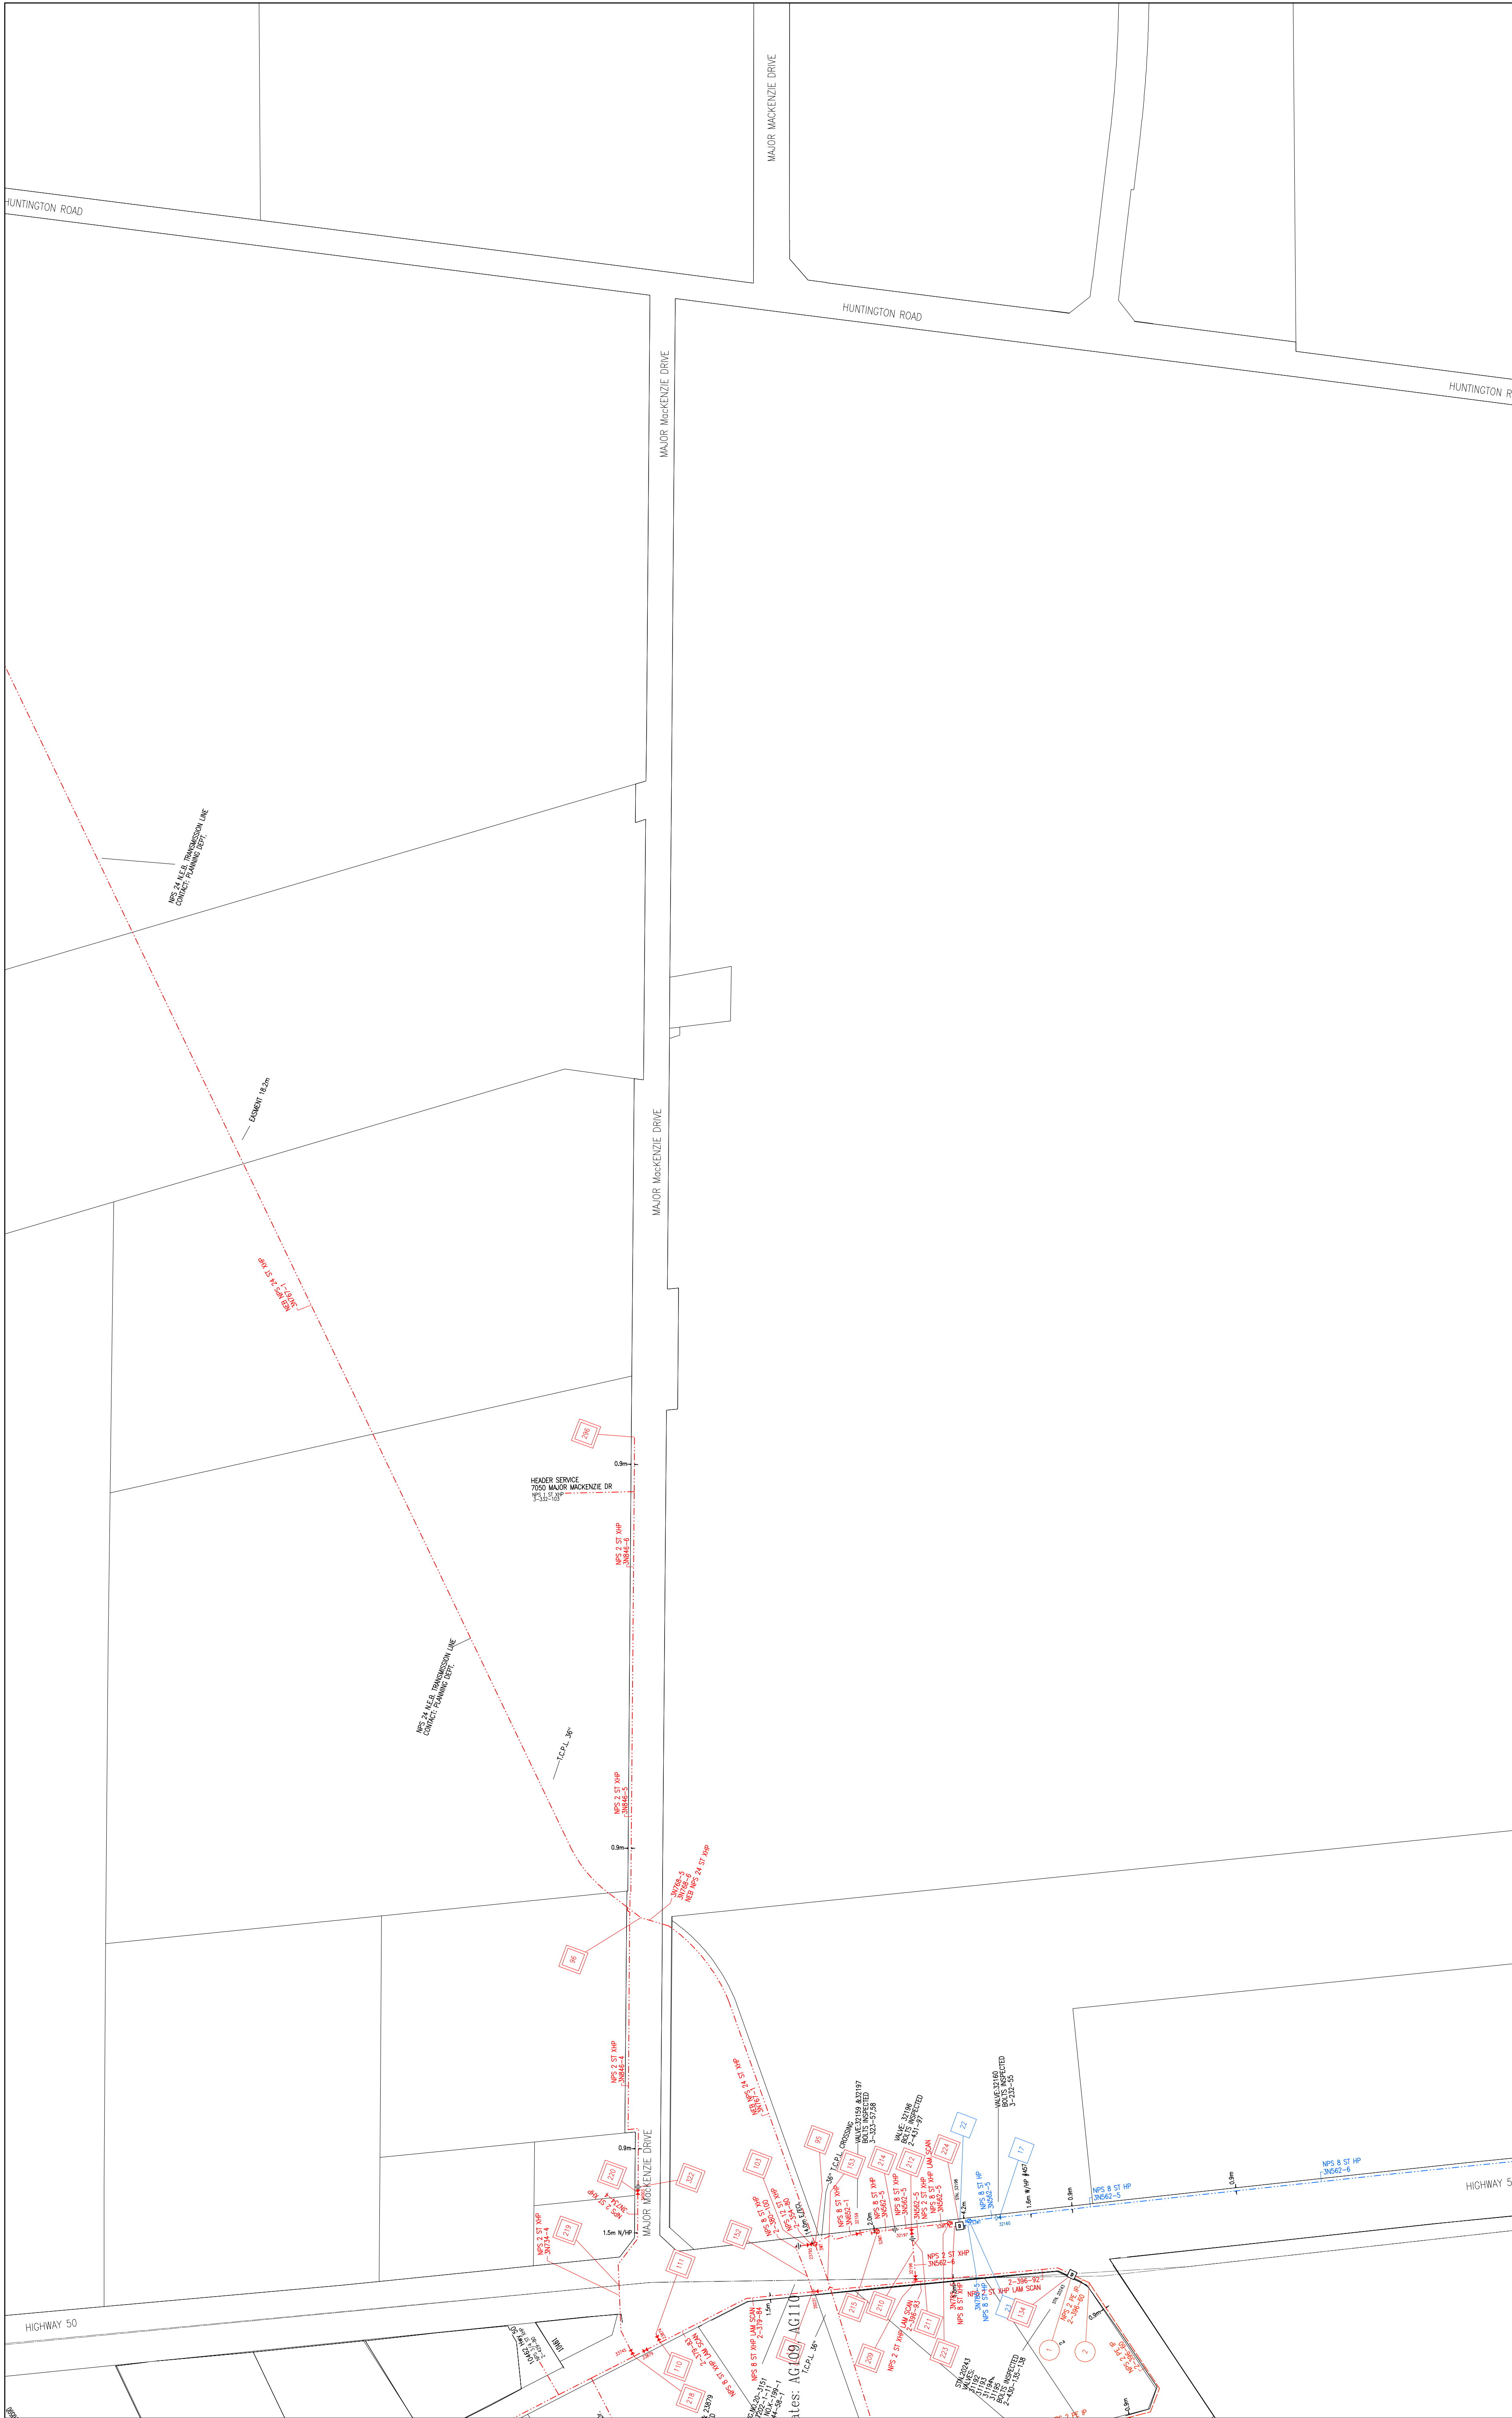



### Atlas Plate Record

Plotted By:	Any Brenham	Date of Last Revision:	2006 Dec 01
Scale:	1:2400	Revised By:	hameeda
		Region:	Area 20 - Mis
		Plate Number:	MV6
		Date Plotted:	2006 Dec 05




Network Numbers and Pressure Types:  
2182-XHP 3983-HP

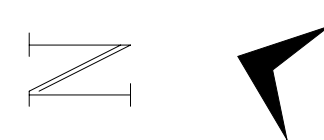

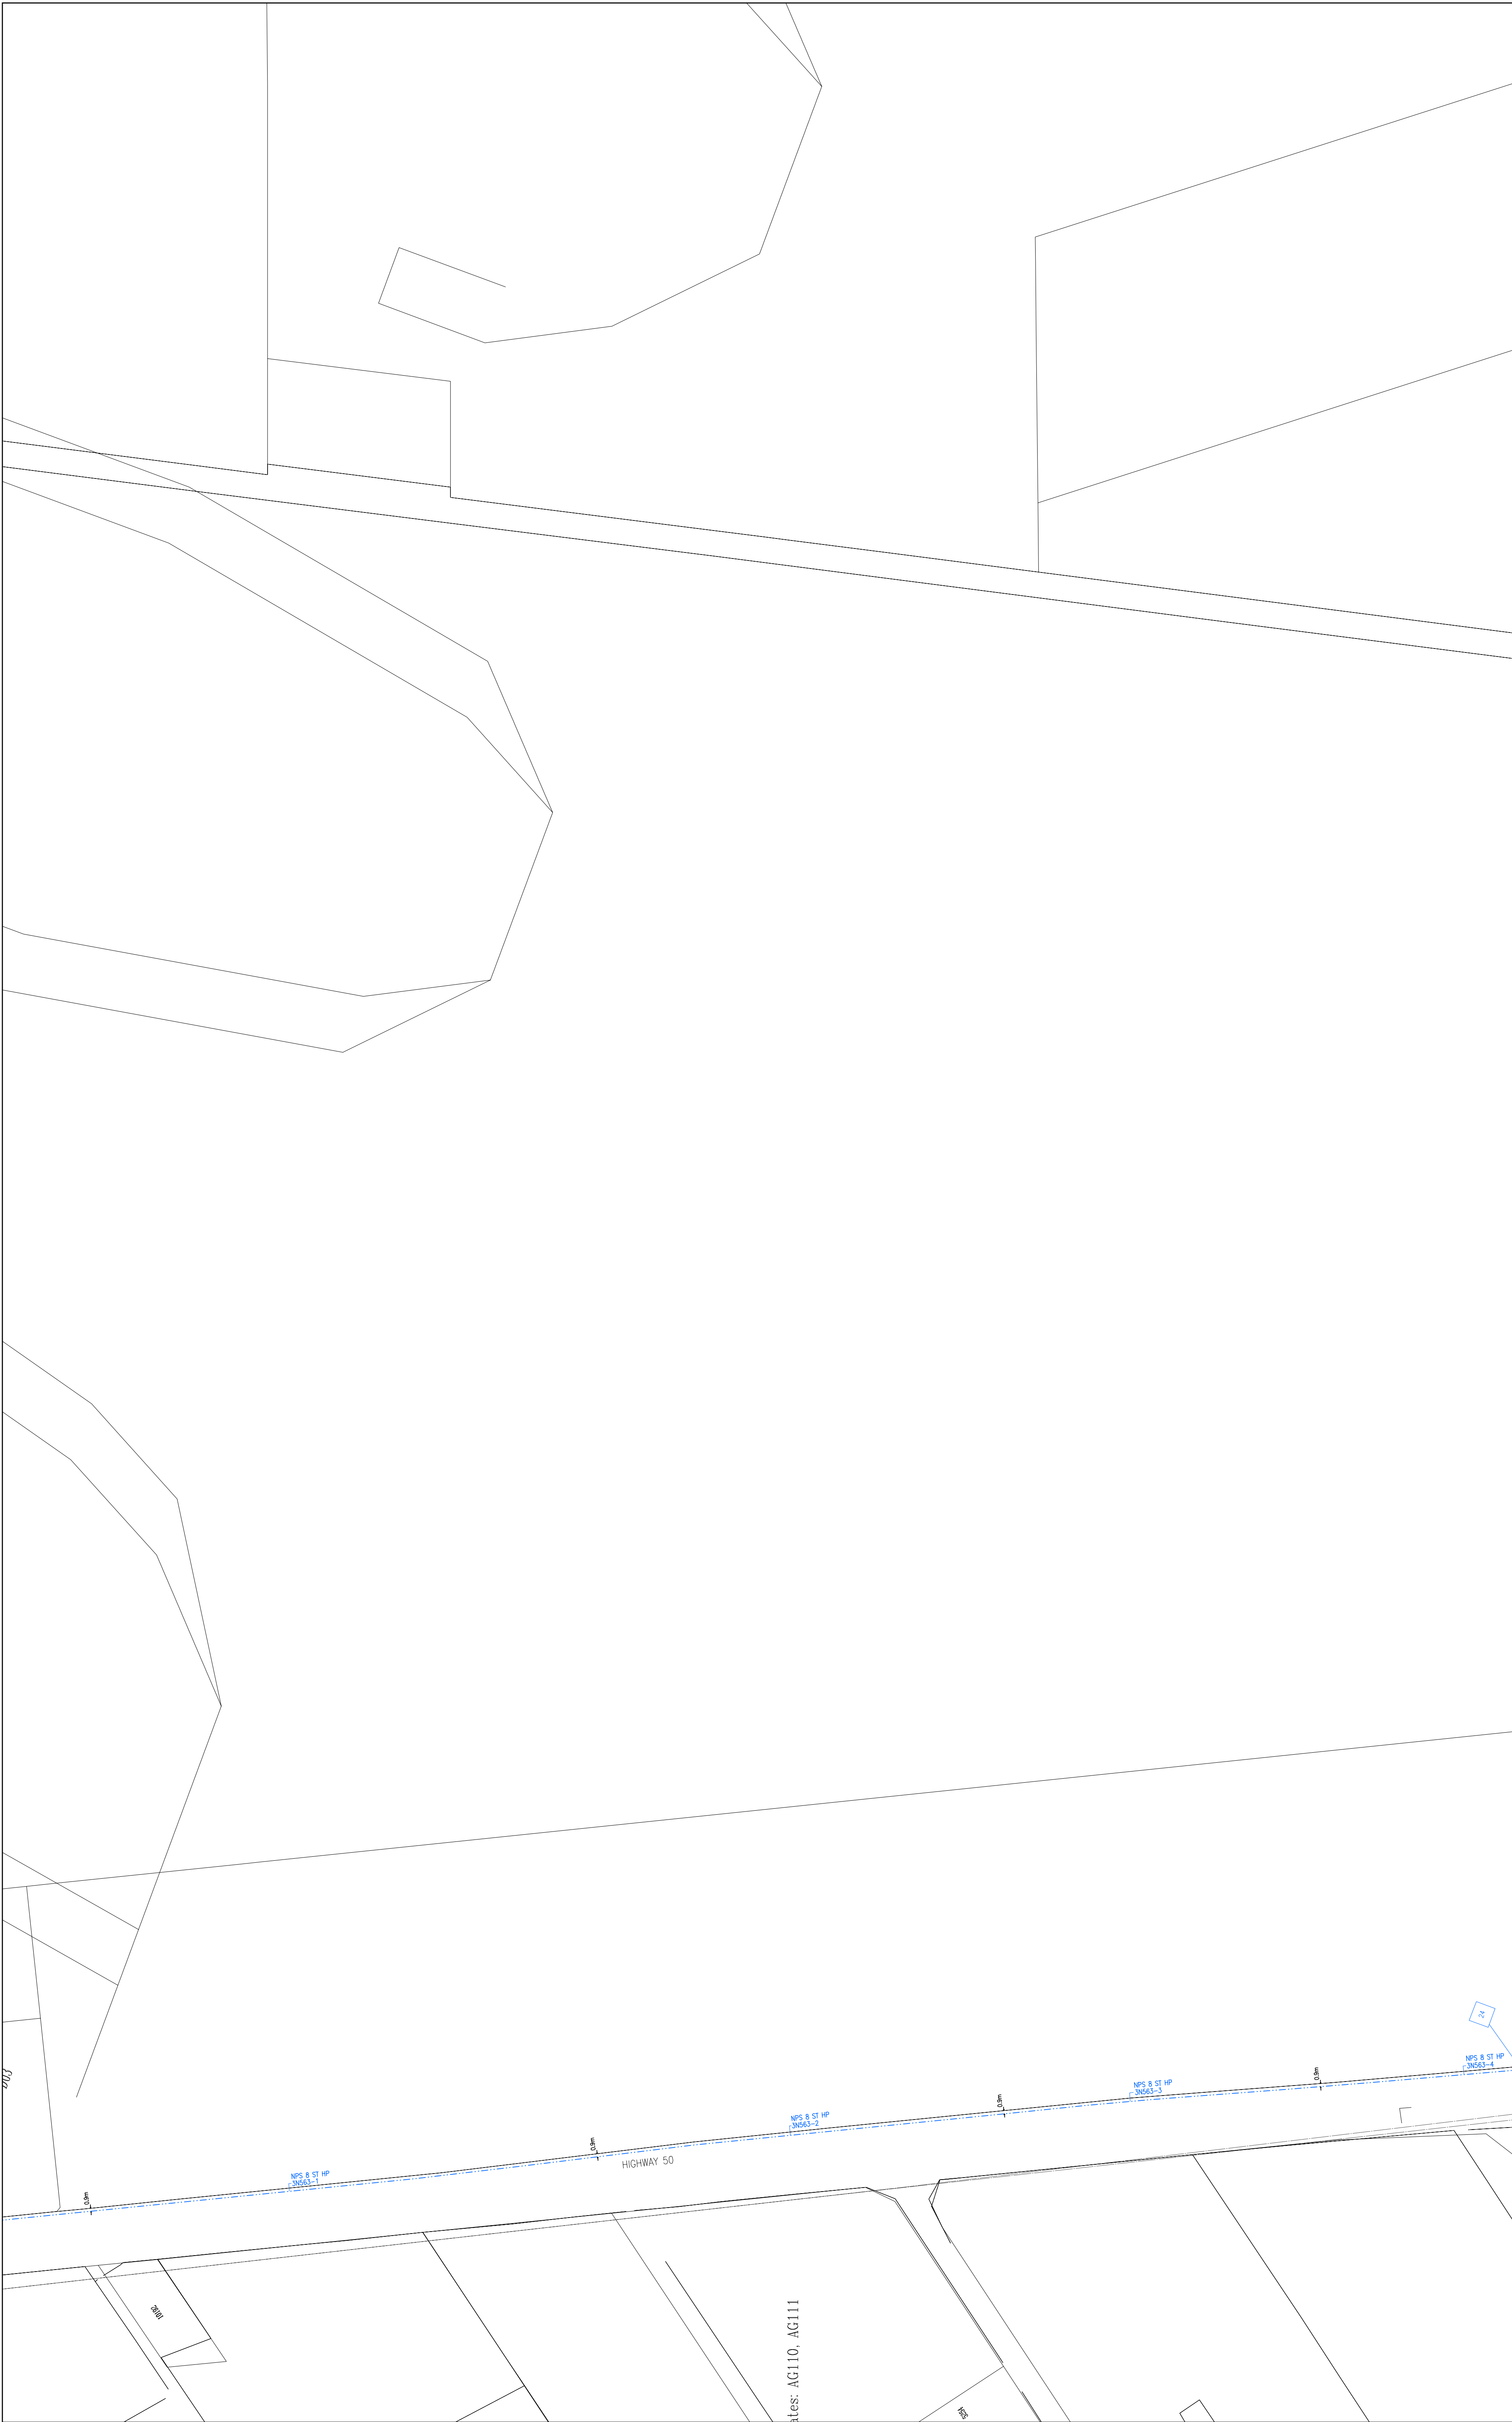

Plates: AG110, AG111

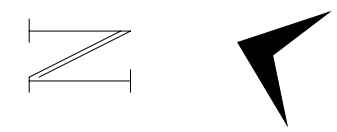

Network Numbers and Pressure Types:  
3983-HP

Plate: MV8



### Atlas Plate Record


Plotted By:	Any Brenham	Date of Last Revision:	2006 Dec 01	Date Plotted:	2006 Dec 05
Scale:	1:2400	Revised By:	hameeda	Plate Number:	MV7
		Region:	Area 20 - Mis		







Plate: AG107

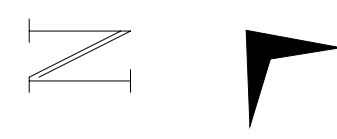


Network Numbers and Pressure Types:  
2182-XHP

Plates: MV4, MV3

### Atlas Plate Record

Plotted By:	gissys	Date of Last Revision:	2010 Feb 10
Scale:	1:2400	Revised By:	zakm
		Region:	Area 20 - Mis
		Plate Number:	AG128
		Date Plotted:	2010 Feb 11

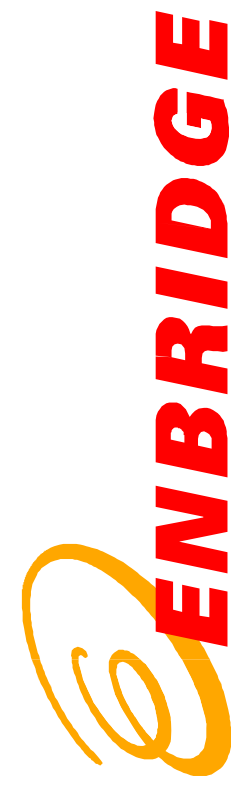



## **Third Party Requirements**

### **In the Vicinity of**

#### **Natural Gas Facilities**

- **General Requirements**
- **Support of Gas Pipelines**
- **Blasting Requirements**
- **Pile Driving or Compaction Requirements**
- **Heavy Equipment Operation in the Vicinity of Gas Pipelines**

**October 2007**



APPENDIX "A"

REGIONAL CONTACT LIST

ENBRIDGE GAS DISTRIBUTION

500 Consumers Road  
North York, ON M2J 1P8

Markups mark-ups@enbridge.com  
Mail to: Distribution Planning  
Ontario One Call Locates: 1 (800) 400-2255  
Damage Prevention: 1 (866) 922-3622

**Emergency: 1 (866) 763-5427**

ENBRIDGE GAS STORAGE

P. O. Box 520  
3595 Tecumseh Road  
Mooretown ON N0N 1M0

Ontario One Call Locates: 1 (800) 400-2255  
Engineering Dept.: 1 (519) 862-6015

**Emergency: 1 (800) 255-1431**

GAZIFÈRE

706 Boulevard Greber,  
Gatineau QC  
J8V 3P8

Locates: 1 (800) 663-9228  
Planning Dept.: 1 (819) 771-8321 X-2449

**Emergency: 1 (819) 771-8321**

ST. LAWRENCE GAS

COMPANY LTD.

33 Stearns Street,  
P.O. Box 270  
Massena, NY. 13662

Locates: 1 (315) 769-3511  
Planning Dept.: 1 (315) 769-3516 x 174

**Emergency: 1 (315) 769-3511**

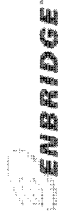


TABLE OF CONTENTS

Page

1.0	DEFINITIONS	4
2.0	GENERAL REQUIREMENTS	5
2.1	Working in the Vicinity of Gas Pipelines	5
2.2	Support of Pipelines Required at all times	6
2.3	Encroachment	6
2.4	Tree Planting	7
2.5	Minimum Clearance from other Structures	8
2.6	Minimum Cover Requirements	8
2.7	Points of Thrust	8
2.8	Repairs of Damaged Pipe and Pipe Coating	8
2.9	Blasting, Pile Driving or Compaction	8
3.0	SUPPORT OF GAS PIPELINES	10
3.1	Trenching Parallel to Gas Pipelines	10
3.2	Minimum Requirements	10
3.3	Support of Pipelines Crossing Trench	10
3.3.1	Temporary Support	10
3.3.2	Cast Iron Pipelines	12
3.3.3	Steel and Polyethylene Pipelines	12
3.4	Support of Pipelines Parallel to trench	12
3.4.1	General	12
3.4.2	Cast Iron Pipelines	14
3.4.3	Steel and Polyethylene Pipelines	14
4.0	BLASTING REQUIREMENTS	17
4.1	Policy	17
4.2	Notification Requirements	18
4.2.1	Surface Blasting Application	18
4.2.2	Tunnel Blasting Application	18
4.3	Evaluation by Enbridge Gas Distribution	19
4.3.1	Ground Water Monitoring	20
4.4	Guidelines for Blasting	20
4.5	Post Blasting Operations	21
5.0	PILE DRIVING OR COMPACTION REQUIREMENTS	23
5.1	Policy	23
5.2	Pile Driving or Compaction Application	23
5.3	Evaluation by Enbridge Gas Distribution	24
5.4	Guideline for Pile Driving or Compaction	25
5.5	Post Piling or Compaction Operations	27
5.6	Soil Types	30

**TABLE OF CONTENTS**

**Page**

**6.0 HEAVY EQUIPMENT OPERATION IN THE VICINITY OF GAS PIPELINES**

- 6.1 General
- 6.2 Equipment Moving Across Pipeline
- 6.3 Equipment Moving Along the Pipeline
- 6.4 Compaction Equipment Restrictions
- 6.5 General Vehicles External Loading Restrictions

31  
31  
32  
32  
32

**6.3**

**EQUIPMENT MOVING ALONG THE PIPELINE**

Heavy equipment may be operated parallel to existing pipelines provided that a minimum offset of 1.0 m is maintained on pipeline sizes less than NPS 12 and 2.0 m on pipelines NPS 12 and larger unless otherwise directed by Enbridge Gas Distribution.

Only lightweight rubber tired equipment shall be operated directly over existing gas pipelines unless a minimum pipe cover of twice the pipe diameter or 1.0 m (whichever is greater) can be verified.

When working directly over existing gas pipelines, all equipment movements shall be transverse to the staked location rather than parallel to it.

**6.4**

**COMPACTION EQUIPMENT RESTRICTIONS**

Mechanical equipment shall not be operated within 0.3 m of the pipeline.

Hand held compaction equipment shall be used within 1.0 m of the sides or top of all gas pipelines.

Heavier compaction equipment may be used once the pipe cover equals the greater of twice the diameter or 1.0 m.

**6.5**

**GENERAL VEHICLE EXTERNAL LOADING RESTRICTIONS**

For most vehicles, other than heavy construction equipment discussed above, external loading will not be factor because the standard Enbridge Gas Distribution pipeline cover requirements provide sufficient protection.

In cases where extreme loading is likely to occur, the following table provides vehicle load restrictions based on the depth of cover of pipe. If the loads exceed these, or if there are additional concerns, the contact name listed in the permit application should be contacted to specify required precautions and/or perform any loading calculation.

Since the depth of cover is important, if the depth is questionable, the pipeline should be located by hand. During wet weather conditions, increasing the amount of cover should be considered due to the rutting over the main.

**Table No. 7**

<b>Weight / Axle Maximum Allowable Load (kg)</b>	
Cast Iron (CI)	Steel (ST)
12,000	12,000
	7,000
	Plastic (PE)
	7,000

Vehicle Load Restrictions Based on Minimum Depth of 0.6 m.

**Page**

8  
11  
11  
13  
22  
29  
32

**TABLES**

- Table No. 1 Minimum Cover Requirements
- Table No. 2 Maximum Span Without Support Beam
- Table No. 3 Support Beam Sizes
- Table No. 4 Minimum Allowed Distance From Pipeline to Excavation
- Table No. 5 Stand-Off Distance for Blasting Near Polyethylene and Steel Facilities
- Table No. 6 Maximum Vibration Intensities Expected From Pile Driving in Dry and Wet Sand and Clay
- Table No. 7 Weight/Axle Maximum Allowable Load

**DRAWINGS**

- Dwg. No. 1 Support of Cast or Wrought Iron Gas Pipelines Crossing Excavations
- Dwg. No. 2 Support of Plastic or Steel Gas Pipelines Crossing Excavations
- Dwg. No. 3 Influence Lines for Gas Pipelines Adjacent to Excavations

**FIGURES**

- Figure 1 Root Deflector
- Figure 2 Ground Vibrations from Pile Driving

**APPENDIX**

- Appendix A REGIONAL CONTACT LIST

15  
15  
16

7  
28

33

## 6.0 HEAVY EQUIPMENT OPERATION IN THE VICINITY OF GAS PIPELINES

### 6.1 GENERAL

This information is presented as a guideline to cover precautions necessary when heavy construction equipment (gross weight greater than 10 tonnes) is to be operated in the vicinity of buried pipelines where no pavement exists or where grading operations are taking place.

Prior to any crossing, the location of the gas plant must first be located by an Enbridge Gas Distribution representative.

The excavator/constructor is responsible for confirming the location and depth of the gas plant by having test holes excavated as necessary with respect to the local conditions but not more than 50 m intervals.

### 6.2 EQUIPMENT MOVING ACROSS THE PIPELINE

Crossing locations for heavy equipment are to be kept a minimum.

The crossing locations shall be determined between the Enbridge Gas Distribution representative and the excavator/constructor. The crossing location shall be based on the following:

- Nature of the construction operations
- The types and number of equipment involved
- Pipeline material and depth

Once the predetermined crossing locations have been established, heavy equipment must be restricted to crossing at these locations only. It is the responsibility of the excavator/constructor to inform their personnel of the crossing location restrictions.

Gas plants shall be protected from possible damage at crossing locations at all times. The protection can be provided by constructing berms over the staked lines unless minimum cover of twice the pipe diameter or 1.0 m (whichever is greater) has been verified.

Equipment shall be operated at “dead slow “ speeds when crossing pipelines to minimize impact loading.

## 1.0 DEFINITIONS

Terms used in the following Guideline are defined as follows unless otherwise specified:

Company	- Enbridge Gas Distribution Inc. or any of its representatives
LDC	- Local Distribution Company
Contractor or Excavator	- Any individual, partnership, corporation, public agency or other entity that dig, bore, trench, grade excavate or break ground with mechanical equipment or explosives in the vicinity of a gas pipeline or related facility.
Facility	- Defined as any Enbridge Gas Distribution Inc. Company Pipeline (main or service), regulator station or storage facility and their related components
Pile	- Any vertical or slightly slanted structural member introduced or constructed in the soil in order to transmit loads and forces from the superstructure to the subsoil; the structural member can also be used as a component of a retaining wall system
Pile Driving	- The placement of piles carried out by gravity hammer, vibratory hammer, auguring, pressing, screwing or any combinations of the above methods
Surface Blasting	- An operation involving the excavation of rock foundations for various types of structures, grade construction for highways or railroads, canals (trenches) for water supply or collection purposes.
Tunnel Blasting	- Operations involving the piercing of below ground (generally horizontal) opening in rock.
Blaster	- The person or persons responsible for setting the charges and performing the blast.
Applicant	- The owner of the proposed work
Compaction	- Any vibration generating operation which will result in a potential increase of the density of soils or controlled backfill materials. The means to increase the density may be static or dynamic
Engineer, Independent blasting consultant	- A Professional Engineer who is registered as a member of the Professional Engineers of Ontario (PEO) and a holder of Certificate of Authorization (C of A)
Construction Operations	- Activities associated with excavation, blasting, piling or compaction
Vicinity	- A horizontal distance of 30 meters, or less, from any Enbridge Gas Distribution Inc. natural gas facility (above-ground or below-ground)

## 2.0 GENERAL REQUIREMENTS

### 2.1 WORK IN THE VICINITY OF GAS PIPELINES

All work in the vicinity of gas pipelines must be approved by Enbridge Gas Distribution (the "Company").

All work within 30.0 metres of an NEB operated pipeline right-of-way must have the approval from Enbridge. This is a requirement of all NEB pipelines, which are under the jurisdiction of the National Energy Board, and follows the NEB Pipeline Crossing Regulations.

A stake out of the gas pipeline must be requested prior to any Construction. Call Ontario One Call at 1-800-400-2255 or 905-709-1717 at least 48 hours in advance of the proposed work.

Mechanical equipment shall not be operated within 0.3 m of the pipeline. Hand Excavation shall be performed when locating and digging within 0.3 m of the pipeline.

Mechanical excavation is not permitted within 3.0 m of the NEB or Vital pipelines without the approval of Enbridge.

Hand held compaction equipment shall be used within 1.0 m of the sides or top of all gas pipelines.

Spoil from excavation shall not be piled on the gas pipeline. This blocks access to the gas pipeline in the event that maintenance or operations activities are required on the pipeline.

The gas pipeline must be inspected for damage before backfilling the excavation.

It is the excavator's responsibility, under Section 18 and 19 of the Energy Act to ensure the gas pipeline(s) is not undermined or endangered in any way.

### 2.2 SUPPORT OF PIPELINES REQUIRED AT ALL TIMES

It is the responsibility of the Contractor to ensure that existing underground plant is properly supported.

Precautions must be taken to support underground plant at all times and to prevent damage to gas pipelines due to excavation activities. Inadequate support damages underground plant and can result in the escape of natural gas, constituting a hazard to persons and property.

When excavation is necessary over, under, near or parallel to underground Gas plant, the support is the responsibility of the excavator. The methods of support

## 5.6 SOIL TYPES

### (Occupational Health and Safety Act And Regulations for Construction Projects)

(1) For the purposes of this Part, soil shall be classified as Type 1, 2, 3, or 4 in accordance with the descriptions set out in this section.

#### (2) Type 1 Soil

- a) is hard, very dense and only able to be penetrated with difficulty by a small sharp object;
- b) has a low natural moisture content and a high degree of internal strength;
- c) has no signs of water seepage; and
- d) can be excavated only by mechanical equipment.

#### (3) Type 2 Soil

- a) is very stiff, dense and can be penetrated with moderate difficulty by a small sharp object;
- b) has a low to medium natural moisture content and a medium degree of internal strength; and
- c) has a damp appearance after it is excavated.

#### (4) Type 3 Soil

- a) is stiff to firm and compact to loose in consistency or is previously excavated soil;
- b) exhibits signs of surface cracking;
- c) exhibits signs of water seepage;
- d) if it is dry, may run easily into a well-defined conical pile; and
- e) has a low degree of internal strength.

#### (5) Type 4 Soil

- a) is soft to very soft and very loose in consistency, very sensitive and upon disturbance is significantly reduced in natural strength;
- b) runs easily or flows, unless it is completely supported before excavating procedures;
- c) has almost no internal strength;
- d) is wet or muddy, and
- e) exerts substantial fluid pressure on its supporting system.



Table No. 6

MAXIMUM VIBRATION INTENSITIES EXPECTED FROM PILE DRIVING IN DRY AND WET SAND AND CLAY

E/D	Particle Velocity in/s		CLAY
	DRY SAND	WET SAND	
0.10	0.02	0.03	-----
0.22	0.04	0.06	0.01
0.30	0.05	0.08	0.02
0.40	0.07	0.11	0.04
0.50	0.08	0.13	0.04
0.60	0.10	0.18	0.05
0.70	0.11	0.20	0.06
0.80	0.13	0.23	0.08
0.90	0.16	0.27	0.09
1.00	0.18	0.29	0.10
2.00	0.33	0.59	0.30
3.00	0.56	0.88	0.58
4.00	0.70	1.10	0.89
5.00	0.88	1.40	1.10
6.00	1.05	1.85	1.80 Acceptable
7.00	1.10	2.01	2.01 Unacceptable
8.00	1.40	2.30	2.40
9.00	1.75	2.80	3.10
10.00	1.85	2.90	3.40

E/D	Particle Velocity mm/s		CLAY
	DRY SAND	WET SAND	
0.10	0.43	0.74	-----
0.22	0.97	1.50	0.25
0.30	1.27	1.27	0.43
0.40	1.75	2.80	0.66
0.50	2.06	3.30	1.02
0.60	2.54	4.57	1.27
0.70	2.80	5.08	1.52
0.80	3.30	5.84	1.96
0.90	4.06	6.86	2.29
1.00	4.57	7.37	2.54
2.00	8.38	14.99	7.62
3.00	14.22	22.35	14.73
4.00	17.78	27.94	22.61
5.00	22.35	35.56	27.94
6.00	26.67	46.99	45.72 Acceptable
7.00	27.94	50.80	50.80 Unacceptable
8.00	35.56	58.42	60.96
9.00	44.45	71.12	78.74
10.00	46.99	73.66	86.36



vary from case to case depending on the characteristics of the excavation, adjacent soil and the pipeline material. Failure to provide proper support will render the excavator responsible for all consequential damage or loss. (Refer to Section 3.0, Support of Gas Pipelines, for details on supporting the gas pipeline.)

2.3 ENCROACHMENT

Permanent awnings and roof structures are prohibited above gas pipelines within the public right-of-way, or within the Company's right-of-way. Enbridge Gas Distribution will not accept responsibility for any damages to the encroaching structure within the public right-of-way, or within the Company's right-of-way, if it is necessary for the maintenance or operation of the existing underground plant or to install new underground facilities in the future.

2.4 TREE PLANTING

For pipelines regulated by the NEB and Vital Mains (identified as critical pipelines), trees or large shrubs must have a minimum lateral clearance between the edge of the root ball or open bottom container and adjacent edge of the existing pipeline of not less than 2.5 m (8 feet).

For all other pipelines, a minimum clearance of 1.2 m (4 feet) horizontally must be maintained between the edge of the root ball or open bottom container and adjacent edge of the existing gas pipeline

In cases where 1.2 m (4 feet) clearance cannot be maintained, a minimum clearance of 0.6 m (2 feet) can be permitted provided a root deflector is installed on the sides of the root ball adjacent to the gas pipeline.

Final location of the trees must be confirmed with Enbridge Gas Distribution to avoid interference with the existing gas pipelines.

Root Deflectors

A root deflector is a mechanical barrier placed between tree roots and pipelines to prevent damage to the pipelines. A root deflector can be made from 1/4-inch rigid plastic, fiberglass or a non-degradable material. As the root tip of a tree travels out from the root ball the tip will contact the barrier, unable to penetrate to the barrier, the root will turn.

Root deflectors must be installed 0.6 meters (2 feet) from the pipeline on the side of the tree facing the pipeline and must extend 1.2 meters (4 feet) from the center of the tree trunk, parallel to the pipeline, at both directions; or the deflector must circle the tree.



Root deflectors usually have a collar to keep the top of the deflector at ground level, and they should extend down to the bottom of the root-ball as shown in Figure 2.4.

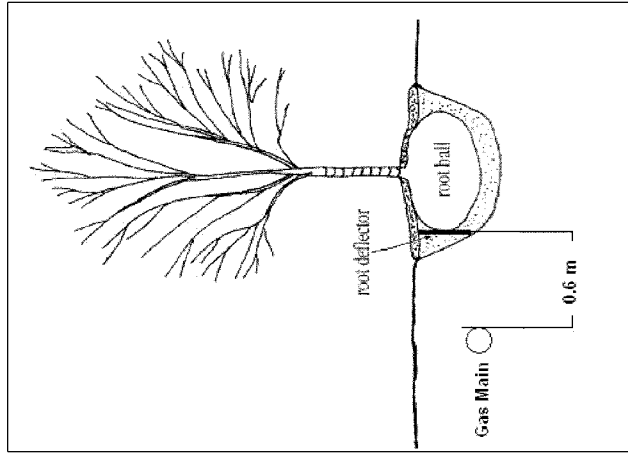



Figure 1  
Root Deflector

## 2.5 MINIMUM CLEARANCE FROM OTHER STRUCTURES

The following clearances must be maintained between the outside wall of the gas pipeline and other underground structures:

- Horizontal - 0.6 m minimum
- Vertical - 0.3 m minimum
- Vertical - 0.6 m minimum for pipelines 16 inches in diameter and larger

## GROUND VIBRATIONS FROM PILE DRIVING (Figure 2)

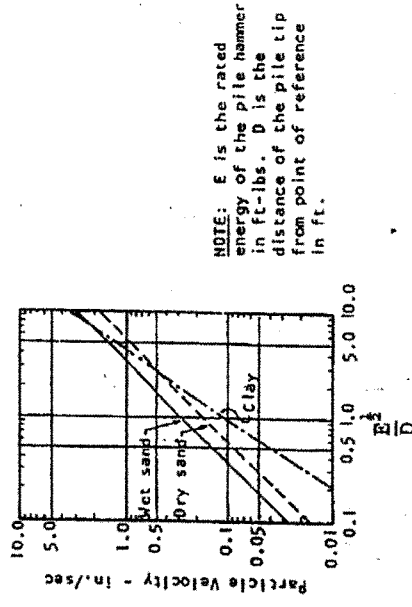

Maximum vibration intensities expected from pile driving in wet sand, dry sand, and clay

GROUND VIBRATIONS FROM PILE DRIVING  
AND THE EFFECT OF GROUND VIBRATIONS  
(after Liu and Wiss, 1974)

No operations shall be permitted within a standoff distance of 1.5 meters from the pipeline or other natural gas facility unless approved by Enbridge Gas Distribution.

Auguring of the soil up to the base of the pipeline may be required in order to avoid deviation of the piles within a distance of 1.5 m from the pipeline.

All operations must comply with the Provincial Occupational Health and Safety Act and Regulations for Construction Projects as well as all applicable Company specifications, standards and guidelines.

Leak surveys (flame ionization) shall be conducted at any time following the higher vibration intensities or displacements notwithstanding any delays or costs incurred by the contractor or authority responsible for the proposed work.

#### 5.5 POST PILING OR COMPACTION OPERATIONS

A summary of all operations including pile driving and compaction logs, vibration control, seismographs and other pertinent information shall be provided to Enbridge Gas Distribution by the Contractor responsible for the proposed work no later than 5 business days after work has been completed.

On completion of the daily operations, and approximately 30 days after the end of the operations, Enbridge Gas Distribution shall conduct a leak survey (flame ionization) of the pipeline. The resulting damages will be repaired at the expense of the Contractor responsible for the proposed work.

Excavations for permanent structures (i.e. pools, root cellars, septic tanks etc.) must be at least 10.0 m from the limit of the existing right-of-way of the NEB pipeline.

Any work performed within 30.0 meters of an NEB pipeline right-of-way must be approved by Enbridge.

#### 2.6 MINIMUM COVER REQUIREMENTS (Table No. 1)

Mains	Location	Minimum cover (m)
	Below traveled surfaces (roads), Road Crossings, General, Rights-of-way (roads)	1.2/0.9 *
	Water crossings	1.5
	Controlled Access Highways crossings, Below base of rails (cased)	1.7
	Rights-of-way (railroads), Drainage, Irrigation Ditches	1.0
Services	Private property	0.3
	Streets and Roads	0.45
	Wet Gas Areas @ Main/Building	1.2 / 0.9

\* 1.2m is required for Transmission Lines 0.9m is required for Distribution Lines

#### 2.7 POINTS OF THRUST

Precautions must be taken when working in the immediate vicinity of points of thrust. Points of thrust occur at pipeline fittings such as Elbows (45° or 90°), End Caps, Weld Tees, Reducer Couplings and closed Valves. In the event that the excavation involves exposing a point of thrust, or exposing an area near a point of thrust, specific instructions provided by the Company must be followed. Failure to follow these instructions can result in significant harm to persons and property.

#### 2.8 REPAIR OF DAMAGED PIPE AND PIPE COATING

In all cases where the pipe or the pipe coating is damaged by the construction operation, contact the Company immediately and leave the excavation open until Company personnel have made the necessary repairs.

#### 2.9 BLASTING, PILE DRIVING OR COMPACTION

Blasting, Pile Driving, or Compaction activities in the vicinity of natural gas pipelines requires the prior approval by the owner of the pipeline. (TSSA Act 2001).



Written notification from the owner of the proposed work (municipality, etc.) shall be submitted to the Manager Distribution Planning. The request shall be submitted a minimum of four (4) weeks prior to blasting, pile driving or compaction to allow sufficient time to ensure the Company requirements are followed. (Refer to Section 4.0, **Blasting Requirements, and Section 5.0, Pile Driving and Compaction Requirements**, for specific responsibilities.)



- d) Soil types fitting the description of Type 4 soil as defined in Article 226 of the Occupational Health and Safety Act and Regulations for Construction Projects (Refer to Section 5.6 Soil Types, page 30).

For all these situations, monitoring of vibrations, with the appropriate number of seismographs, is mandatory. The seismographs shall be the portable types with the capability of producing on site printouts. This control will confirm the intensity of the vibrations generated by the pile driving or compaction work as projected. Furthermore, reports of recorded intensities shall be provided on a regular basis or at the request of Enbridge Gas Distribution.

Should a situation with low energy compaction operations with a soil cover of less than 1.5 meters above the pipeline at a stand-off distance of 3 meters or less from a pipeline be encountered, Enbridge Gas Distribution may require the opinion of an independent Engineer.

In addition, if a Type 3 soil (refer to Section 5.6 Soil Types, page 30) is present on site, Enbridge Gas Distribution may, again, require the opinion of an independent Engineer.

For the start of the construction operations, the equipment and method used for pile driving shall comply with the guidelines presented in Figure 2, page 28, and Table 6, page 29, which identify the maximum vibration intensities expected from pile driving in dry and wet sand and clay. These guidelines can be replaced by actual vibration testing (portable seismograph) on site.

The Peak Particle Velocity (PPV) measured on the pipeline, or at the closest point of the related structure with respect to the work, shall not exceed 50 mm/s. Furthermore, the maximum displacement for the vertical and/or horizontal component corresponding to the above stated vibration intensity shall not exceed 50 mm at any given length of the pipeline in question.

For all operations, if the Peak Particle Velocity (PPV) and/or the displacement limit are surpassed, all operations must stop notwithstanding any delays or costs incurred by the contractor or owner of the proposed work. Enbridge Gas Distribution will require that the cause of these higher vibrations or displacement be investigated. The operations shall resume only when the cause and remedy are established and with the approval of Enbridge Gas Distribution's Engineering Department.

Should any subsequent recordings indicate vibration intensities or displacements above the prescribed limits all operations shall immediately stop. Enbridge Gas Distribution shall require that the work be carried out according to methods it judges to be acceptable to the integrity of the pipeline or related structure notwithstanding any delays or costs incurred by the Contractor responsible for the proposed work.

Enbridge Gas Distribution shall be responsible for isolating the area of the pipeline in the direct vicinity of the operations as required. The Contractor will be responsible for all Company costs during piling operations.

In the event a third party is affected as a result of the pile driving and/or compaction operations, all expenses associated therewith incurred by Enbridge Gas Distribution shall also be at the Contractor's expense.

#### 5.4 GUIDELINE FOR PILE DRIVING OR COMPACTION

The information provided in this section is to be viewed as a guideline only and is not intended to remove Contractor responsibility for damages caused by the piling and/or compaction operations. The contractor is responsible for ensuring that all pile driving and/or compaction work is performed in a good and workmanlike manner in accordance with all applicable laws, codes, by-laws and regulations.

Prior to pile driving and/or compaction work, a site meeting shall be arranged with an authorized representative of the Contractor and an Enbridge Gas Distribution representative to confirm details of the location of Company facilities and the proposed work.

The pipeline should not be excavated prior to the piling or compaction operation. If the particular situation warrants the excavation of the pipeline, then it must be properly supported in accordance with **Section 3.0 Standard Procedures**.

If in the assessment of Enbridge Gas Distribution, the soil cover is deemed to be insufficient, Enbridge Gas Distribution shall require that a protective ramp be constructed and maintained above the pipeline in accordance with Company guidelines. Construction vehicles or equipment will not be allowed to pass over a pipeline without the authorization of a Company representative.

The following situations will require the opinion of an independent Engineer. This Engineer must be specialized in vibration control, analysis and soil movement in order to evaluate and validate the proposed method of work and operation.

- a) Compaction of soils or backfill rated at 10,000 ft-lbs or higher at a stand-off distance of 6 meters or less from the pipeline
- b) Pile driving at a stand-off distance of 10 meters or less from the pipeline or other natural gas facility.
- c) High-energy dynamic compaction for the rehabilitation of soils at a distance of 30 meters or less from the pipeline.

### 3.0 SUPPORT OF GAS PIPELINES

#### 3.1 TRENCHING PARALLEL TO GAS PIPELINES

When a trench parallels an existing gas pipeline, support may be required depending on trench depth, pipeline material and soil conditions. (Refer to **Section 3.4, Support of Pipelines Parallel to Trench**, for details.)

#### 3.2 MINIMUM REQUIREMENTS

Support methods specified by the Company are minimum requirements. Excavators shall not depart from these unless a Professional Engineer working for or on behalf of the excavator has designed an alternative method. Any alternative method must ensure support comparable to these specifications and be, in the opinion of the Professional Engineer, consistent with good engineering practices. Where that is the case, the alternative specification shall be documented and approved by the Professional Engineer and sent to the Company's Engineering Department for acceptability.

The following specifications deal with the support of gas pipelines in the vicinity of excavations. Two typical field situations are covered:

- support of gas pipelines **crossing the trench** and
- support of gas pipelines **parallel to the trench**.

#### 3.3 SUPPORT OF PIPELINES CROSSING TRENCH

##### 3.3.1 Temporary Support

Temporary support refers to the support of gas pipelines prior to or at the time of excavation to protect the pipeline from deflection due to its own weight while it is exposed. Temporary support shall remain in place until the backfill material underneath the pipeline is compacted adequately to restore support of pipeline.

Prior to trenching beneath a pipeline or service, temporary support shall be erected for pipelines if the unsupported span of pipeline in the trench exceeds the length indicated in **Table No. 2, page 11**.

When temporary support is required, **Table No. 3, page 11**, below, indicates the required beam for a given span. The beam shall be a continuous length grade No. 1 Spruce-Pine-Fir (S-P-F) or equivalent. For spans exceeding 4.5 m, contact the Company's Engineering Department for approval.

**Table No. 2**  
**Maximum Span Without Support Beam**

Pipe Size (NPS)	Steel (m)	PE (polyethylene) (m)	CI (cast iron) (m)
1/2	2.0	1.0	-
3/4 - 1 1/4	2.5	1.25	-
2	3.0	1.5	-
3 to 4	4.5	1.75	1.0
6	6.0	2.0	1.0
8	7.0	2.0	1.0
12	10.0	-	1.0
16	11.5	-	1.0
20	13.0	-	1.0
24	15.0	-	1.0

- If required, a technical report with appropriate analysis and prediction of the vibration levels according to the opinion of an independent Engineer specialized in vibration control and analysis;
- A clause stating that the work will be carried out by qualified personnel with appropriate experienced supervision;
- A clause stating that all vibration testing results, or other preventative control testing, will be submitted to Enbridge Gas Distribution on a regular basis, or upon request.

To help with the preparation of the written request, locates to determine the location of the pipeline can be requested by calling "Ontario One Call" listed in Regional Contact List on Appendix A, and appropriate markups of drawings can be obtained by contacting "Distribution Planning" listed in Regional Contact List on Appendix A.

### 5.3

#### EVALUATION BY ENBRIDGE GAS DISTRIBUTION

Enbridge Gas Distribution shall conduct a record search on the natural gas facilities in the vicinity of the proposed work to identify their materials, location and maintenance history.

Enbridge Gas Distribution shall assess the impact of the proposed operation on the pipeline or related facility versus the stand-off distance. If it is determined that the proposed operation and/or method of work may be detrimental, the Contractor must retain the services of an independent Engineer. This Engineer must be specialized in vibration control, analysis and soil movement in order to evaluate and validate the proposed method of work and operation.

Enbridge Gas Distribution shall conduct leak surveys (flame ionization unit) of the pipelines and other related natural gas facilities prior, during and after the start of work. Leak surveys shall be conducted at any time during the project notwithstanding any delays or costs incurred by the Contractor responsible for proposed work.

Enbridge Gas Distribution shall prepare a contingency plan in case the isolation of the line or shut down of the related facility becomes necessary. This may not be possible without affecting a large number of customers and all operations may be suspended until Company investigations are completed notwithstanding any delays or costs incurred by the Contractor responsible for proposed work.

Enbridge Gas Distribution shall locate all control valves within the vicinity of the approved location and check all valves involved in the contingency plan to ensure accessibility and proper operability.

**Third Party Requirements in the Vicinity of Natural Gas Facilities**

**Table No. 3**  
**Support Beam Sizes**

Given: max. span between Beam Supports

Pipe Size (NPS)	Steel		PE		Cast Iron	
	≤ 2 m	≤ 4.5 m	≤ 2 m	≤ 4.5 m	≤ 2 m	≤ 4.5 m
1/2 - 2	Nil	4 x 6	4 x 4	4 x 6	4 x 4	6 x 8
3 - 6	Nil	Nil	4 x 4	6 x 6	4 x 4	8 x 8
8 - 12	Nil	Nil	4 x 4	8 x 8	6 x 6	10 x 10
16 - 24	Nil	Nil	Nil	Nil	8 x 8	12 x 12

The beam shall be placed above the pipeline with the ends of the beam resting on firm undisturbed soil. The beam shall not bear directly on the gas pipeline. The pipeline shall be supported from the beam with rope, chain or equivalent in a manner that will prevent damage to the pipeline and pipeline coating, and eliminate sag. The spacing between the rope, canvas sling or equivalent, shall not exceed 1.0 m (see Drawing No. 1, page 15, for details).

Backfill material underneath the exposed pipeline shall be compacted to a minimum of 95% Standard Proctor density. Sand padding shall be placed to a level 150 mm above and below the pipeline. Perform compaction with the loose lift height not exceeding 200 mm or one-quarter of the trench width, whichever is less. Injecting water into the backfill beneath the pipeline is not an acceptable method of compaction.

Mechanical equipment shall not be operated within 0.3 m of the pipeline. Hand Excavation shall be performed when locating and digging within 0.3 m of the pipeline. Hand held compaction equipment shall be used within 1.0 m of the sides or top of all gas pipelines.

**Third Party Requirements in the Vicinity of Natural Gas Facilities**

## 5.0 PILE DRIVING OR COMPACTION REQUIREMENTS

### 5.1 POLICY

Prior to any pile driving or compaction operations within the vicinity of a gas pipeline, the potential damage to Enbridge Gas Distribution plant will be evaluated to ensure the uninterrupted operation and long-term safety of its underground facilities. Any resultant damage caused either directly or indirectly to the gas plant will be borne entirely by the Contractor undertaking the proposed work.

If, in the opinion of Enbridge Gas Distribution, the particular pile driving or compaction operation cannot be carried out without affecting the pipeline or facility integrity, the following alternatives, or contingencies, may be implemented:

- a review of the particular situation by an independent consultant including a risk analysis and a prevention program;
- change in the construction methods;
- replacement or relocation of the pipeline/facility.

All costs incurred will be covered by the Contractor undertaking the proposed work with final approval being granted by Enbridge Gas Distribution.

### 5.2 PILE DRIVING OR COMPACTION APPLICATION

The application must include the following information:

- Name of project owner, general contractor and relevant sub-trades;
- A copy of the permits, certificates or other forms required by municipal bylaws;
- Name of design engineer and a copy of plans issued for construction with detailed drawings identifying all affected natural gas facilities;
- The type of piles and equipment used; including the methods of control to prevent the deviation of the piles;
- Geo-technical reports and other pertinent information;
- A copy of the location of other public utilities such as telephone, cable TV, sewer and water mains, electrical services, etc.;

Third Party Requirements in the Vicinity of Natural Gas Facilities

23

### 3.3.2 Cast Iron Pipelines

Any cast iron pipeline NPS 8 or less which is completely exposed crossing a trench for a length greater than 1.0 m must either be replaced or temporarily supported and properly backfilled. Any cast iron pipeline NPS 12 or greater that is completely exposed for greater than 1.0 m must be referred to the Company's Engineering Department for analysis. (See Drawing No. 1, page 15, for details)

If the pipeline is to be replaced, the replacement section shall extend to beyond the two 45° lines projected upward from the trench bottom (see Drawing No. 3, page 16, for details).

If the pipeline is to be temporarily supported, the spacing of the rope, canvas sling or equivalent, shall be a maximum of 1.0 m. Any exposed joint shall be supported by canvas sling or rope at either side of the joint and at 1.0 m spacings along the pipeline's length (see Drawing No. 1, page 15, for details).

### 3.3.3 Steel and Polyethylene Pipelines

All steel and polyethylene pipelines exposed to a length greater than indicated in Table No. 1 shall be temporarily supported and backfilled as shown in Drawing No. 2, page 15, and as outlined in Section 3.3.1, Temporary Support.

**NOTE:** All temporary support on polyethylene pipes must be removed prior to permanent backfill. Adequate support shall remain in place until the backfill material has restored support.

## 3.4 SUPPORT OF PIPELINES PARALLEL TO TRENCH

### 3.4.1 General

Two cases exist for pipelines parallel to an excavation;

- i) trench < 1.2 m deep,
- ii) trench ≥ 1.2 m deep.

In either instance, the pipeline is not to be exposed unless it is necessary to provide direct support.

**Trench wall support is not required** for excavations provided the pipeline meets the following criteria:

- depth is less than 1.2 metres,
- the pipeline is at least 0.6 metres from the edge of excavation or is outside the shaded area as indicated in Drawing No. 2 and,
- soil is stable (TYPE 1 or 2, refer to **Soil Types, page 30**)

Third Party Requirements in the Vicinity of Natural Gas Facilities

12

**Trench wall support is required** for excavations if one of the following conditions exists:

- depth is equal to or greater than 1.2 metres,
- the pipeline is closer to the edge of the excavation than the minimum allowed distance as indicated in **Table No. 4, page 13**
- depth is less than 1.2 metres and the soil is unstable (TYPE 3 or 4, refer to **Soil Types, page 30**)

**NOTE:** Adequate support shall remain in place until the backfill material has restored support.

Table No. 3 gives minimum distances from the edge of the trench to the pipeline in which the excavation influences pipelines for the given soil types.

Table No. 4 Minimum Allowed Distance from Pipeline to Excavation (m)		
Trench Depth (m)	Soil Types 1 & 2*	Soil Types 3 & 4*
>1.2	0.9	0.9
≥1.5	0.9	0.9
≥1.8	0.9	0.9
≥2.1	0.9	0.9
≥2.4	0.9	0.9
≥2.7	0.9	1.0
≥3.0	0.9	1.5
≥3.3	0.9	1.8
≥3.6	0.9	2.2
≥3.9	0.9	2.5
≥4.2	0.9	3.0
≥4.5	1.0	3.4
≥4.8	1.5	3.8
≥5.1	2.0	4.1
≥5.4	2.5	4.6
≥5.7	3.0	5.0
≥6	3.4	5.5
*as defined in the Occupational Health and Safety Act		

TABLE NO 5 Stand-off Distance for Blasting Near Polyethylene and Steel Facilities	
STAND-OFF DISTANCE FROM FACILITY (m)	MAXIMUM ALLOWABLE EXPLOSIVE CHARGE WEIGHT PER DELAY (kg)
3.00	0.18
4.00	0.33
5.00	0.51
6.00	0.73
7.00	1.00
8.00	1.31
9.00	1.65
10.00	2.04
12.00	2.94
14.00	4.00
16.00	5.22
18.00	6.61
20.00	8.16
22.00	9.87
24.00	11.75
26.00	13.79
28.00	16.00
30.00	18.36

The chart above is based on a Peak Particle Velocity (PPV) of 50 mm/sec. No greater velocity shall be allowed. Maximum amplitude shall be limited to 0.1524 mm.

If the applicant insists that blasting is necessary, the required independent blasting consultants report shall evaluate and validate the proposal.

The applicant shall comply with the Ontario Provincial Standard Specification - OPSS 120 - General Specification for the Use of Explosives, in addition to these Enbridge Gas Distribution blasting requirements.

Monitoring of blasting vibrations with a portable seismograph capable of producing on site print outs in the vicinity of Company facilities is mandatory to confirm that predicted vibration levels are respected. At the completion of the blasting operation, a copy of the seismographic report shall be provided to Enbridge Gas Distribution.

**Table 5, page 22**, shall be used to guide explosive charge weights. Peak Particle Velocity (PPV) shall be limited to 50 mm/sec and maximum amplitude shall be limited to 0.1524 mm.

#### 4.6 POST BLASTING OPERATION

Upon completion of daily blasting operations and within 30 days after the final blasting, Enbridge Gas Distribution shall conduct a leak survey (flame ionization) of the pipeline at the applicants' expense. Leak survey shall also be completed at the end of each day of blasting. Damage that has resulted from the blast will be repaired at the applicants' expense. A summary of all blasting operations including blasting logs, vibration control, seismograph reports and other pertinent information shall be provided to Enbridge Gas Distribution by the applicant at the completion of blasting operations.

#### 3.4.2 Cast Iron Pipelines

If a cast iron pipeline lies within the 45° line projected upward from the bottom of the trench, the trench shall be suitably shored to support the pipeline. A sliding trench box does not provide adequate support.

If a cast iron pipeline lies within the 45° line projected upward from the trench bottom and the bottom of the trench is below the water table, a field assessment of the situation is required to determine if this pipeline must be replaced.

For cast iron pipelines within the minimum distances given in **Table No. 4, page 13**, above, the support shall be abandoned in place.

If any cast iron pipeline becomes exposed for a length greater than 1.0 m it shall be replaced. Replacement limits shall be determined in the field.

#### 3.4.3 Steel and Polyethylene Pipelines

In the case of a steel or polyethylene pipeline within the limits of 3.4.1, and the trench bottom is below the water table, the trench shall be suitably supported as required in 3.4.1.


For steel and polyethylene pipelines within the minimum distances given in **Table No. 4, page 13**, support shall remain in place until backfill material restores support.

Any steel or polyethylene pipeline that is unsupported for a length greater than indicated in **Table No. 2, page 11**, shall require field assessment by the Company.




**DWG NO. 1: Support of Cast/Wrought Iron Gas Pipelines Crossing Excavations**

**NOTE:** BEAM SHALL EXTEND TO 1.0 m BEYOND THE SIDE OF THE TRENCH ON UNDISTURBED SOIL OR A DISTANCE EQUAL TO THE DEPTH OF THE PROPOSED EXCAVATION, WHICHEVER IS GREATER.

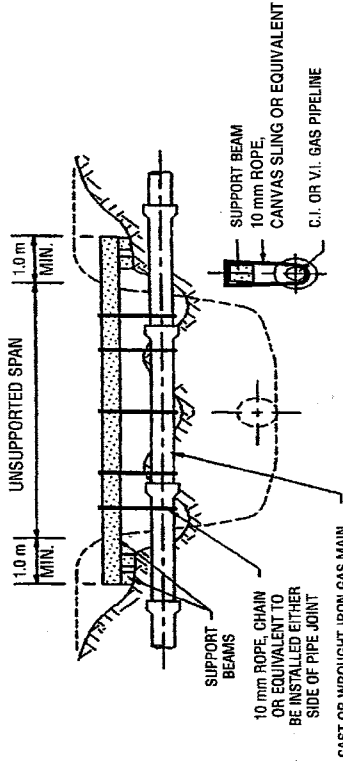

**DWG NO. 2: Support of Plastic or Steel Gas Pipelines Crossing Excavations**

**NOTE:** BEAM SHALL EXTEND TO 1.0m BEYOND THE SIDE OF THE TRENCH ON UNDISTURBED SOIL OR A DISTANCE EQUAL TO THE DEPTH OF THE PROPOSED EXCAVATION, WHICHEVER IS GREATER.

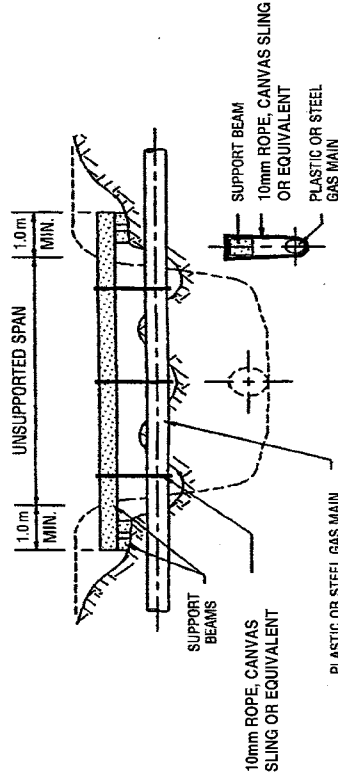

**4.4 GROUND WATER MONITORING**

Where there is a potential for damage to nearby wells, the blaster shall conduct an evaluation designed and implemented to minimize adverse impacts on potentially affected wells. Generally, all water wells within 100 meters of proposed blasting locations should be monitored for quality and quantity prior to construction.

Blasting in a watercourse requires Department of Fisheries and Oceans (DFO) authorization.

**4.5 GUIDELINES FOR BLASTING**

The information provided in this section is not to be construed as an exhaustive list of performance specifications, but rather a guide for conducting blasting in the vicinity of Enbridge Gas Distribution pipelines. The applicant is responsible for ensuring that all blasting work is performed in a good and workmanlike manner in accordance with all applicable laws, codes, by-laws, and regulations.

The contractor shall be liable for and indemnify Enbridge Gas Distribution in relation to any and all damage directly or indirectly caused or arising as a result of blasting operations carried out by the applicant, its employees, contractors or those for whom the applicant is responsible at law.

Prior to blasting operations, a site meeting shall be arranged with an authorized representative of the applicant and an Enbridge Gas Distribution representative to confirm details of the location of Company facilities and the proposed blast.

Enbridge Gas Distribution pipelines shall not be excavated prior to blasting. If excavation is unavoidable, then the pipeline shall be properly supported according to current Enbridge Gas Distribution requirements as outlined in this booklet. The applicant shall take suitable precautions to protect the exposed pipeline from fly-rock. Blasting mats shall be used to minimize the risk of fly-rock.

Explosives shall be of a type that will not propagate between holes nor desensitize due to compression pressures. No explosives shall be left in the drill hole overnight.

For surface blasts located at distances of 10 meters or less from a pipeline and when the excavation of the first blast hole has attained a depth equal to the top of the buried natural gas pipeline, the vertical depth of subsequent blast holes shall be restricted to one half of the horizontal distance to the closest portion of the natural gas pipeline. The required independent blasting consultants' report shall specifically address the impact of these conditions. This condition is not applicable for tunnel blasting operations.

Horizontal stand-off distances for surface blasting and directs stand-off distances for tunnel blasting of less than 3 meters are not permitted.

- Type of advancement proposed and type of tunnel method proposed; full face, top of heading and bench, pilot tunnel
- Type of tunnel lining proposed.
- The use of preventative blasting techniques such as line drilling, cushion blasting, etc.
- Other pertinent information specific to tunneling techniques.

To assist with the preparation of the written request, locates to determine the location of the pipeline can be requested, or mark-ups of drawings can be obtained by contacting the Manager Distribution Planning, Enbridge Gas Distribution. Lists of Regional addresses and phone numbers are outlined at Appendix A.

#### 4.3 EVALUATION BY ENBRIDGE GAS DISTRIBUTION

Enbridge Gas Distribution will conduct a record search on the facilities in the vicinity of the blast to determine the material, location and maintenance history.

Enbridge Gas Distribution will evaluate the impact of the blast on the facilities, assessing the charge weight to be detonated in relation to the stand off distance. If, in the opinion of Enbridge Gas Distribution, a hazardous condition may result if the charges are fired as outlined in the application, the applicant shall be notified in writing. The applicant shall not commence operations and shall retain the services of an independent blasting consultant to evaluate and validate the application. A copy of the required consultants' report shall be forwarded to Enbridge Gas Distribution Engineering Department for approval.

Enbridge Gas Distribution shall conduct a leak survey (flame ionization unit) of the pipeline prior, during and after the blasting and independently of its normal leak-monitoring program to establish satisfactorily that the pipeline is not leaking.


Enbridge Gas Distribution shall prepare a contingency plan to respond in the event that isolation of the pipeline becomes necessary. Blasting operations shall not commence until all Enbridge Gas Distribution procedures have been implemented and the applicant has received written notification of it.

Enbridge Gas Distribution shall locate all control valves within the vicinity of the approved blast area. Check all valves involved in the contingency plan to ensure accessibility and proper operability.


In the event a third party is affected as a result of the blasting operations, all expenses associated therewith incurred by Enbridge Gas Distribution shall also be at the applicant's expense

DWG NO. 3: Influence Lines for Gas Pipelines Adjacent to Excavations

#### CAST IRON CROSSINGS - MINIMUM REPLACEMENT SECTIONS

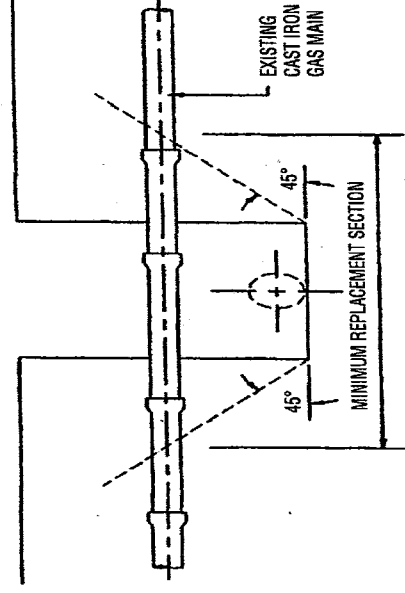

#### PARALLEL MAINS - GENERAL

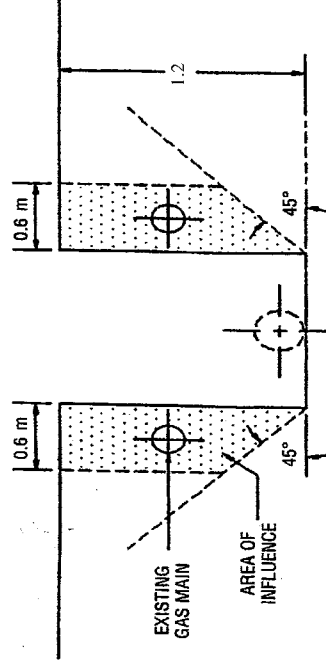

**NOTE:** IF PIPE IS LOCATED IN THE SHADED AREA, IF SOIL IS UNSTABLE (TYPE 3 or 4), THE TRENCH IS REQUIRED TO BE SUPPORTED

## 4.0 BLASTING REQUIREMENTS

### 4.1 POLICY

Prior to any blasting operation in the vicinity of a gas pipeline, the hazard to Enbridge Gas Distribution Inc. plant will be evaluated to ensure the uninterrupted operation and long-term safety of its underground facilities. Responsibility for the design of the blast and any resultant damage is born entirely by the party using the explosives.

A recognized independent blasting consultant shall be retained at the applicants' expense to evaluate and validate the risks for blasting under any of the following conditions:

- a) Explosive charge weight per delay in **Table 5, page 22**, is exceeded.
- b) Blasting requirements less than 3 meters from Company facilities.
- c) Blasting in the vicinity of cast iron and wrought iron pipelines.
- d) Any tunnel blasting operation in the vicinity of Company facilities.
- e) Surface blasts less than 10 meters from a Company pipeline where the excavation depth of the first blast hole is equal to the depth of the top of the pipeline and subsequent blast hole depths are greater than one half the horizontal distance to the closest portion of the pipeline.
- f) Any time if in the opinion of Enbridge Gas Distribution Inc., it is felt the integrity of Company facilities may be affected by the blast.

The Independent Blasting Consultant shall be a Registered Professional Engineer and a holder of a Certificate of Authorization (C of A), specializing in blasting.

A copy of the consultant's report shall be forwarded to Enbridge Gas Distribution Inc. Engineering Department for review.

If in the opinion of Enbridge Gas Distribution Inc. or an independent blasting consultant, blasting cannot be carried out without affecting the facility's integrity, alternatives shall be considered, including the replacement or relocation of the affected facility at the applicants' expense. In these situations, additional time must be allowed to obtain the necessary permits and to complete the necessary construction work.

## 4.2 NOTIFICATION REQUIREMENTS

### 4.2.1 Surface Blasting Applications

The written request for surface blasting shall include the following information:

- Name of the owner of the project, general contractor and design engineer.
- Name of the blasting contractor and person in charge of the blast.
- Date for the blasting operation.
- A copy of a construction drawing or sketch drawn to scale indicating:
  - i Details of the proposed drilling and loading pattern for explosives.
  - ii Diameters of drilled holes, relative to Company facilities.
  - iii Location of other public utilities, i.e. Bell, hydro, water etc.
- Number and timing of delays.
- Total explosive weight to be detonated per delay.
- Specifications for the type of explosives to be used.
- Predicted vibration levels anticipated at the pipeline and controls to be used to confirm vibration levels (i.e. Seismographs).
- Potential stabilization of rock face and type of potential stabilization techniques i.e.: rock anchors, shotcrete, ribs, etc.
- Geological parameters (Borehole logs or Geological reports) which indicate the design of the blast are acceptable.
- Written confirmation that the blasting operation will be carried out by qualified personnel with appropriate engineering supervision.

### 4.2.2 Tunnel Blasting Applications

The written request for tunnel blasting shall include all information required in the surface blasting application as set out above in 4.2.1. In addition, the required independent blasting consultant's report shall include:

- Location plans and profile views with construction drawing or sketch, drawn to scale.
- Evaluation of geo-technical data.
- Exact stand-off distances horizontal and direct (radial)

## Noss, Melissa

---

**From:** Keen, Stephen  
**Sent:** Wednesday, May 25, 2011 4:08 PM  
**To:** Baudais, Nathalie  
**Cc:** Sparham, Richard  
**Subject:** FW: EGD 102010 - Class Environmental Assessment - Hwy 50 - Castlemore Rd to Rutherford Rd

fyi

---

**From:** Diana Beaulne [<mailto:Diana.Beaulne@enbridge.com>]  
**Sent:** Wednesday, May 25, 2011 3:12 PM  
**To:** Keen, Stephen  
**Subject:** EGD 102010 - Class Environmental Assessment - Hwy 50 - Castlemore Rd to Rutherford Rd

Thank you for your letter informing us of your future planned work. Enbridge has buried plant in numerous locations throughout your planned work area. Currently the scope of your project is too general to determine if a conflict exists. During the engineering design of your project please send us copies of your plans per normal procedure so we may review.

Kind Regards,

Diana Beaulne  
Right of Way Approval Technician  
Enbridge Gas Distribution Inc.  
Distribution Planning 4<sup>th</sup> Floor  
500 Consumers Rd  
North York, ON.  
M2J 1P8

[markups@enbridge.com](mailto:markups@enbridge.com)

Tel: 416-495-5160  
FAX: 416-758-4373

AS/LAD NUMBER:

- STANDARD NOTES :
- ALL ASTONAL ROAD CROWN, VEWAY & TREE CROSSES MUST BE HORIZONTAL
  - ANY AUGERED, PILED, BORED OR DRILLED PIPE MUST USE 12 GAUGE
  - PROPOSED GAS MAIN SHALL HAVE A MINIMUM COVER UP 1.2m FOR ALL ROAD CROSSINGS, 1.0m ALL OTHER LOCATIONS UNLESS NOTED OTHERWISE.
  - ALL APPLICABLE PURGING PROCEDURES SHALL BE FOLLOWED AS OUTLINED
  - PIPELINE MARKERS TO BE PLACED ON ALL BURGE CAPS AND WELD JOINTS.
  - PIPELINE MARKERS AND PIPELINE MARKERS TO BE INSTALLED WHERE SHOWN ON THE PLAN UNLESS APPROVED BY PLANNING AND/OR CORROSION.

WELD TABLE

WELD NO.	WELD CHAINAGE	PIPE CHAINAGE	DESCRIPTION	WELD No.	WELD CHAINAGE	PIPE CHAINAGE	DESCRIPTION

PROP NPS 2 ST 1/2 XHP GAS MAIN

HIGHWAY No. 50

NOT DEDICATED


0.6m

21.2m 42.2m

44.6m 20.9m

MATCH LINE - SEE PAGE 3 OF 3

MATCH LINE - SEE PAGE 1 OF 3

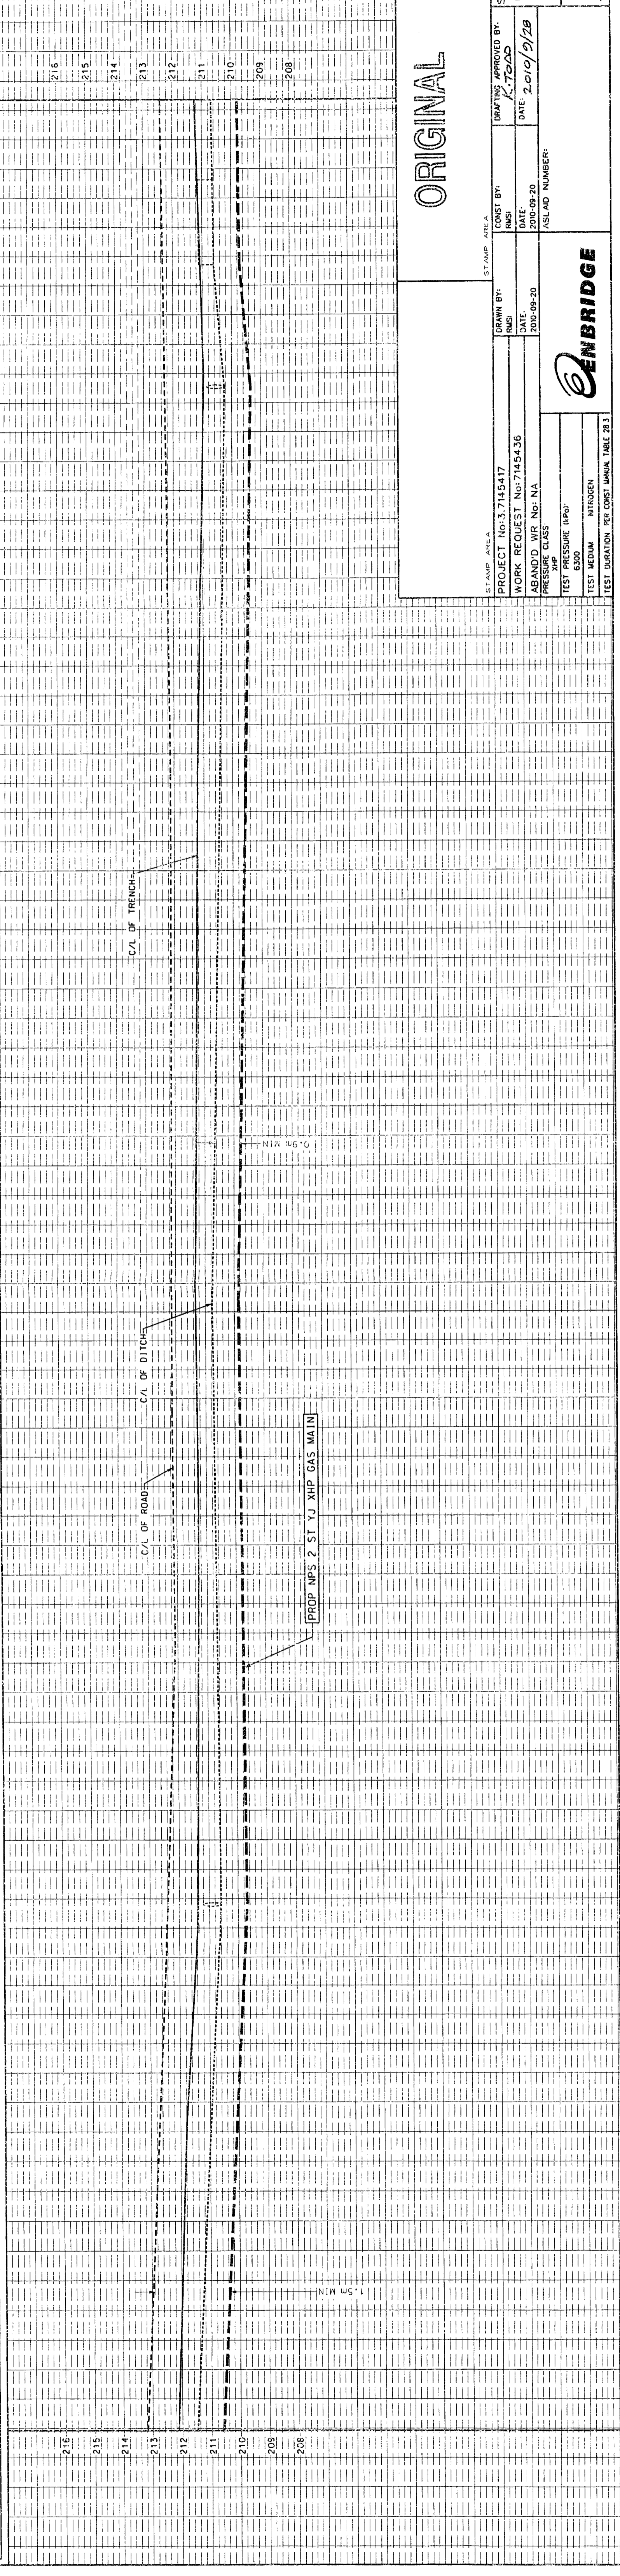

- WELDING PROCEDURES  
USE ONLY THE APPROVED WELDING PROCEDURES THAT APPLY:
- WITHIN THE REGULATORY JURISDICTION
  - TO THE TYPE OF JOINT
  - THE PIPE GRADE, CARBON EQUIVALENT, PRESSURE, DIAMETER AND WALL THICKNESS RANGE.

- WORK REGIONAL NOTE :
- MIN. COVER 1.5m OR 1.5m BELOW C OF TRENCH OR 1.5m IS LOWER OR AS INDICATED ON PLAN.


- ENBRIDGE GAS DISTRIBUTION LEGEND
- PROP. ABANDONED GAS MAIN
  - PROPOSED GAS MAIN
  - EXISTING GAS MAIN

ORIGINAL

STAMP AREA	STAMP AREA	SCALE:
PROJECT NO: 3 7145417	DRAWN BY:	RMS
WORK REQUEST NO: 7145436	DATE:	2010/09/28
ABANDONED W/R NO: NA	DATE:	2010-09-20
PRESSURE CLASS:	DATE:	2010-09-20
TEST PRESSURE (PSI):	AS/LAD NUMBER:	
TEST MEDIA: 6300 NITROGEN		
TEST DURATION PER COST MANUAL TABLE 283:		
		PAGE: 2 OF 3



WELD TABLE	PIPE CHAINAGE	WELD NO.	WELD CHAINAGE	PIPE CHAINAGE	DESCRIPTION

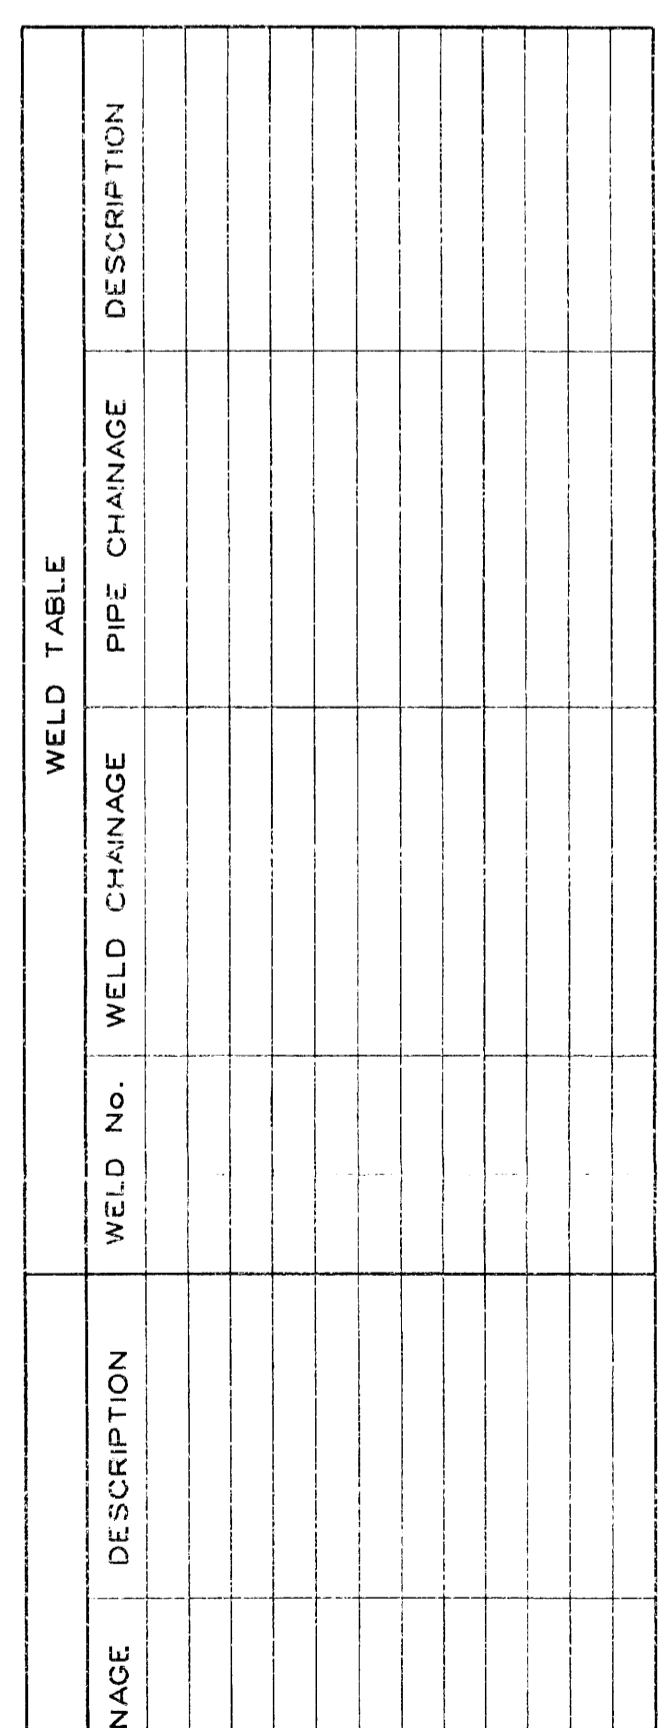

B

MATCH LINE - SEE PAGE 2 OF 3

B

STANDARD NOTES :

- ALL ASPHALT ROAD, DRIVEWAY & TREE CROSSINGS TO BE HORIZONTAL
- DIRECTIONAL DRILLED
- BORED OR DRILLED PIPE MUST USE 12 GAUGE TRACER WIRE AS PER SECTION 29.1.52 IF THE CAM MANUAL FOR ALL ROAD CROSSINGS IS NOT TO BE USED UNLESS NOTED OTHERWISE.
- ALL PROPOSED GAS MAINS ARE TO BE LOCATED ON STANDARD OFFSET OF ROAD
- ALL APPLICABLE BIDDING PROCEDURES SHALL BE FOLLOWED AS OUTLINED IN THE CAM MANUAL
- PIPELINE MARKERS TO BE PLACED ON ALL CRUISE CAPS AND WELD CAPS
- PIPELINE MARKERS TO BE INSTALLED AT THE P.D.P. AND THE CAM MANUAL.
- AND BE VISIBLY IDENTIFIED BY PLANNING AND/OR CONSTRUCTION.
- APPROVED BY:

WORK REGIONAL NOTE :

- MIN. COVER: 1.5m OR 1.5m BELOW C/L OF TRENCH OR 1.5m BELOW C/L OF ROAD OR 0.9m BELOW C/L OF DITCH WHICHEVER IS LOWER OR AS INDICATED ON PLANS.


WELDING PROCEDURES

USE ONLY THE APPROVED WELDING PROCEDURES THAT APPLY:

- WITHIN THE REGULATORY JURISDICTION
- FOR THE SPECIFIC APPLICATION
- THE PIPE GRADE, CARBON EQUIVALENT, PRESSURE, DIAMETER AND WALL THICKNESS RANGE.

ENBRIDGE GAS DISTRIBUTION LEGEND

- PROPT. ABANDONED GAS MAIN
- PROPOSED GAS MAIN
- EXISTING GAS MAIN

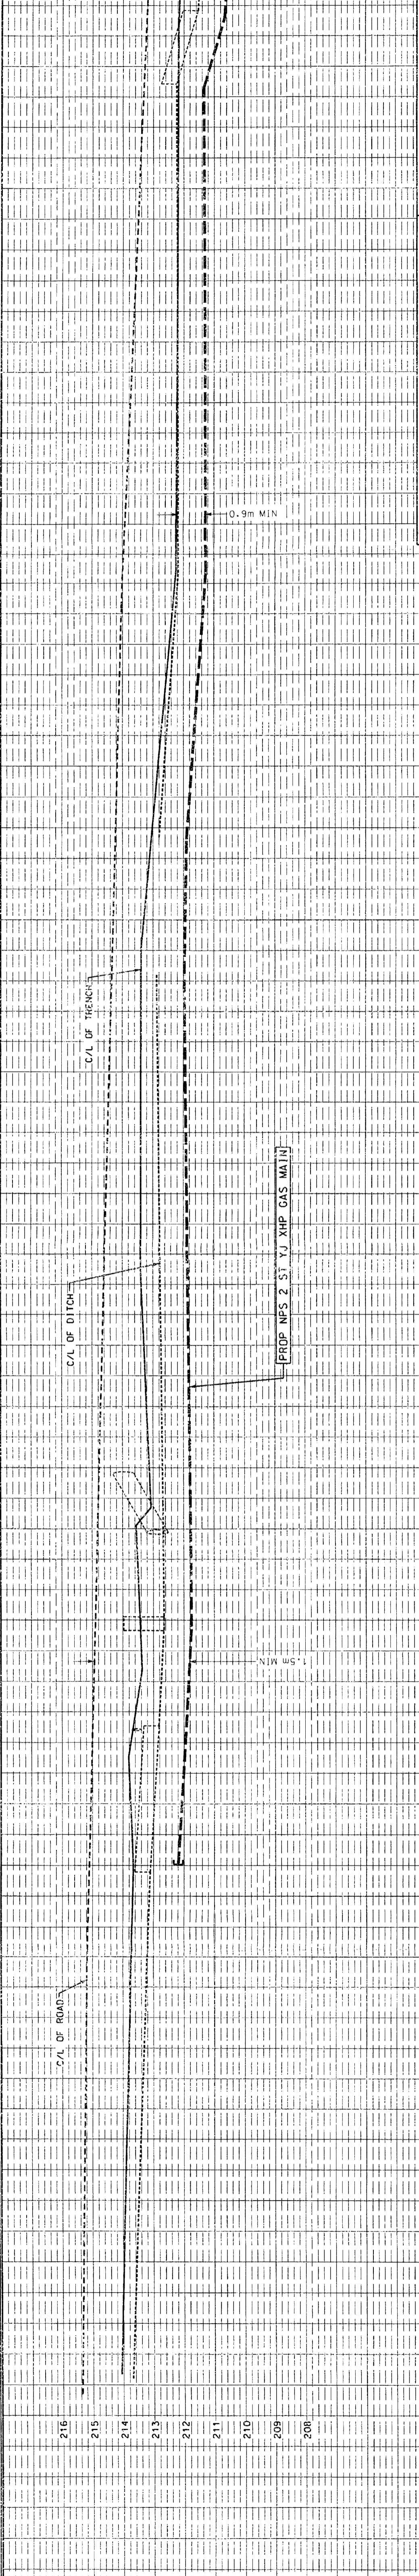

ORIGINAL

STAMP AREA

PROJECT NO. 2-7143417	DRWING APPROVED BY: K. TOSS
WORK REQUEST NO. 7143435	DATE: 2019-09-20
REVISION NO. NA	DATE: 2019-09-20
PRESSURE CLASS	ASLAD NUMBER:
TEST PRESSURE (kPa)	DATE: 2019-09-20
TEST MEDIA: WITGREN	
TEST DURATION: 22.50% (MIN.) (SEE 29.1)	

ENBRIDGE

SCALE: HORIZ. 1:500 VERT. 1:100

PAGE 3 OF 3



## Noss, Melissa

---

**From:** Edgar Henriquez [Edgar.Henriquez@rci.rogers.com]  
**Sent:** Friday, August 13, 2010 9:19 AM  
**To:** Lamontagne, Larry  
**Subject:** RE: HWY 50 Rogers Utility Markup Request  
**Attachments:** M103726\_Hwy 50 from Mayfield Rd to Rutherford Rd\_HDR iTRANS.dwg; ATT00001..txt

**Follow Up Flag:** Follow up  
**Flag Status:** Completed

Hi Larry,  
Please find attached the mark-up drawing for the area under your study.  
Rogers has aerial fiber TV plant in this area.  
Rogers File M103726  
Thanks

**Edgar Henriquez**  
Mark-up Coordinator GTAW  
OPE - GTA West  
Rogers Cable System Inc  
3573 Wolfedale Road  
Mississauga, On. L5C 3T6  
Tel: 905 897 6457  
Fax: 905 273 5233

-----Original Message-----

**From:** Lamontagne, Larry [<mailto:Laurent.Lamontagne@hdrinc.com>]  
**Sent:** Wednesday, May 19, 2010 10:37 AM  
**To:** Edgar Henriquez  
**Cc:** Keen, Stephen; Glofcheskie, Chris  
**Subject:** HWY 50 Rogers Utility Markup Request

Hi Edgar

As per our conversation today please find attached the AutoCadd file of our EA study limits. Please markup all existing and future Rogers Cable plant.

Study limits:

- Hwy 50 (Mayfield Road to Rutherford Road)
- Mayfield Road (Hwy 50 to Coleraine Drive)

Could you please let me know the turnaround time for my request.

If you have any questions regarding my request please don't hesitate to contact me.


Thank you

**Larry Lamontagne. Dipl.T.**  
Transportation Designer

**HDR | iTRANS**

100 York Boulevard, Suite 300 | Richmond Hill, ON | L4B 1J8  
Phone: 905.882.4100 x 5348 | Fax: 905.882.1557 | Email: [llamontagne@itransconsulting.com](mailto:llamontagne@itransconsulting.com)  
[www.hdrinc.com](http://www.hdrinc.com)  
[www.itransconsulting.com](http://www.itransconsulting.com)



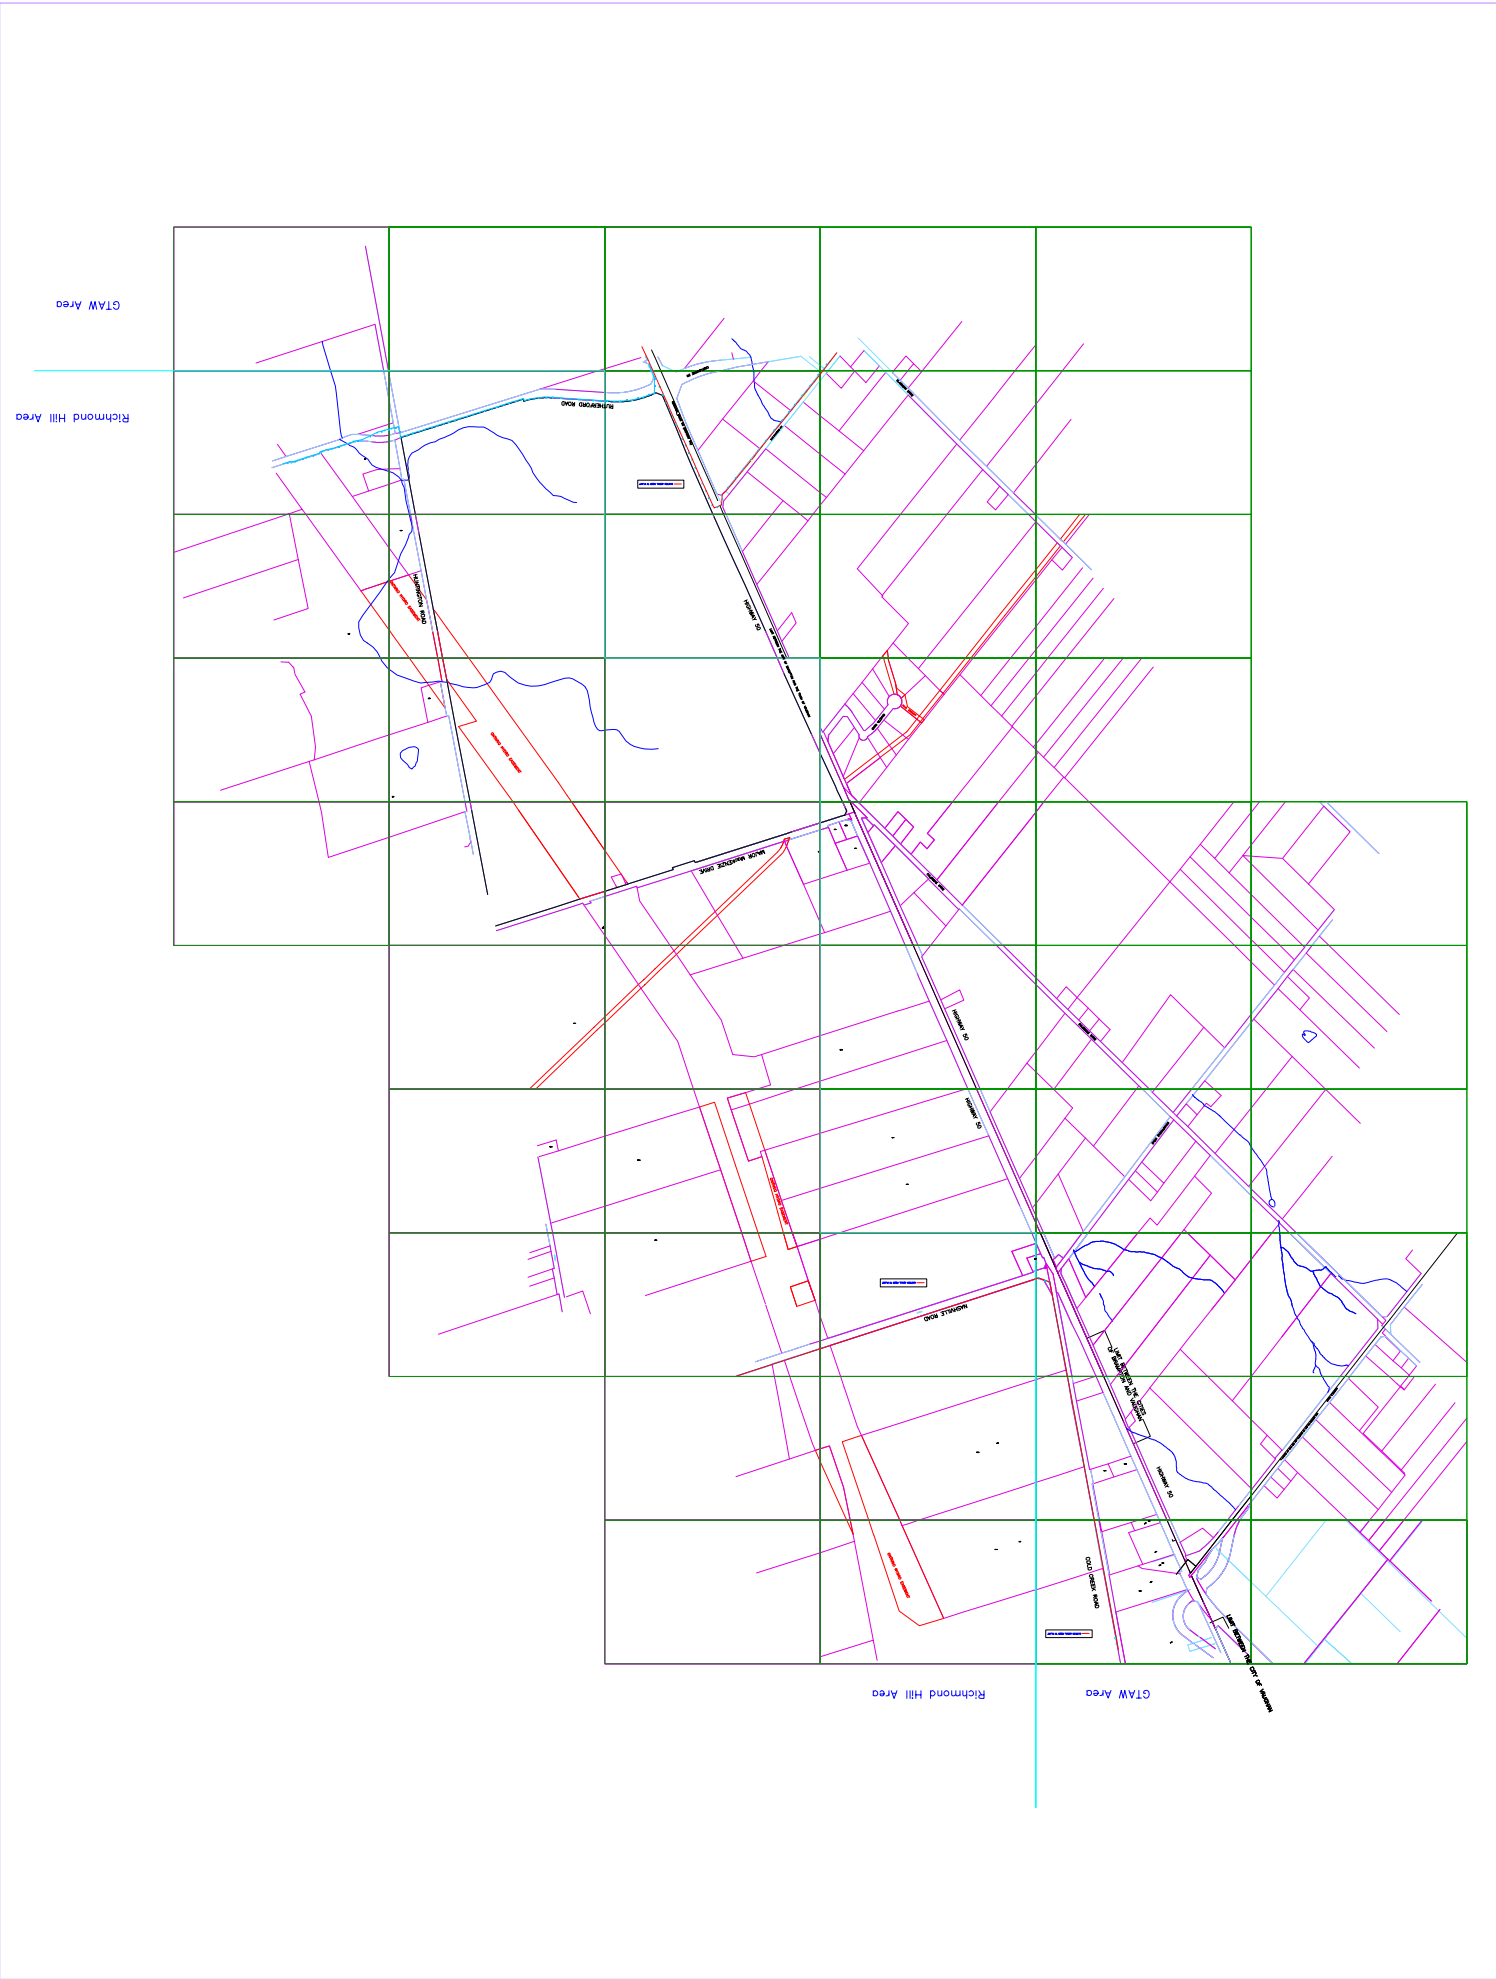

## Noss, Melissa

---

**From:** Utility Circulations [Utility.Circulations@mtsallstream.com]  
**Sent:** Tuesday, May 25, 2010 10:03 AM  
**To:** Lamontagne, Larry  
**Subject:** RE: HWY 50 Allstream Utility Markup Request

**Follow Up Flag:** Follow up  
**Flag Status:** Flagged

Good morning Larry,

Allstream has no existing plant in the area indicated in your submission. No mark-up & no objection.

Regards,

Utility Circulations  
[Utility.Circulations@mtsallstream.com](mailto:Utility.Circulations@mtsallstream.com)

---

**From:** Lamontagne, Larry [<mailto:Laurent.Lamontagne@hdrinc.com>]  
**Sent:** Wednesday, May 19, 2010 11:00 AM  
**To:** Utility Circulations  
**Cc:** Keen, Stephen; Glofcheskie, Chris  
**Subject:** HWY 50 Allstream Utility Markup Request

Please find attached an AutoCadd file of our EA study limits. Please markup all existing and future Allstream plant.

Study limits:

- Hwy 50 (Mayfield Road to Rutherford Road)
- Mayfield Road (Hwy 50 to Coleraine Drive)

Could you please let me know the turnaround time for my request.

If you have any questions regarding my request please don't hesitate to contact me.

Thank you

**Larry Lamontagne. Dipl.T.**  
Transportation Designer

**HDR | iTRANS**

100 York Boulevard, Suite 300 | Richmond Hill, ON | L4B 1J8

Phone: 905.882.4100 x 5348 | Fax: 905.882.1557 | Email: [llamontagne@itransconsulting.com](mailto:llamontagne@itransconsulting.com)

[www.hdrinc.com](http://www.hdrinc.com)

[www.itransconsulting.com](http://www.itransconsulting.com)

## Noss, Melissa

---

**From:** Keen, Stephen  
**Sent:** Monday, June 14, 2010 10:30 AM  
**To:** McLaughlin, Barry  
**Subject:** FW: Highway 50 and Mayfield Road Improvements Class EA

**Follow Up Flag:** Follow up  
**Flag Status:** Completed

---

**From:** Zia, Solmaz [<mailto:Solmaz.Zia@peelregion.ca>]  
**Sent:** Thursday, June 10, 2010 2:55 PM  
**To:** Keen, Stephen  
**Subject:** FW: Highway 50 and Mayfield Road Improvements Class EA

Steve,

fyi

**Solmaz Zia, P.Eng.**  
Project Manager  
Transportation Program Planning  
Public Works, Region of Peel  
Tel: (905) 791-7800 ext. 7845  
[Solmaz.Zia@peelregion.ca](mailto:Solmaz.Zia@peelregion.ca)

---

**From:** [Jennifer.Long@HydroOne.com](mailto:Jennifer.Long@HydroOne.com) [<mailto:Jennifer.Long@HydroOne.com>]  
**Sent:** June 4, 2010 9:17 AM  
**To:** Zia, Solmaz  
**Cc:** [ierullo@HydroOne.com](mailto:ierullo@HydroOne.com)  
**Subject:** Highway 50 and Mayfield Road Improvements Class EA

Dear Ms. Zia,

In our initial review, we can confirm that there are no Hydro One Transmission Facilities in the subject area. Please find our response form in the attachment.

Please be advised that this is only a preliminary assessment based on current information. No further consultation with Hydro One Networks Inc. is required if no changes are made to the current information.

If you have any further questions or concerns, please feel free to contact me.

Regards,

**Jen Long**  
Transmission Lines Sustainment  
System Investment, Asset Management  
**Hydro One Networks Inc.**  
Tel: 416-345-4421  
[Jennifer.Long@HydroOne.com](mailto:Jennifer.Long@HydroOne.com)

November 26, 2010  
Project No. 09-4390

Hydro One Networks Inc.  
West Central Zone 2

40 Olympic Drive  
Box 585  
Dundas, On  
L9H 7P5  
Attn, Scheduling

Re: Highway 50 from Castlemore Road/Rutherford Road to Mayfield Road/Albion  
Vaughan Road, and Mayfield Road from Hwy 50 to Coleraine Drive in the City of  
Brampton, City of Vaughan and Town of Caledon, Region of Peel and Region of York

---

Dear Sir / Madam,

The Region of Peel along with York Region is undertaking a Class C Environmental  
Assessment (EA) Study for the above noted project.

Please be advised that HDR/ iTrans is undertaking the EA including the preliminary  
design on behalf of the Municipalities of Peel and York for the identification of utility  
relocations involved with this project.

As per the EA recommendation, widening of Highway 50 and Mayfield Road to 6 and 4  
lanes respectively is proposed which requires a number of Hydro poles relocation.

We are at the third phase of the EA and the preliminary design for the noted corridor has  
been developed. We will mail 1 set of our preliminary design drawings under separate  
cover. Please review them and provide us with the existing plants along the noted road  
and your future plans for this corridor.

We request that you provide us with a preliminary estimate for the proposed relocation.

We would like to offer a meeting with you to review the conceptual relocation  
requirements. Please advise when your staff is available to meet with us.

The anticipated detailed design schedule is summer 2011 and utility relocation is 2015.

Your co-operation in providing the information required is anticipated and appreciated.

If you have any questions, do not hesitate to contact the undersigned.

---

**Public Works**

9445 Airport Road, 3<sup>rd</sup> Floor, Brampton, ON. L6S 4J3  
Telephone: 905-791-7800 / [www.peelregion.ca](http://www.peelregion.ca)

Regards,



Solmaz Zia, P.Eng.  
Project Manager  
Transportation Program Planning  
Public Works, Region of Peel  
Tel: (905) 791-7800 ext. 7845  
Fax: 905-791-1442  
[Solmaz.Zia@peelregion.ca](mailto:Solmaz.Zia@peelregion.ca)

CC: Edward Chiu, York Region  
Steve Keen, HDR/iTrans

March 15, 2011  
Project No. 09-4390

Hydro One Networks Inc.  
West Central Zone 2

40 Olympic Drive  
Box 585  
Dundas, On  
L9H 7P5  
Attn, Scheduling

Re: Highway 50 from Castlemore Road/Rutherford Road to Mayfield Road/Albion  
Vaughan Road, and Mayfield Road from Hwy 50 to Coleraine Drive in the City of  
Brampton, City of Vaughan and Town of Caledon, Region of Peel and Region of York

---

Dear Sir / Madam,

We provided, under separate cover, 1 set of plans of the above described work project, with existing utilities and anticipated conflicts based on our initial preliminary design review.

Please examine the noted plans for corrections or omissions, and conflicts with proposed construction. We also request to plot your proposed relocation and return sets of plans to Steve Keen's attention at HDR|iTrans office (144 Front Street W, Suite 655, Toronto, ON, M5H 2L7) giving existing and proposed depth of plant, where applicable.

Include in your submission, a preliminary cost estimate in order that we may establish a cost effective relocation strategy. It is anticipated the utility relocation to take place by 2014/2015.

Hydro One Brampton is notified of the utility relocation requirement.

Regards,



Solmaz Zia, P.Eng.  
Project Manager, Transportation Division

CC: Edward Chiu, York Region  
Steve Keen, HDR|iTrans  
Richard Sparham, Peel Region

---

**Public Works**

9445 Airport Road, 3<sup>rd</sup> Floor, Brampton, ON. L6S 4J3  
Telephone: 905-791-7800 / [www.peelregion.ca](http://www.peelregion.ca)

## Noss, Melissa

---

**From:** barbara.kolodziej@HydroOne.com  
**Sent:** Wednesday, May 19, 2010 3:14 PM  
**To:** Lamontagne, Larry  
**Cc:** Rebecca.Fu@HydroOne.com; ian.mitchell@HydroOne.com  
**Subject:** FW: HWY 50 Hydro One Utility Markup Request  
**Attachments:** Castlemore - Hwy50 - 9HO05007P.dwg

**Importance:** High

Hello Larry,

Please find attached DWG file. Hydro One Telecom has fiber optic cable only between Rutherford Rd & Old Castlemore Rd on the East side of Hwy 50, then crossing to Old Castlemore Rd on the South side of the road. At the intersection is U/G fiber, otherwise Aerial. Look only at pages 12 to 15, which include this area.

Regards,

*Barbara Kolodziej  
Outside Plant Engineering  
Hydro One Telecom  
Tel: 416-240-6842  
Fax: 416-240-6790*

---

**From:** MITCHELL Ian  
**Sent:** Wednesday, May 19, 2010 2:46 PM  
**To:** HOT OUTSIDE PLANT  
**Subject:** FW: HWY 50 Hydro One Utility Markup Request  
**Importance:** High

Barbara/Rebecca,

Can you please review these drawings and mark up where our facilities are and send back to Larry by end of next week.

Thank you,

Ian Mitchell  
Outside Plant Manager  
Hydro One Telecom Inc.  
P. 416-240-6701  
F. 416-240-6790  
C. 647-287-3007  
[ian.mitchell@hydroone.com](mailto:ian.mitchell@hydroone.com)

---

**From:** Lamontagne, Larry [<mailto:Laurent.Lamontagne@hdrinc.com>]  
**Sent:** Wednesday, May 19, 2010 2:29 PM  
**To:** MITCHELL Ian  
**Cc:** Keen, Stephen; Glofcheskie, Chris  
**Subject:** RE: HWY 50 Hydro One Utility Markup Request

Hi Ian

Thank you for the quick response.

Please find attached the DWG file showing the EA corridor and study limits for Hwy 50 and Mayfield Road . Please markup all existing and future Hydro One Utility plant.

Study limits:

- Hwy 50 (Mayfield Road to Rutherford Road)
- Mayfield Road (Hwy 50 to Coleraine Drive)

Could you please let me know the turnaround time for my request.

If you have any questions regarding my request please don't hesitate to contact me.

Thank you

## Larry Lamontagne. Dipl.T.

Transportation Designer

### HDR | iTRANS

100 York Boulevard, Suite 300 | Richmond Hill, ON | L4B 1J8

Phone: 905.882.4100 x 5348 | Fax: 905.882.1557 | Email: [llamontagne@itransconsulting.com](mailto:llamontagne@itransconsulting.com)

[www.hdrinc.com](http://www.hdrinc.com)

[www.itransconsulting.com](http://www.itransconsulting.com)

---

**From:** [ian.mitchell@HydroOne.com](mailto:ian.mitchell@HydroOne.com) [<mailto:ian.mitchell@HydroOne.com>]

**Sent:** Wednesday, May 19, 2010 12:48 PM

**To:** Lamontagne, Larry

**Cc:** Keen, Stephen; Glofcheskie, Chris

**Subject:** RE: HWY 50 Hydro One Utility Markup Request

Larry,

I am the contact for Hydro One Telecom and I would prefer all drawings sent in DWG but we can work with PDF or ZIP as well. If it's the electrical distribution information you are looking for then you need to contact Hydro One Brampton. I have provided Dave Robinson's information, if he is not the right person he will pass you on to who is.

D.Robinson, E.Tech.

Hydro One Brampton Networks Inc.

175 Sandalwood Pkwy, West

Brampton, ON

L7A 1E8

Engineering Technician

Tel: (905) 840-6300 ext. 3356

E-mail Address: [drobinson@hydroonebrampton.com](mailto:drobinson@hydroonebrampton.com)

Thank you,

Ian Mitchell

Outside Plant Manager

Hydro One Telecom Inc.

P. 416-240-6701

F. 416-240-6790

C. 647-287-3007

[ian.mitchell@hydroone.com](mailto:ian.mitchell@hydroone.com)

---

**From:** Lamontagne, Larry [<mailto:Laurent.Lamontagne@hdrinc.com>]

**Sent:** Wednesday, May 19, 2010 11:14 AM

**To:** MITCHELL Ian

**Cc:** Keen, Stephen; Glofcheskie, Chris

**Subject:** HWY 50 Hydro One Utility Markup Request



Hi Ian

I am following up on the message I left you today (May 19, 2010) regarding a Utility Markup plan request for Hwy 50 (Mayfield Rd. to Rutherford) showing Hydro One's existing and future plant.

Could you please let me know if you are the contact person for the markup plans or direct me to who may be in charge. Also, I will need to know what format you require the drawings (DWG, PDF...)

Thank you

**Larry Lamontagne. Dipl.T.**

Transportation Designer

**HDR | iTRANS**

100 York Boulevard, Suite 300 | Richmond Hill, ON | L4B 1J8

Phone: 905.882.4100 x 5348 | Fax: 905.882.1557 | Email: [llamontagne@itransconsulting.com](mailto:llamontagne@itransconsulting.com)

[www.hdrinc.com](http://www.hdrinc.com)

[www.itransconsulting.com](http://www.itransconsulting.com)

### CONSTRUCTION NOTES

- 1 OVERLASH 108.8m of 1-48 COUNT FIBER OPTIC CABLE ON EXISTING ASSUMED 1/4" EHS HOT STRAND.
- 2 INSTALL 2197.3m of NEW 1/4" EHS STRAND. LASH 1-48 COUNT FIBER OPTIC CABLE.
- 3 INSTALL 545.3m of NEW 1/4" EHS STRAND. LASH 1-48 COUNT FIBER OPTIC CABLE.
- 4
- 5
- A INSTALL NEW NEUTRAL BOND AND GROUND ROD, AND WIRE.
- B INSTALL NEW 10.0m LOOPBACK.
- C INSTALL NEW DOWNGUY AND ANCHOR.
- D INSTALL NEW RISER C/W U-GUARD.
- E INSTALL NEW HYDRO ONE SPULCE ENCLOSURE.
- F INSTALL NEW 1/4" OVERHEAD GUY.

### SCOPE OF WORK

NEW OVERHEAD GUY	3=61.5m
NEW DOWNGUY AND ANCHOR	9
NEW 48 COUNT FIBER OPTIC CABLE	2996.2m
NEW OVERLASH	108.8m
NEW LASHWIRE	8524.2m
NEW 1/4" EHS STRAND	2732.6m
NEW CATV MAKE READY	3
NEW HOT MAKE READY	1
NEW BELL MAKE READY	12
NEW HYDRO MAKE READY	2
NEW RISER C/W U-GUARD	2
NEW SPULCE ENCLOSURE	1
NEW GROUND ROD AND WIRE	11=110.0m

NOTE: INFORMATION WAS OBTAINED FROM DRAWINGS REFERRED TO. PHOTOGRAPHS OF PLAN AND PROFILE PROVIDED BY THE CITY OF BRAMPTON AND REGION OF PEEL.

**HYDRO ONE TELECOM CONTACT**  
IAN MITCHELL  
HYDRO ONE TELECOM INC  
45 KEELEFIELD STREET  
SCARBOROUGH, ONT. M1B 5A3  
PHONE: (416) 240-4700  
FAX: (416) 240-4700  
CELL: (416) 240-4700  
EMAIL: ian.mitchell@hydroone.com

### ANCHOR SPECIFICATIONS



ANCHOR TYPE	ANCHOR STRENGTH
SINGLE HELIX 8"	14000lbs
SINGLE HELIX 10"	20000lbs
SINGLE HELIX 12"	25000lbs
SINGLE HELIX 14"	31000lbs
TRIPLE HELIX, 8"-10"-12"	46000lbs

CALCULATION FOR REQUIRED STRENGTH OF ANCHOR IS BASED ON -20" WITH 0.5" OF ICE AND SOIL CLASS 4 (MEDIUM DENSE SANDY GRAVEL; VERY STIFF TO HARD SILTS AND CLAYS).

### GENERAL NOTES AERIAL DESIGN AND CONSTRUCTION

1. ALL CONSTRUCTION WORK SHALL BE IN CONFORMANCE WITH CANADIAN, PROVINCIAL, AND ONTARIO HYDRO SERVICES COMPANY SAFETY REQUIREMENTS. THESE INCLUDES WITHOUT LIMITATION:
  - OHSW WORK PROTECTION CODE
  - OCCUPATIONAL HEALTH AND SAFETY ACT
  - THIS DESIGN CONFORMS TO CSA STANDARD C22.3 NO. 1-06.
2. TAKE THE NECESSARY PRECAUTIONS TO PROTECT THE EXISTING INSTALLATION FROM DAMAGE. THE CONTRACTOR WILL BE RESPONSIBLE FOR ALL THE CLAIMS DUE TO DAMAGE.
3. ALL REVISIONS MUST BE MADE PRIOR TO CONSTRUCTION.
4. ALL BOLTS MUST PROVIDE FOR 25mm OF EXPOSED THREAD.
5. ASSUME SOIL CONDITIONS AT ANCHOR POINT ARE AS FOLLOWS:
  - MEDIUM DENSE SANDY GRAVEL; VERY STIFF TO HARD SILTS AND CLAYS.
6. THE CONTRACTOR SHALL CHECK AND VERIFY ALL SITE CONDITIONS, CLEARANCES AND DIMENSIONS AT THE SITE AND REPORT ANY DISCREPANCIES TO THE ENGINEER BEFORE PROCEEDING WITH WORK.
7. SAGS & CLEARANCES ARE CHECKED AND CALCULATED FOR NEW ATTACHMENTS ONLY.
8. POLES NOT CHECKED FOR OVERALL LOADING. ADDITIONAL APPLIED LOADS ARE SHOWN ON THIS DRAWING DUE TO NEW ATTACHMENTS ONLY.
9. THE CONTRACTOR SHALL ENSURE THAT THE COMMUNICATION STRAND OR MESSENGER IS BONDED TO THE DISTRIBUTION SYSTEM NEUTRAL AT EVERY DIP LOCATION & EVERY 300 METRES.
10. VISIT THE SITE TO CHECK ON AVAILABLE ACCESS, STORAGE AND WORKING AREAS. DETERMINE ANY INTERFERENCE WITH EXISTING SERVICES.
11. SPIRAL WRAP AND TAG ALL EXPOSED FIBER OPTIC CABLE, INCLUDING: DRIP LOOPS, ENDS OF LOOPBACKS & DIPS ABOVE U-GUARDS.
12. AERIAL STRAND SHALL BE 1/4" EHS STRAND, 7-WIRE ZINC COATED, OR 3/8" EHS STRAND, 7-WIRE ZINC COATED, UNLESS NOTED OTHERWISE.
13. LOCATIONS AND DETAILS SHOWN ON THIS DRAWING ARE BASED ON THE BEST INFORMATION AVAILABLE AT TIME OF SURVEY. CONFIRM ALL LOCATIONS, CLEARANCES, AND INTERFERENCES ON SITE PRIOR TO BEGINNING WORK.
14. POLES WERE NOT VERIFIED FOR DECAY, OR DEFICIENCIES DUE TO THE INSTALLATION OF EXISTING ATTACHMENTS.
15. CONTRACTOR TO CONTACT THE ENGINEER IF THE HYDRO LINE ABOVE THE NEW ATTACHMENT HAS A SAG LARGER THAN 1000mm OR IF THE VOLTAGE IS HIGHER THAN 750V.
16. MAKE GOOD ALL EXISTING FINISHES WHEN WORK IS COMPLETE.
17. THE POSITION OF POLE LINES, CONDUITS, WATERMANS, SEWERS AND OTHER UNDERGROUND AND ABOVE GROUND UTILITIES AND STRUCTURES ARE NOT NECESSARILY SHOWN ON THE CONTRACT DRAWINGS, AND WHERE SHOWN, THE ACCURACY OF THE POSITION OF SUCH UTILITIES AND STRUCTURES IS NOT GUARANTEED. BEFORE STARTING WORK, THE CONTRACTOR SHALL CONFIRM THE EXACT LOCATION OF ALL SUCH UTILITIES AND STRUCTURES, AND SHALL ASSUME ALL LIABILITY FOR DAMAGE TO THEM.
18. ALL THE MATERIAL AND EQUIPMENT TO BE ESA AND CSA APPROVED.
19. CONTRACTOR TO USE DOWNGUY SPLITTERS AS REQUIRED IN ORDER TO AVOID CONTACT WITH POWER LINES.
20. ANALYSIS WAS PERFORMED USING THE DETERMINISTIC METHOD ASSUMING THAT THE HIGHEST VOLTAGE OF ANY OF THE EXISTING SUPPLY LINES IS LESS THAN 70 KV PHASE TO PHASE.
21. WHERE EXISTING COMMUNICATIONS ATTACHMENTS ARE SHOWN TO BE RELOCATED, THE THIRD PARTY OWNER OF THE ATTACHMENT MUST BE CONTACTED TO REVIEW AND ENSURE MINIMUM CLEARANCES ARE MAINTAINED IN ACCORDANCE WITH APPLICABLE STANDARDS.

RECORD OF INSPECTION BY CONTRACTOR		
AS CONSTRUCTED		
<input type="checkbox"/> Aerial Installation		
<input type="checkbox"/> U/G Installation		
With changes shown on this Drawing		
Attachment Owner	Permit #	Date
Company Name		
Print Name		
Position		
Signature		
<input type="checkbox"/> This is to certify that the construction as recorded in this drawing is consistent with the approved plan, Standard Designs, or work instruction and that approved equipment has been used.		

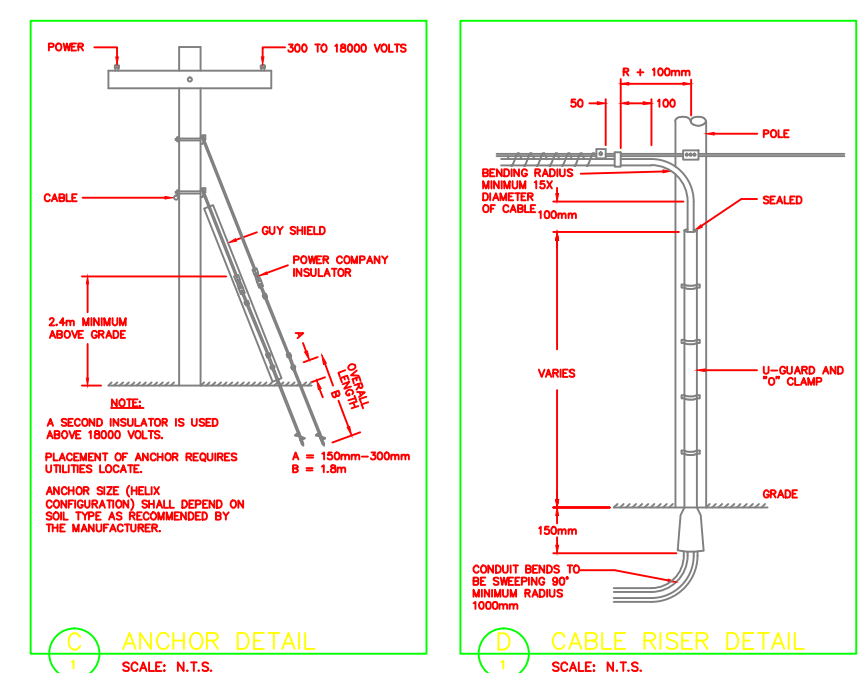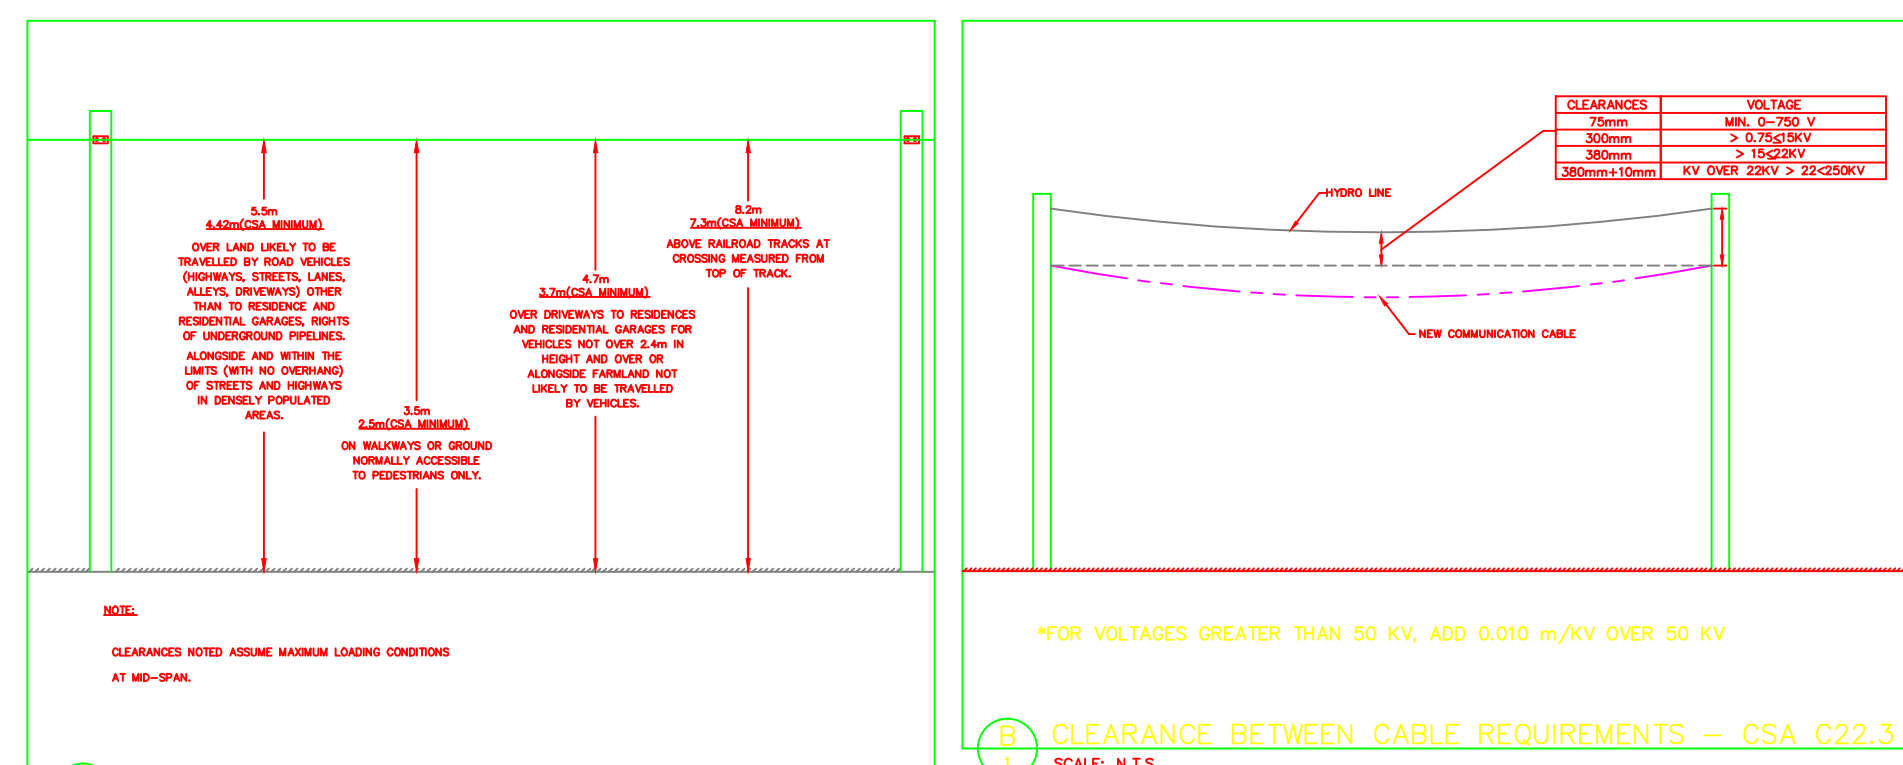


### HYDRO ONE TELECOM ATTACHMENT CERTIFICATE

THIS IS TO CERTIFY THAT THE CONSTRUCTION AS RECORDED IN THIS DRAWING MEETS THE APPLICABLE REQUIREMENTS OF THE SAFETY STANDARDS IN PART 4 OF REGULATION 22/04.

NAME: \_\_\_\_\_ DATE: \_\_\_\_\_

SIGNATURE & PROFESSIONAL DESIGNATION: \_\_\_\_\_

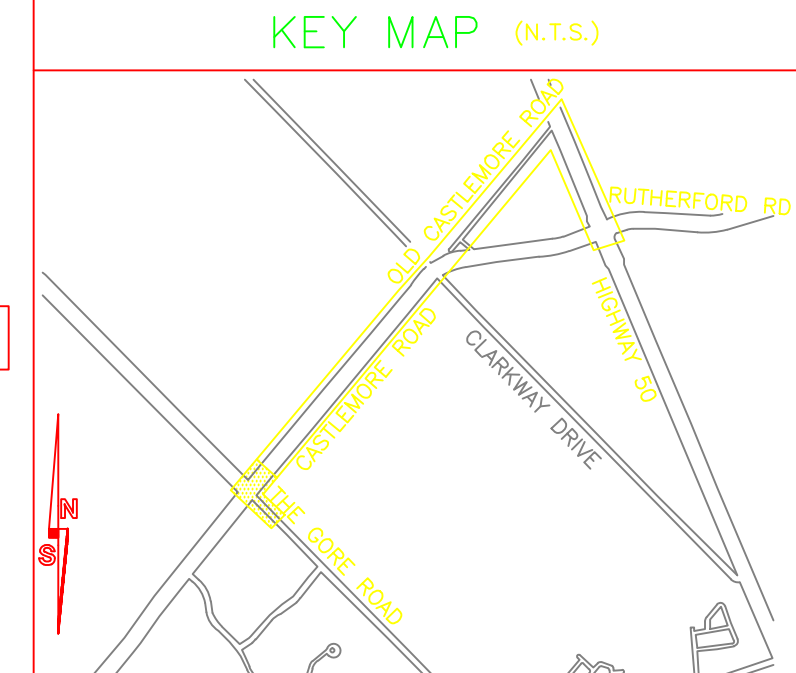

### REFERENCE DRAWINGS

CITY OF BRAMPTON

### LEGEND

NEW FIBER	---
NEW STRAND	----
OVERLASH	-----
EXISTING CONDUIT	-----
UNDERGROUND GAS LINE	-G-
UNDERGROUND WATER	-W-
UNDERGROUND HYDRO	-H-
UNDERGROUND BELL	-BC-
UNDERGROUND CATV	-C-
STORM SEWER	-ST-
SANITARY SEWER	-SS-
PROPERTY LINE	-P/L-
FENCE	---
DITCH	---
EDGE OF PAVEMENT	-E/P-
CURB	---
GRAVEL SHOULDER	---
NEW SPULCE	---
EXISTING SPULCE	---
VAULT	---
BELL PEDESTAL	---
CATV PEDESTAL	---
TRANSFORMER	---
CATCH BASIN	---
WATER VALVE	---
FIRE HYDRANT	---
EXISTING POLE TO BE REMOVED	---
STREET SIGN	---
HYDRO POLE	---
MANHOLE COVER	---
MANHOLE & COVER	---
LARGE ROCK	---
TREE	---
DIP LOCATION	---
NEW DOWNGUY AND ANCHOR	---
NEW SIDEWALK GUY	---
NEW INTERIOR FIBER	---
NEW BACKBOARD	---
EXISTING BACKBOARD	---
NEW PATCH PANEL	---
EXISTING PATCH PANEL	---
NEW EQUIPMENT RACK	---
EXISTING EQUIPMENT RACK	---
NEW FIBER COIL	---

THESE DRAWINGS ARE COPYRIGHT AND THE PROPERTY OF MAGNATE ENGINEERING AND ASSOCIATES INC. REPRODUCTION OF THESE DRAWINGS WITHOUT THE CONSENT OF MAGNATE ENGINEERING AND ASSOCIATES INC. IS STRICTLY PROHIBITED. DO NOT SCALE THESE DRAWINGS. ANY ERRORS OR DISCREPANCY IS TO BE REPORTED IMMEDIATELY TO MAGNATE ENGINEERING AND ASSOCIATES INC.

DATE	REVISION	BY
05/20/2009	ISSUED FOR PERMIT	YC

**hydro one**  
Hydro One Telecommunications

**MAGNATE**  
ENGINEERING AND ASSOCIATES INC.  
18 Automatic Road, Suite 1C  
Brampton, Ontario L6S 5N5  
Telephone: (905) 799-8220

CASTLEMORE RD - THE GORE RD TO HWY 50  
CITY OF BRAMPTON

PROJECT #	CONTRACTOR #	SCALE
	9H005007P	1:500
APPROVED BY:	DATE:	DWG
	05/20/09	1 OF 14
DRAWING NUMBER:		

### CERTIFICATE OF APPROVAL

THE NEW INSTALLATION WORK COVERED BY THIS DOCUMENT MEETS THE SAFETY REQUIREMENTS OF SECTION 4 OF REGULATION 22/04, WITH CONSIDERATIONS OF THE FOLLOWING:

THE DESIGN CONFORMS TO CSA 22.3 NO 1-06 FOR HYDRO ONE TELECOM CLEARANCE, SEPARATION, GUYING AND STRAND TENSION. IT IS NOT INTENDED TO VERIFY THE INTEGRITY OF ATTACHMENTS, ANCHORING OR STRAND TENSIONS OF OTHERS, OR POLE STRENGTH.

POLES WERE NOT INVESTIGATED FOR DEFECTS/ROT.

NAME: \_\_\_\_\_ DATE: \_\_\_\_\_

SIGNATURE OF APPROVAL: \_\_\_\_\_

CONSTRUCTION NOTES

- OVERLASH 108.8m of 1-48 COUNT FIBER OPTIC CABLE ON EXISTING ASSUMED 1/4" EHS HOT STRAND.
INSTALL 2187.3m OF NEW 1/4" EHS STRAND, LASH 1-48 COUNT FIBER OPTIC CABLE.
INSTALL 545.3m OF NEW 1/4" EHS STRAND, LASH 1-48 COUNT FIBER OPTIC CABLE.
INSTALL NEW NEUTRAL BOND AND GROUND ROD, AND WIRE.
INSTALL NEW 10.0m LOOPBACK.
INSTALL NEW DOWNGUY AND ANCHOR.
INSTALL NEW RISER C/W U-GUARD.
INSTALL NEW HYDRO ONE SPULCE ENCLOSURE.
INSTALL NEW 1/4" OVERHEAD GUY.

SCOPE OF WORK

Table with 2 columns: Item description and Quantity. Includes items like NEW OVERHEAD GUY (3=61.5m), NEW DOWNGUY AND ANCHOR (9), NEW 48 COUNT FIBER OPTIC CABLE (2896.2m), etc.

NOTE: INFORMATION WAS OBTAINED FROM DRAWINGS SUPPLIED BY: 1. PHOTOGRAPHS OF PLAN AND PROFILE PROVIDED BY THE CITY OF BRAMPTON AND REGION OF PEEL.

HYDRO ONE TELECOM CONTACT: IAN MITCHELL, HYDRO ONE TELECOM INC, 85 KEELE RD, UNIT 513, BRAMPTON, ONT. M6Y 5A3. PHONE: (416) 245-8370, FAX: (416) 245-7292, CELL: (416) 245-7292, EMAIL: ian.mitchell@hydroone.com

ANCHOR SPECIFICATIONS




Table with 2 columns: ANCHOR TYPE and ANCHOR STRENGTH. Includes SINGLE HELIX 8", 10", 12", 14" and TRIPLE HELIX, 8"-10"-12".

CALCULATION FOR REQUIRED STRENGTH OF ANCHOR IS BASED ON -20" WITH 0.5" OF ICE AND SOIL CLASS 4 (MEDIUM DENSE SANDY GRAVEL; VERY STIFF TO HARD SILTS AND CLAYS).


GENERAL NOTES AERIAL DESIGN AND CONSTRUCTION

- 1. ALL CONSTRUCTION WORK SHALL BE IN CONFORMANCE WITH CANADIAN, PROVINCIAL AND ONTARIO HYDRO SERVICES COMPANY SAFETY REQUIREMENTS. THESE INCLUDES WITHOUT LIMITATION: - OHSC WORK PROTECTION CODE, - OCCUPATIONAL HEALTH AND SAFETY ACT, - THIS DESIGN CONFORMS TO CSA STANDARD C22.3 NO. 1-06.
2. TAKE THE NECESSARY PRECAUTIONS TO PROTECT THE EXISTING INSTALLATION FROM DAMAGE. THE CONTRACTOR WILL BE RESPONSIBLE FOR ALL THE CLAIMS DUE TO DAMAGE.
3. ALL REVISIONS MUST BE MADE PRIOR TO CONSTRUCTION.
4. ALL BOLTS MUST PROVIDE FOR 25mm OF EXPOSED THREAD.
5. ASSUME SOIL CONDITIONS AT ANCHOR POINT ARE AS FOLLOWS: - MEDIUM DENSE SANDY GRAVEL; VERY STIFF TO HARD SILTS AND CLAYS.
6. THE CONTRACTOR SHALL CHECK AND VERIFY ALL SITE CONDITIONS, CLEARANCES AND DIMENSIONS AT THE SITE AND REPORT ANY DISCREPANCIES TO THE ENGINEER BEFORE PROCEEDING WITH WORK.
7. SAGS & CLEARANCES ARE CHECKED AND CALCULATED FOR NEW ATTACHMENTS ONLY.
8. POLES NOT CHECKED FOR OVERALL LOADING. ADDITIONAL APPLIED LOADS ARE SHOWN ON THIS DRAWING DUE TO NEW ATTACHMENTS ONLY.
9. THE CONTRACTOR SHALL ENSURE THAT THE COMMUNICATION STRAND OR MESSENGER IS BONDED TO THE DISTRIBUTION SYSTEM NEUTRAL AT EVERY DIP LOCATION & EVERY 300 METRES.
10. VISIT THE SITE TO CHECK ON AVAILABLE ACCESS, STORAGE AND WORKING AREAS. DETERMINE ANY INTERFERENCE WITH EXISTING SERVICES.
11. SPIRAL WRAP AND TAG ALL EXPOSED FIBER OPTIC CABLE, INCLUDING: DRIP LOOPS, ENDS OF LOOPBACKS & DIPS ABOVE U-GUARDS.
12. AERIAL STRAND SHALL BE 1/4" EHS STRAND, 7-WIRE ZINC COATED, OR 3/8" EHS STRAND, 7-WIRE ZINC COATED, UNLESS NOTED OTHERWISE.
13. LOCATIONS AND DETAILS SHOWN ON THIS DRAWING ARE BASED ON THE BEST INFORMATION AVAILABLE AT TIME OF SURVEY. CONFIRM ALL LOCATIONS, CLEARANCES, AND INTERFERENCES ON SITE PRIOR TO BEGINNING WORK.
14. POLES WERE NOT VERIFIED FOR DECAY, OR DEFICIENCIES DUE TO THE INSTALLATION OF EXISTING ATTACHMENTS.
15. CONTRACTOR TO CONTACT THE ENGINEER IF THE HYDRO LINE ABOVE THE NEW ATTACHMENT HAS A SAG LARGER THAN 1000mm OR IF THE VOLTAGE IS HIGHER THAN 750V.
16. MAKE GOOD ALL EXISTING FINISHES WHEN WORK IS COMPLETE.
17. THE POSITION OF POLE LINES, CONDUITS, WATERMANS, SEWERS AND OTHER UNDERGROUND AND ABOVE GROUND UTILITIES AND STRUCTURES ARE NOT NECESSARILY SHOWN ON THE CONTRACT DRAWINGS, AND WHERE SHOWN, THE ACCURACY OF THE POSITION OF SUCH UTILITIES AND STRUCTURES IS NOT GUARANTEED. BEFORE STARTING WORK, THE CONTRACTOR SHALL CONFIRM THE EXACT LOCATION OF ALL SUCH UTILITIES AND STRUCTURES, AND SHALL ASSUME ALL LIABILITY FOR DAMAGE TO THEM.
18. ALL THE MATERIAL AND EQUIPMENT TO BE ESA AND CSA APPROVED.
19. CONTRACTOR TO USE DOWNGUY SPLITTERS AS REQUIRED IN ORDER TO AVOID CONTACT WITH POWER LINES.
20. ANALYSIS WAS PERFORMED USING THE DETERMINISTIC METHOD ASSUMING THAT THE HIGHEST VOLTAGE OF ANY OF THE EXISTING SUPPLY LINES IS LESS THAN 70 KV PHASE TO PHASE.
21. WHERE EXISTING COMMUNICATIONS ATTACHMENTS ARE SHOWN TO BE RELOCATED, THE THIRD PARTY OWNER OF THE ATTACHMENT MUST BE CONTACTED TO REVIEW AND ENSURE MINIMUM CLEARANCES ARE MAINTAINED IN ACCORDANCE WITH APPLICABLE STANDARDS.

RECORD OF INSPECTION BY CONTRACTOR table with columns for Attachment Owner, Permit #, Date, Company Name, Print Name, Position, Signature, and checkboxes for AS CONSTRUCTED, Aerial Installation, U/G Installation, and a confirmation statement.

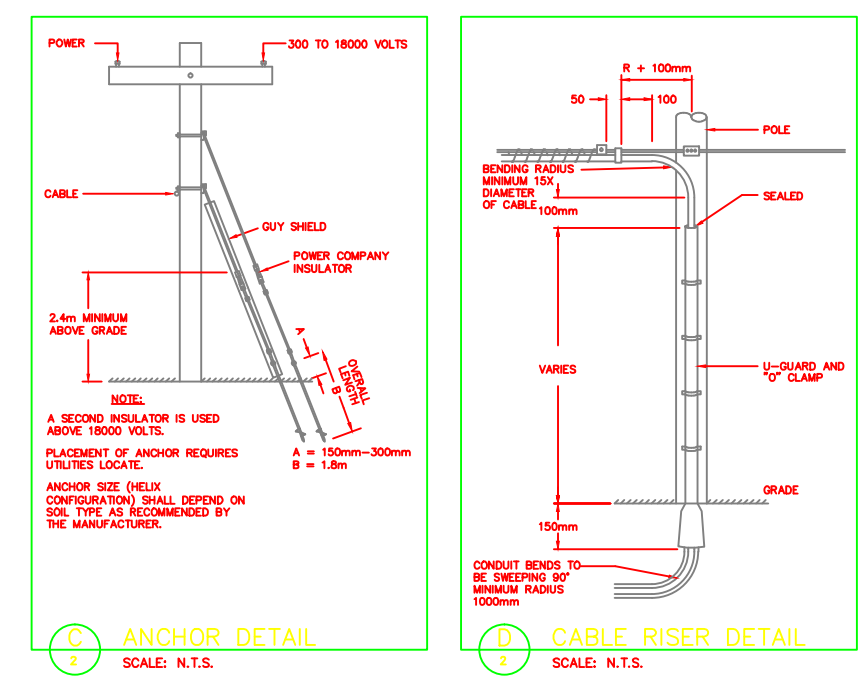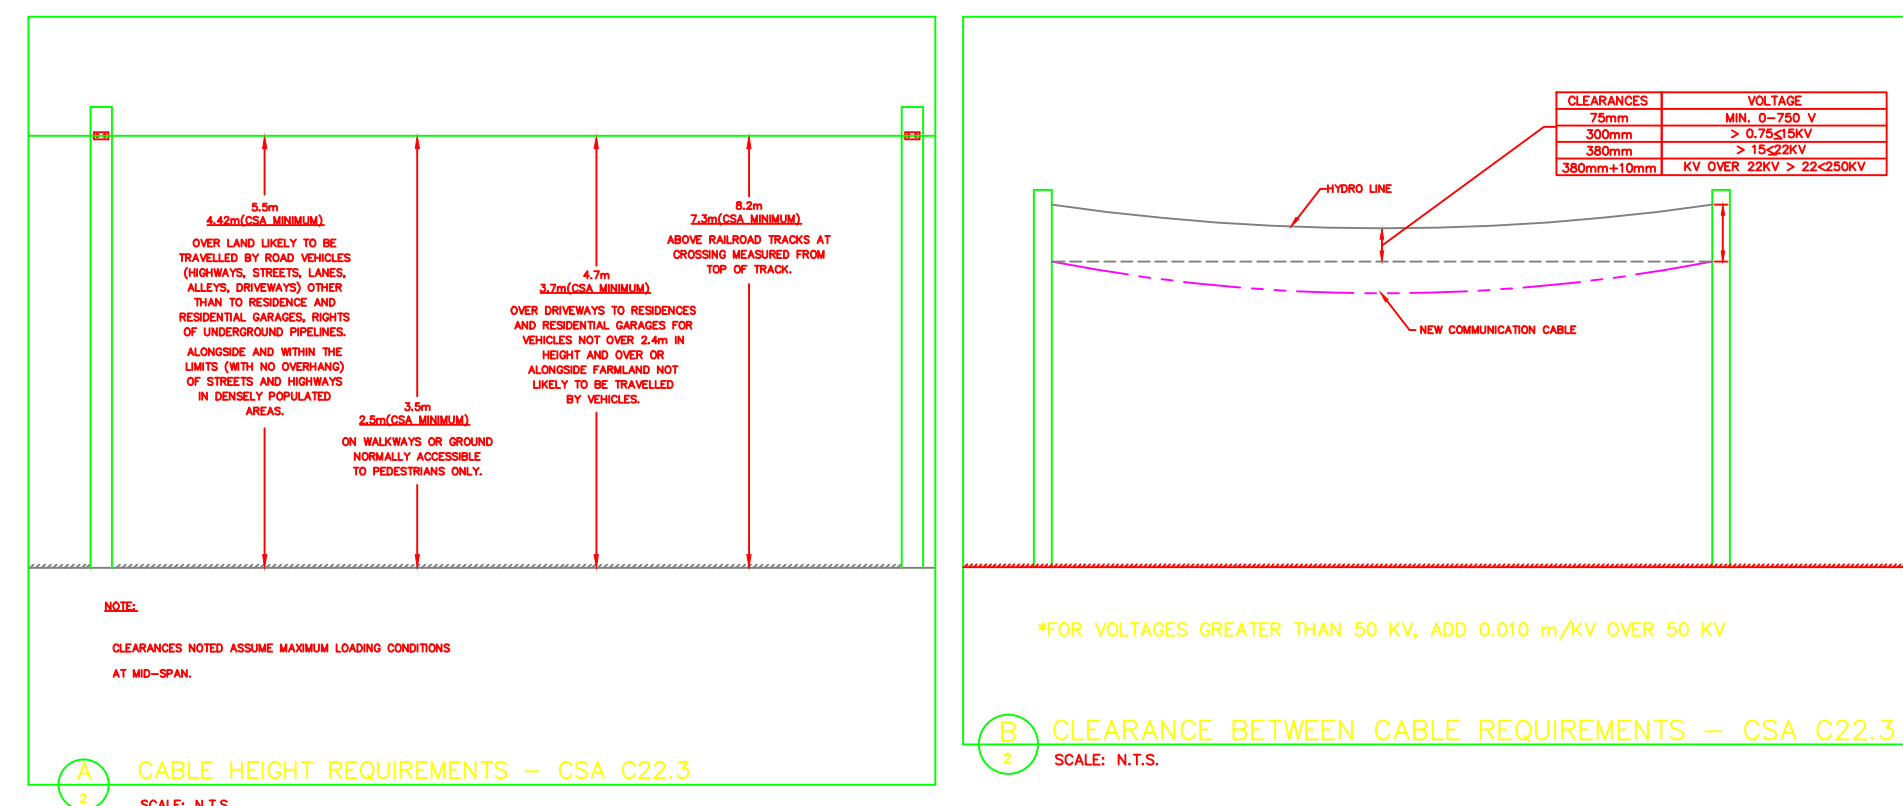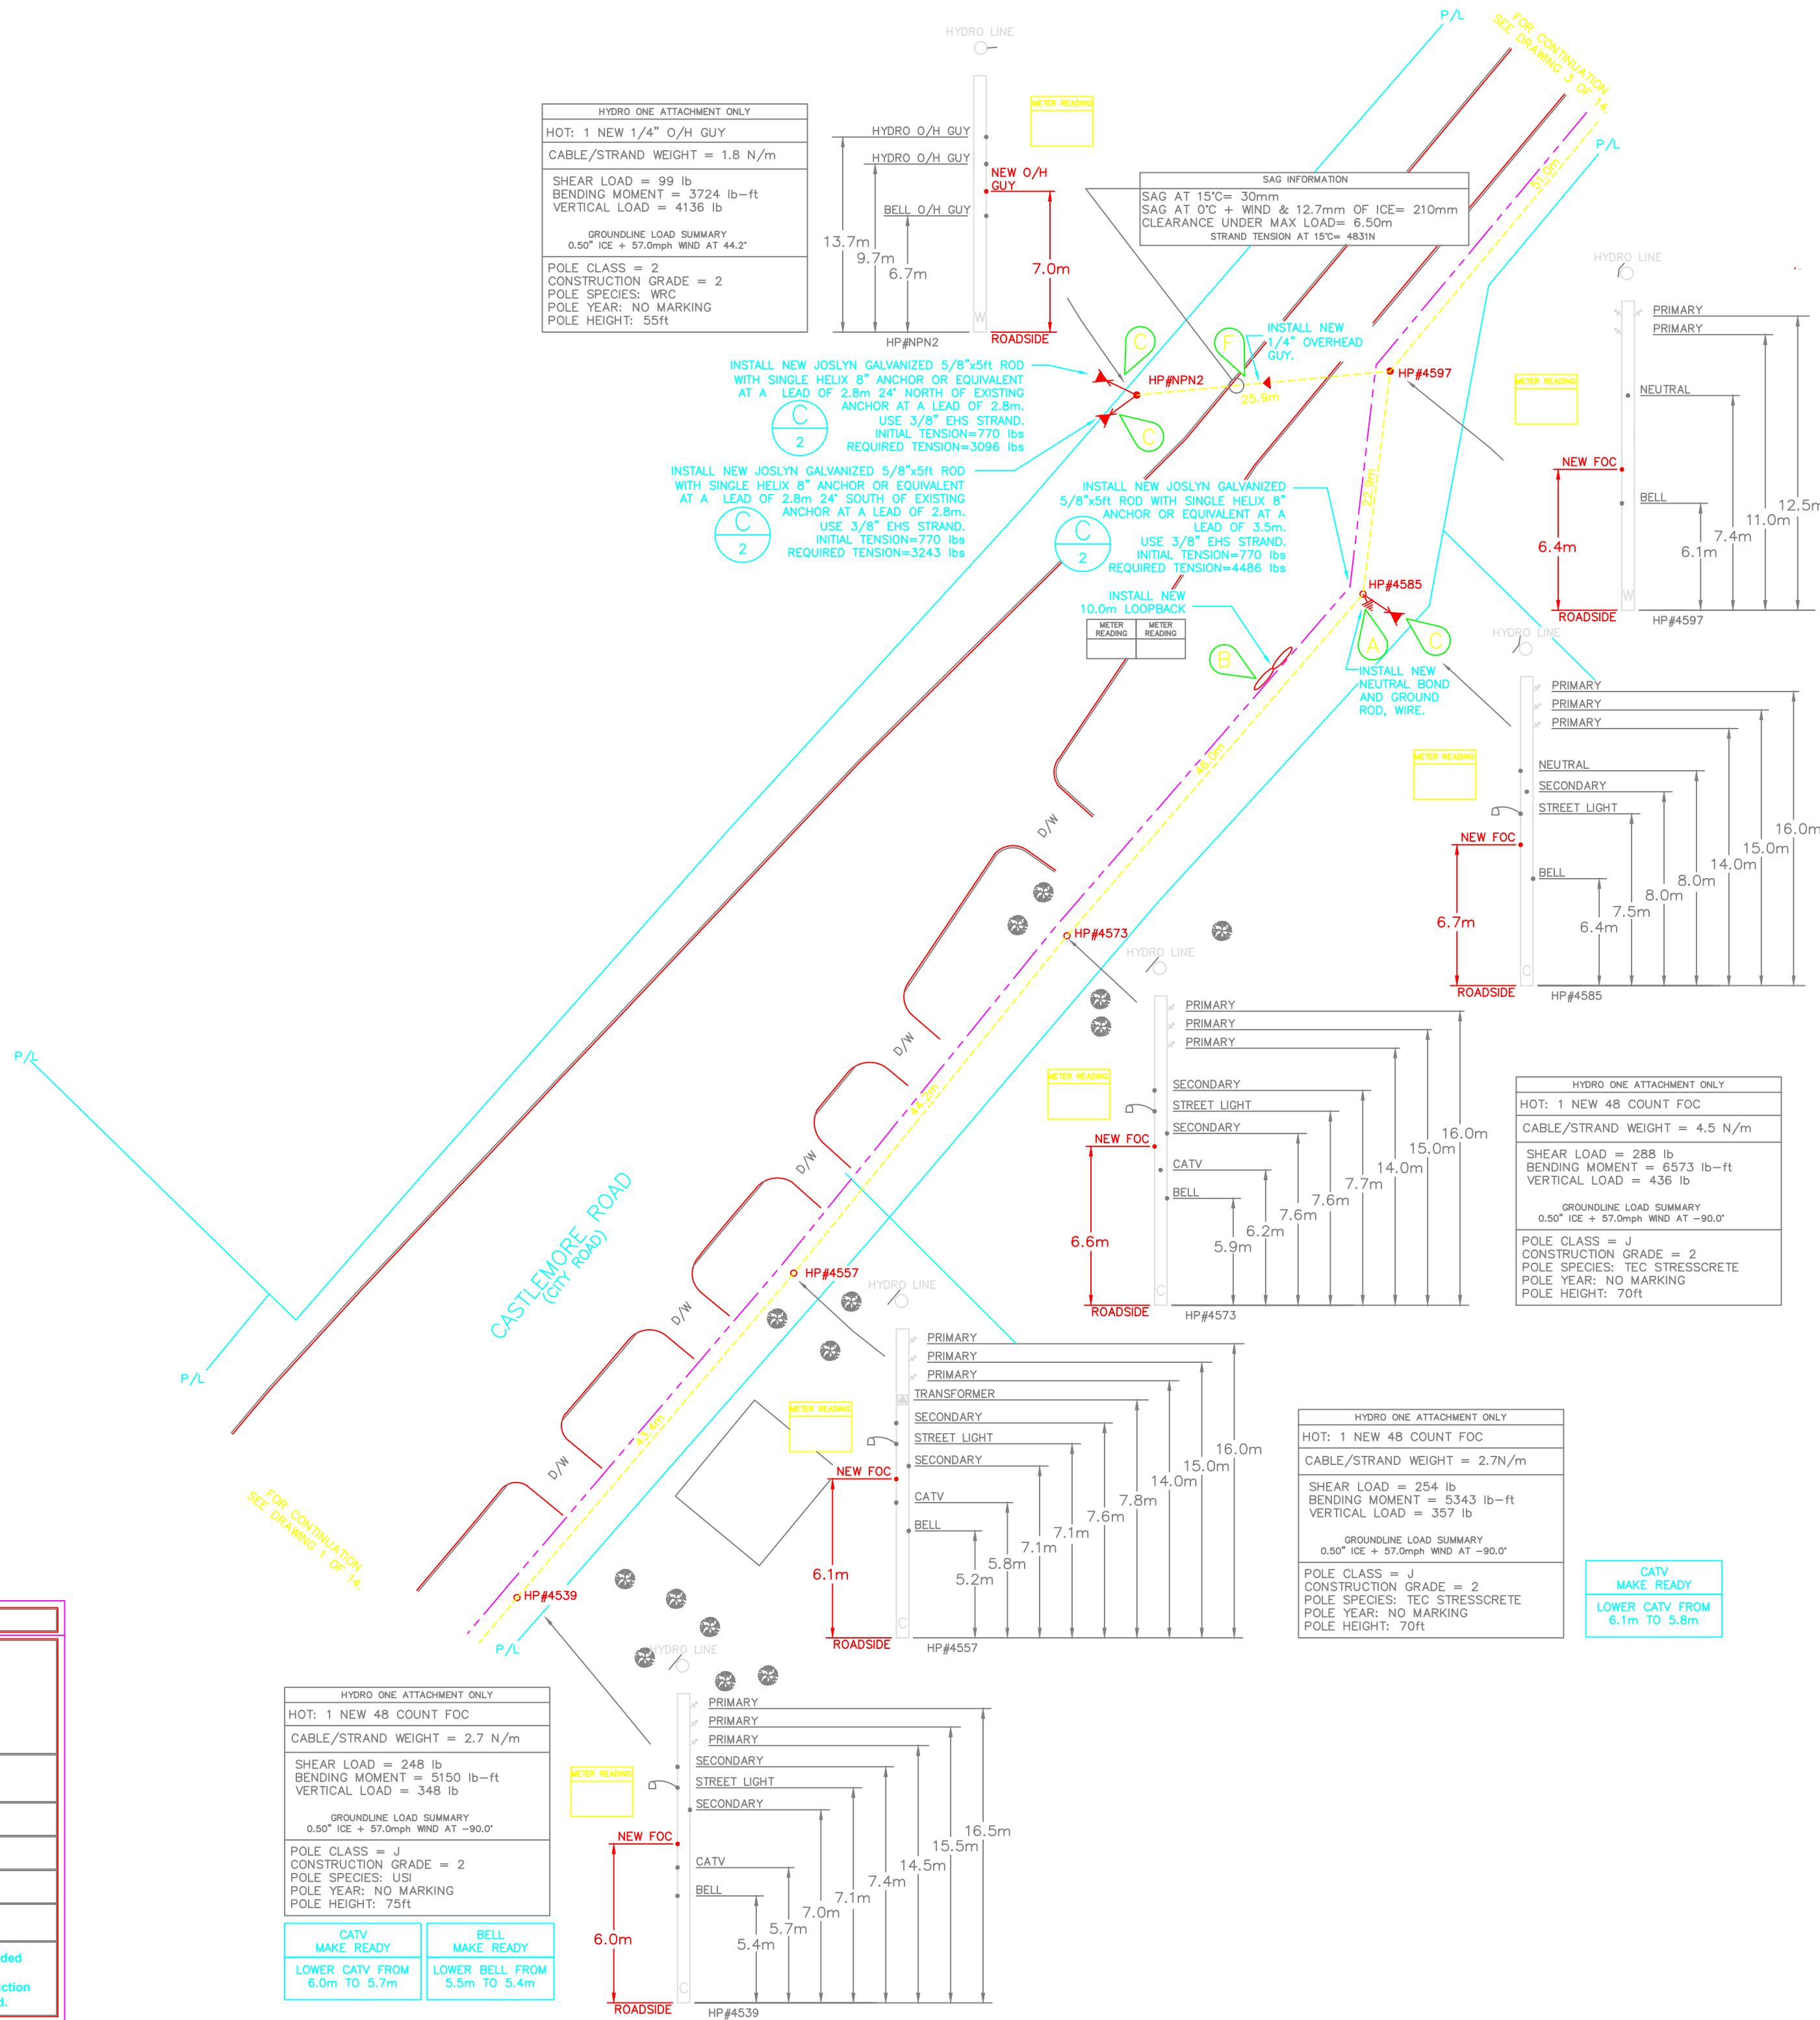

HYDRO ONE TELECOM ATTACHMENT CERTIFICATE. THIS IS TO CERTIFY THAT THE CONSTRUCTION AS RECORDED IN THIS DRAWING MEETS THE APPLICABLE REQUIREMENTS OF THE SAFETY STANDARDS IN PART 4 OF REGULATION 22/04. Includes fields for NAME, DATE, and SIGNATURE & PROFESSIONAL DESIGNATION.

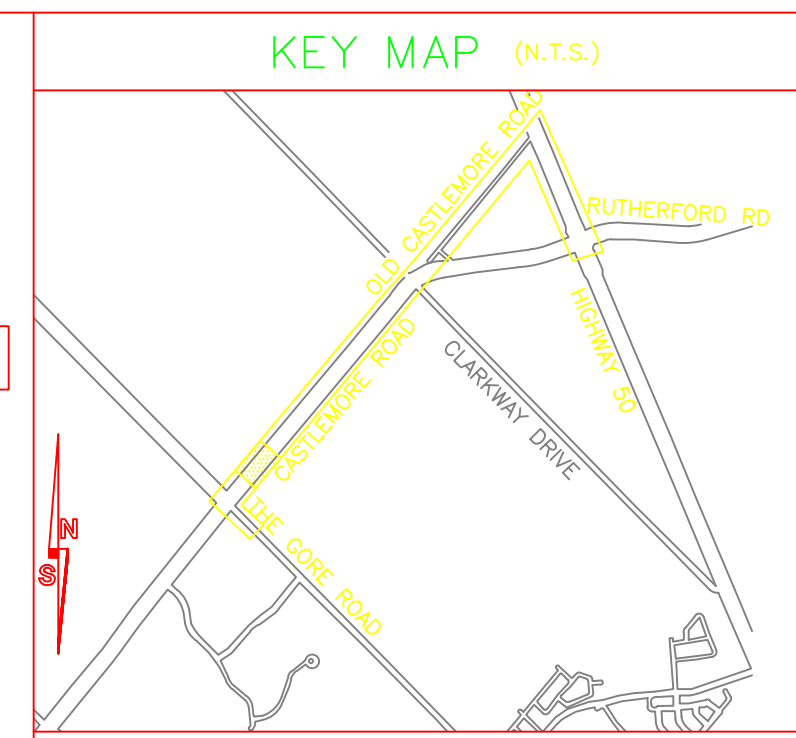

REFERENCE DRAWINGS

CITY OF BRAMPTON

LEGEND

Legend table listing symbols for various utility lines and structures. External items include New Fiber, New Strand, Overlash, Existing Conduit, Underground Gas Line, etc. Internal items include Fiber I.D.#, BTMN-(Cable I.D.)-(Fibre Count).



FOR NEW CABLE ATTACHMENT TO HYDRO POLE ONLY, INCLUDING: TENSIONING FOR CLEARANCES AND NEW CABLE LOADS. MAGNATE ENGINEERING AND ASSOCIATES INC. 18 Automatic Road Suite 1C Brampton, Ontario L6S 5N5 Telephone: (905) 799-8220

CERTIFICATE OF APPROVAL. THE NEW INSTALLATION WORK COVERED BY THIS DOCUMENT MEETS THE SAFETY REQUIREMENTS OF SECTION 4 OF REGULATION 22/04, WITH CONSIDERATIONS OF THE FOLLOWING: THE DESIGN CONFORMS TO CSA C22.3 NO 1-06 FOR HYDRO ONE TELECOM CLEARANCE, SEPARATION, GUYING AND STRAND TENSION. IT IS NOT INTENDED TO VERIFY THE INTEGRITY OF ATTACHMENTS, ANCHORING OR STRAND TENSIONS OF OTHERS, OR POLE STRENGTH. POLES WERE NOT INVESTIGATED FOR DEFECTS/ROT. Includes fields for NAME, DATE, and SIGNATURE OF APPROVAL.

THESE DRAWINGS ARE COPYRIGHT AND THE PROPERTY OF MAGNATE ENGINEERING AND ASSOCIATES INC. REPRODUCTION OF THESE DRAWINGS WITHOUT THE CONSENT OF MAGNATE ENGINEERING AND ASSOCIATES INC. IS STRICTLY PROHIBITED. DO NOT SCALE THESE DRAWINGS. ANY ERRORS OR DISCREPANCY IS TO BE REPORTED IMMEDIATELY TO MAGNATE ENGINEERING AND ASSOCIATES INC.

Table with 3 columns: DATE, REVISION, and BY. Shows 05/20/2009 ISSUED FOR PERMIT YC.

hydro one logo and Hydro One Telecommunications name.

MAGNATE ENGINEERING AND ASSOCIATES INC. logo and address: 18 Automatic Road, Suite 1C Brampton, Ontario L6S 5N5 Telephone: (905) 799-8220

Project summary table: PROJECT # 9H005007P, CONTRACTOR #, SCALE 1:500, APPROVED BY, DATE 05/20/09, DWG 2 OF 14, DRAWING NUMBER.

### CONSTRUCTION NOTES

- 1 OVERLASH 108.8m OF 1-48 COUNT FIBER OPTIC CABLE ON EXISTING ASSUMED 1/4" EHS HOT STRAND.
- 2 INSTALL 2187.3m OF NEW 1/4" EHS STRAND, LASH 1-48 COUNT FIBER OPTIC CABLE.
- 3 INSTALL 545.3m OF NEW 1/4" EHS STRAND, LASH 1-48 COUNT FIBER OPTIC CABLE.
- 4 INSTALL NEW NEUTRAL BOND AND GROUND ROD, AND WIRE.
- 5 INSTALL NEW 10.0m LOOPBACK.
- 6 INSTALL NEW DOWNGUY AND ANCHOR. (+)
- 7 INSTALL NEW RISER C/W U-GUARD. (+)
- 8 INSTALL NEW HYDRO ONE SPULCE ENCLOSURE.
- 9 INSTALL NEW 1/4" OVERHEAD GUY.

### SCOPE OF WORK

NEW OVERHEAD GUY	3=61.5m
NEW DOWNGUY AND ANCHOR	9
NEW 48 COUNT FIBER OPTIC CABLE	2996.2m
NEW OVERLASH	108.8m
NEW LASHWIRE	8524.2m
NEW 1/4" EHS STRAND	2732.6m
NEW CATV MAKE READY	3
NEW HOT MAKE READY	1
NEW BELL MAKE READY	12
NEW HYDRO MAKE READY	2
NEW RISER C/W U-GUARD	2
NEW SPULCE ENCLOSURE	1
NEW GROUND ROD AND WIRE	11=110.0m

NOTE: INFORMATION WAS OBTAINED FROM DRAWINGS SUPPLIED BY:  
1. PHOTOGRAPHS OF PLAN AND PROFILE PROVIDED BY THE CITY OF BRAMPTON AND REGION OF PEEL.

**HYDRO ONE TELECOM CONTACT**  
IAN MITCHELL  
HYDRO ONE TELECOM INC  
65 KEELEFIELD STREET  
SCARBOROUGH, ONT. M1B 5A3  
PHONE: (416) 249-4370  
FAX: (416) 249-4399  
CELL: (416) 249-4370  
EMAIL: ian.mitchell@hydroone.com

### ANCHOR SPECIFICATIONS





ANCHOR TYPE	ANCHOR STRENGTH
SINGLE HELIX 8"	14000lbs
SINGLE HELIX 10"	20000lbs
SINGLE HELIX 12"	25000lbs
SINGLE HELIX 14"	31000lbs
TRIPLE HELIX, 8"-10"-12"	46000lbs

CALCULATION FOR REQUIRED STRENGTH OF ANCHOR IS BASED ON -20" WITH 0.5" OF ICE AND SOIL CLASS 4 (MEDIUM DENSE SANDY GRAVEL; VERY STIFF TO HARD SILTS AND CLAYS).

### GENERAL NOTES AERIAL DESIGN AND CONSTRUCTION

1. ALL CONSTRUCTION WORK SHALL BE IN CONFORMANCE WITH CANADIAN, PROVINCIAL AND ONTARIO HYDRO SERVICES COMPANY SAFETY REQUIREMENTS. THESE INCLUDES WITHOUT LIMITATION:
  - OHS WORK PROTECTION CODE
  - OCCUPATIONAL HEALTH AND SAFETY ACT
  - THIS DESIGN CONFORMS TO CSA STANDARD C22.3 NO. 1-06.
2. TAKE THE NECESSARY PRECAUTIONS TO PROTECT THE EXISTING INSTALLATION FROM DAMAGE. THE CONTRACTOR WILL BE RESPONSIBLE FOR ALL THE CLAIMS DUE TO DAMAGE.
3. ALL REVISIONS MUST BE MADE PRIOR TO CONSTRUCTION.
4. ALL BOLTS MUST PROVIDE FOR 25mm OF EXPOSED THREAD.
5. ASSUME SOIL CONDITIONS AT ANCHOR POINT ARE AS FOLLOWS:
  - MEDIUM DENSE SANDY GRAVEL; VERY STIFF TO HARD SILTS AND CLAYS.
6. THE CONTRACTOR SHALL CHECK AND VERIFY ALL SITE CONDITIONS, CLEARANCES AND DIMENSIONS AT THE SITE AND REPORT ANY DISCREPANCIES TO THE ENGINEER BEFORE PROCEEDING WITH WORK.
7. SAGS & CLEARANCES ARE CHECKED AND CALCULATED FOR NEW ATTACHMENTS ONLY.
8. POLES NOT CHECKED FOR OVERALL LOADING. ADDITIONAL APPLIED LOADS ARE SHOWN ON THIS DRAWING DUE TO NEW ATTACHMENTS ONLY.
9. THE CONTRACTOR SHALL ENSURE THAT THE COMMUNICATION STRAND OR MESSENGER IS BONDED TO THE DISTRIBUTION SYSTEM NEUTRAL AT EVERY DIP LOCATION & EVERY 300 METRES.
10. VISIT THE SITE TO CHECK ON AVAILABLE ACCESS, STORAGE AND WORKING AREAS. DETERMINE ANY INTERFERENCE WITH EXISTING SERVICES.
11. SPIRAL WRAP AND TAG ALL EXPOSED FIBER OPTIC CABLE, INCLUDING: DRIP LOOPS, ENDS OF LOOPBACKS & DIPS ABOVE U-GUARDS.
12. AERIAL STRAND SHALL BE 1/4" EHS STRAND, 7-WIRE ZINC COATED, OR 3/8" EHS STRAND, 7-WIRE ZINC COATED, UNLESS NOTED OTHERWISE.
13. LOCATIONS AND DETAILS SHOWN ON THIS DRAWING ARE BASED ON THE BEST INFORMATION AVAILABLE AT TIME OF SURVEY. CONFIRM ALL LOCATIONS, CLEARANCES, AND INTERFERENCES ON SITE PRIOR TO BEGINNING WORK.
14. POLES WERE NOT VERIFIED FOR DECAY, OR DEFICIENCIES DUE TO THE INSTALLATION OF EXISTING ATTACHMENTS.
15. CONTRACTOR TO CONTACT THE ENGINEER IF THE HYDRO LINE ABOVE THE NEW ATTACHMENT HAS A SAG LARGER THAN 1000mm OR IF THE VOLTAGE IS HIGHER THAN 750V.
16. MAKE GOOD ALL EXISTING FINISHES WHEN WORK IS COMPLETE.
17. THE POSITION OF POLE LINES, CONDUITS, WATERMANS, SEWERS AND OTHER UNDERGROUND AND ABOVE GROUND UTILITIES AND STRUCTURES ARE NOT NECESSARILY SHOWN ON THE CONTRACT DRAWINGS, AND WHERE SHOWN, THE ACCURACY OF THE POSITION OF SUCH UTILITIES AND STRUCTURES IS NOT GUARANTEED. BEFORE STARTING WORK, THE CONTRACTOR SHALL CONFIRM THE EXACT LOCATION OF ALL SUCH UTILITIES AND STRUCTURES, AND SHALL ASSUME ALL LIABILITY FOR DAMAGE TO THEM.
18. ALL THE MATERIAL AND EQUIPMENT TO BE ESA AND CSA APPROVED.
19. CONTRACTOR TO USE DOWNGUY SPLITTERS AS REQUIRED IN ORDER TO AVOID CONTACT WITH POWER LINES.
20. ANALYSIS WAS PERFORMED USING THE DETERMINISTIC METHOD ASSUMING THAT THE HIGHEST VOLTAGE OF ANY OF THE EXISTING SUPPLY LINES IS LESS THAN 70 KV PHASE TO PHASE.
21. WHERE EXISTING COMMUNICATIONS ATTACHMENTS ARE SHOWN TO BE RELOCATED, THE THIRD PARTY OWNER OF THE ATTACHMENT MUST BE CONTACTED TO REVIEW AND ENSURE MINIMUM CLEARANCES ARE MAINTAINED IN ACCORDANCE WITH APPLICABLE STANDARDS.

RECORD OF INSPECTION BY CONSTRUCTOR	
AS CONSTRUCTED	<input type="checkbox"/> Aerial Installation
	<input type="checkbox"/> U/G Installation
With changes shown on this Drawing	
Attachment Owner	Permit #
	Date
Company Name	
Print Name	
Position	
Signature	
<input type="checkbox"/> This is to certify that the construction as recorded in this drawing is consistent with the approved plan, Standard Designs, or work instruction and that approved equipment has been used.	

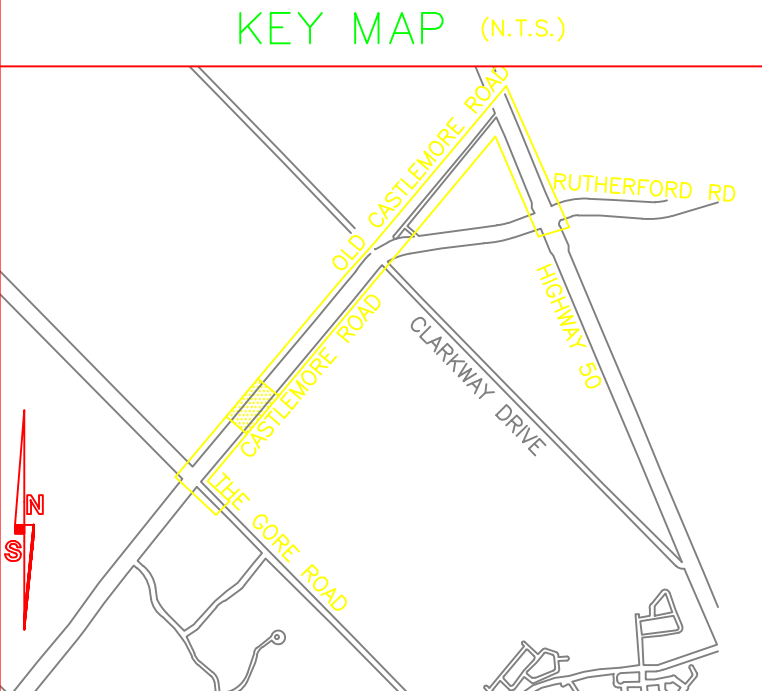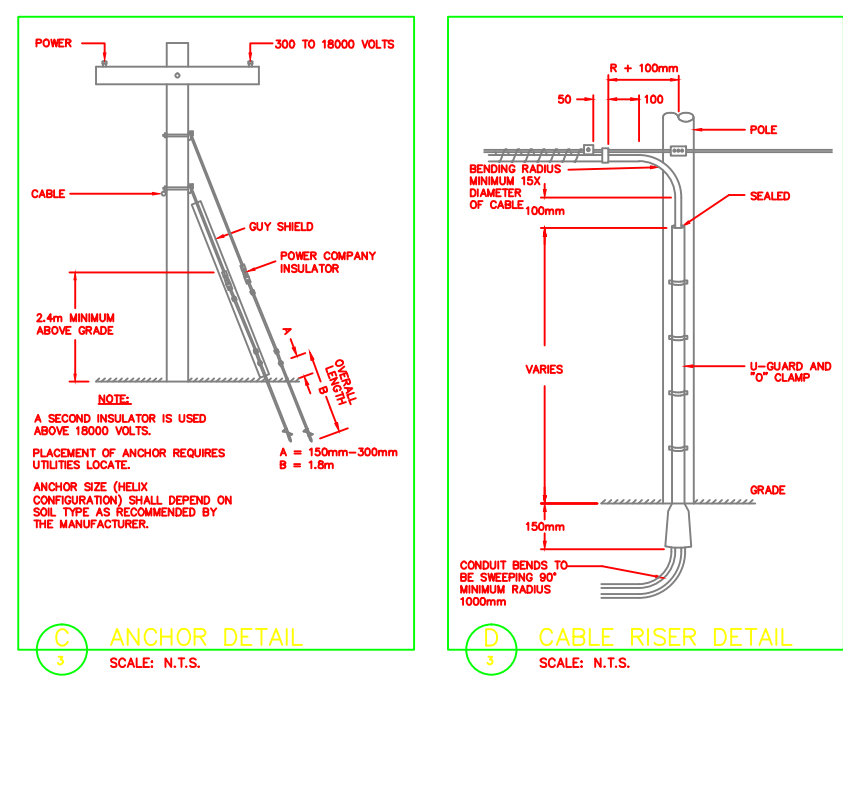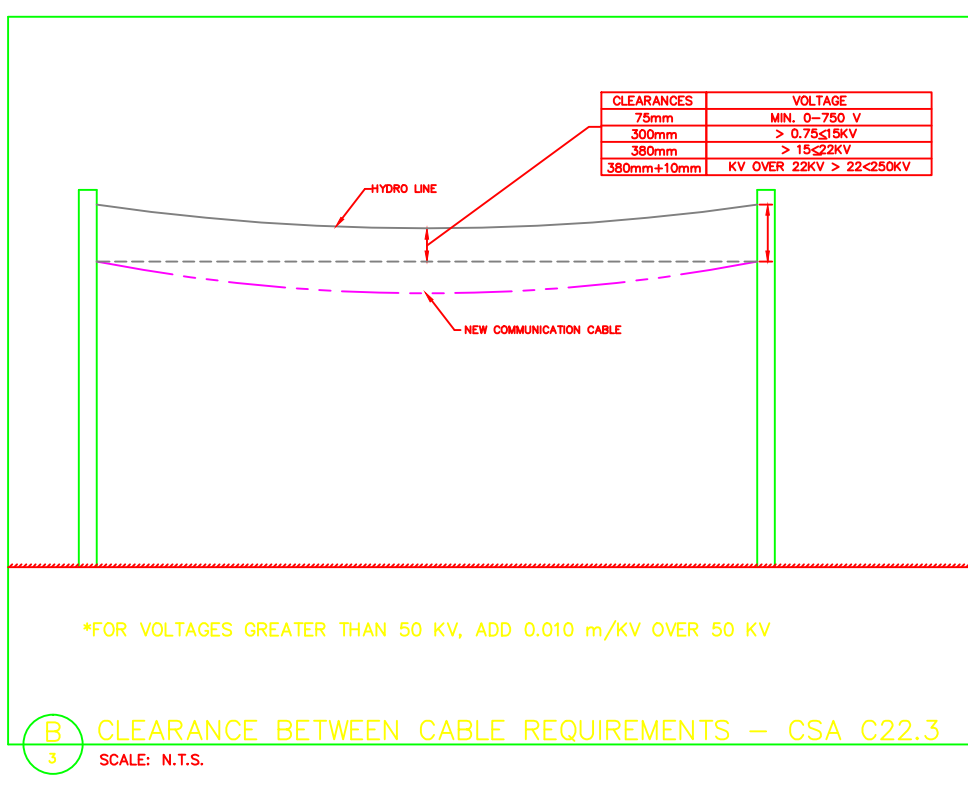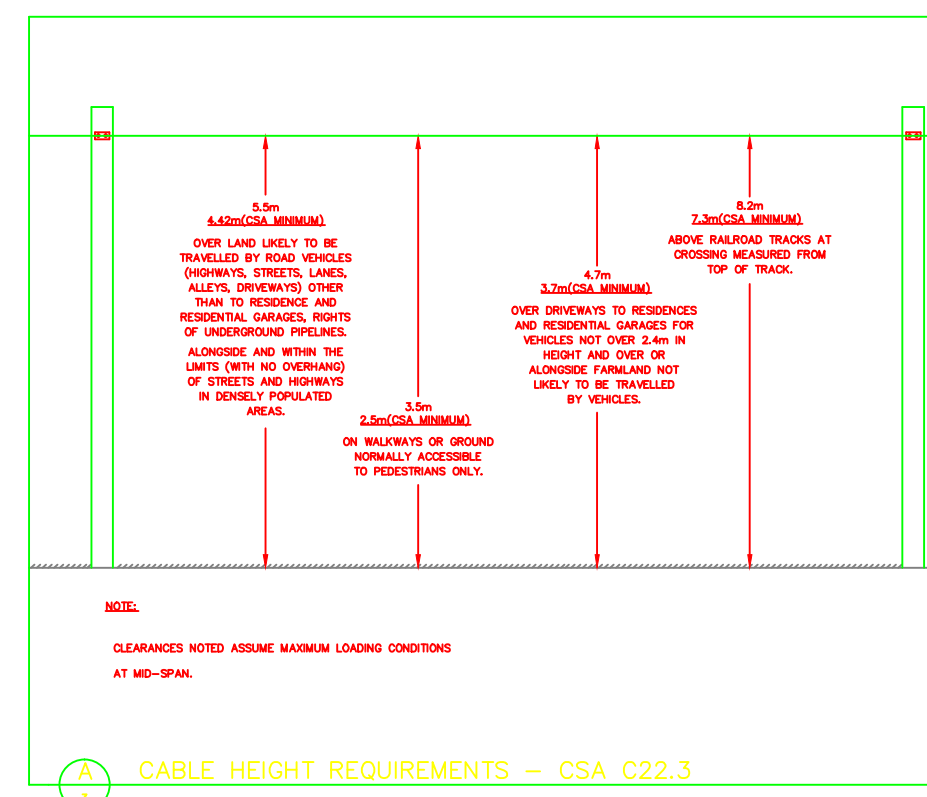


### REFERENCE DRAWINGS

### CITY OF BRAMPTON

### LEGEND

NEW FIBER	---
NEW STRAND	----
OVERLASH	-----
EXISTING CONDUIT	-----
UNDERGROUND GAS LINE	—G—
UNDERGROUND WATER	—W—
UNDERGROUND HYDRO	—H—
UNDERGROUND BELL	—BC—
UNDERGROUND CATV	—BC—
STORM SEWER	—ST—
SANITARY SEWER	—SS—
PROPERTY LINE	—P/L—
FENCE	—F—
DITCH	—D—
EDGE OF PAVEMENT	—E/P—
CURB	—C—
GRAVEL SHOULDER	—GS—
NEW SPULCE	—S—
EXISTING SPULCE	—S—
VAULT	—V—
BELL PEDESTAL	—BP—
CATV PEDESTAL	—CP—
TRANSFORMER	—T—
CATCH BASIN	—CB—
WATER VALVE	—WV—
FIRE HYDRANT	—FH—
EXISTING POLE TO BE REMOVED	—EP—
STREET SIGN	—SS—
HYDRO POLE	—HP—
MANHOLE COVER	—MC—
MANHOLE & COVER	—MHC—
LARGE ROCK	—LR—
TREE	—TR—
DIP LOCATION	—DL—
NEW DOWNGUY AND ANCHOR	—NDA—
NEW SIDEWALK GUY	—NSG—
NEW INTERIOR FIBER	—NIF—
NEW BACKBOARD	—NB—
EXISTING BACKBOARD	—EB—
NEW PATCH PANEL	—NPP—
EXISTING PATCH PANEL	—EPP—
NEW EQUIPMENT RACK	—NER—
EXISTING EQUIPMENT RACK	—EER—
NEW FIBER COIL	—NFC—

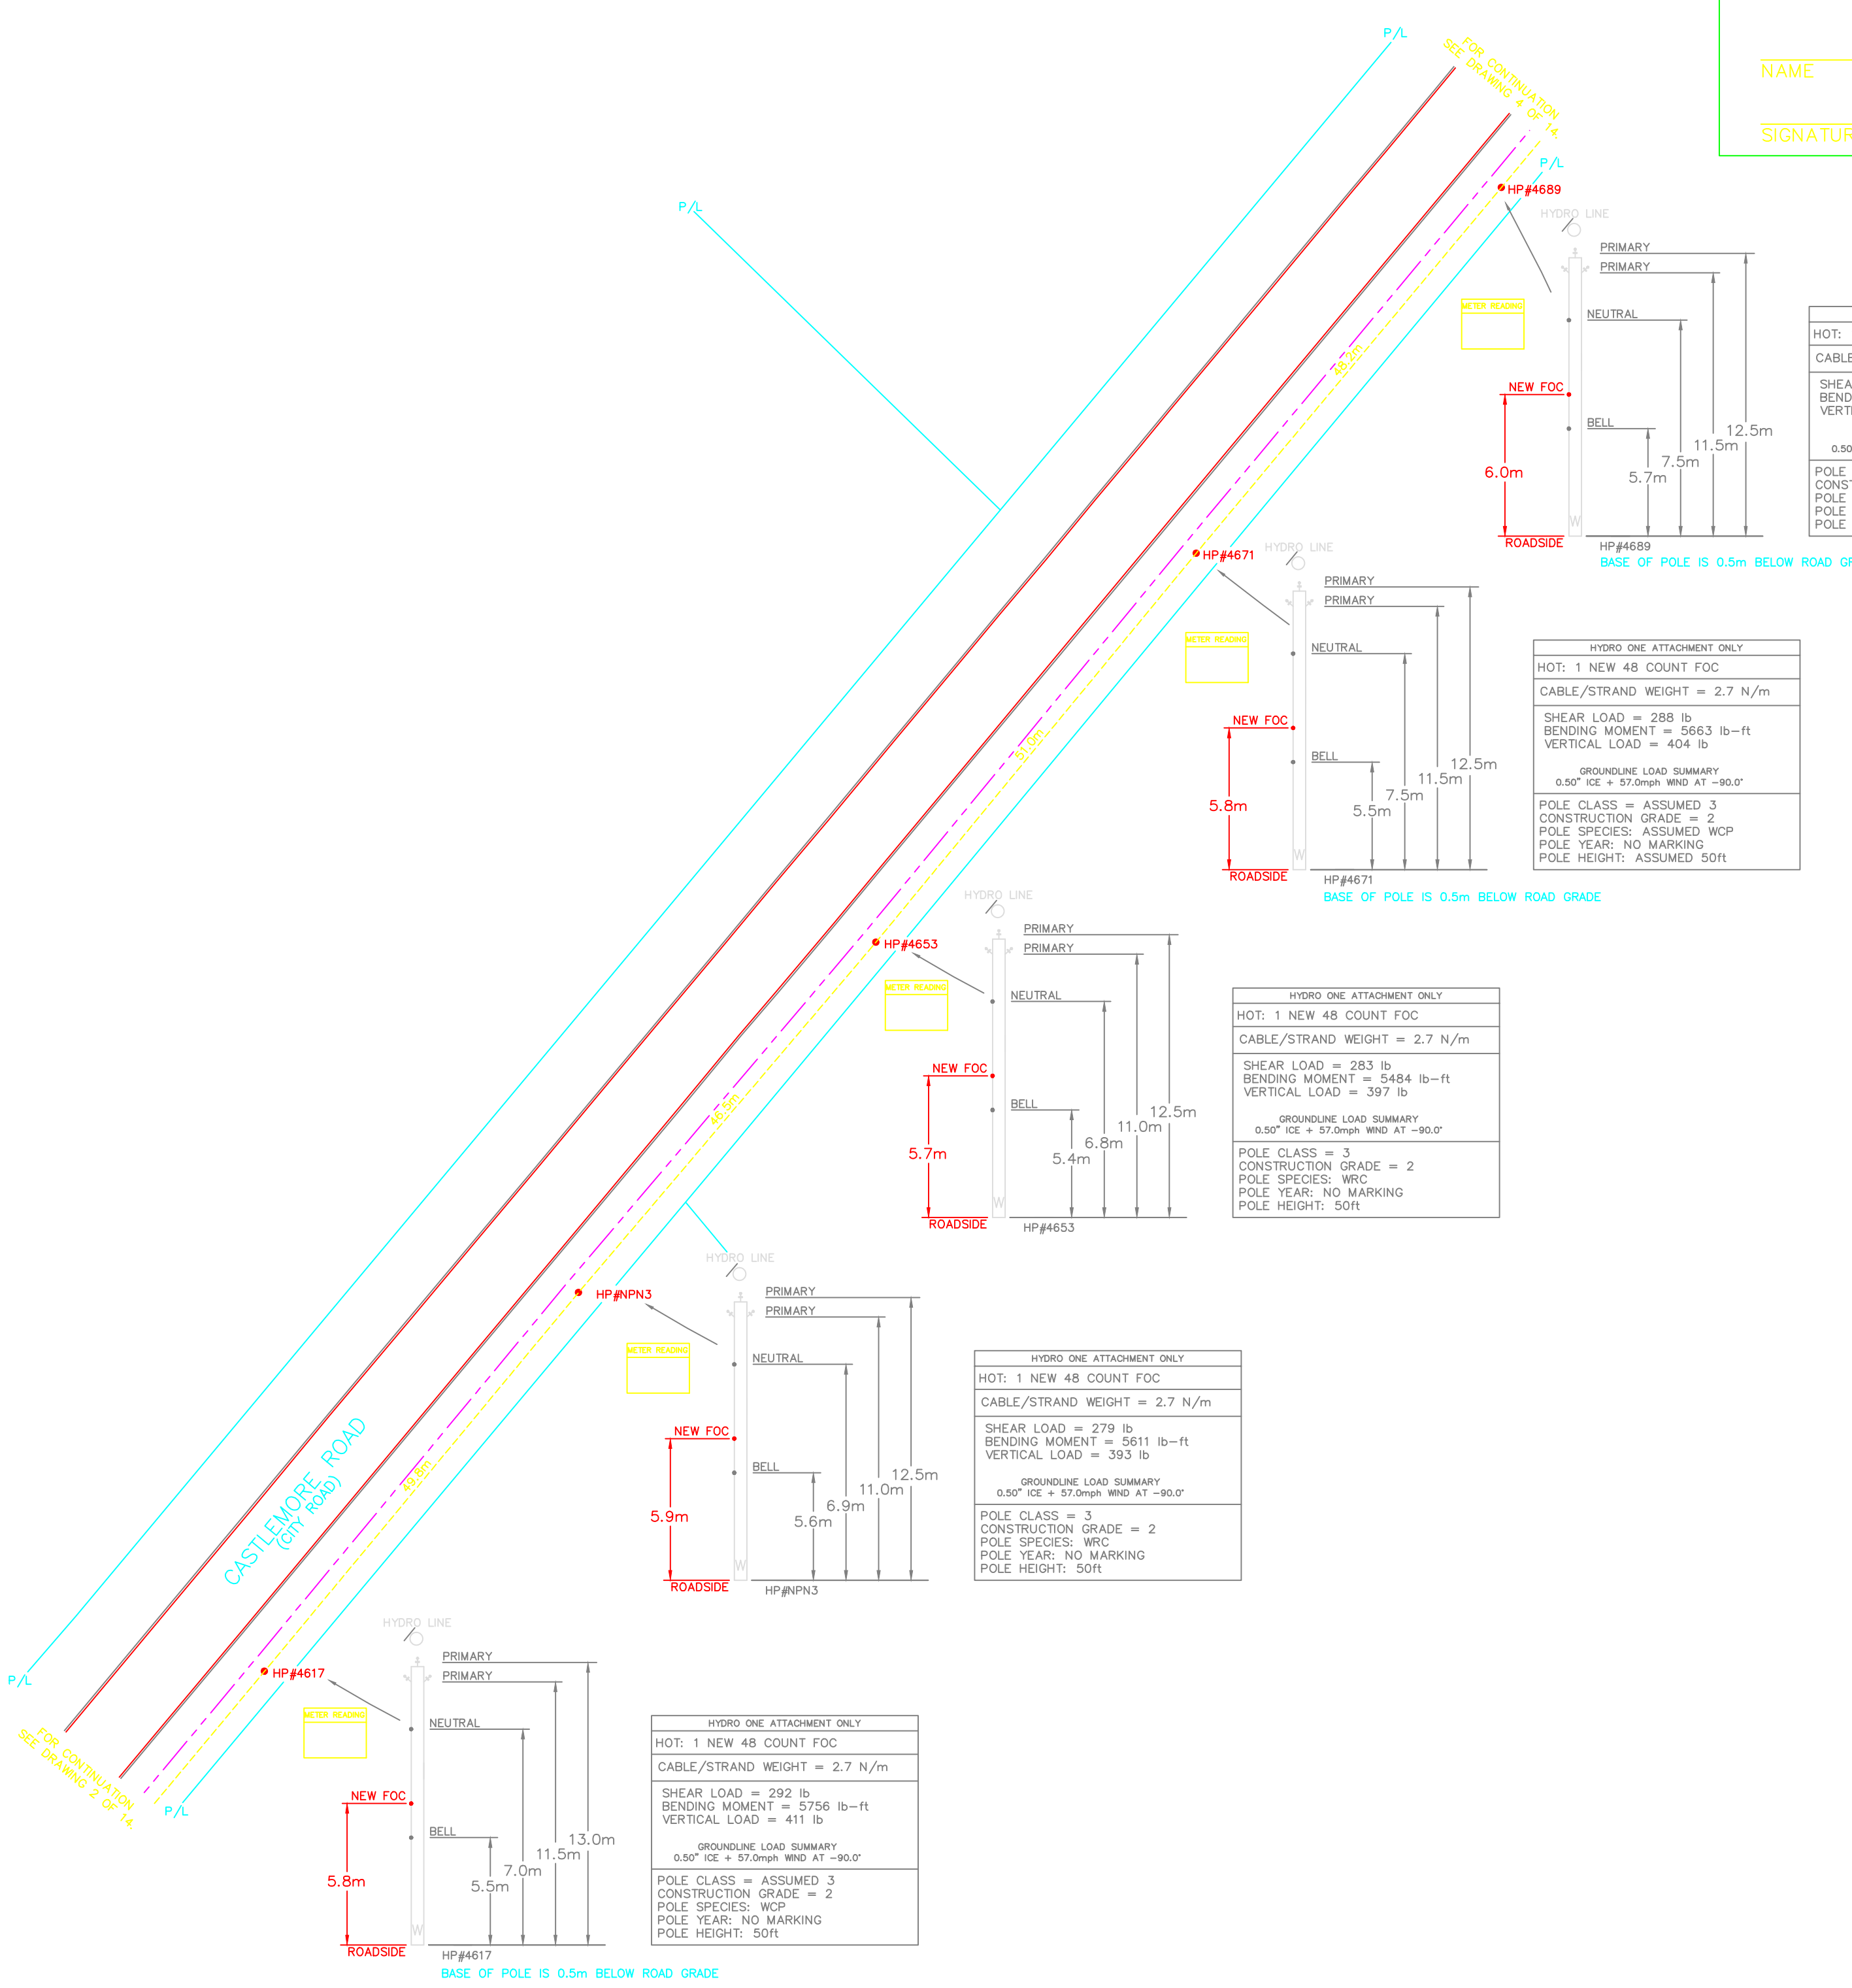

### HYDRO ONE TELECOM ATTACHMENT CERTIFICATE

THIS IS TO CERTIFY THAT THE CONSTRUCTION AS RECORDED IN THIS DRAWING MEETS THE APPLICABLE REQUIREMENTS OF THE SAFETY STANDARDS IN PART 4 OF REGULATION 22/04.

NAME: \_\_\_\_\_ DATE: \_\_\_\_\_

SIGNATURE & PROFESSIONAL DESIGNATION: \_\_\_\_\_



FOR NEW CABLE ATTACHMENT TO HYDRO POLE ONLY, INCLUDING:  
TENSIONING FOR CLEARANCES AND NEW CABLE LOADS



### CERTIFICATE OF APPROVAL

THE NEW INSTALLATION WORK COVERED BY THIS DOCUMENT MEETS THE SAFETY REQUIREMENTS OF SECTION 4 OF REGULATION 22/04, WITH CONSIDERATIONS OF THE FOLLOWING:

THE DESIGN CONFORMS TO CSA 22.3 NO. 1-06 FOR HYDRO ONE TELECOM CLEARANCE, SEPARATION, GUYING AND STRAND TENSION. IT IS NOT INTENDED TO VERIFY THE INTEGRITY OF ATTACHMENTS, ANCHORING OR STRAND TENSIONS OF OTHERS, OR POLE STRENGTH.

POLES WERE NOT INVESTIGATED FOR DEFECTS/ROT.

NAME: \_\_\_\_\_ DATE: \_\_\_\_\_

SIGNATURE OF APPROVAL: \_\_\_\_\_

THESE DRAWINGS ARE COPYRIGHT AND THE PROPERTY OF MAGNATE ENGINEERING AND ASSOCIATES INC. REPRODUCTION OF THESE DRAWINGS WITHOUT THE CONSENT OF MAGNATE ENGINEERING AND ASSOCIATES INC. IS STRICTLY PROHIBITED. DO NOT SCALE THESE DRAWINGS, ANY ERRORS, OR DISCREPANCY IS TO BE REPORTED IMMEDIATELY TO MAGNATE ENGINEERING AND ASSOCIATES INC.

DATE	REVISION	BY
05/20/2009	ISSUED FOR PERMIT	YC



### CASTLEMORE RD - THE GORE RD TO HWY 50 CITY OF BRAMPTON

PROJECT #	CONTRACTOR #	SCALE:
	9H005007P	1:500

APPROVED BY:	DATE:	DWG
	05/20/09	3 OF 14

DRAWING NUMBER:

## CONSTRUCTION NOTES

- 1 OVERLASH 108.8m OF 1-48 COUNT FIBER OPTIC CABLE ON EXISTING ASSUMED 1/4" EHS HOT STRAND.
- 2 INSTALL 2187.3m OF NEW 1/4" EHS STRAND, LASH 1-48 COUNT FIBER OPTIC CABLE.
- 3 INSTALL 545.3m OF NEW 1/4" EHS STRAND, LASH 1-48 COUNT FIBER OPTIC CABLE.
- 4 INSTALL NEW NEUTRAL BOND AND GROUND ROD, AND WIRE.
- 5 INSTALL NEW 10.0m LOOPBACK.
- 6 INSTALL NEW DOWNGUY AND ANCHOR.
- 7 INSTALL NEW RISER C/W U-GUARD.
- 8 INSTALL NEW HYDRO ONE SPlice ENCLOSURE.
- 9 INSTALL NEW 1/4" OVERHEAD GUY.

## SCOPE OF WORK

NEW OVERHEAD GUY	3=61.5m
NEW DOWNGUY AND ANCHOR	9
NEW 48 COUNT FIBER OPTIC CABLE	2896.2m
NEW OVERLASH	108.8m
NEW LASHWIRE	8524.2m
NEW 1/4" EHS STRAND	2732.6m
NEW CATV MAKE READY	3
NEW HOT MAKE READY	1
NEW BELL MAKE READY	12
NEW HYDRO MAKE READY	2
NEW RISER C/W U-GUARD	2
NEW SPlice ENCLOSURE	1
NEW GROUND ROD AND WIRE	11=110.0m

NOTE:  
INFORMATION WAS OBTAINED FROM DRAWINGS  
REFLECTED BY:  
1. PHOTOGRAPHS OF PLAN AND PROFILE PROVIDED BY  
THE CITY OF BRAMPTON AND REGION OF PEEL.

**HYDRO ONE TELECOM CONTACT**  
IAN MITCHELL  
HYDRO ONE TELECOM INC  
45 KEELEND STREET  
SCARBOROUGH, ONTARIO M1V 5A3  
PHONE: (416) 249-4370  
FAX: (416) 249-4370  
CELL: (416) 249-4370  
EMAIL: ian.mitchell@hydroone.com

## ANCHOR SPECIFICATIONS




ANCHOR TYPE	ANCHOR STRENGTH
SINGLE HELIX 8"	14000lbs
SINGLE HELIX 10"	20000lbs
SINGLE HELIX 12"	25000lbs
SINGLE HELIX 14"	31000lbs
TRIPLE HELIX, 8"-10"-12"	46000lbs

CALCULATION FOR REQUIRED STRENGTH OF ANCHOR IS BASED ON -20" WITH 0.5" OF ICE AND SOIL CLASS 4 (MEDIUM DENSE SANDY GRAVEL; VERY STIFF TO HARD SILTS AND CLAYS).

## GENERAL NOTES AERIAL DESIGN AND CONSTRUCTION

1. ALL CONSTRUCTION WORK SHALL BE IN CONFORMANCE WITH CANADIAN, PROVINCIAL AND ONTARIO HYDRO SERVICES COMPANY SAFETY REQUIREMENTS. THESE INCLUDES WITHOUT LIMITATION:
  - OHS WORK PROTECTION CODE
  - OCCUPATIONAL HEALTH AND SAFETY ACT
  - THIS DESIGN CONFORMS TO CSA STANDARD C22.3 NO. 1-06.
2. TAKE THE NECESSARY PRECAUTIONS TO PROTECT THE EXISTING INSTALLATION FROM DAMAGE. THE CONTRACTOR WILL BE RESPONSIBLE FOR ALL THE CLAIMS DUE TO DAMAGE.
3. ALL REVISIONS MUST BE MADE PRIOR TO CONSTRUCTION.
4. ALL BOLTS MUST PROVIDE FOR 25mm OF EXPOSED THREAD.
5. ASSUME SOIL CONDITIONS AT ANCHOR POINT ARE AS FOLLOWS:
  - MEDIUM DENSE SANDY GRAVEL; VERY STIFF TO HARD SILTS AND CLAYS.
6. THE CONTRACTOR SHALL CHECK AND VERIFY ALL SITE CONDITIONS, CLEARANCES AND DIMENSIONS AT THE SITE AND REPORT ANY DISCREPANCIES TO THE ENGINEER BEFORE PROCEEDING WITH WORK.
7. SAGS & CLEARANCES ARE CHECKED AND CALCULATED FOR NEW ATTACHMENTS ONLY.
8. POLES NOT CHECKED FOR OVERALL LOADING. ADDITIONAL APPLIED LOADS ARE SHOWN ON THIS DRAWING DUE TO NEW ATTACHMENTS ONLY.
9. THE CONTRACTOR SHALL ENSURE THAT THE COMMUNICATION STRAND OR MESSENGER IS BONDED TO THE DISTRIBUTION SYSTEM NEUTRAL AT EVERY DIP LOCATION & EVERY 300 METRES.
10. VISIT THE SITE TO CHECK ON AVAILABLE ACCESS, STORAGE AND WORKING AREAS. DETERMINE ANY INTERFERENCE WITH EXISTING SERVICES.
11. SPIRAL WRAP AND TAG ALL EXPOSED FIBER OPTIC CABLE, INCLUDING: DRIP LOOPS, ENDS OF LOOPBACKS & DIPS ABOVE U-GUARDS.
12. AERIAL STRAND SHALL BE 1/4" EHS STRAND, 7-WIRE ZINC COATED, OR 3/8" EHS STRAND, 7-WIRE ZINC COATED, UNLESS NOTED OTHERWISE.
13. LOCATIONS AND DETAILS SHOWN ON THIS DRAWING ARE BASED ON THE BEST INFORMATION AVAILABLE AT TIME OF SURVEY. CONFIRM ALL LOCATIONS, CLEARANCES, AND INTERFERENCES ON SITE PRIOR TO BEGINNING WORK.
14. POLES WERE NOT VERIFIED FOR DECAY, OR DEFICIENCIES DUE TO THE INSTALLATION OF EXISTING ATTACHMENTS.
15. CONTRACTOR TO CONTACT THE ENGINEER IF THE HYDRO LINE ABOVE THE NEW ATTACHMENT HAS A SAG LARGER THAN 1000mm OR IF THE VOLTAGE IS HIGHER THAN 750V.
16. MAKE GOOD ALL EXISTING FINISHES WHEN WORK IS COMPLETE.
17. THE POSITION OF POLE LINES, CONDUITS, WATERMANS, SEWERS AND OTHER UNDERGROUND AND ABOVE GROUND UTILITIES AND STRUCTURES ARE NOT NECESSARILY SHOWN ON THE CONTRACT DRAWINGS, AND WHERE SHOWN, THE ACCURACY OF THE POSITION OF SUCH UTILITIES AND STRUCTURES IS NOT GUARANTEED. BEFORE STARTING WORK, THE CONTRACTOR SHALL CONFIRM THE EXACT LOCATION OF ALL SUCH UTILITIES AND STRUCTURES, AND SHALL ASSUME ALL LIABILITY FOR DAMAGE TO THEM.
18. ALL THE MATERIAL AND EQUIPMENT TO BE ESA AND CSA APPROVED.
19. CONTRACTOR TO USE DOWNGUY SPLITTERS AS REQUIRED IN ORDER TO AVOID CONTACT WITH POWER LINES.
20. ANALYSIS WAS PERFORMED USING THE DETERMINISTIC METHOD ASSUMING THAT THE HIGHEST VOLTAGE OF ANY OF THE EXISTING SUPPLY LINES IS LESS THAN 70 KV PHASE TO PHASE.
21. WHERE EXISTING COMMUNICATIONS ATTACHMENTS ARE SHOWN TO BE RELOCATED, THE THIRD PARTY OWNER OF THE ATTACHMENT MUST BE CONTACTED TO REVIEW AND ENSURE MINIMUM CLEARANCES ARE MAINTAINED IN ACCORDANCE WITH APPLICABLE STANDARDS.

RECORD OF INSPECTION BY CONSTRUCTOR	
AS CONSTRUCTED	<input type="checkbox"/> Aerial Installation
	<input type="checkbox"/> U/G Installation
With changes shown on this Drawing	
Attachment Owner	Permit #
	Date
	Company Name
	Print Name
	Position
	Signature
<input type="checkbox"/> This is to certify that the construction as recorded in this drawing is consistent with the approved plan, Standard Designs, or work instruction and that approved equipment has been used.	

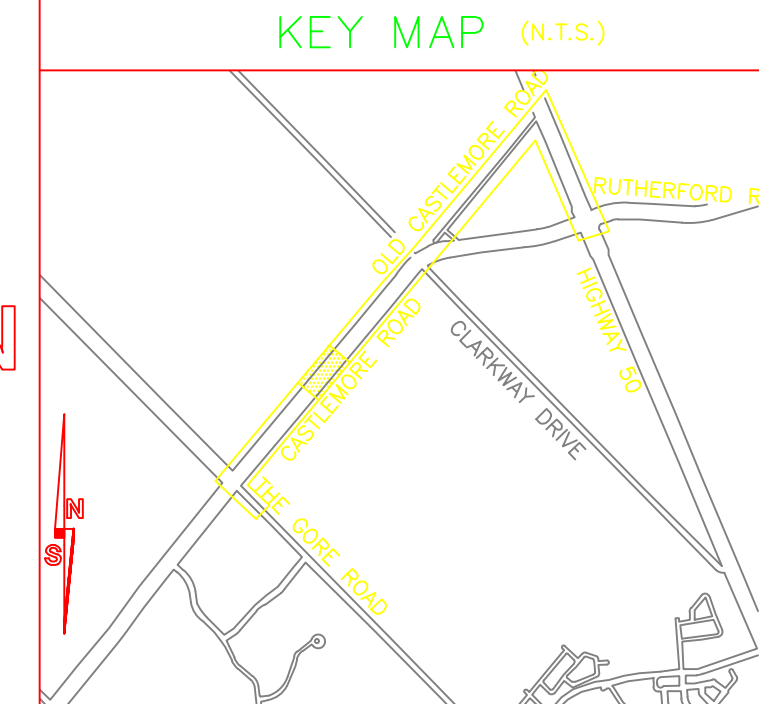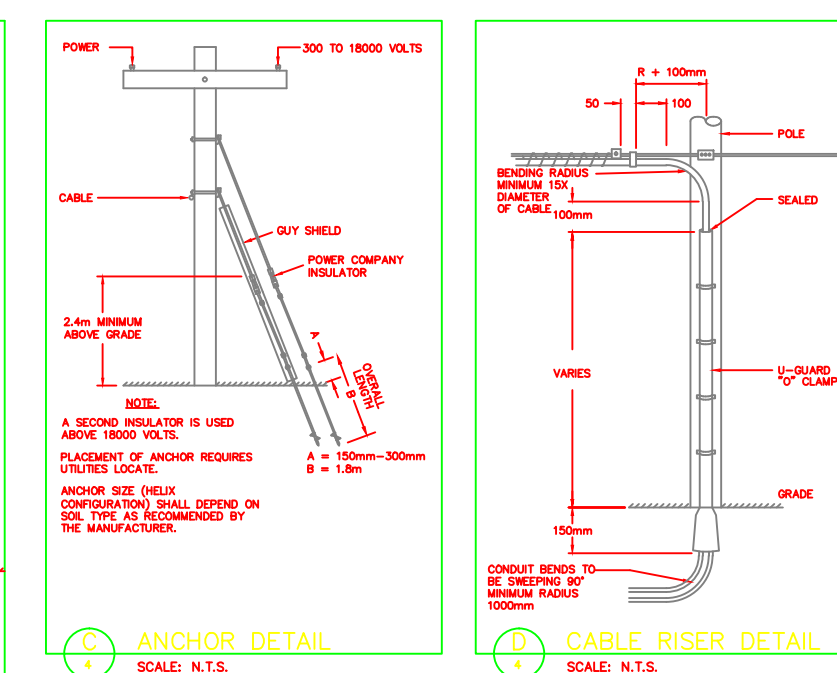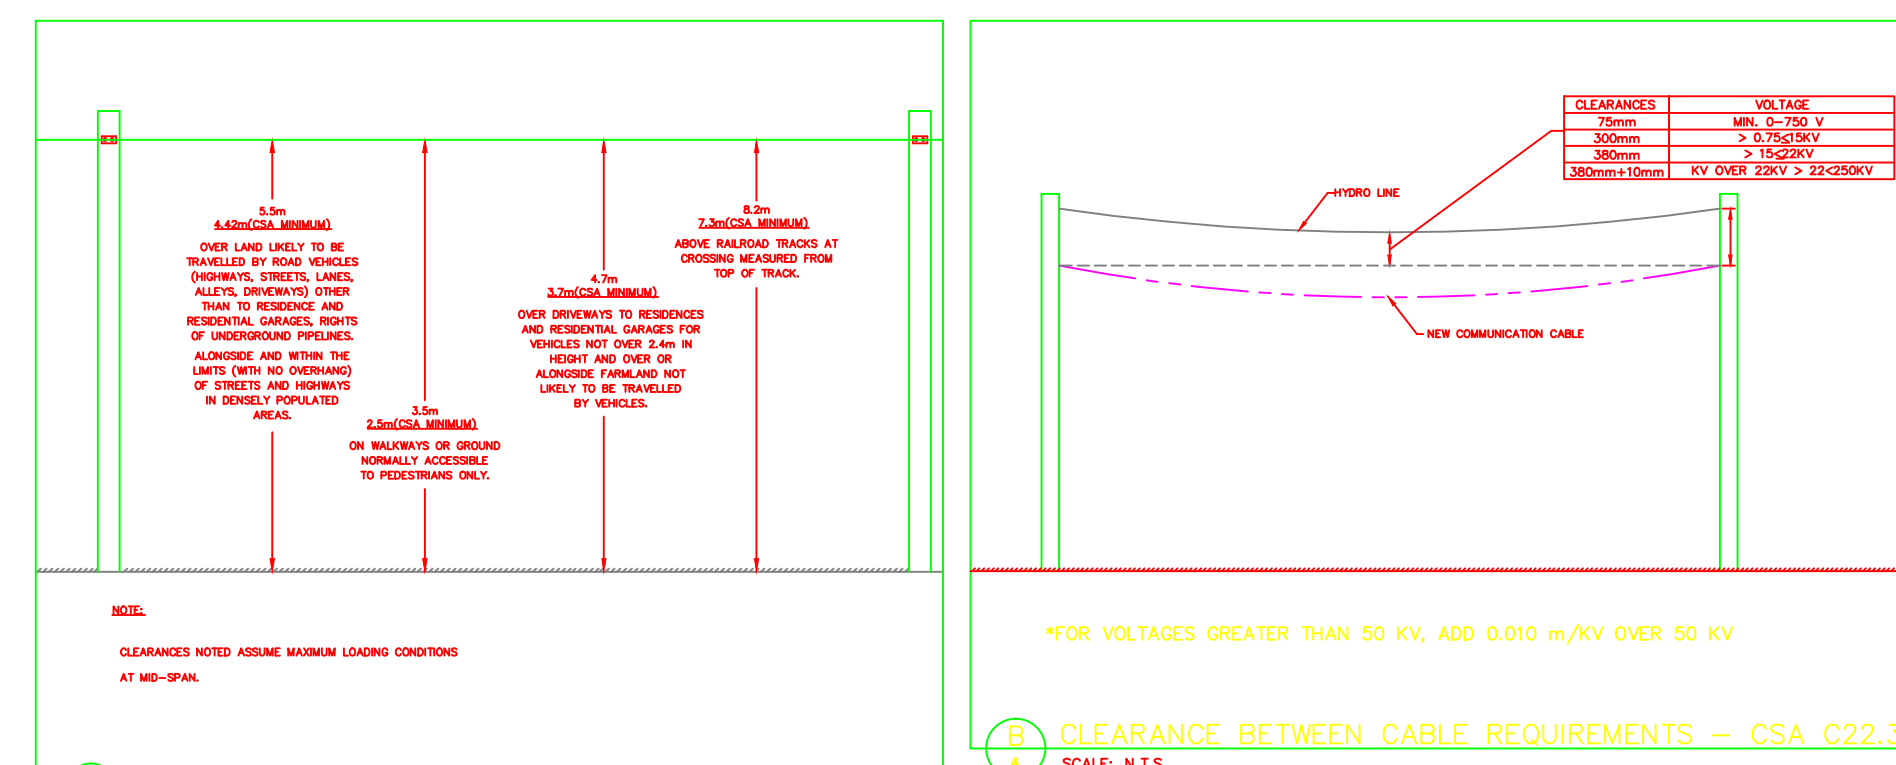

## REFERENCE DRAWINGS

CITY OF BRAMPTON

## LEGEND

NEW FIBER	
NEW STRAND	
OVERLASH	
EXISTING CONDUIT	
UNDERGROUND GAS LINE	
UNDERGROUND WATER	
UNDERGROUND HYDRO	
UNDERGROUND BELL	
UNDERGROUND CATV	
STORM SEWER	
SANITARY SEWER	
PROPERTY LINE	
FENCE	
DITCH	
EDGE OF PAVEMENT	
CURB	
GRAVEL SHOULDER	
NEW SPlice	
EXISTING SPlice	
VAULT	
BELL PEDESTAL	
CATV PEDESTAL	
TRANSFORMER	
CATCH BASIN	
WATER VALVE	
FIRE HYDRANT	
EXISTING POLE TO BE REMOVED	
STREET SIGN	
HYDRO POLE	
MANHOLE COVER	
MANHOLE & COVER	
LARGE ROCK	
TREE	
DIP LOCATION	
NEW DOWNGUY AND ANCHOR	
NEW SIDEWALK GUY	
NEW INTERIOR FIBER	
NEW BACKBOARD	
EXISTING BACKBOARD	
NEW PATCH PANEL	
EXISTING PATCH PANEL	
NEW EQUIPMENT RACK	
EXISTING EQUIPMENT RACK	
NEW FIBER COIL	

FIBER I.D.# MBTN-(CABLE I.D.)-(FIBRE COUNT)

THESE DRAWINGS ARE COPYRIGHT AND THE PROPERTY OF MAGNATE ENGINEERING AND ASSOCIATES INC. REPRODUCTION OF THESE DRAWINGS WITHOUT THE CONSENT OF MAGNATE ENGINEERING AND ASSOCIATES INC. IS STRICTLY PROHIBITED. DO NOT SCALE THESE DRAWINGS, ANY ERRORS, OR DISCREPANCY IS TO BE REPORTED IMMEDIATELY TO MAGNATE ENGINEERING AND ASSOCIATES INC.

DATE	REVISION	BY
05/20/2009	ISSUED FOR PERMIT	YC

**hydro one**  
Hydro One Telecommunications

Hydro One Telecom Inc.  
45 Keelefield Street  
Brampton, Ontario L6L 5A3

**MAGNATE**  
ENGINEERING AND ASSOCIATES INC.

18 Automatic Road, Suite 1C  
Brampton, Ontario L6L 5N5  
Telephone: (905) 799-8220

CASTLEMORE RD - THE GORE RD TO HWY 50  
CITY OF BRAMPTON


PROJECT #	CONTRACTOR #	SCALE:
	9H005007P	1:500
APPROVED BY:	DATE:	DWG 4 OF 14
	05/20/09	
DRAWING NUMBER:		

## HYDRO ONE TELECOM ATTACHMENT CERTIFICATE

THIS IS TO CERTIFY THAT THE CONSTRUCTION AS RECORDED IN THIS DRAWING MEETS THE APPLICABLE REQUIREMENTS OF THE SAFETY STANDARDS IN PART 4 OF REGULATION 22/04.

NAME \_\_\_\_\_ DATE \_\_\_\_\_

SIGNATURE & PROFESSIONAL DESIGNATION \_\_\_\_\_

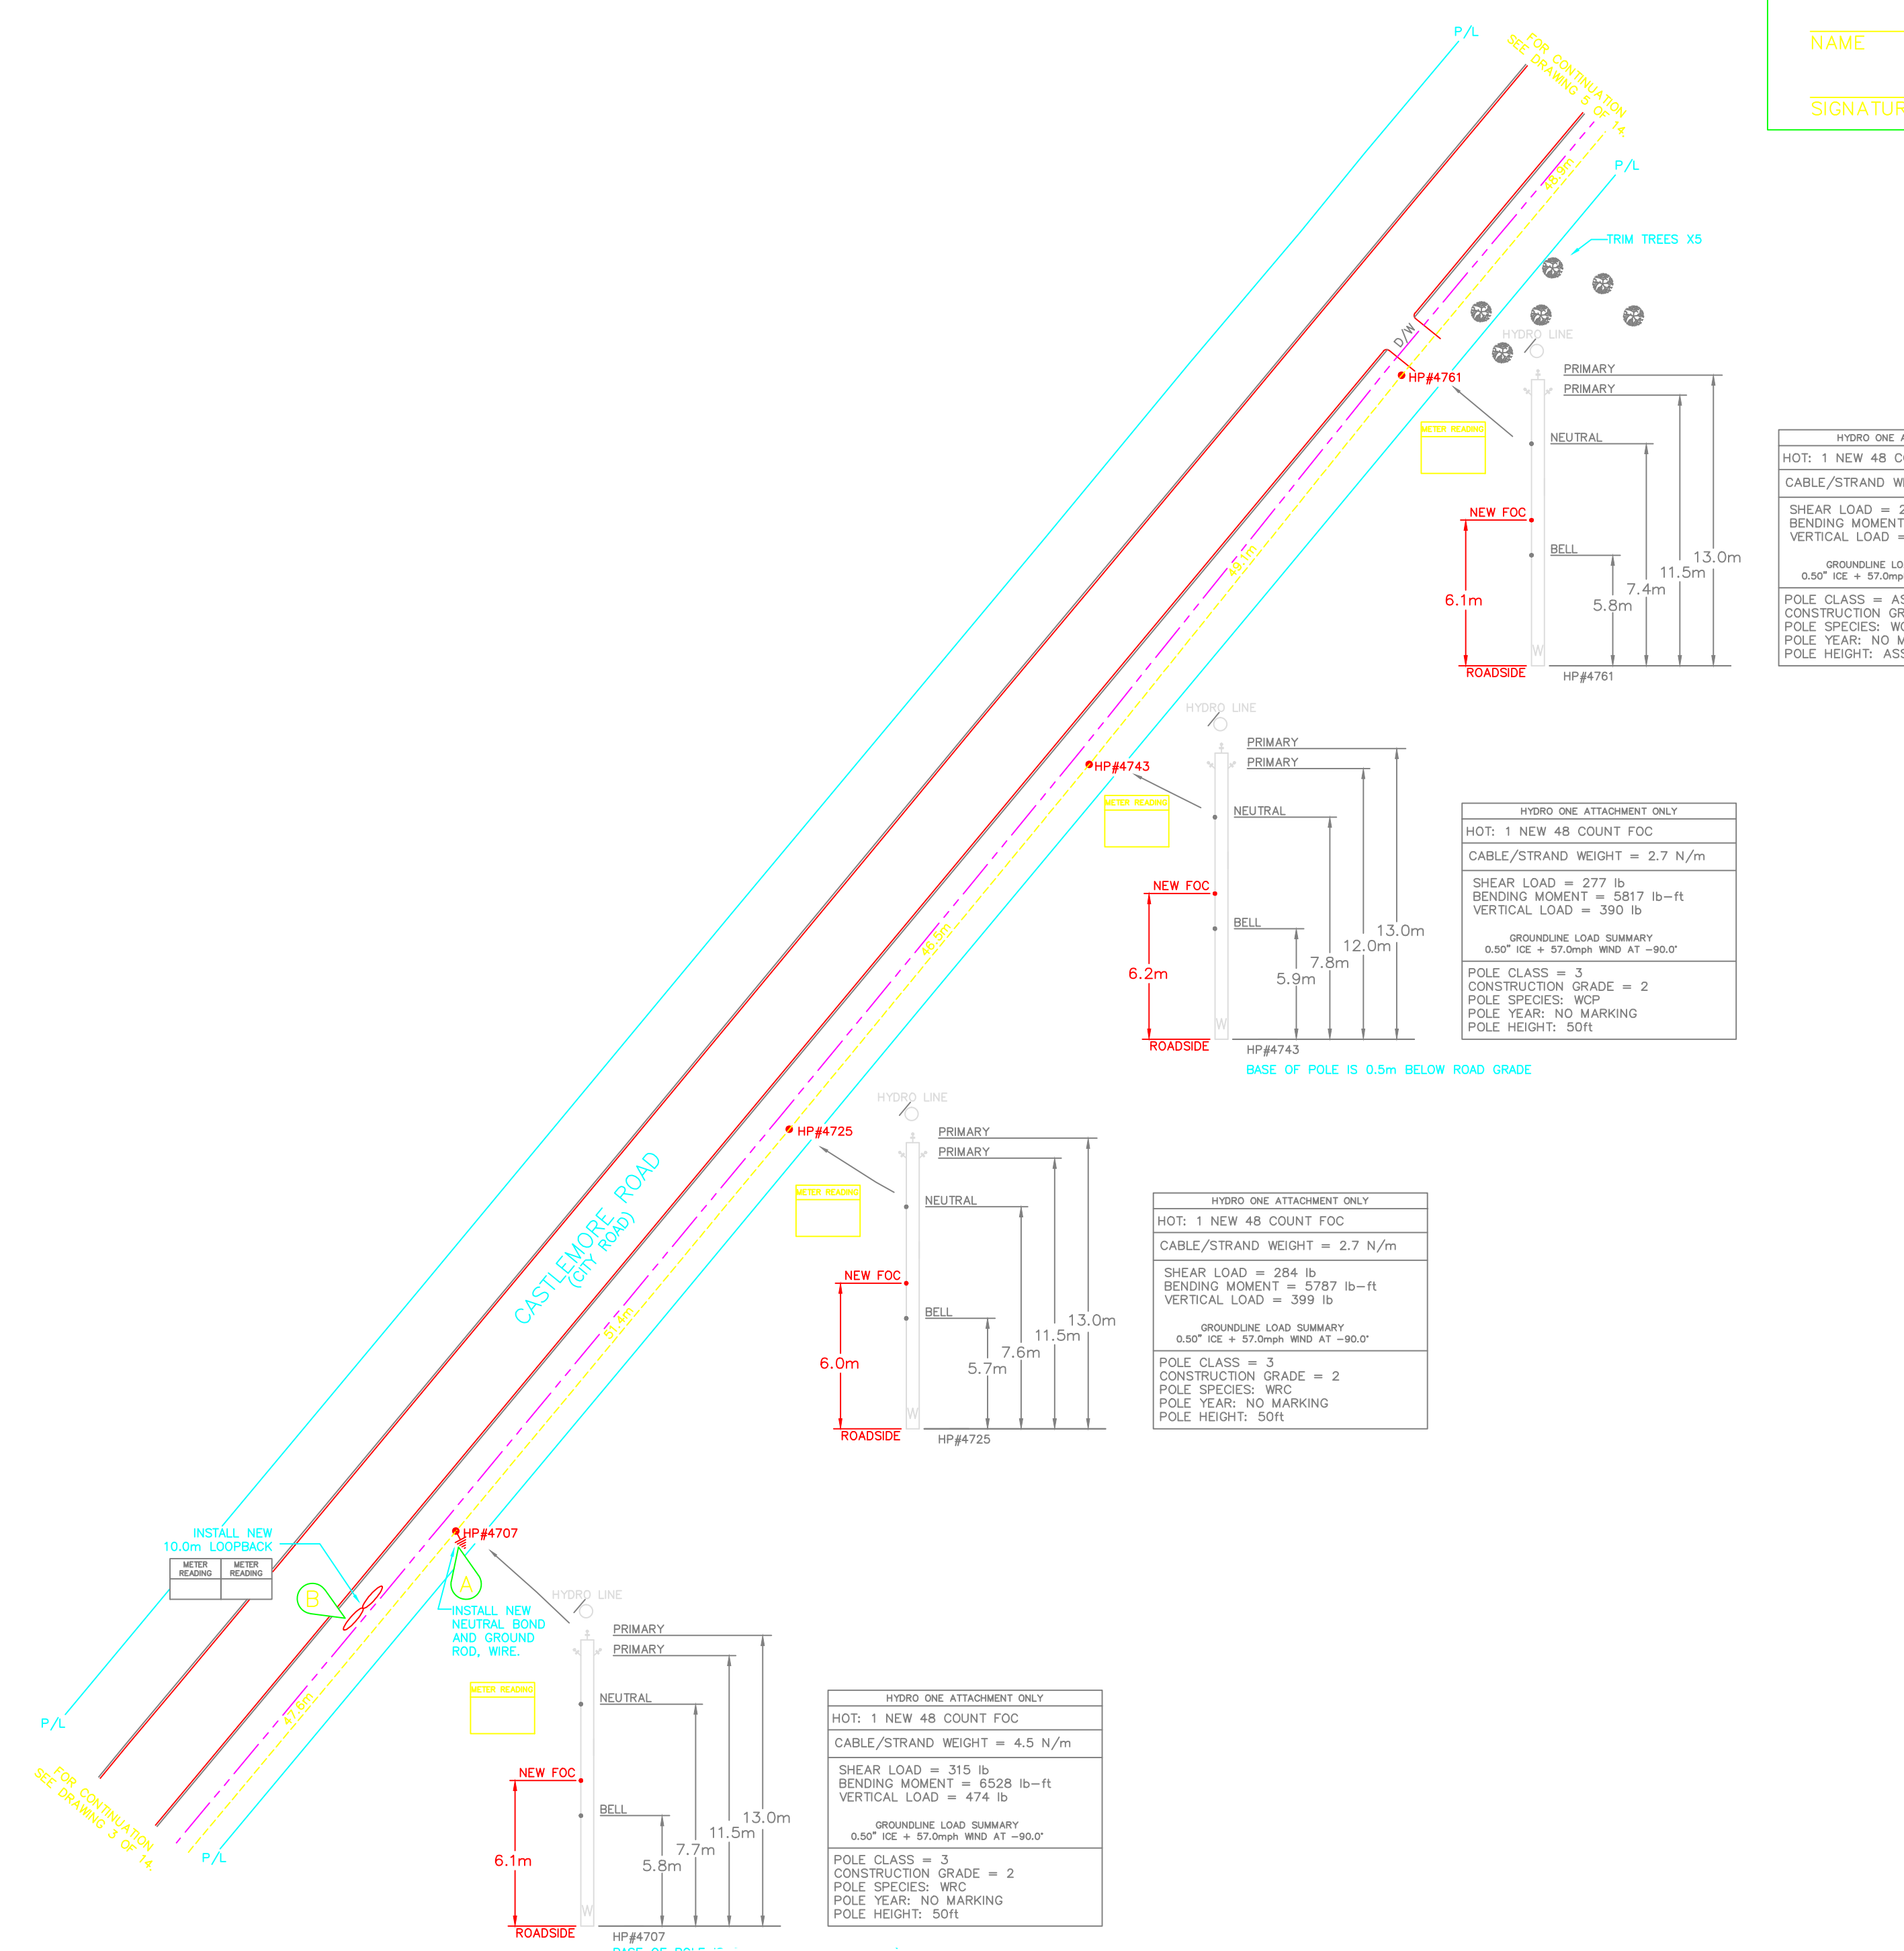

## CERTIFICATE OF APPROVAL

THE NEW INSTALLATION WORK COVERED BY THIS DOCUMENT MEETS THE SAFETY REQUIREMENTS OF SECTION 4 OF REGULATION 22/04, WITH CONSIDERATIONS OF THE FOLLOWING:

THE DESIGN CONFORMS TO CSA 22.3 NO. 1-06 FOR HYDRO ONE TELECOM CLEARANCE, SEPARATION, GUYING AND STRAND TENSION. IT IS NOT INTENDED TO VERIFY THE INTEGRITY OF ATTACHMENTS, ANCHORING OR STRAND TENSIONS OF OTHERS, OR POLE STRENGTH.

POLES WERE NOT INVESTIGATED FOR DEFECTS/ROT.

NAME: \_\_\_\_\_ DATE: \_\_\_\_\_

SIGNATURE OF APPROVAL: \_\_\_\_\_





FOR NEW CABLE ATTACHMENT TO HYDRO POLE ONLY, INCLUDING:  
TENSIONING FOR CLEARANCES AND NEW CABLE LOADS



18 Automatic Road Suite 1C  
Brampton, Ontario L6L 5N5  
Telephone: (905) 799-8220

## CONSTRUCTION NOTES

- 1 OVERLASH 108.9m OF 1-48 COUNT FIBER OPTIC CABLE ON EXISTING ASSUMED 1/4" EHS HOT STRAND.
- 2 INSTALL 2187.3m OF NEW 1/4" EHS STRAND. LASH 1-48 COUNT FIBER OPTIC CABLE.
- 3 INSTALL 545.3m OF NEW 1/4" EHS STRAND. LASH 1-48 COUNT FIBER OPTIC CABLE.
- 4
- 5
- A INSTALL NEW NEUTRAL BOND AND GROUND ROD, AND WIRE.
- B INSTALL NEW 10.0m LOOPBACK.
- C INSTALL NEW DOWNGUY AND ANCHOR. 
- D INSTALL NEW RISER C/W U-GUARD. 
- E INSTALL NEW HYDRO ONE SPICE ENCLOSURE.
- F INSTALL NEW 1/4" OVERHEAD GUY.

## SCOPE OF WORK

NEW OVERHEAD GUY	3=61.5m
NEW DOWNGUY AND ANCHOR	9
NEW 48 COUNT FIBER OPTIC CABLE	2996.2m
NEW OVERLASH	108.8m
NEW LASHWIRE	8524.2m
NEW 1/4" EHS STRAND	2732.6m
NEW CATV MAKE READY	3
NEW HOT MAKE READY	1
NEW BELL MAKE READY	12
NEW HYDRO MAKE READY	2
NEW RISER C/W U-GUARD	2
NEW SPICE ENCLOSURE	1
NEW GROUND ROD AND WIRE	11=110.0m

NOTE:  
INFORMATION WAS OBTAINED FROM DRAWINGS  
REFLECTED BY:  
1. PHOTOGRAPHS OF PLAN AND PROFILE PROVIDED BY  
THE CITY OF BRAMPTON AND REGION OF PEEL.

HYDRO ONE TELECOM  
CONTACT  
IAN MITCHELL  
HYDRO ONE TELECOM INC  
65 KEELE STREET  
MIDLAND, ONT. N6M 5A3  
PHONE: (416) 240-4370  
FAX: (416) 240-4300  
CELL: (416) 240-4300  
EMAIL: ian.mitchell@hydroone.com

## ANCHOR SPECIFICATIONS






ANCHOR TYPE	ANCHOR STRENGTH
SINGLE HELIX 8"	14000lbs
SINGLE HELIX 10"	20000lbs
SINGLE HELIX 12"	25000lbs
SINGLE HELIX 14"	31000lbs
TRIPLE HELIX, 8"-10"-12"	46000lbs

CALCULATION FOR REQUIRED STRENGTH OF ANCHOR IS BASED ON -20" WITH 0.5" OF ICE AND SOIL CLASS 4 (MEDIUM DENSE SANDY GRAVEL; VERY STIFF TO HARD SILTS AND CLAYS).

## GENERAL NOTES AERIAL DESIGN AND CONSTRUCTION

1. ALL CONSTRUCTION WORK SHALL BE IN CONFORMANCE WITH CANADIAN, PROVINCIAL AND ONTARIO HYDRO SERVICES COMPANY SAFETY REQUIREMENTS. THESE INCLUDES WITHOUT LIMITATION:
  - OHSC WORK PROTECTION CODE
  - OCCUPATIONAL HEALTH AND SAFETY ACT
  - THIS DESIGN CONFORMS TO CSA STANDARD C22.3 NO. 1-06.
2. TAKE THE NECESSARY PRECAUTIONS TO PROTECT THE EXISTING INSTALLATION FROM DAMAGE. THE CONTRACTOR WILL BE RESPONSIBLE FOR ALL THE CLAIMS DUE TO DAMAGE.
3. ALL REVISIONS MUST BE MADE PRIOR TO CONSTRUCTION.
4. ALL BOLTS MUST PROVIDE FOR 25mm OF EXPOSED THREAD.
5. ASSUME SOIL CONDITIONS AT ANCHOR POINT ARE AS FOLLOWS:
  - MEDIUM DENSE SANDY GRAVEL; VERY STIFF TO HARD SILTS AND CLAYS.
6. THE CONTRACTOR SHALL CHECK AND VERIFY ALL SITE CONDITIONS, CLEARANCES AND DIMENSIONS AT THE SITE AND REPORT ANY DISCREPANCIES TO THE ENGINEER BEFORE PROCEEDING WITH WORK.
7. SAGS & CLEARANCES ARE CHECKED AND CALCULATED FOR NEW ATTACHMENTS ONLY.
8. POLES NOT CHECKED FOR OVERALL LOADING. ADDITIONAL APPLIED LOADS ARE SHOWN ON THIS DRAWING DUE TO NEW ATTACHMENTS ONLY.
9. THE CONTRACTOR SHALL ENSURE THAT THE COMMUNICATION STRAND OR MESSENGER IS BONDED TO THE DISTRIBUTION SYSTEM NEUTRAL AT EVERY DIP LOCATION & EVERY 300 METRES.
10. VISIT THE SITE TO CHECK ON AVAILABLE ACCESS, STORAGE AND WORKING AREAS. DETERMINE ANY INTERFERENCE WITH EXISTING SERVICES.
11. SPIRAL WRAP AND TAG ALL EXPOSED FIBER OPTIC CABLE, INCLUDING: DRIP LOOPS, ENDS OF LOOPBACKS & DIPS ABOVE U-GUARDS.
12. AERIAL STRAND SHALL BE 1/4" EHS STRAND, 7-WIRE ZINC COATED, OR 3/8" EHS STRAND, 7-WIRE ZINC COATED, UNLESS NOTED OTHERWISE.
13. LOCATIONS AND DETAILS SHOWN ON THIS DRAWING ARE BASED ON THE BEST INFORMATION AVAILABLE AT TIME OF SURVEY. CONFIRM ALL LOCATIONS, CLEARANCES, AND INTERFERENCES ON SITE PRIOR TO BEGINNING WORK.
14. POLES WERE NOT VERIFIED FOR DECAY, OR DEFICIENCIES DUE TO THE INSTALLATION OF EXISTING ATTACHMENTS.
15. CONTRACTOR TO CONTACT THE ENGINEER IF THE HYDRO LINE ABOVE THE NEW ATTACHMENT HAS A SAG LARGER THAN 1000mm OR IF THE VOLTAGE IS HIGHER THAN 750V.
16. MAKE GOOD ALL EXISTING FINISHES WHEN WORK IS COMPLETE.
17. THE POSITION OF POLE LINES, CONDUITS, WATERMANS, SEWERS AND OTHER UNDERGROUND AND ABOVE GROUND UTILITIES AND STRUCTURES ARE NOT NECESSARILY SHOWN ON THE CONTRACT DRAWINGS, AND WHERE SHOWN, THE ACCURACY OF THE POSITION OF SUCH UTILITIES AND STRUCTURES IS NOT GUARANTEED. BEFORE STARTING WORK, THE CONTRACTOR SHALL CONFIRM THE EXACT LOCATION OF ALL SUCH UTILITIES AND STRUCTURES, AND SHALL ASSUME ALL LIABILITY FOR DAMAGE TO THEM.
18. ALL THE MATERIAL AND EQUIPMENT TO BE ESA AND CSA APPROVED.
19. CONTRACTOR TO USE DOWNGUY SPLITTERS AS REQUIRED IN ORDER TO AVOID CONTACT WITH POWER LINES.
20. ANALYSIS WAS PERFORMED USING THE DETERMINISTIC METHOD ASSUMING THAT THE HIGHEST VOLTAGE OF ANY OF THE EXISTING SUPPLY LINES IS LESS THAN 70 KV PHASE TO PHASE.
21. WHERE EXISTING COMMUNICATIONS ATTACHMENTS ARE SHOWN TO BE RELOCATED, THE THIRD PARTY OWNER OF THE ATTACHMENT MUST BE CONTACTED TO REVIEW AND ENSURE MINIMUM CLEARANCES ARE MAINTAINED IN ACCORDANCE WITH APPLICABLE STANDARDS.

RECORD OF INSPECTION BY CONTRACTOR		
AS CONSTRUCTED		
<input type="checkbox"/> Aerial Installation <input type="checkbox"/> U/G Installation		
With changes shown on this Drawing		
Attachment Owner	Permit #	Date
Company Name		
Print Name		
Position		
Signature		
<input type="checkbox"/> This is to certify that the construction as recorded in this drawing is consistent with the approved plan/Standard Designs, or work instruction and that approved equipment has been used.		

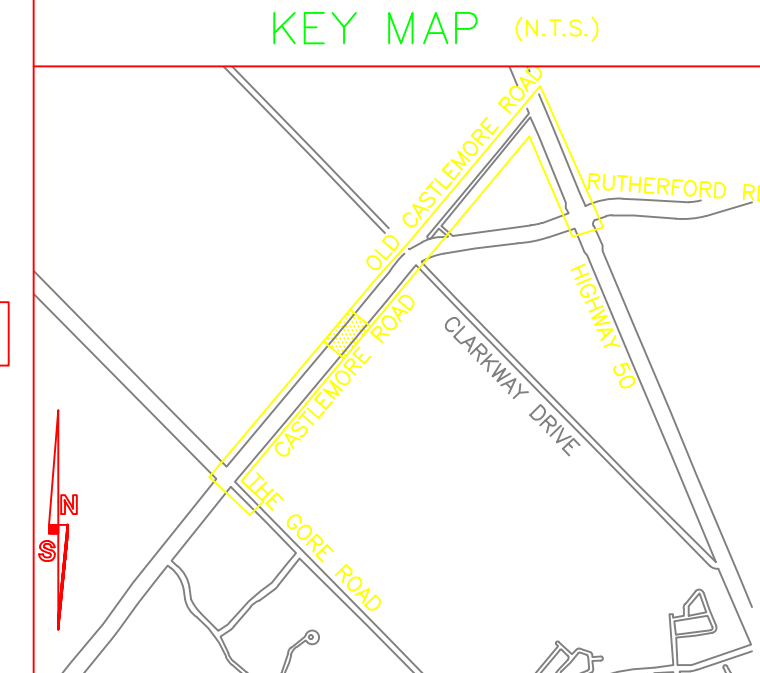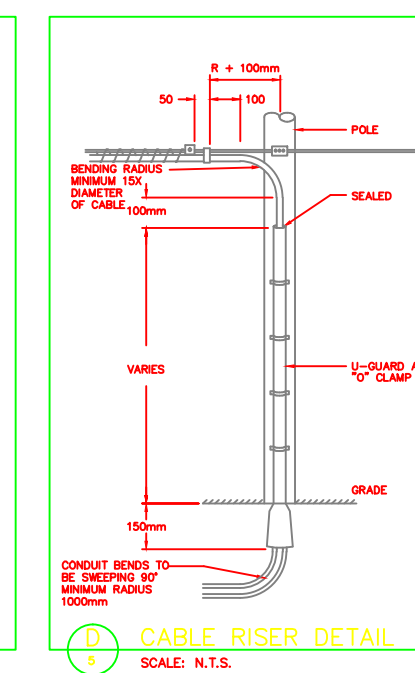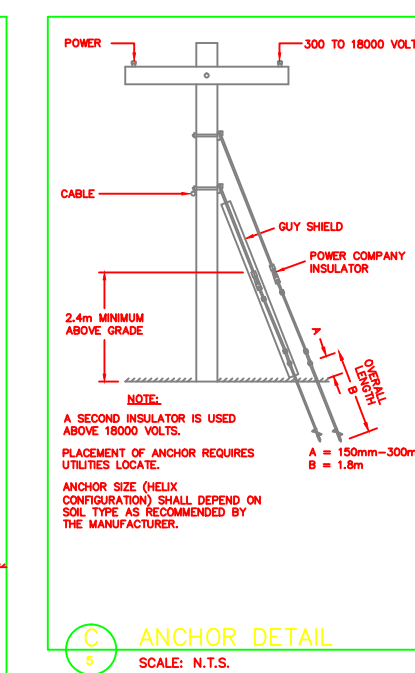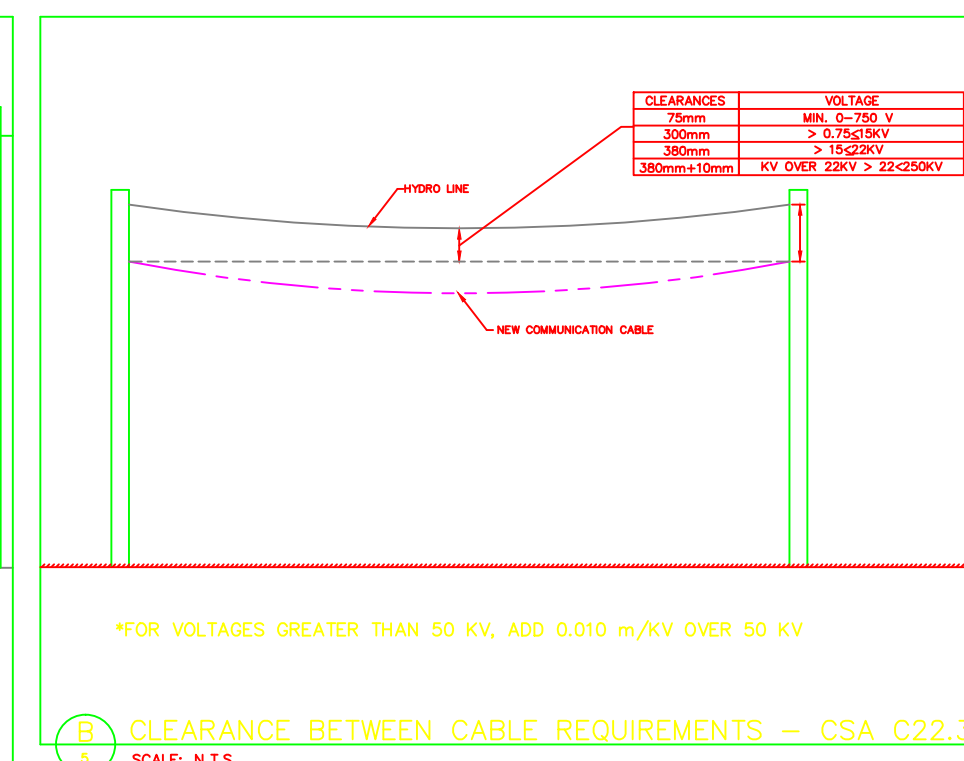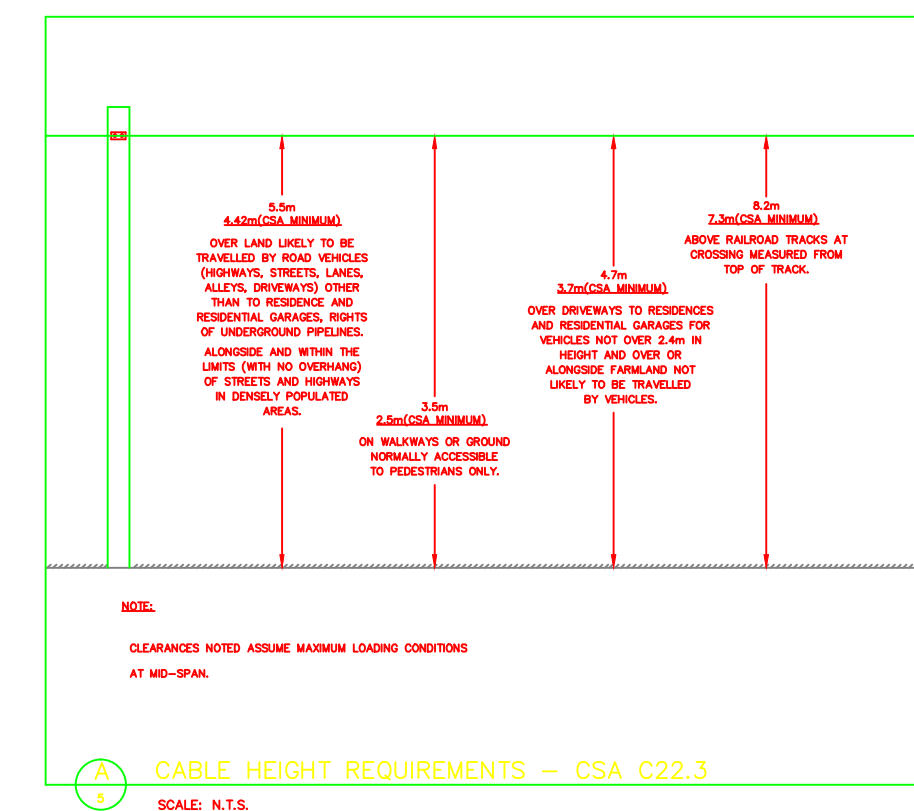

## REFERENCE DRAWINGS

CITY OF BRAMPTON

## LEGEND

NEW FIBER	
NEW STRAND	
OVERLASH	
EXISTING CONDUIT	
UNDERGROUND GAS LINE	
UNDERGROUND WATER	
UNDERGROUND HYDRO	
UNDERGROUND BELL	
UNDERGROUND CATV	
STORM SEWER	
SANITARY SEWER	
PROPERTY LINE	
FENCE	
DITCH	
EDGE OF PAVEMENT	
CURB	
GRAVEL SHOULDER	
NEW SPICE	
EXISTING SPICE	
VAULT	
BELL PEDESTAL	
CATV PEDESTAL	
TRANSFORMER	
CATCH BASIN	
WATER VALVE	
FIRE HYDRANT	
EXISTING POLE TO BE REMOVED	
STREET SIGN	
HYDRO POLE	
MANHOLE COVER	
MANHOLE & COVER	
LARGE ROCK	
TREE	
DIP LOCATION	
NEW DOWNGUY AND ANCHOR	
NEW SIDEWALK GUY	
NEW INTERIOR FIBER	
NEW BACKBOARD	
EXISTING BACKBOARD	
NEW PATCH PANEL	
EXISTING PATCH PANEL	
NEW EQUIPMENT RACK	
EXISTING EQUIPMENT RACK	
NEW FIBER COIL	


FIBER I.D.# MBTN-(CABLE I.D.)-(FIBRE COUNT)

THESE DRAWINGS ARE COPYRIGHT AND THE PROPERTY OF MAGNATE ENGINEERING AND ASSOCIATES INC. REPRODUCTION OF THESE DRAWINGS WITHOUT THE CONSENT OF MAGNATE ENGINEERING AND ASSOCIATES INC. IS STRICTLY PROHIBITED. DO NOT SCALE THESE DRAWINGS, ANY ERRORS, OR DISCREPANCY IS TO BE REPORTED IMMEDIATELY TO MAGNATE ENGINEERING AND ASSOCIATES INC.

LICENSED PROFESSIONAL ENGINEER  
J.M. QUINTERO IRRATE  
100079833  
Province of Ontario

FOR NEW CABLE ATTACHMENT TO HYDRO POLE ONLY, INCLUDING:  
TENSIONING FOR CLEARANCES AND NEW CABLE LOADS

**MAGNATE**  
ENGINEERING AND ASSOCIATES INC.  
18 Automatic Road Suite 1C  
Brampton, Ontario L6S 5N5  
Telephone: (905) 799-8220

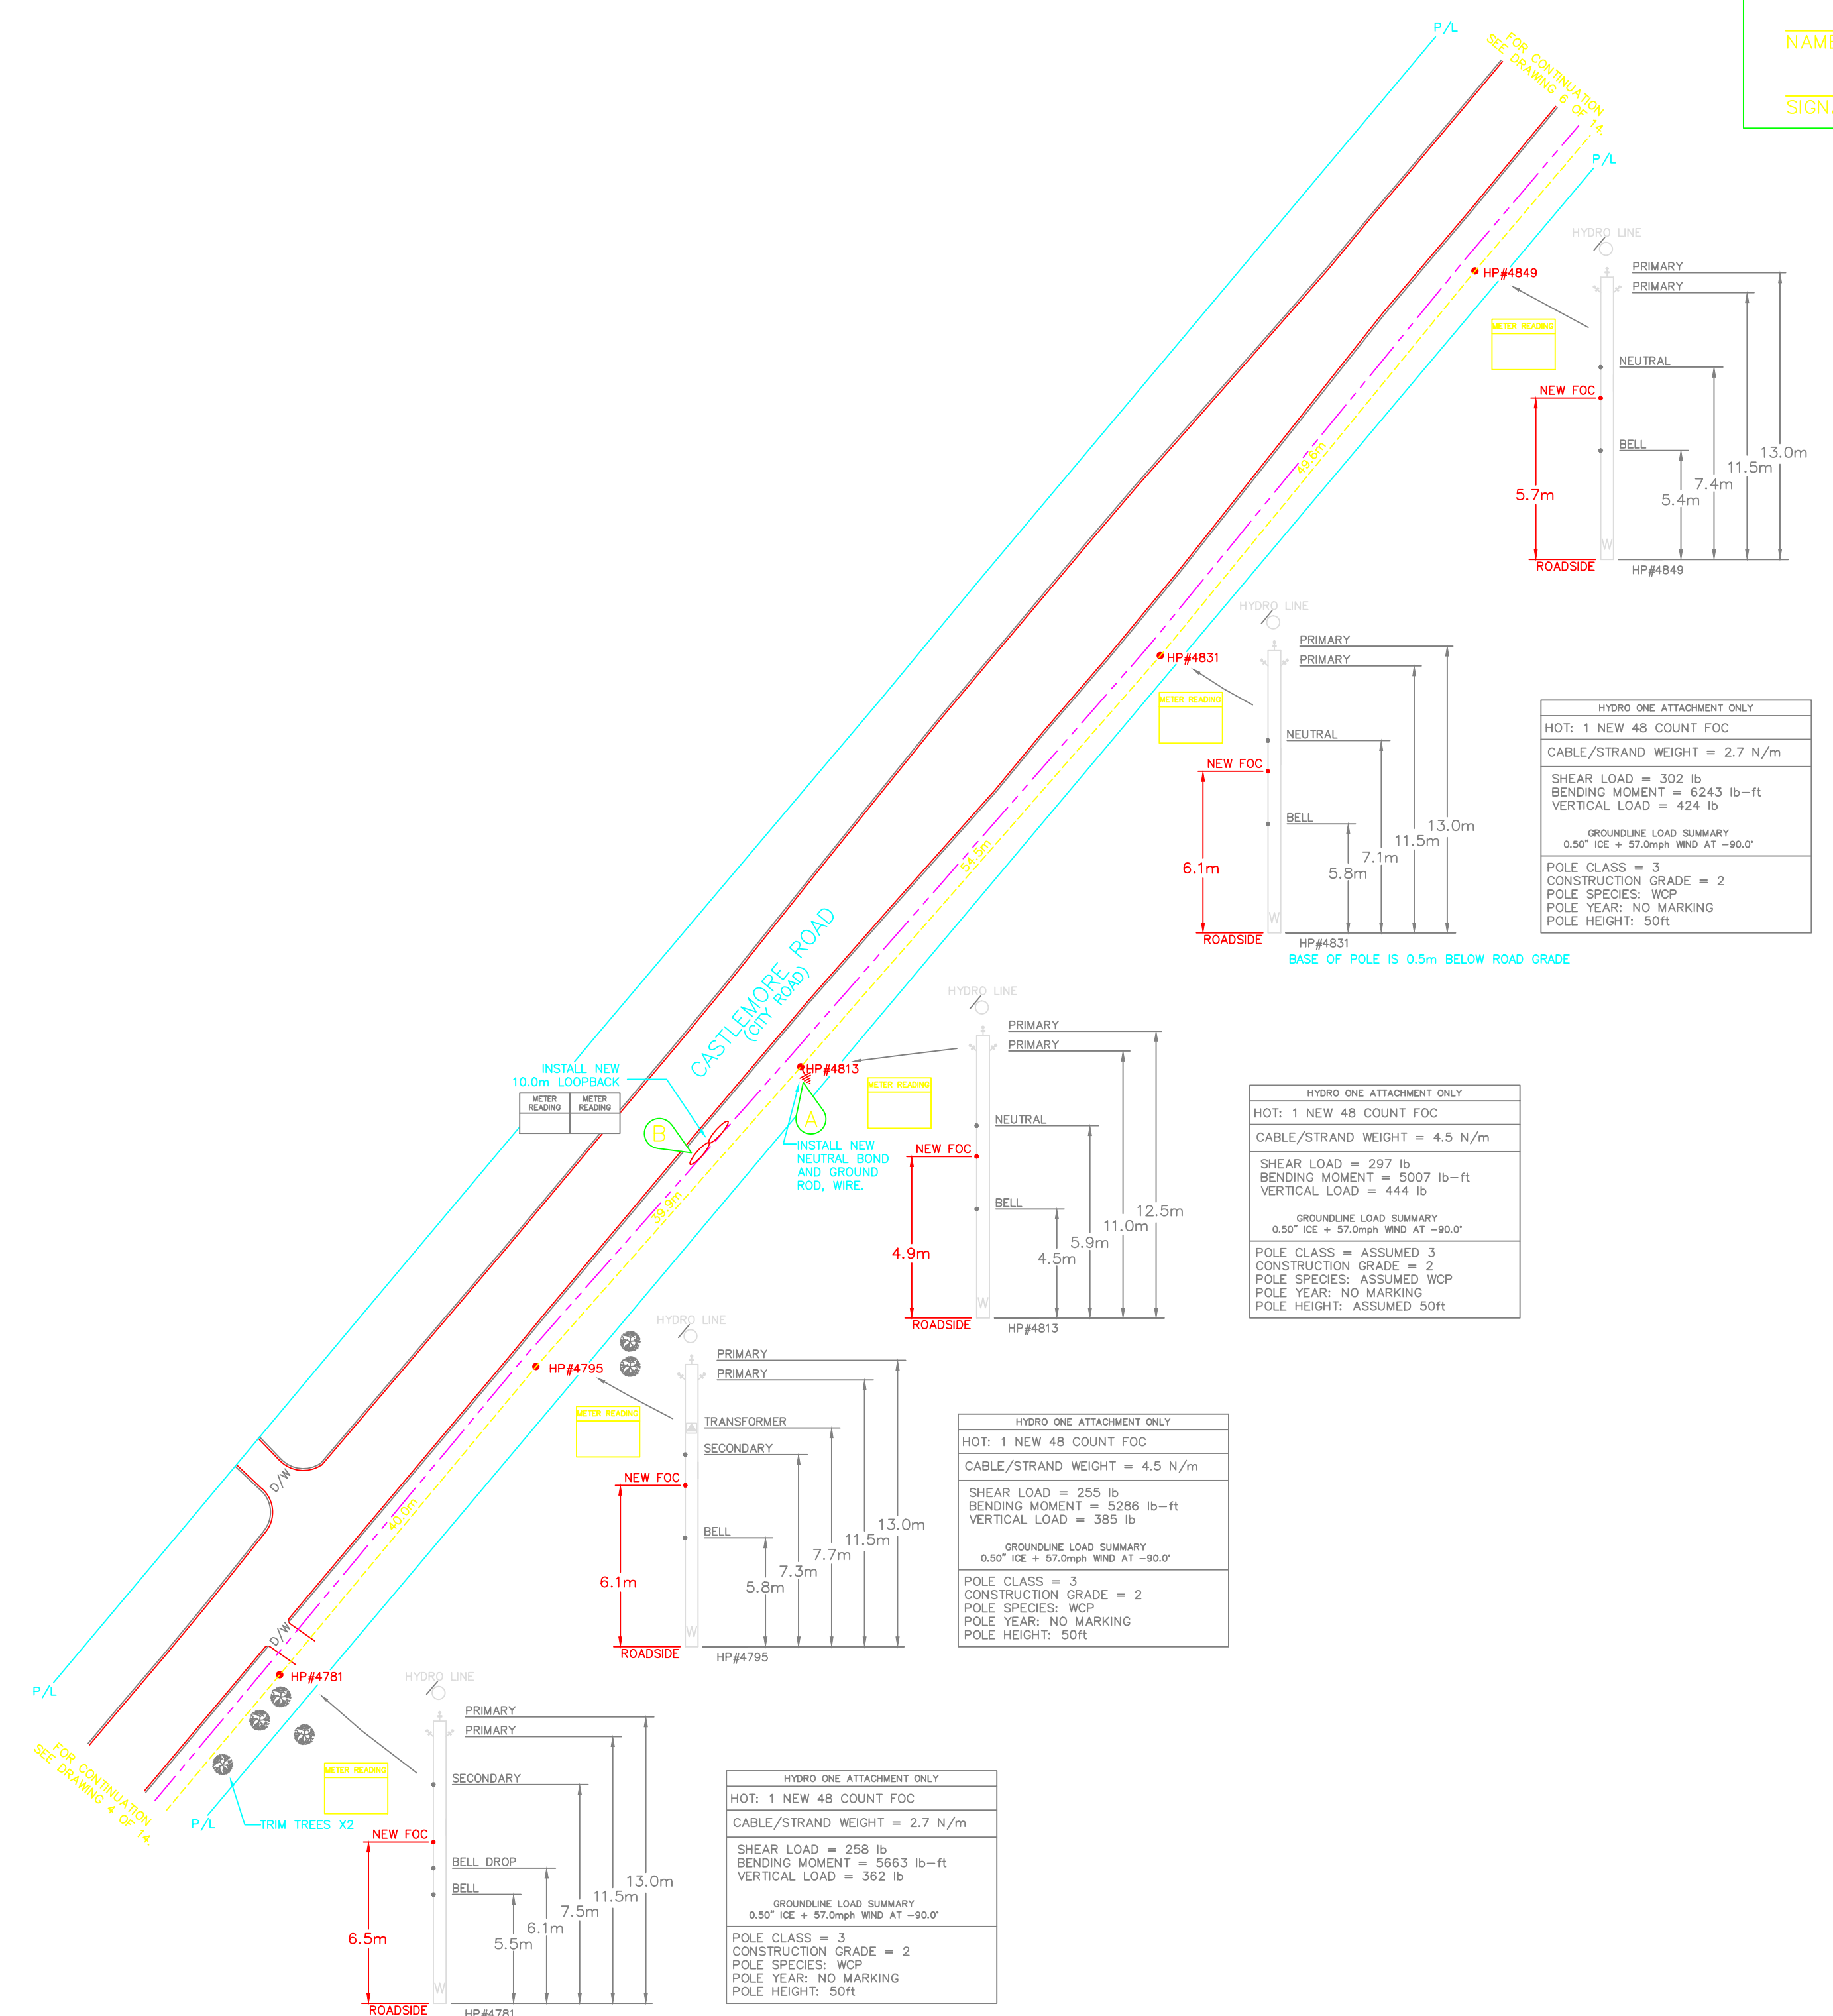

HYDRO ONE ATTACHMENT ONLY  
HOT: 1 NEW 48 COUNT FOC  
CABLE/STRAND WEIGHT = 2.7 N/m  
SHEAR LOAD = 285 lb  
BENDING MOMENT = 5533 lb-ft  
VERTICAL LOAD = 401 lb  
GROUNDLINE LOAD SUMMARY  
0.50" ICE + 57.0mph WIND AT -90.0°

POLE CLASS = 3  
CONSTRUCTION GRADE = 2  
POLE SPECIES: WCP  
POLE YEAR: NO MARKING  
POLE HEIGHT: 50ft

HYDRO ONE ATTACHMENT ONLY  
HOT: 1 NEW 48 COUNT FOC  
CABLE/STRAND WEIGHT = 2.7 N/m  
SHEAR LOAD = 302 lb  
BENDING MOMENT = 6243 lb-ft  
VERTICAL LOAD = 424 lb  
GROUNDLINE LOAD SUMMARY  
0.50" ICE + 57.0mph WIND AT -90.0°

POLE CLASS = 3  
CONSTRUCTION GRADE = 2  
POLE SPECIES: WCP  
POLE YEAR: NO MARKING  
POLE HEIGHT: 50ft

HYDRO ONE ATTACHMENT ONLY  
HOT: 1 NEW 48 COUNT FOC  
CABLE/STRAND WEIGHT = 4.5 N/m  
SHEAR LOAD = 297 lb  
BENDING MOMENT = 5007 lb-ft  
VERTICAL LOAD = 444 lb  
GROUNDLINE LOAD SUMMARY  
0.50" ICE + 57.0mph WIND AT -90.0°

POLE CLASS = ASSUMED 3  
CONSTRUCTION GRADE = 2  
POLE SPECIES: ASSUMED WCP  
POLE YEAR: NO MARKING  
POLE HEIGHT: ASSUMED 50ft

HYDRO ONE ATTACHMENT ONLY  
HOT: 1 NEW 48 COUNT FOC  
CABLE/STRAND WEIGHT = 4.5 N/m  
SHEAR LOAD = 255 lb  
BENDING MOMENT = 5286 lb-ft  
VERTICAL LOAD = 385 lb  
GROUNDLINE LOAD SUMMARY  
0.50" ICE + 57.0mph WIND AT -90.0°

POLE CLASS = 3  
CONSTRUCTION GRADE = 2  
POLE SPECIES: WCP  
POLE YEAR: NO MARKING  
POLE HEIGHT: 50ft

HYDRO ONE ATTACHMENT ONLY  
HOT: 1 NEW 48 COUNT FOC  
CABLE/STRAND WEIGHT = 2.7 N/m  
SHEAR LOAD = 258 lb  
BENDING MOMENT = 5663 lb-ft  
VERTICAL LOAD = 362 lb  
GROUNDLINE LOAD SUMMARY  
0.50" ICE + 57.0mph WIND AT -90.0°

POLE CLASS = 3  
CONSTRUCTION GRADE = 2  
POLE SPECIES: WCP  
POLE YEAR: NO MARKING  
POLE HEIGHT: 50ft

## CERTIFICATE OF APPROVAL

THE NEW INSTALLATION WORK COVERED BY THIS DOCUMENT MEETS THE SAFETY REQUIREMENTS OF SECTION 4 OF REGULATION 22/04, WITH CONSIDERATIONS OF THE FOLLOWING:

THE DESIGN CONFORMS TO CSA 22.3 NO. 1-06 FOR HYDRO ONE TELECOM CLEARANCE, SEPARATION, GUYING AND STRAND TENSION. IT IS NOT INTENDED TO VERIFY THE INTEGRITY OF ATTACHMENTS, ANCHORING OR STRAND TENSIONS OF OTHERS, OR POLE STRENGTH.

POLES WERE NOT INVESTIGATED FOR DEFECTS/ROT.

NAME: \_\_\_\_\_ DATE: \_\_\_\_\_

SIGNATURE OF APPROVAL: \_\_\_\_\_

05/20/2009	ISSUED FOR PERMIT	YC
DATE	REVISION	BY

**hydro one**  
Hydro One Telecommunications  
Hydro One Telecom Inc.  
65 Haffield Street  
Brampton, Ontario N6M 5A3

**MAGNATE**  
ENGINEERING AND ASSOCIATES INC.  
18 Automatic Road, Suite 1C  
Brampton, Ontario L6S 5N5  
Telephone: (905) 799-8220

CASTLEMORE RD - THE GORE RD TO HWY 50  
CITY OF BRAMPTON

PROJECT #	CONTRACTOR #	SCALE:
	9H005007P	1:500
APPROVED BY:	DATE:	DWG 5 OF 14
	05/20/09	
DRAWING NUMBER:		

### CONSTRUCTION NOTES

- 1 OVERLASH 108.8m OF 1-48 COUNT FIBER OPTIC CABLE ON EXISTING ASSUMED 1/4" EHS HOT STRAND.
- 2 INSTALL 2187.3m OF NEW 1/4" EHS STRAND, LASH 1-48 COUNT FIBER OPTIC CABLE.
- 3 INSTALL 545.3m OF NEW 1/4" EHS STRAND, LASH 1-48 COUNT FIBER OPTIC CABLE.
- 4
- 5
- A INSTALL NEW NEUTRAL BOND AND GROUND ROD, AND WIRE.
- B INSTALL NEW 10.0m LOOPBACK.
- C INSTALL NEW DOWNGUY AND ANCHOR.
- D INSTALL NEW RISER C/W U-GUARD.
- E INSTALL NEW HYDRO ONE SPlice ENCLOSURE.
- F INSTALL NEW 1/4" OVERHEAD GUY.

### SCOPE OF WORK

NEW OVERHEAD GUY	3=61.5m
NEW DOWNGUY AND ANCHOR	9
NEW 48 COUNT FIBER OPTIC CABLE	2896.2m
NEW OVERLASH	108.8m
NEW LASHWIRE	8524.2m
NEW 1/4" EHS STRAND	2732.6m
NEW CATV MAKE READY	3
NEW HOT MAKE READY	1
NEW BELL MAKE READY	12
NEW HYDRO MAKE READY	2
NEW RISER C/W U-GUARD	2
NEW SPlice ENCLOSURE	1
NEW GROUND ROD AND WIRE	11=110.0m

NOTE: INFORMATION WAS OBTAINED FROM DRAWINGS SUPPLIED BY:  
1. PHOTOGRAPHS OF PLAN AND PROFILE PROVIDED BY THE CITY OF BRAMPTON AND REGION OF PEEL.

**HYDRO ONE TELECOM CONTACT**  
IAN MITCHELL  
HYDRO ONE TELECOM INC  
65 KEELE STREET  
SCARBOROUGH, ONT. M1V 5A3  
PHONE: (416) 240-4370  
FAX: (416) 240-4370  
CELL: (416) 240-4370  
EMAIL: ian.mitchell@hydroone.com

### ANCHOR SPECIFICATIONS






ANCHOR TYPE	ANCHOR STRENGTH
SINGLE HELIX 8"	14000lbs
SINGLE HELIX 10"	20000lbs
SINGLE HELIX 12"	25000lbs
SINGLE HELIX 14"	31000lbs
TRIPLE HELIX, 8"-10"-12"	46000lbs

CALCULATION FOR REQUIRED STRENGTH OF ANCHOR IS BASED ON -20" WITH 0.5" OF ICE AND SOIL CLASS 4 (MEDIUM DENSE SANDY GRAVEL; VERY STIFF TO HARD SILTS AND CLAYS).

### GENERAL NOTES AERIAL DESIGN AND CONSTRUCTION

1. ALL CONSTRUCTION WORK SHALL BE IN CONFORMANCE WITH CANADIAN, PROVINCIAL AND ONTARIO HYDRO SERVICES COMPANY SAFETY REQUIREMENTS. THESE INCLUDES WITHOUT LIMITATION:
  - OHSC WORK PROTECTION CODE
  - OCCUPATIONAL HEALTH AND SAFETY ACT
  - THIS DESIGN CONFORMS TO CSA STANDARD C22.3 NO. 1-06.
2. TAKE THE NECESSARY PRECAUTIONS TO PROTECT THE EXISTING INSTALLATION FROM DAMAGE. THE CONTRACTOR WILL BE RESPONSIBLE FOR ALL THE CLAIMS DUE TO DAMAGE.
3. ALL REVISIONS MUST BE MADE PRIOR TO CONSTRUCTION.
4. ALL BOLTS MUST PROVIDE FOR 25mm OF EXPOSED THREAD.
5. ASSUME SOIL CONDITIONS AT ANCHOR POINT ARE AS FOLLOWS:
  - MEDIUM DENSE SANDY GRAVEL; VERY STIFF TO HARD SILTS AND CLAYS.
6. THE CONTRACTOR SHALL CHECK AND VERIFY ALL SITE CONDITIONS, CLEARANCES AND DIMENSIONS AT THE SITE AND REPORT ANY DISCREPANCIES TO THE ENGINEER BEFORE PROCEEDING WITH WORK.
7. SAGS & CLEARANCES ARE CHECKED AND CALCULATED FOR NEW ATTACHMENTS ONLY.
8. POLES NOT CHECKED FOR OVERALL LOADING. ADDITIONAL APPLIED LOADS ARE SHOWN ON THIS DRAWING DUE TO NEW ATTACHMENTS ONLY.
9. THE CONTRACTOR SHALL ENSURE THAT THE COMMUNICATION STRAND OR MESSENGER IS BONDED TO THE DISTRIBUTION SYSTEM NEUTRAL AT EVERY DIP LOCATION & EVERY 300 METRES.
10. VISIT THE SITE TO CHECK ON AVAILABLE ACCESS, STORAGE AND WORKING AREAS. DETERMINE ANY INTERFERENCE WITH EXISTING SERVICES.
11. SPIRAL WRAP AND TAG ALL EXPOSED FIBER OPTIC CABLE, INCLUDING: DRIP LOOPS, ENDS OF LOOPBACKS & DIPS ABOVE U-GUARDS.
12. AERIAL STRAND SHALL BE 1/4" EHS STRAND, 7-WIRE ZINC COATED, OR 3/8" EHS STRAND, 7-WIRE ZINC COATED, UNLESS NOTED OTHERWISE.
13. LOCATIONS AND DETAILS SHOWN ON THIS DRAWING ARE BASED ON THE BEST INFORMATION AVAILABLE AT TIME OF SURVEY. CONFIRM ALL LOCATIONS, CLEARANCES, AND INTERFERENCES ON SITE PRIOR TO BEGINNING WORK.
14. POLES WERE NOT VERIFIED FOR DECAY, OR DEFICIENCIES DUE TO THE INSTALLATION OF EXISTING ATTACHMENTS.
15. CONTRACTOR TO CONTACT THE ENGINEER IF THE HYDRO LINE ABOVE THE NEW ATTACHMENT HAS A SAG LARGER THAN 1000mm OR IF THE VOLTAGE IS HIGHER THAN 750V.
16. MAKE GOOD ALL EXISTING FINISHES WHEN WORK IS COMPLETE.
17. THE POSITION OF POLE LINES, CONDUITS, WATERMANS, SEWERS AND OTHER UNDERGROUND AND ABOVE GROUND UTILITIES AND STRUCTURES ARE NOT NECESSARILY SHOWN ON THE CONTRACT DRAWINGS, AND WHERE SHOWN, THE ACCURACY OF THE POSITION OF SUCH UTILITIES AND STRUCTURES IS NOT GUARANTEED. BEFORE STARTING WORK, THE CONTRACTOR SHALL CONFIRM THE EXACT LOCATION OF ALL SUCH UTILITIES AND STRUCTURES, AND SHALL ASSUME ALL LIABILITY FOR DAMAGE TO THEM.
18. ALL THE MATERIAL AND EQUIPMENT TO BE ESA AND CSA APPROVED.
19. CONTRACTOR TO USE DOWNGUY SPLITTERS AS REQUIRED IN ORDER TO AVOID CONTACT WITH POWER LINES.
20. ANALYSIS WAS PERFORMED USING THE DETERMINISTIC METHOD ASSUMING THAT THE HIGHEST VOLTAGE OF ANY OF THE EXISTING SUPPLY LINES IS LESS THAN 70 KV PHASE TO PHASE.
21. WHERE EXISTING COMMUNICATIONS ATTACHMENTS ARE SHOWN TO BE RELOCATED, THE THIRD PARTY OWNER OF THE ATTACHMENT MUST BE CONTACTED TO REVIEW AND ENSURE MINIMUM CLEARANCES ARE MAINTAINED IN ACCORDANCE WITH APPLICABLE STANDARDS.

RECORD OF INSPECTION BY CONSTRUCTOR	
AS CONSTRUCTED	<input type="checkbox"/> Aerial Installation
	<input type="checkbox"/> U/G Installation
With changes shown on this Drawing	
Attachment Owner	Permit #
	Date
	Company Name
	Print Name
	Position
	Signature
<input type="checkbox"/> This is to certify that the construction as recorded in this drawing is consistent with the approved plan, Standard Designs, or work instruction and that approved equipment has been used.	

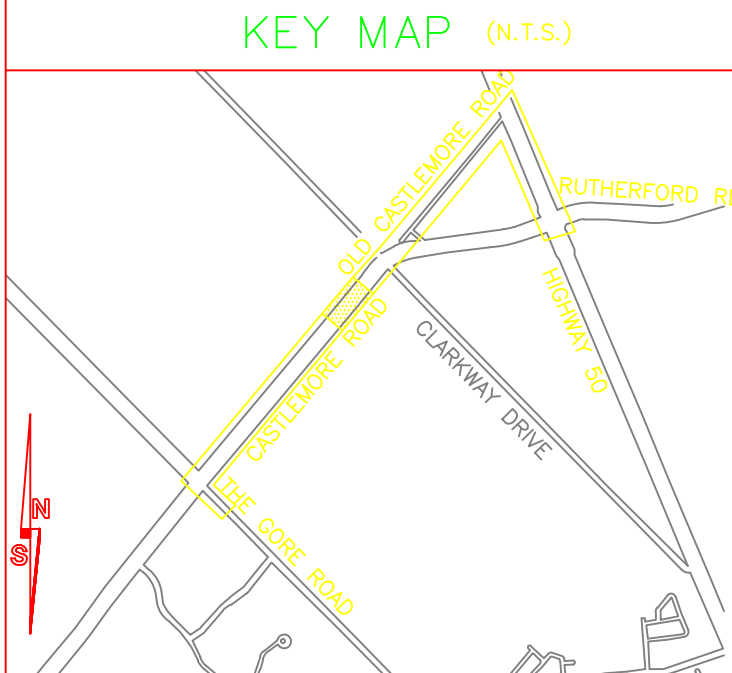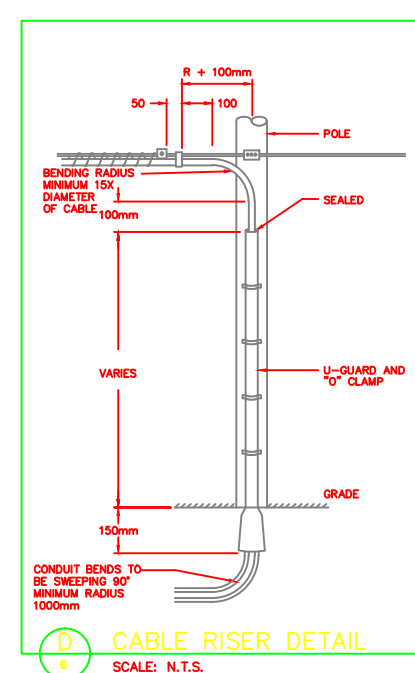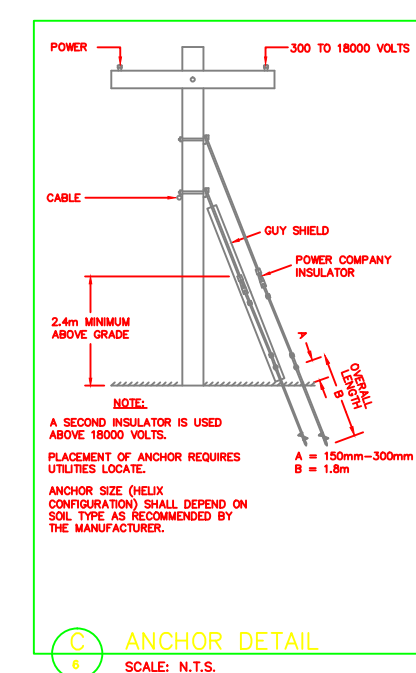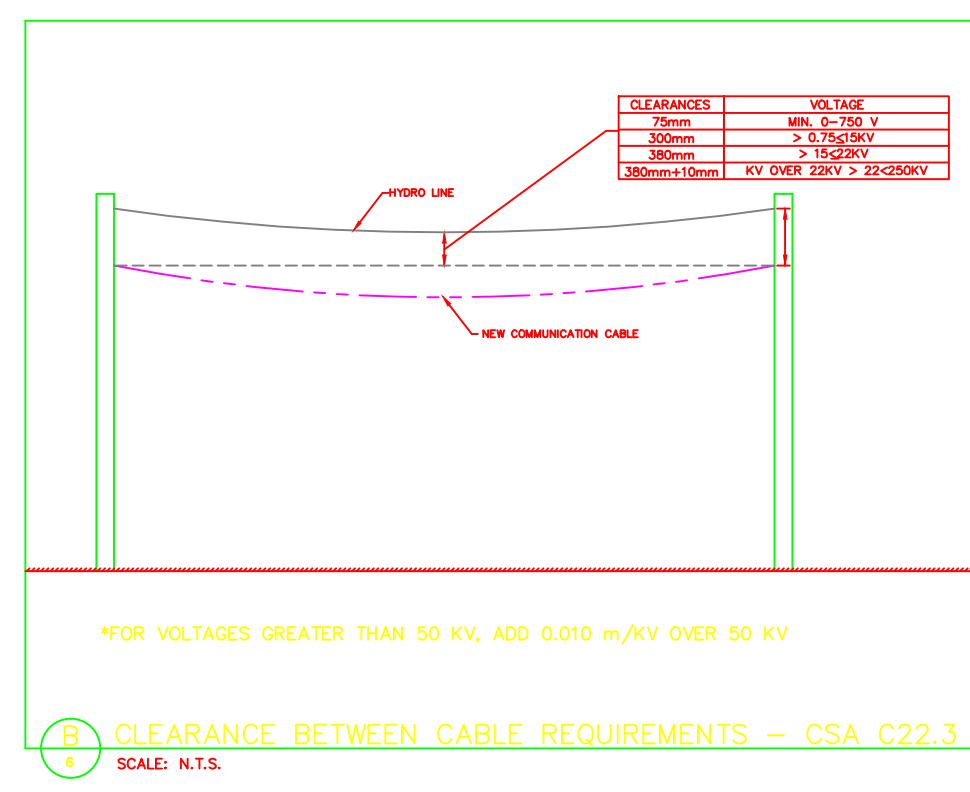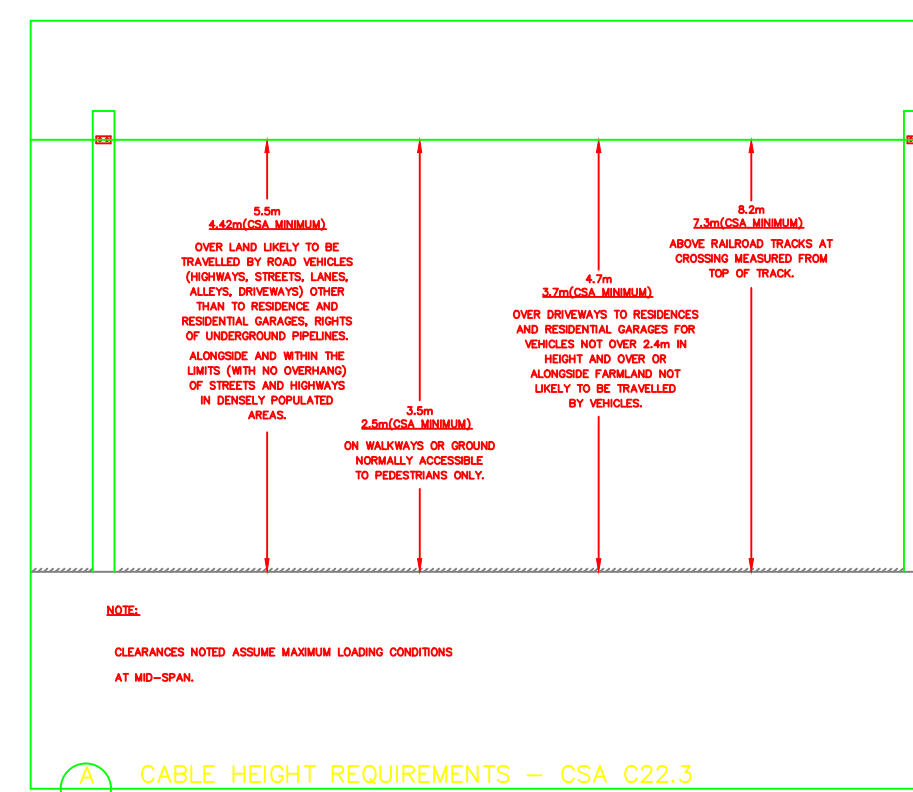

### REFERENCE DRAWINGS

CITY OF BRAMPTON

### LEGEND

NEW FIBER	
NEW STRAND	
OVERLASH	
EXISTING CONDUIT	
UNDERGROUND GAS LINE	
UNDERGROUND WATER	
UNDERGROUND HYDRO	
UNDERGROUND BELL	
UNDERGROUND CATV	
STORM SEWER	
SANITARY SEWER	
PROPERTY LINE	
FENCE	
DITCH	
EDGE OF PAVEMENT	
CURB	
GRAVEL SHOULDER	
NEW SPlice	
EXISTING SPlice	
VAULT	
BELL PEDESTAL	
CATV PEDESTAL	
TRANSFORMER	
CATCH BASIN	
WATER VALVE	
FIRE HYDRANT	
EXISTING POLE TO BE REMOVED	
STREET SIGN	
HYDRO POLE	
MANHOLE COVER	
MANHOLE & COVER	
LARGE ROCK	
TREE	
DIP LOCATION	
NEW DOWNGUY AND ANCHOR	
NEW SIDEWALK GUY	
NEW INTERIOR FIBER	
NEW BACKBOARD	
EXISTING BACKBOARD	
NEW PATCH PANEL	
EXISTING PATCH PANEL	
NEW EQUIPMENT RACK	
EXISTING EQUIPMENT RACK	
NEW FIBER COIL	

FIBER I.D.# BMTN-(CABLE I.D.)-(FIBRE COUNT)

THESE DRAWINGS ARE COPYRIGHT AND THE PROPERTY OF MAGNATE ENGINEERING AND ASSOCIATES INC. REPRODUCTION OF THESE DRAWINGS WITHOUT THE CONSENT OF MAGNATE ENGINEERING AND ASSOCIATES INC. IS STRICTLY PROHIBITED. DO NOT SCALE THESE DRAWINGS, ANY ERRORS OR DISCREPANCY IS TO BE REPORTED IMMEDIATELY TO MAGNATE ENGINEERING AND ASSOCIATES INC.

DATE	REVISION	BY
05/20/2009	ISSUED FOR PERMIT	YC

**hydro one**  
Hydro One Telecommunications

Hydro One Telecom Inc.  
65 Keele Street  
Toronto, Ontario M3J 5A3

**MAGNATE**  
ENGINEERING AND ASSOCIATES INC.

18 Automatic Road, Suite 1C  
Brampton, Ontario L6S 5N5  
Telephone: (905) 799-8220

CASTLEMORE RD - THE GORE RD TO HWY 50  
CITY OF BRAMPTON


PROJECT #	CONTRACTOR #	SCALE
	9H005007P	1:500
APPROVED BY:	DATE:	DWG
	05/20/09	6 OF 14
DRAWING NUMBER:		

### HYDRO ONE TELECOM ATTACHMENT CERTIFICATE

THIS IS TO CERTIFY THAT THE CONSTRUCTION AS RECORDED IN THIS DRAWING MEETS THE APPLICABLE REQUIREMENTS OF THE SAFETY STANDARDS IN PART 4 OF REGULATION 22/04.

NAME \_\_\_\_\_ DATE \_\_\_\_\_

SIGNATURE & PROFESSIONAL DESIGNATION \_\_\_\_\_

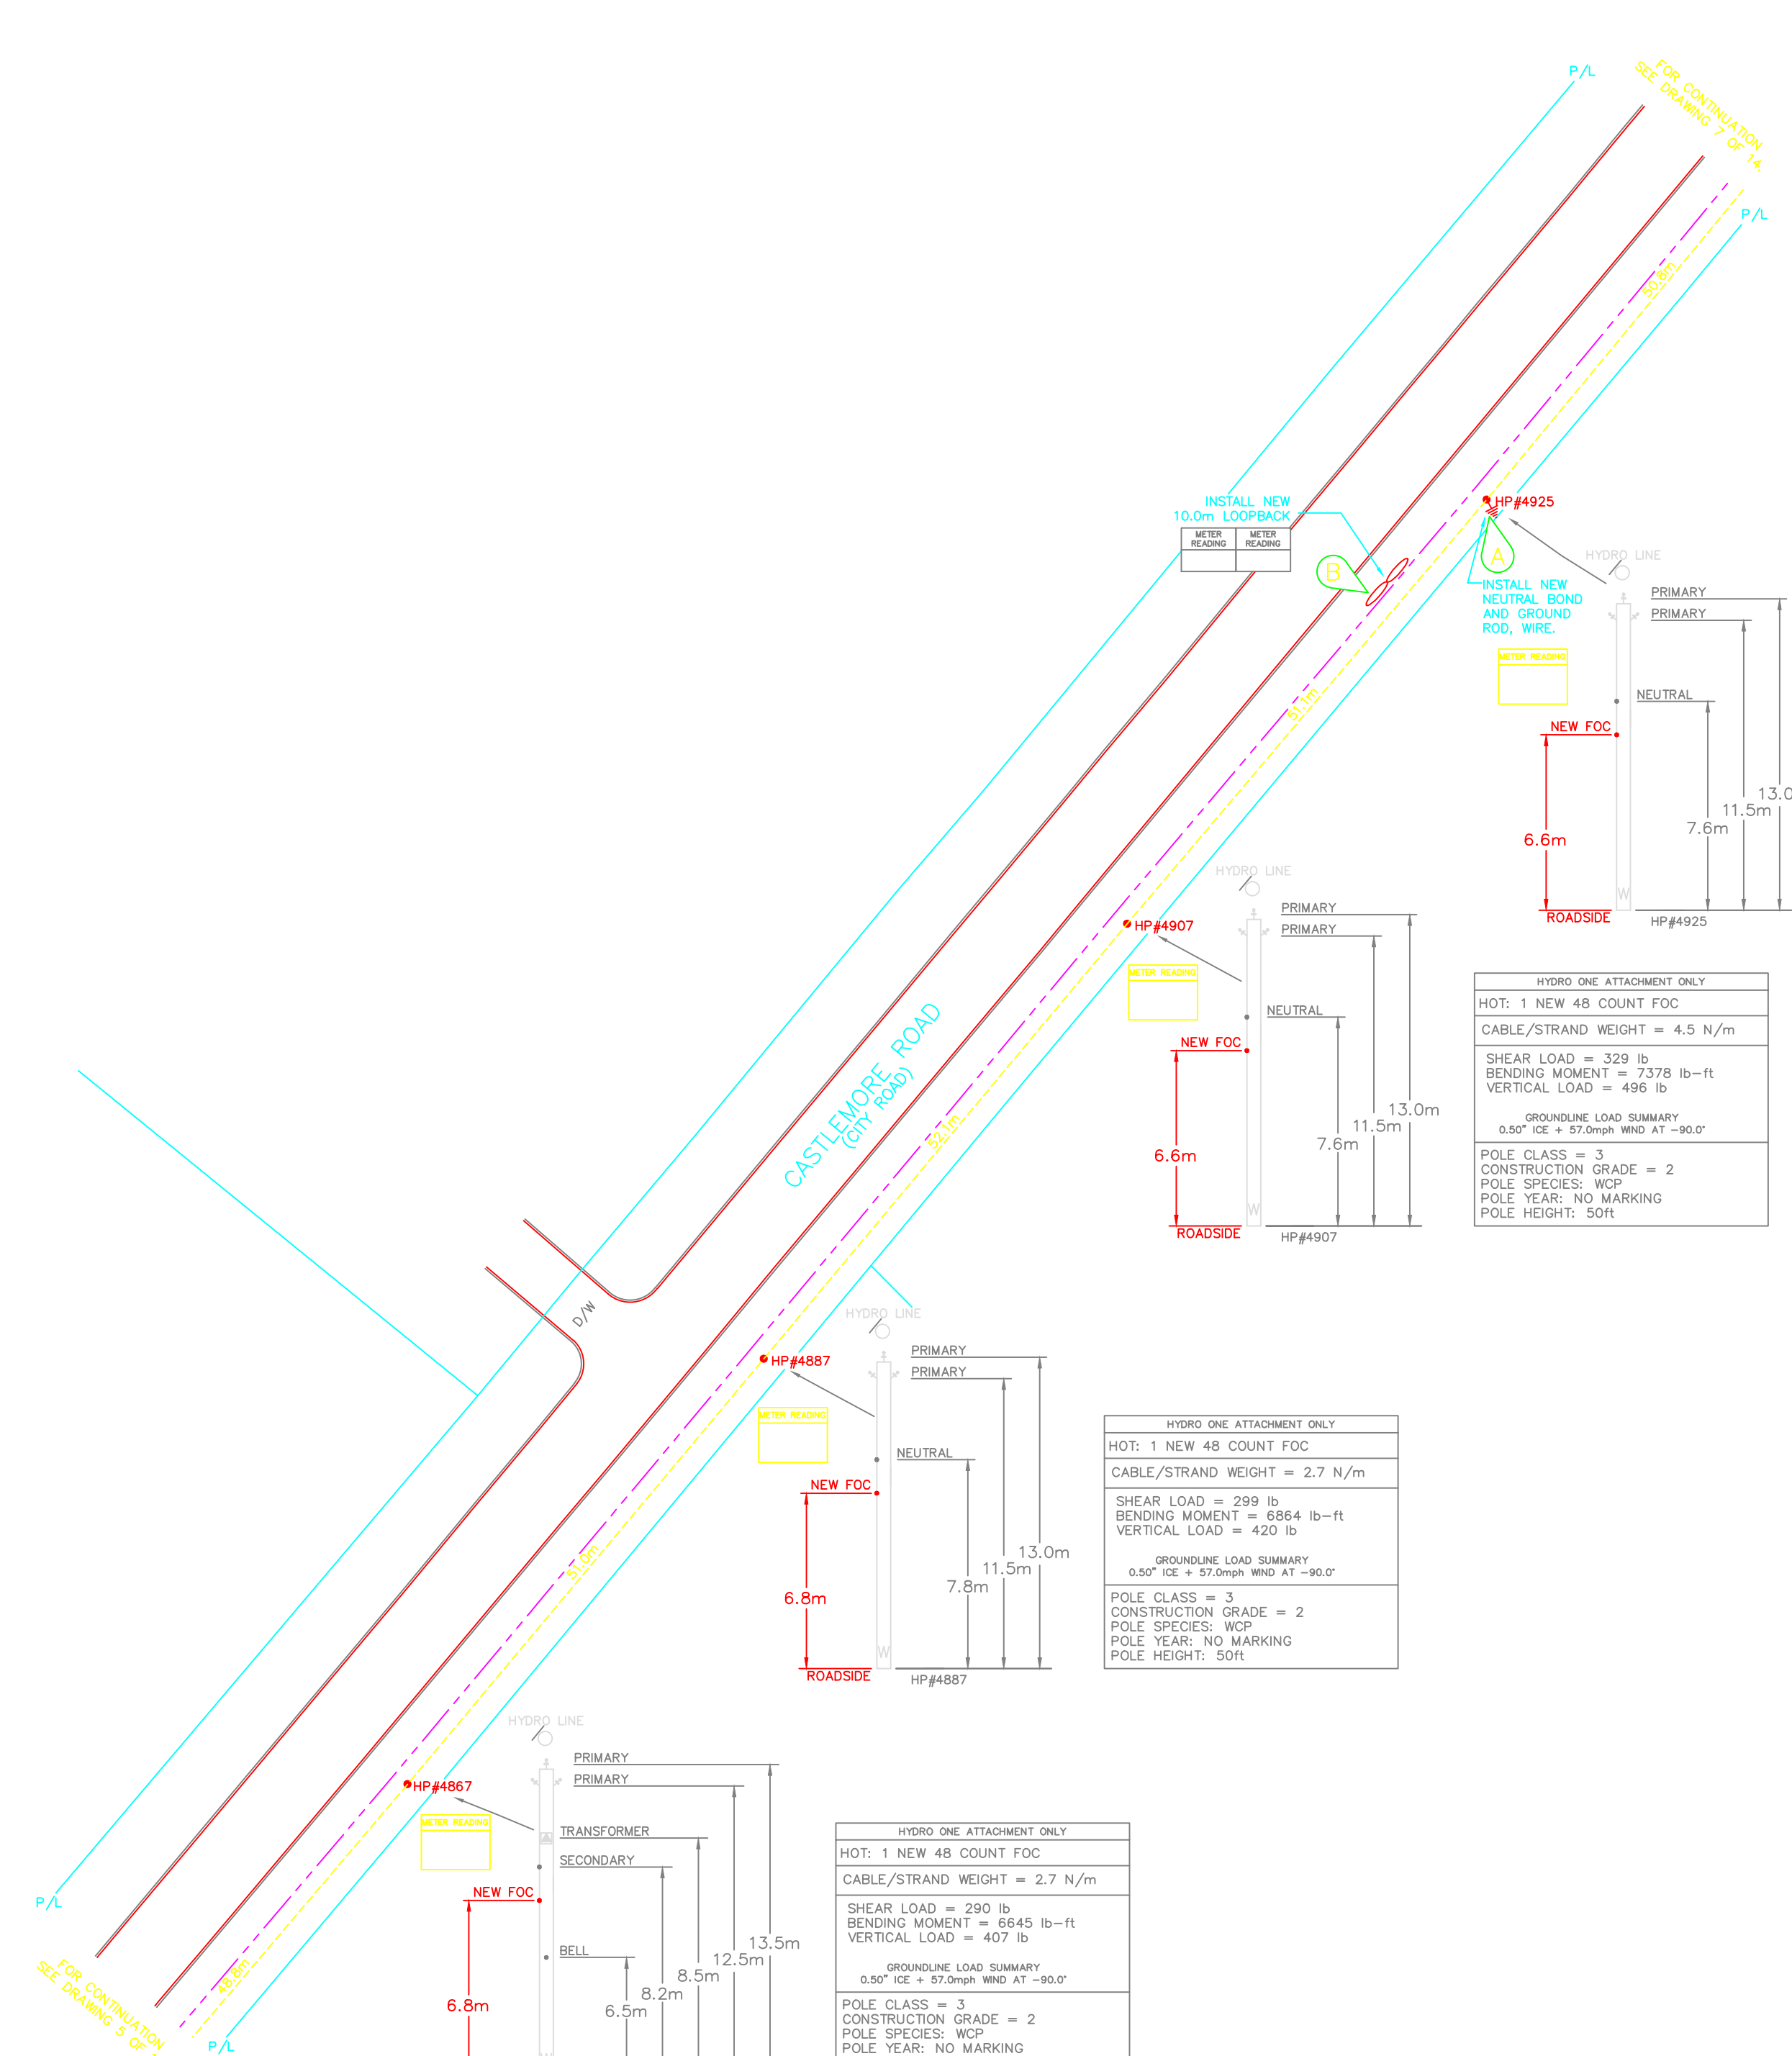

### CERTIFICATE OF APPROVAL

THE NEW INSTALLATION WORK COVERED BY THIS DOCUMENT MEETS THE SAFETY REQUIREMENTS OF SECTION 4 OF REGULATION 22/04, WITH CONSIDERATIONS OF THE FOLLOWING:

THE DESIGN CONFORMS TO CSA 22.3 NO 1-06 FOR HYDRO ONE TELECOM CLEARANCE, SEPARATION, GUYING AND STRAND TENSION. IT IS NOT INTENDED TO VERIFY THE INTEGRITY OF ATTACHMENTS, ANCHORING OR STRAND TENSIONS OF OTHERS, OR POLE STRENGTH.

POLES WERE NOT INVESTIGATED FOR DEFECTS/ROT.

NAME: \_\_\_\_\_ DATE: \_\_\_\_\_

SIGNATURE OF APPROVAL: \_\_\_\_\_

### CONSTRUCTION NOTES

- 1 OVERLASH 108.8m OF 1-48 COUNT FIBER OPTIC CABLE ON EXISTING ASSUMED 1/4" EHS HOT STRAND.
- 2 INSTALL 2187.3m OF NEW 1/4" EHS STRAND, LASH 1-48 COUNT FIBER OPTIC CABLE.
- 3 INSTALL 545.3m OF NEW 1/4" EHS STRAND, LASH 1-48 COUNT FIBER OPTIC CABLE.
- 4
- 5
- A INSTALL NEW NEUTRAL BOND AND GROUND ROD, AND WIRE.
- B INSTALL NEW 10.0m LOOPBACK.
- C INSTALL NEW DOWNGUY AND ANCHOR.
- D INSTALL NEW RISER C/W U-GUARD.
- E INSTALL NEW HYDRO ONE SPULSE ENCLOSURE.
- F INSTALL NEW 1/4" OVERHEAD GUY.

### SCOPE OF WORK

NEW OVERHEAD GUY	3=61.5m
NEW DOWNGUY AND ANCHOR	9
NEW 48 COUNT FIBER OPTIC CABLE	2896.2m
NEW OVERLASH	108.8m
NEW LASHWIRE	8524.2m
NEW 1/4" EHS STRAND	2732.6m
NEW CATV MAKE READY	3
NEW HOT MAKE READY	1
NEW BELL MAKE READY	12
NEW HYDRO MAKE READY	2
NEW RISER C/W U-GUARD	2
NEW SPULSE ENCLOSURE	1
NEW GROUND ROD AND WIRE	11=110.0m

NOTE: INFORMATION WAS OBTAINED FROM DRAWINGS SUPPLIED BY:  
1. PHOTOGRAPHS OF PLAN AND PROFILE PROVIDED BY THE CITY OF BRAMPTON AND REGION OF PEEL.

**HYDRO ONE TELECOM CONTACT**  
IAN MITCHELL  
HYDRO ONE TELECOM INC  
65 KEELEND STREET  
SCARBOROUGH, ONT. M1V 5A3  
PHONE: (416) 240-5700  
FAX: (416) 240-5700  
CELL: (416) 240-5700  
EMAIL: ian.mitchell@hydroone.com

### ANCHOR SPECIFICATIONS







ANCHOR TYPE	ANCHOR STRENGTH
SINGLE HELIX 8"	14000lbs
SINGLE HELIX 10"	20000lbs
SINGLE HELIX 12"	25000lbs
SINGLE HELIX 14"	31000lbs
TRIPLE HELIX, 8"-10"-12"	46000lbs

CALCULATION FOR REQUIRED STRENGTH OF ANCHOR IS BASED ON -20" WITH 0.5" OF ICE AND SOIL CLASS 4 (MEDIUM DENSE SANDY GRAVEL; VERY STIFF TO HARD SILTS AND CLAYS).

### GENERAL NOTES AERIAL DESIGN AND CONSTRUCTION

1. ALL CONSTRUCTION WORK SHALL BE IN CONFORMANCE WITH CANADIAN, PROVINCIAL AND ONTARIO HYDRO SERVICES COMPANY SAFETY REQUIREMENTS. THESE INCLUDES WITHOUT LIMITATION:
  - OHSC WORK PROTECTION CODE
  - OCCUPATIONAL HEALTH AND SAFETY ACT
  - THIS DESIGN CONFORMS TO CSA STANDARD C22.3 NO. 1-06.
2. TAKE THE NECESSARY PRECAUTIONS TO PROTECT THE EXISTING INSTALLATION FROM DAMAGE. THE CONTRACTOR WILL BE RESPONSIBLE FOR ALL THE CLAIMS DUE TO DAMAGE.
3. ALL REVISIONS MUST BE MADE PRIOR TO CONSTRUCTION.
4. ALL BOLTS MUST PROVIDE FOR 25mm OF EXPOSED THREAD.
5. ASSUME SOIL CONDITIONS AT ANCHOR POINT ARE AS FOLLOWS:
  - MEDIUM DENSE SANDY GRAVEL; VERY STIFF TO HARD SILTS AND CLAYS.
6. THE CONTRACTOR SHALL CHECK AND VERIFY ALL SITE CONDITIONS, CLEARANCES AND DIMENSIONS AT THE SITE AND REPORT ANY DISCREPANCIES TO THE ENGINEER BEFORE PROCEEDING WITH WORK.
7. SAGS & CLEARANCES ARE CHECKED AND CALCULATED FOR NEW ATTACHMENTS ONLY.
8. POLES NOT CHECKED FOR OVERALL LOADING. ADDITIONAL APPLIED LOADS ARE SHOWN ON THIS DRAWING DUE TO NEW ATTACHMENTS ONLY.
9. THE CONTRACTOR SHALL ENSURE THAT THE COMMUNICATION STRAND OR MESSENGER IS BONDED TO THE DISTRIBUTION SYSTEM NEUTRAL AT EVERY DIP LOCATION & EVERY 300 METRES.
10. VISIT THE SITE TO CHECK ON AVAILABLE ACCESS, STORAGE AND WORKING AREAS. DETERMINE ANY INTERFERENCE WITH EXISTING SERVICES.
11. SPIRAL WRAP AND TAG ALL EXPOSED FIBER OPTIC CABLE, INCLUDING: DRIP LOOPS, ENDS OF LOOPBACKS & DIPS ABOVE U-GUARDS.
12. AERIAL STRAND SHALL BE 1/4" EHS STRAND, 7-WIRE ZINC COATED, OR 3/8" EHS STRAND, 7-WIRE ZINC COATED, UNLESS NOTED OTHERWISE.
13. LOCATIONS AND DETAILS SHOWN ON THIS DRAWING ARE BASED ON THE BEST INFORMATION AVAILABLE AT TIME OF SURVEY. CONFIRM ALL LOCATIONS, CLEARANCES, AND INTERFERENCES ON SITE PRIOR TO BEGINNING WORK.
14. POLES WERE NOT VERIFIED FOR DECAY, OR DEFICIENCIES DUE TO THE INSTALLATION OF EXISTING ATTACHMENTS.
15. CONTRACTOR TO CONTACT THE ENGINEER IF THE HYDRO LINE ABOVE THE NEW ATTACHMENT HAS A SAG LARGER THAN 1000mm OR IF THE VOLTAGE IS HIGHER THAN 750V.
16. MAKE GOOD ALL EXISTING FINISHES WHEN WORK IS COMPLETE.
17. THE POSITION OF POLE LINES, CONDUITS, WATERMANS, SEWERS AND OTHER UNDERGROUND AND ABOVE GROUND UTILITIES AND STRUCTURES ARE NOT NECESSARILY SHOWN ON THE CONTRACT DRAWINGS, AND WHERE SHOWN, THE ACCURACY OF THE POSITION OF SUCH UTILITIES AND STRUCTURES IS NOT GUARANTEED. BEFORE STARTING WORK, THE CONTRACTOR SHALL CONFIRM THE EXACT LOCATION OF ALL SUCH UTILITIES AND STRUCTURES, AND SHALL ASSUME ALL LIABILITY FOR DAMAGE TO THEM.
18. ALL THE MATERIAL AND EQUIPMENT TO BE ESA AND CSA APPROVED.
19. CONTRACTOR TO USE DOWNGUY SPLITTERS AS REQUIRED IN ORDER TO AVOID CONTACT WITH POWER LINES.
20. ANALYSIS WAS PERFORMED USING THE DETERMINISTIC METHOD ASSUMING THAT THE HIGHEST VOLTAGE OF ANY OF THE EXISTING SUPPLY LINES IS LESS THAN 70 KV PHASE TO PHASE.
21. WHERE EXISTING COMMUNICATIONS ATTACHMENTS ARE SHOWN TO BE RELOCATED, THE THIRD PARTY OWNER OF THE ATTACHMENT MUST BE CONTACTED TO REVIEW AND ENSURE MINIMUM CLEARANCES ARE MAINTAINED IN ACCORDANCE WITH APPLICABLE STANDARDS.

RECORD OF INSPECTION BY CONTRACTOR	
AS CONSTRUCTED	<input type="checkbox"/> Aerial Installation
	<input type="checkbox"/> U/G Installation
With changes shown on this Drawing	
Attachment Owner	Permit #
	Date
	Company Name
	Print Name
	Position
	Signature
<input type="checkbox"/> This is to certify that the construction as recorded in this drawing is consistent with the approved plan, Standard Designs, or work instruction and that approved equipment has been used.	

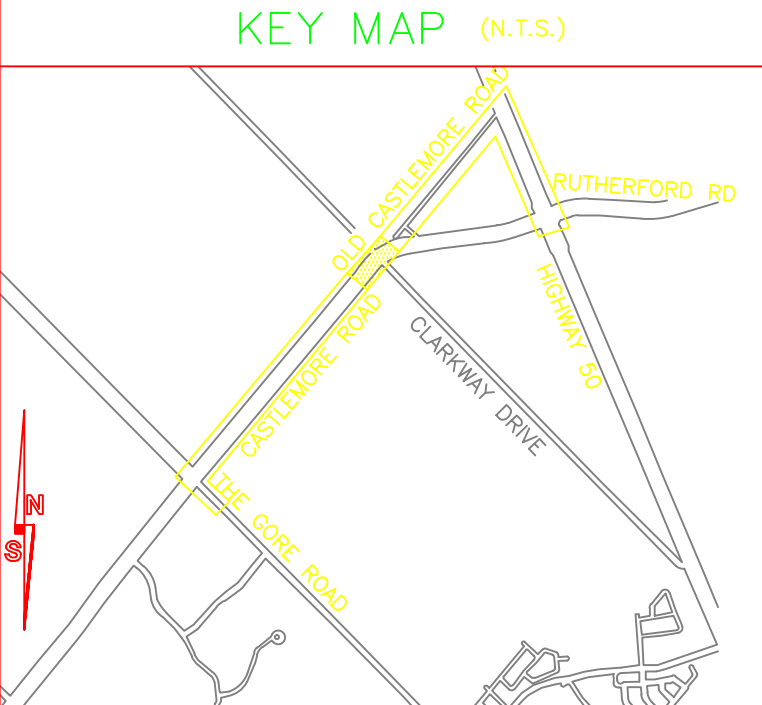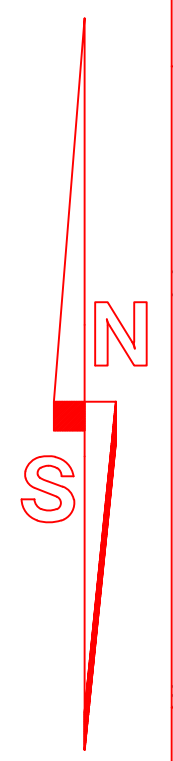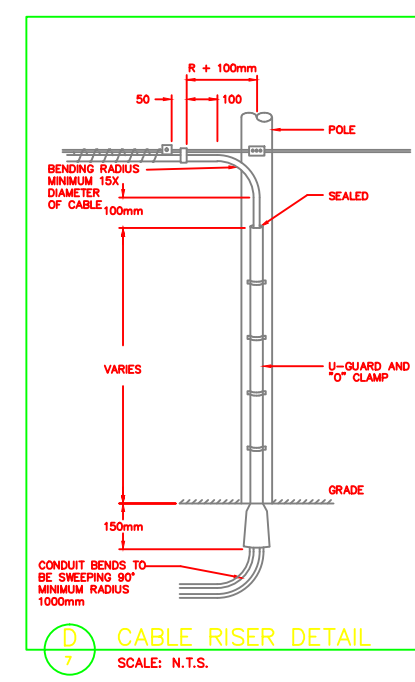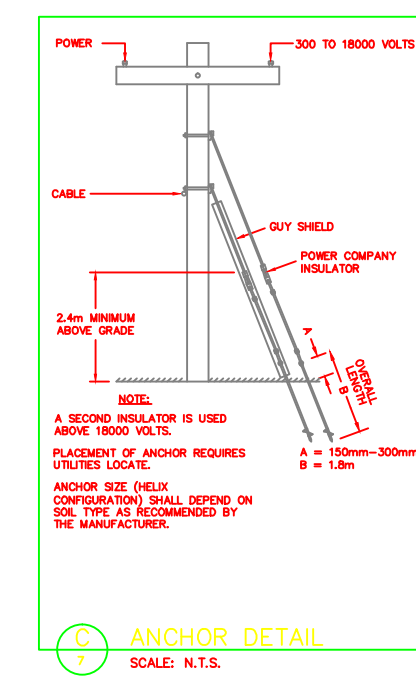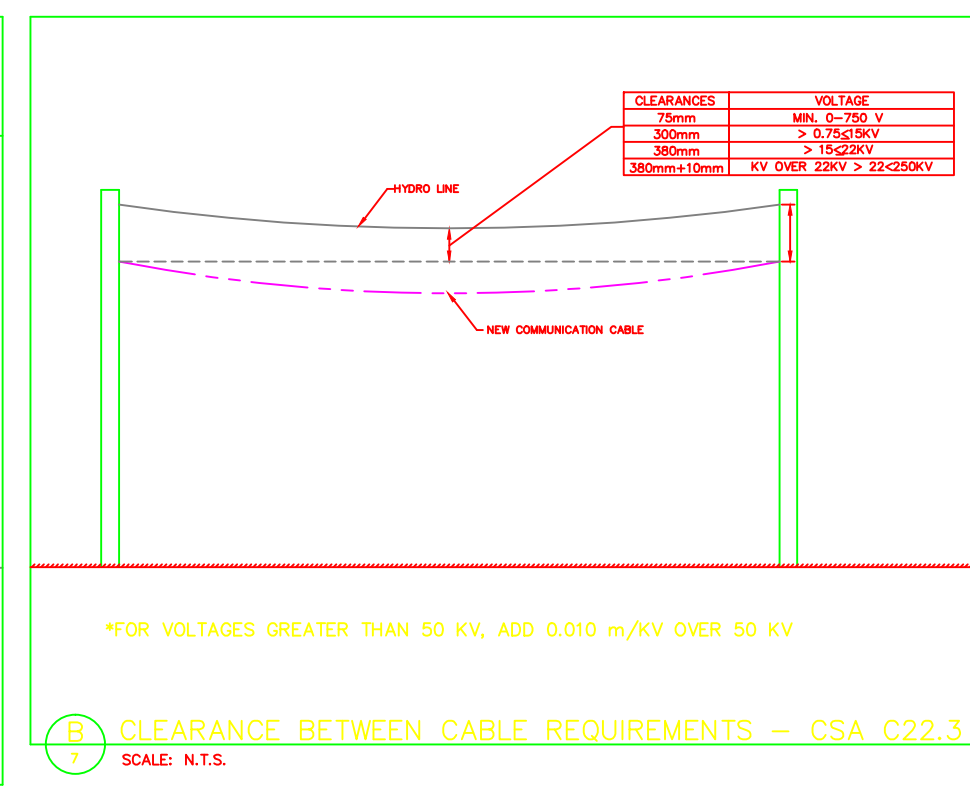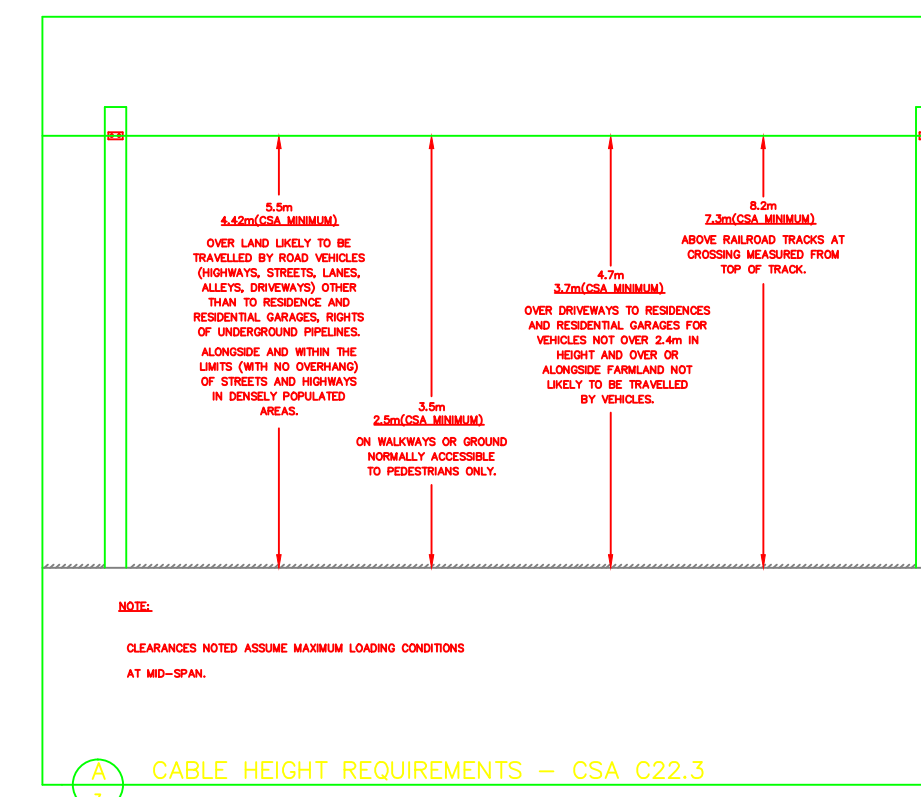

### REFERENCE DRAWINGS

CITY OF BRAMPTON

### LEGEND

NEW FIBER	
NEW STRAND	
OVERLASH	
EXISTING CONDUIT	
UNDERGROUND GAS LINE	
UNDERGROUND WATER	
UNDERGROUND HYDRO	
UNDERGROUND BELL	
UNDERGROUND CATV	
STORM SEWER	
SANITARY SEWER	
PROPERTY LINE	
FENCE	
DITCH	
EDGE OF PAVEMENT	
CURB	
GRAVEL SHOULDER	
NEW SPULSE	
EXISTING SPULSE	
VAULT	
BELL PEDESTAL	
CATV PEDESTAL	
TRANSFORMER	
CATCH BASIN	
WATER VALVE	
FIRE HYDRANT	
EXISTING POLE TO BE REMOVED	
STREET SIGN	
HYDRO POLE	
MANHOLE COVER	
MANHOLE & COVER	
LARGE ROCK	
TREE	
DIP LOCATION	
NEW DOWNGUY AND ANCHOR	
NEW SIDEWALK GUY	
NEW INTERIOR FIBER	
NEW BACKBOARD	
EXISTING BACKBOARD	
NEW PATCH PANEL	
EXISTING PATCH PANEL	
NEW EQUIPMENT RACK	
EXISTING EQUIPMENT RACK	
NEW FIBER COIL	

FIBER I.D.# BMTN-(CABLE I.D.)-(FIBRE COUNT)  
THESE DRAWINGS ARE COPYRIGHT AND THE PROPERTY OF MAGNATE ENGINEERING AND ASSOCIATES INC. REPRODUCTION OF THESE DRAWINGS WITHOUT THE CONSENT OF MAGNATE ENGINEERING AND ASSOCIATES INC. IS STRICTLY PROHIBITED. DO NOT SCALE THESE DRAWINGS, ANY ERRORS, OR DISCREPANCY IS TO BE REPORTED IMMEDIATELY TO MAGNATE ENGINEERING AND ASSOCIATES INC.

DATE	REVISION	BY
05/20/2009	ISSUED FOR PERMIT	YC

**hydro one**  
Hydro One Telecommunications

**MAGNATE**  
ENGINEERING AND ASSOCIATES INC.  
18 Automatic Road, Suite 1C  
Brampton, Ontario L6S 5N5  
Telephone: (905) 799-8220

CASTLEMORE RD - THE GORE RD TO HWY 50  
CITY OF BRAMPTON

PROJECT #	CONTRACTOR #	SCALE
	9H005007P	1:500


APPROVED BY:	DATE:	DWG	OF
	05/20/09	7	14

### HYDRO ONE TELECOM ATTACHMENT CERTIFICATE

THIS IS TO CERTIFY THAT THE CONSTRUCTION AS RECORDED IN THIS DRAWING MEETS THE APPLICABLE REQUIREMENTS OF THE SAFETY STANDARDS IN PART 4 OF REGULATION 22/04.

NAME: \_\_\_\_\_ DATE: \_\_\_\_\_

SIGNATURE & PROFESSIONAL DESIGNATION: \_\_\_\_\_

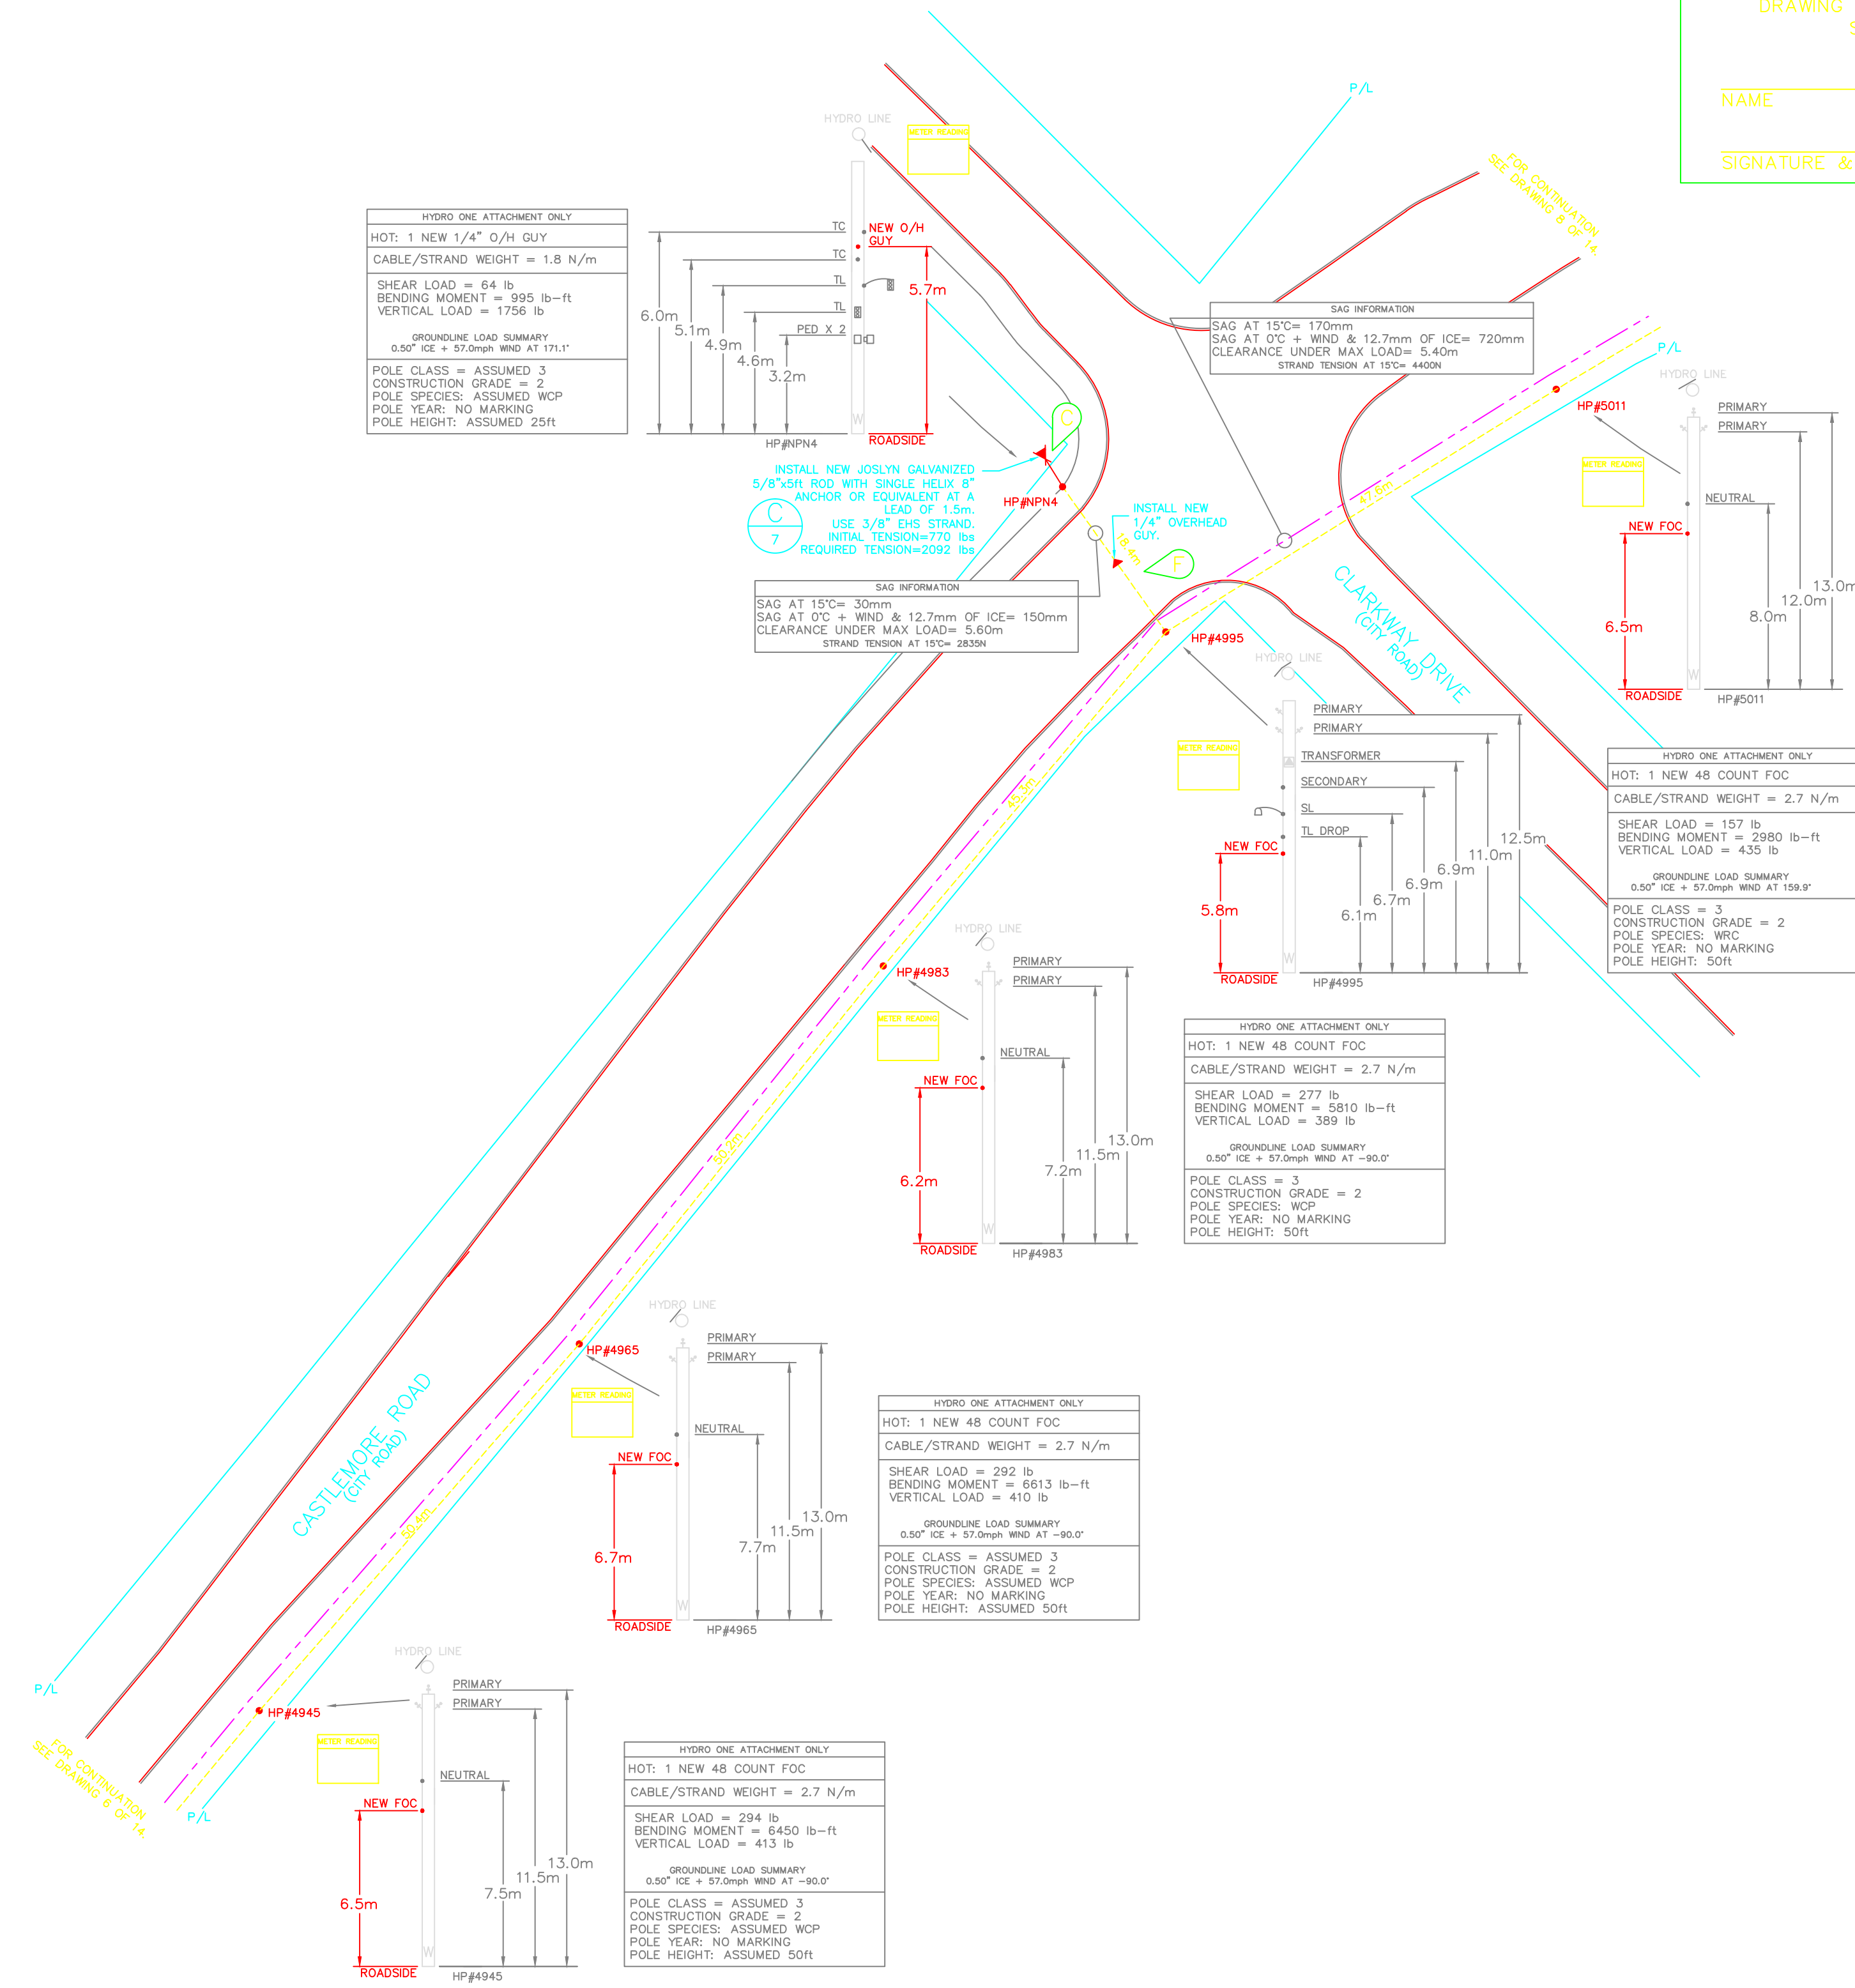

HYDRO MAKE READY  
ENSURE SL IS GROUNDED

### CERTIFICATE OF APPROVAL


THE NEW INSTALLATION WORK COVERED BY THIS DOCUMENT MEETS THE SAFETY REQUIREMENTS OF SECTION 4 OF REGULATION 22/04, WITH CONSIDERATIONS OF THE FOLLOWING:

THE DESIGN CONFORMS TO CSA 22.3 NO. 1-06 FOR HYDRO ONE TELECOM CLEARANCE, SEPARATION, GUYING AND STRAND TENSION. IT IS NOT INTENDED TO VERIFY THE INTEGRITY OF ATTACHMENTS, ANCHORING OR STRAND TENSIONS OF OTHERS, OR POLE STRENGTH.

POLES WERE NOT INVESTIGATED FOR DEFECTS/ROT.

NAME: \_\_\_\_\_ DATE: \_\_\_\_\_

SIGNATURE OF APPROVAL: \_\_\_\_\_

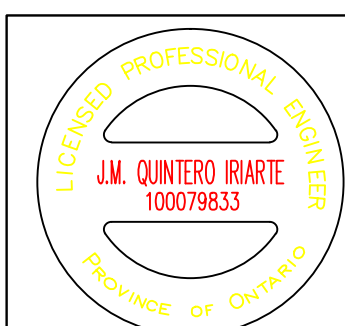

FOR NEW CABLE ATTACHMENT TO HYDRO POLE ONLY, INCLUDING:  
TENSIONING FOR CLEARANCES AND NEW CABLE LOADS



18 Automatic Road Suite 1C  
Brampton, Ontario L6S 5N5  
Telephone: (905) 799-8220



### CONSTRUCTION NOTES

- 1 OVERLASH 108.8m OF 1-48 COUNT FIBER OPTIC CABLE ON EXISTING ASSUMED 1/4" EHS HOT STRAND.
- 2 INSTALL 2187.3m OF NEW 1/4" EHS STRAND, LASH 1-48 COUNT FIBER OPTIC CABLE.
- 3 INSTALL 545.3m OF NEW 1/4" EHS STRAND, LASH 1-48 COUNT FIBER OPTIC CABLE.
- 4
- 5
- A INSTALL NEW NEUTRAL BOND AND GROUND ROD, AND WIRE.
- B INSTALL NEW 10.0m LOOPBACK.
- C INSTALL NEW DOWNGUY AND ANCHOR.
- D INSTALL NEW RISER C/W U-GUARD.
- E INSTALL NEW HYDRO ONE SPULCE ENCLOSURE.
- F INSTALL NEW 1/4" OVERHEAD GUY.

### SCOPE OF WORK

NEW OVERHEAD GUY	3=61.5m
NEW DOWNGUY AND ANCHOR	9
NEW 48 COUNT FIBER OPTIC CABLE	2896.2m
NEW OVERLASH	108.8m
NEW LASHWIRE	8524.2m
NEW 1/4" EHS STRAND	2732.6m
NEW CATV MAKE READY	3
NEW HOT MAKE READY	1
NEW BELL MAKE READY	12
NEW HYDRO MAKE READY	2
NEW RISER C/W U-GUARD	2
NEW SPULCE ENCLOSURE	1
NEW GROUND ROD AND WIRE	11=110.0m

NOTES:  
 INFORMATION WAS OBTAINED FROM DRAWINGS  
 REFERRED TO.  
 1. PHOTOGRAPHS OF PLAN AND PROFILE PROVIDED BY  
 THE CITY OF BRAMPTON AND REGION OF PEEL.

**HYDRO ONE TELECOM CONTACT**  
 IAN MITCHELL  
 HYDRO ONE TELECOM INC  
 45 KEELE STREET  
 SCARBOROUGH, ONTARIO M1V 5A3  
 PHONE: (416) 240-4370  
 FAX: (416) 240-4320  
 CELL: (416) 240-4370  
 EMAIL: ian.mitchell@hydroone.com

### ANCHOR SPECIFICATIONS





ANCHOR TYPE	ANCHOR STRENGTH
SINGLE HELIX 8"	14000lbs
SINGLE HELIX 10"	20000lbs
SINGLE HELIX 12"	25000lbs
SINGLE HELIX 14"	31000lbs
TRIPLE HELIX, 8"-10"-12"	46000lbs

CALCULATION FOR REQUIRED STRENGTH OF ANCHOR IS BASED ON -20" WITH 0.5" OF ICE AND SOIL CLASS 4 (MEDIUM DENSE SANDY GRAVEL; VERY STIFF TO HARD SILTS AND CLAYS).

### GENERAL NOTES AERIAL DESIGN AND CONSTRUCTION

1. ALL CONSTRUCTION WORK SHALL BE IN CONFORMANCE WITH CANADIAN, PROVINCIAL AND ONTARIO HYDRO SERVICES COMPANY SAFETY REQUIREMENTS. THESE INCLUDES WITHOUT LIMITATION:
  - OHS WORK PROTECTION CODE
  - OCCUPATIONAL HEALTH AND SAFETY ACT
  - THIS DESIGN CONFORMS TO CSA STANDARD C22.3 NO. 1-06.
2. TAKE THE NECESSARY PRECAUTIONS TO PROTECT THE EXISTING INSTALLATION FROM DAMAGE. THE CONTRACTOR WILL BE RESPONSIBLE FOR ALL THE CLAIMS DUE TO DAMAGE.
3. ALL REVISIONS MUST BE MADE PRIOR TO CONSTRUCTION.
4. ALL BOLTS MUST PROVIDE FOR 25mm OF EXPOSED THREAD.
5. ASSUME SOIL CONDITIONS AT ANCHOR POINT ARE AS FOLLOWS:
  - MEDIUM DENSE SANDY GRAVEL; VERY STIFF TO HARD SILTS AND CLAYS.
6. THE CONTRACTOR SHALL CHECK AND VERIFY ALL SITE CONDITIONS, CLEARANCES AND DIMENSIONS AT THE SITE AND REPORT ANY DISCREPANCIES TO THE ENGINEER BEFORE PROCEEDING WITH WORK.
7. SAGS & CLEARANCES ARE CHECKED AND CALCULATED FOR NEW ATTACHMENTS ONLY.
8. POLES NOT CHECKED FOR OVERALL LOADING. ADDITIONAL APPLIED LOADS ARE SHOWN ON THIS DRAWING DUE TO NEW ATTACHMENTS ONLY.
9. THE CONTRACTOR SHALL ENSURE THAT THE COMMUNICATION STRAND OR MESSENGER IS BONDED TO THE DISTRIBUTION SYSTEM NEUTRAL AT EVERY DIP LOCATION & EVERY 300 METRES.
10. VISIT THE SITE TO CHECK ON AVAILABLE ACCESS, STORAGE AND WORKING AREAS. DETERMINE ANY INTERFERENCE WITH EXISTING SERVICES.
11. SPIRAL WRAP AND TAG ALL EXPOSED FIBER OPTIC CABLE, INCLUDING: DRIP LOOPS, ENDS OF LOOPBACKS & DIPS ABOVE U-GUARDS.
12. AERIAL STRAND SHALL BE 1/4" EHS STRAND, 7-WIRE ZINC COATED, OR 3/8" EHS STRAND, 7-WIRE ZINC COATED, UNLESS NOTED OTHERWISE.
13. LOCATIONS AND DETAILS SHOWN ON THIS DRAWING ARE BASED ON THE BEST INFORMATION AVAILABLE AT TIME OF SURVEY. CONFIRM ALL LOCATIONS, CLEARANCES, AND INTERFERENCES ON SITE PRIOR TO BEGINNING WORK.
14. POLES WERE NOT VERIFIED FOR DECAY, OR DEFICIENCIES DUE TO THE INSTALLATION OF EXISTING ATTACHMENTS.
15. CONTRACTOR TO CONTACT THE ENGINEER IF THE HYDRO LINE ABOVE THE NEW ATTACHMENT HAS A SAG LARGER THAN 1000mm OR IF THE VOLTAGE IS HIGHER THAN 750V.
16. MAKE GOOD ALL EXISTING FINISHES WHEN WORK IS COMPLETE.
17. THE POSITION OF POLE LINES, CONDUITS, WATERMANS, SEWERS AND OTHER UNDERGROUND AND ABOVE GROUND UTILITIES AND STRUCTURES ARE NOT NECESSARILY SHOWN ON THE CONTRACT DRAWINGS, AND WHERE SHOWN, THE ACCURACY OF THE POSITION OF SUCH UTILITIES AND STRUCTURES IS NOT GUARANTEED. BEFORE STARTING WORK, THE CONTRACTOR SHALL CONFIRM THE EXACT LOCATION OF ALL SUCH UTILITIES AND STRUCTURES, AND SHALL ASSUME ALL LIABILITY FOR DAMAGE TO THEM.
18. ALL THE MATERIAL AND EQUIPMENT TO BE ESA AND CSA APPROVED.
19. CONTRACTOR TO USE DOWNGUY SPLITTERS AS REQUIRED IN ORDER TO AVOID CONTACT WITH POWER LINES.
20. ANALYSIS WAS PERFORMED USING THE DETERMINISTIC METHOD ASSUMING THAT THE HIGHEST VOLTAGE OF ANY OF THE EXISTING SUPPLY LINES IS LESS THAN 70 KV PHASE TO PHASE.
21. WHERE EXISTING COMMUNICATIONS ATTACHMENTS ARE SHOWN TO BE RELOCATED, THE THIRD PARTY OWNER OF THE ATTACHMENT MUST BE CONTACTED TO REVIEW AND ENSURE MINIMUM CLEARANCES ARE MAINTAINED IN ACCORDANCE WITH APPLICABLE STANDARDS.

RECORD OF INSPECTION BY CONSTRUCTOR	
AS CONSTRUCTED	<input type="checkbox"/> Aerial Installation
	<input type="checkbox"/> U/G Installation
With changes shown on this Drawing	
Attachment Owner	Permit #
	Date
Company Name	
Print Name	
Position	
Signature	
<input type="checkbox"/> This is to certify that the construction as recorded in this drawing is consistent with the approved plan, Standard Designs, or work instruction and that approved equipment has been used.	

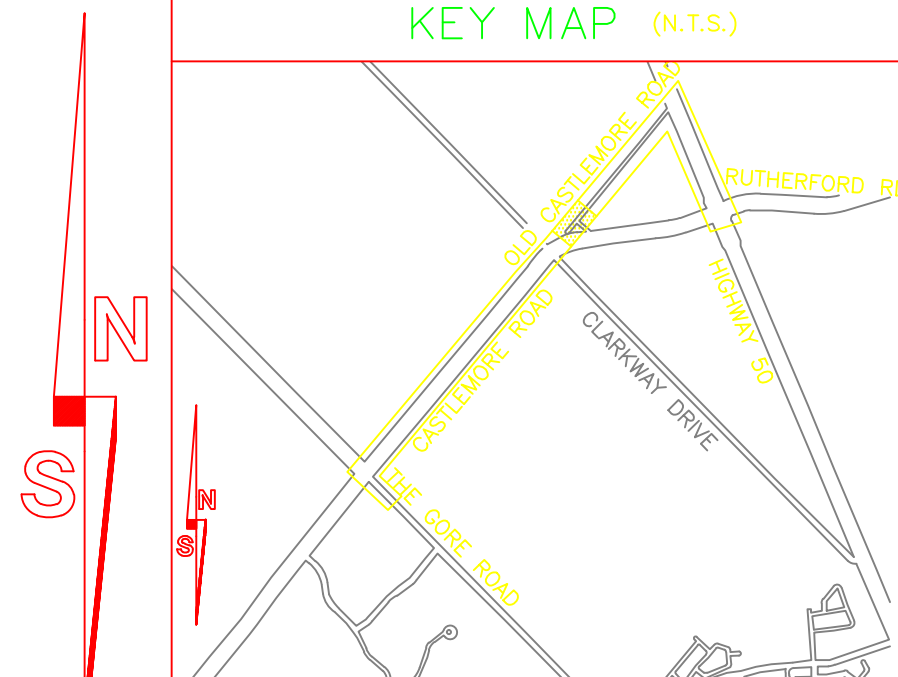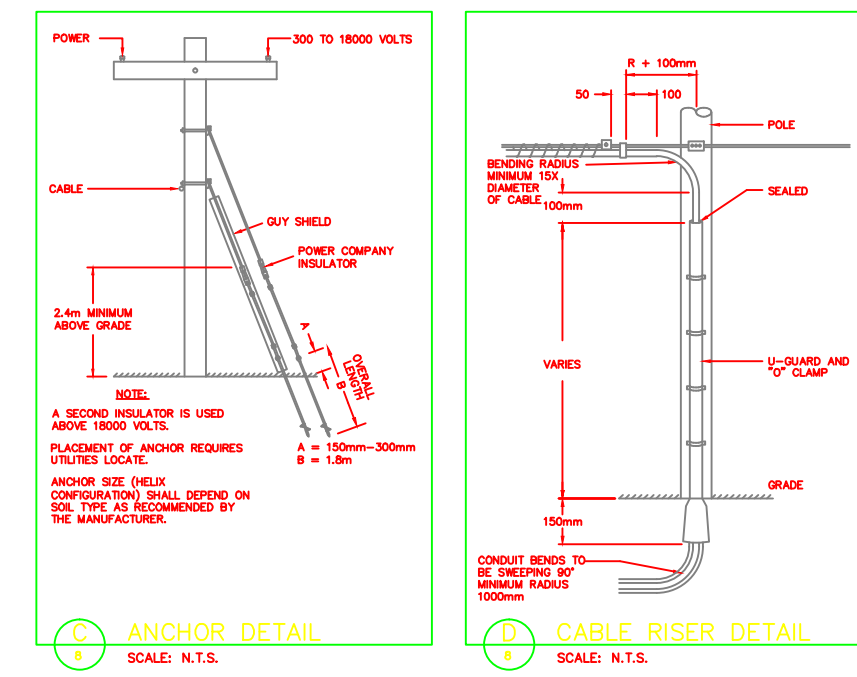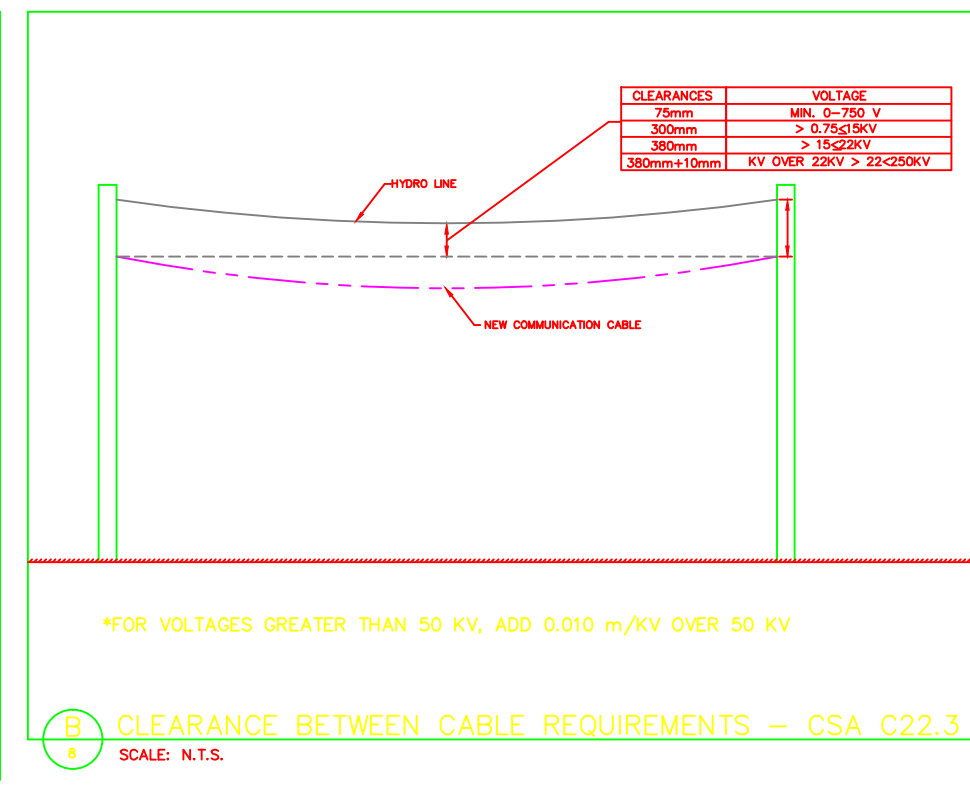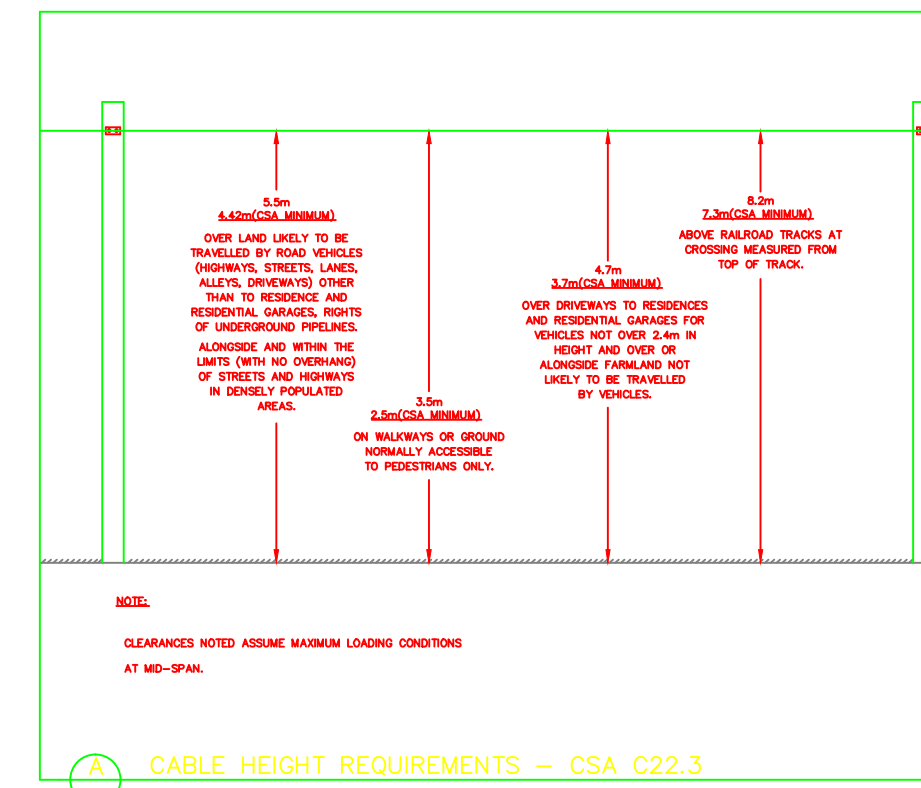


### HYDRO ONE TELECOM ATTACHMENT CERTIFICATE

THIS IS TO CERTIFY THAT THE CONSTRUCTION AS RECORDED IN THIS DRAWING MEETS THE APPLICABLE REQUIREMENTS OF THE SAFETY STANDARDS IN PART 4 OF REGULATION 22/04.

NAME \_\_\_\_\_ DATE \_\_\_\_\_

SIGNATURE & PROFESSIONAL DESIGNATION \_\_\_\_\_

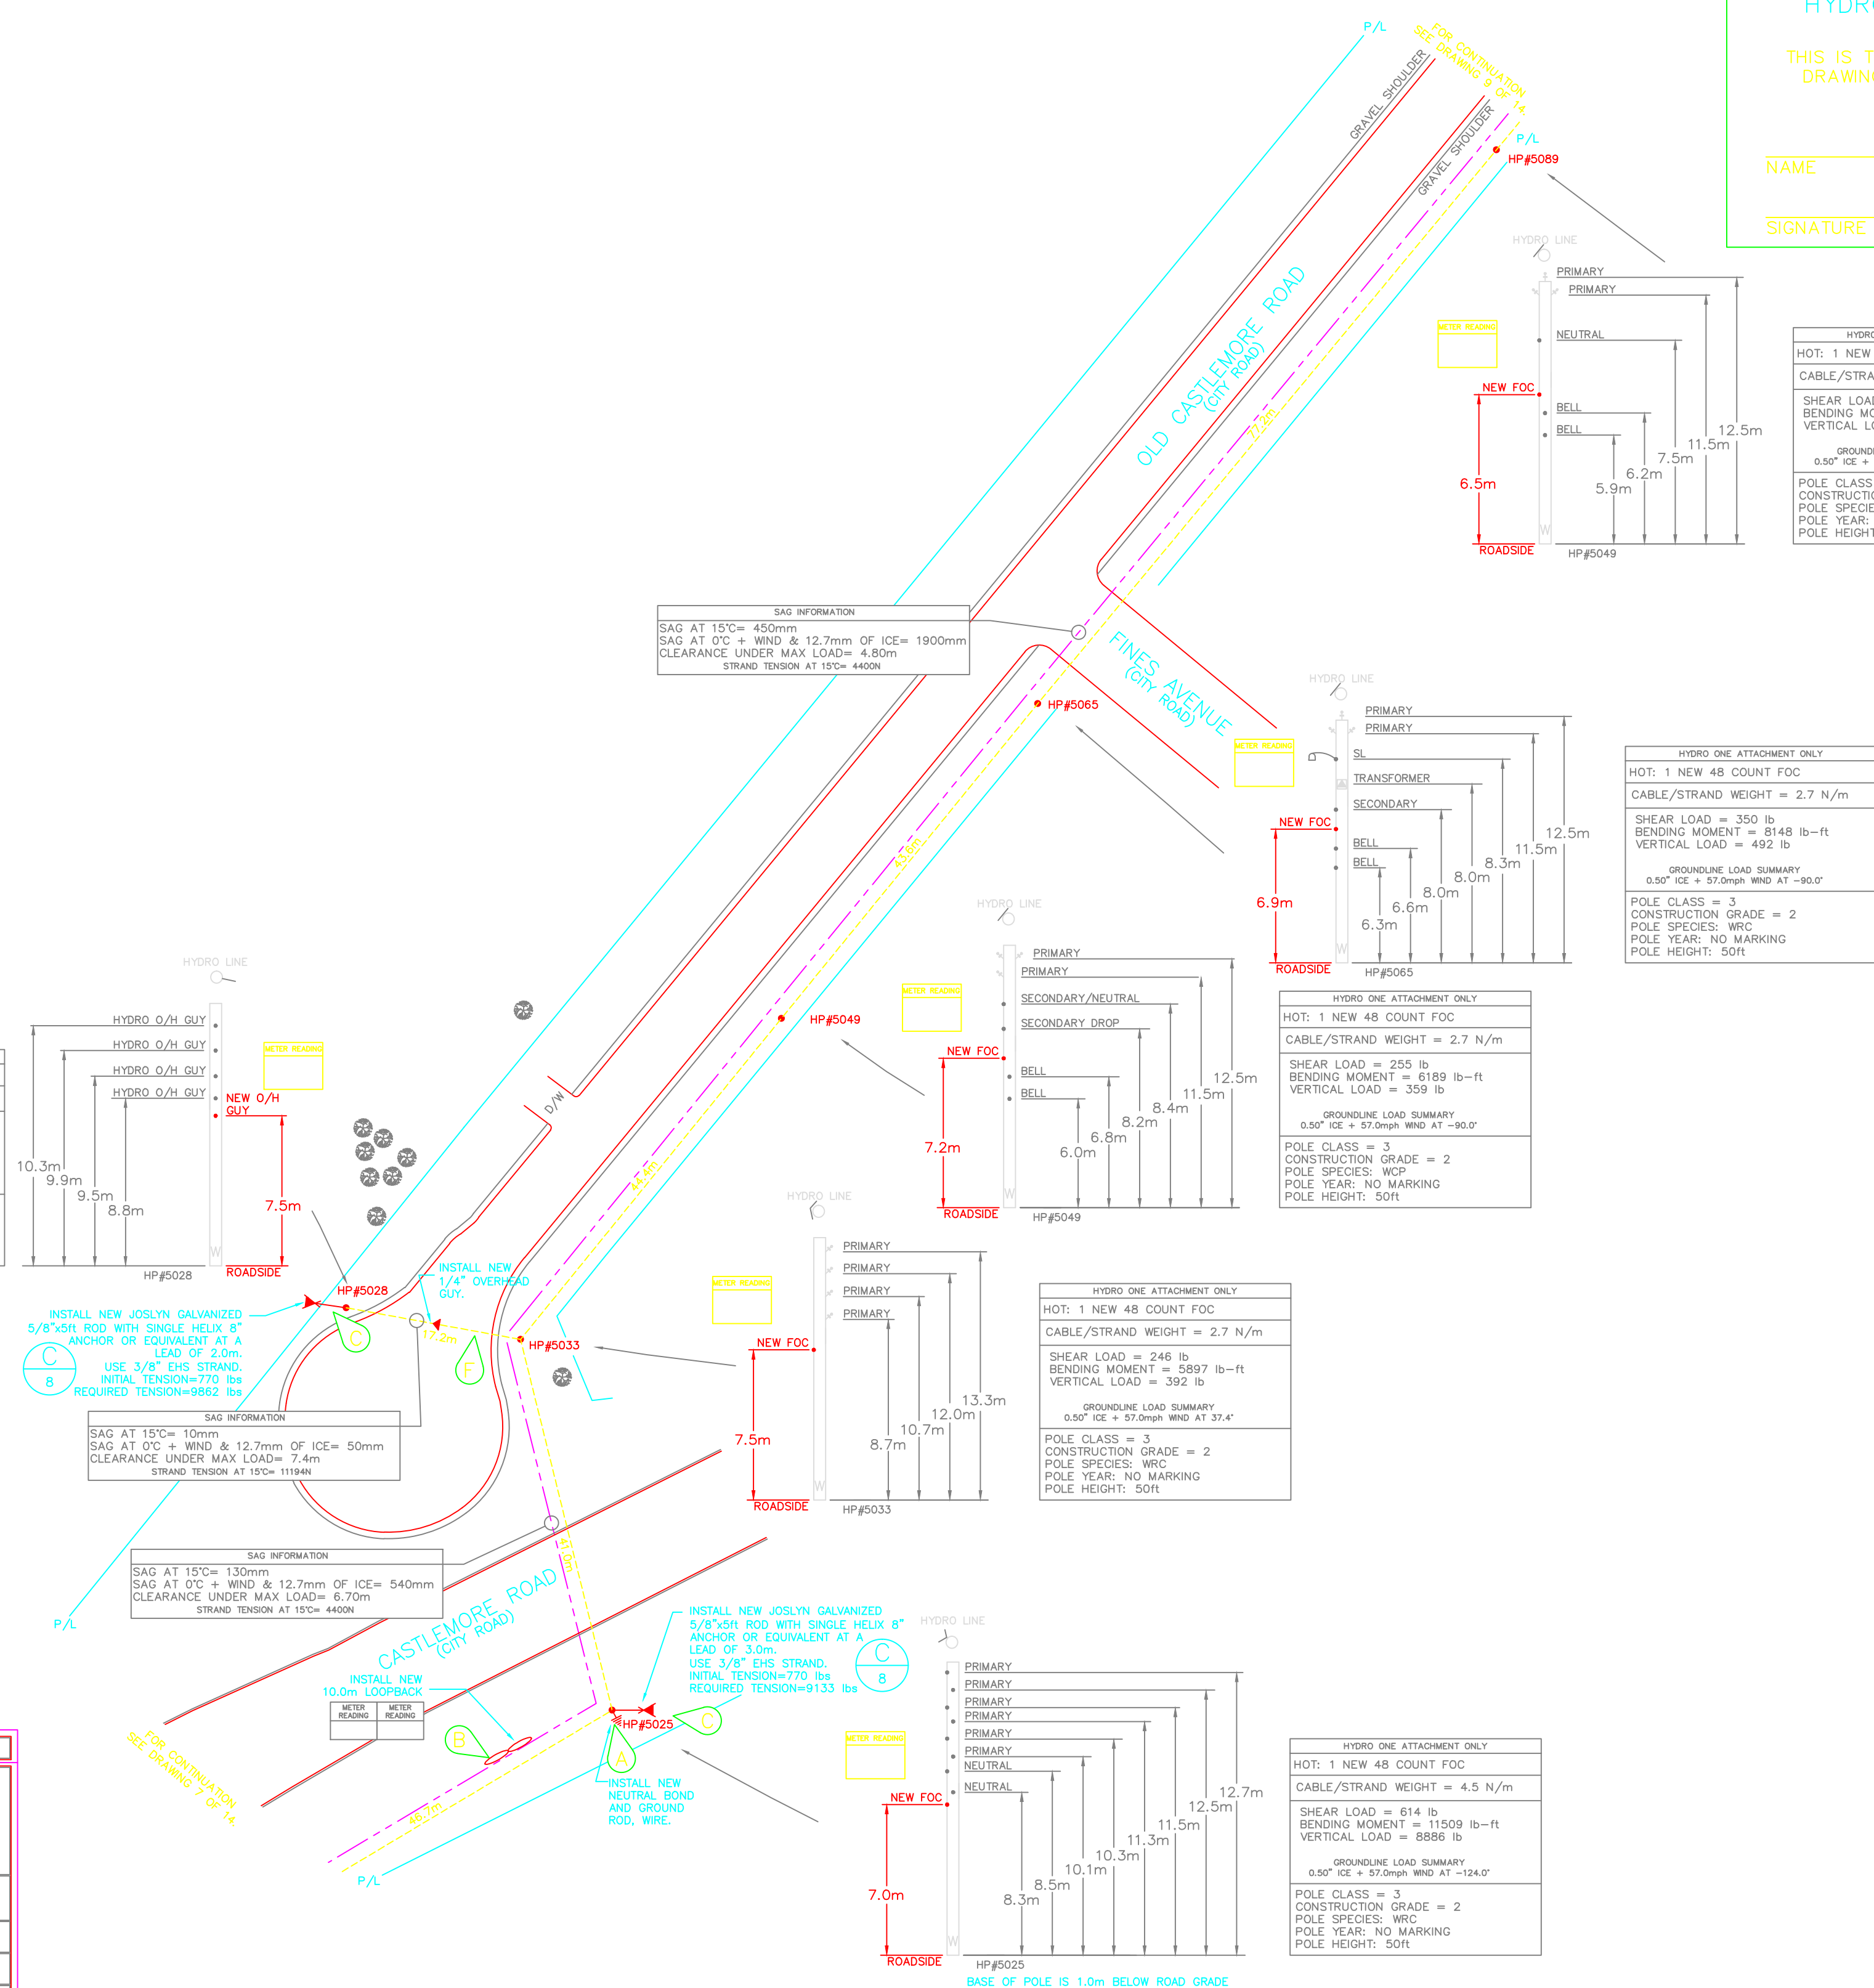

LICENSED PROFESSIONAL ENGINEER  
 J.M. QUINTERO (R4426)  
 100079833  
 Province of Ontario

FOR NEW CABLE ATTACHMENT TO HYDRO POLE ONLY, INCLUDING:  
 TENSIONING FOR CLEARANCES AND NEW CABLE LOADS

**MAGNATE**  
 ENGINEERING AND ASSOCIATES INC.  
 18 Automatic Road Suite 1C  
 Brampton, Ontario L6S 5N5  
 Telephone: (905) 799-8220

### CERTIFICATE OF APPROVAL

THE NEW INSTALLATION WORK COVERED BY THIS DOCUMENT MEETS THE SAFETY REQUIREMENTS OF SECTION 4 OF REGULATION 22/04, WITH CONSIDERATIONS OF THE FOLLOWING:

THE DESIGN CONFORMS TO CSA 22.3 NO 1-06 FOR HYDRO ONE TELECOM CLEARANCE, SEPARATION, GUYING AND STRAND TENSION. IT IS NOT INTENDED TO VERIFY THE INTEGRITY OF ATTACHMENTS, ANCHORING OR STRAND TENSIONS OF OTHERS, OR POLE STRENGTH.

POLES WERE NOT INVESTIGATED FOR DEFECTS/ROT.

NAME: \_\_\_\_\_ DATE: \_\_\_\_\_

SIGNATURE OF APPROVAL: \_\_\_\_\_

### REFERENCE DRAWINGS

CITY OF BRAMPTON

### LEGEND

NEW FIBER	
NEW STRAND	
OVERLASH	
EXISTING CONDUIT	
UNDERGROUND GAS LINE	
UNDERGROUND WATER	
UNDERGROUND HYDRO	
UNDERGROUND BELL	
UNDERGROUND CATV	
STORM SEWER	
SANITARY SEWER	
PROPERTY LINE	
FENCE	
DITCH	
EDGE OF PAVEMENT	
CURB	
GRAVEL SHOULDER	
NEW SPULCE	
EXISTING SPULCE	
VAULT	
BELL PEDESTAL	
CATV PEDESTAL	
TRANSFORMER	
CATCH BASIN	
WATER VALVE	
FIRE HYDRANT	
EXISTING POLE TO BE REMOVED	
STREET SIGN	
HYDRO POLE	
MANHOLE COVER	
MANHOLE & COVER	
LARGE ROCK	
TREE	
DIP LOCATION	
NEW DOWNGUY AND ANCHOR	
NEW SIDEWALK GUY	
NEW INTERIOR FIBER	
NEW BACKBOARD	
EXISTING BACKBOARD	
NEW PATCH PANEL	
EXISTING PATCH PANEL	
NEW EQUIPMENT RACK	
EXISTING EQUIPMENT RACK	
NEW FIBER COIL	

FIBER I.D.# (BTN)-(CABLE I.D.)-(FIBRE COUNT)

THESE DRAWINGS ARE COPYRIGHT AND THE PROPERTY OF MAGNATE ENGINEERING AND ASSOCIATES INC. REPRODUCTION OF THESE DRAWINGS WITHOUT THE CONSENT OF MAGNATE ENGINEERING AND ASSOCIATES INC. IS STRICTLY PROHIBITED. DO NOT SCALE THESE DRAWINGS. ANY ERRORS OR DISCREPANCY IS TO BE REPORTED IMMEDIATELY TO MAGNATE ENGINEERING AND ASSOCIATES INC.

DATE	REVISION	BY
05/20/2009	ISSUED FOR PERMIT	YC

**hydro one**  
 Hydro One Telecommunications

Hydro One Telecom Inc.  
 45 Keele Street  
 Toronto, Ontario M3J 5A3

**MAGNATE**  
 ENGINEERING AND ASSOCIATES INC.  
 18 Automatic Road, Suite 1C  
 Brampton, Ontario L6S 5N5  
 Telephone: (905) 799-8220

CASTLEMORE RD - THE GORE RD TO HWY 50  
 CITY OF BRAMPTON

PROJECT #	CONTRACTOR #	SCALE
9H005007P		1:500

APPROVED BY: \_\_\_\_\_ DATE: 05/20/09  
 DWG 8 OF 14

DRAWING NUMBER: \_\_\_\_\_

### CONSTRUCTION NOTES

- 1 OVERLASH 108.8m OF 1-48 COUNT FIBER OPTIC CABLE ON EXISTING ASSUMED 1/4" EHS HOT STRAND.
- 2 INSTALL 2187.3m OF NEW 1/4" EHS STRAND, LASH 1-48 COUNT FIBER OPTIC CABLE.
- 3 INSTALL 545.3m OF NEW 1/4" EHS STRAND, LASH 1-48 COUNT FIBER OPTIC CABLE.
- 4
- 5
- A INSTALL NEW NEUTRAL BOND AND GROUND ROD, AND WIRE.
- B INSTALL NEW 10.0m LOOPBACK.
- C INSTALL NEW DOWNGUY AND ANCHOR.
- D INSTALL NEW RISER C/W U-GUARD.
- E INSTALL NEW HYDRO ONE SPULSE ENCLOSURE.
- F INSTALL NEW 1/4" OVERHEAD GUY.

### SCOPE OF WORK

NEW OVERHEAD GUY	3=61.5m
NEW DOWNGUY AND ANCHOR	9
NEW 48 COUNT FIBER OPTIC CABLE	2896.2m
NEW OVERLASH	108.8m
NEW LASHWIRE	8524.2m
NEW 1/4" EHS STRAND	2732.6m
NEW CATV MAKE READY	3
NEW HOT MAKE READY	1
NEW BELL MAKE READY	12
NEW HYDRO MAKE READY	2
NEW RISER C/W U-GUARD	2
NEW SPULSE ENCLOSURE	1
NEW GROUND ROD AND WIRE	11=110.0m

NOTE: INFORMATION WAS OBTAINED FROM DRAWINGS SUPPLIED BY:  
1. PHOTOGRAPHS OF PLAN AND PROFILE PROVIDED BY THE CITY OF BRAMPTON AND REGION OF PEEL.

**HYDRO ONE TELECOM CONTACT**  
IAN MITCHELL  
HYDRO ONE TELECOM INC  
65 KEELEF STREET  
SCARBOROUGH, ONTARIO M1V 5A3  
PHONE: (416) 240-4370  
FAX: (416) 240-4370  
CELL: (416) 240-4370  
EMAIL: ian.mitchell@hydroone.com

### ANCHOR SPECIFICATIONS




ANCHOR TYPE	ANCHOR STRENGTH
SINGLE HELIX 8"	14000lbs
SINGLE HELIX 10"	20000lbs
SINGLE HELIX 12"	25000lbs
SINGLE HELIX 14"	31000lbs
TRIPLE HELIX, 8"-10"-12"	46000lbs

CALCULATION FOR REQUIRED STRENGTH OF ANCHOR IS BASED ON -20" WITH 0.5" OF ICE AND SOIL CLASS 4 (MEDIUM DENSE SANDY GRAVEL; VERY STIFF TO HARD SILTS AND CLAYS).

### GENERAL NOTES AERIAL DESIGN AND CONSTRUCTION

1. ALL CONSTRUCTION WORK SHALL BE IN CONFORMANCE WITH CANADIAN, PROVINCIAL AND ONTARIO HYDRO SERVICES COMPANY SAFETY REQUIREMENTS. THESE INCLUDES WITHOUT LIMITATION:  
- OHSC WORK PROTECTION CODE  
- OCCUPATIONAL HEALTH AND SAFETY ACT  
- THIS DESIGN CONFORMS TO CSA STANDARD C22.3 NO. 1-06.
2. TAKE THE NECESSARY PRECAUTIONS TO PROTECT THE EXISTING INSTALLATION FROM DAMAGE. THE CONTRACTOR WILL BE RESPONSIBLE FOR ALL THE CLAIMS DUE TO DAMAGE.
3. ALL REVISIONS MUST BE MADE PRIOR TO CONSTRUCTION.
4. ALL BOLTS MUST PROVIDE FOR 25mm OF EXPOSED THREAD.
5. ASSUME SOIL CONDITIONS AT ANCHOR POINT ARE AS FOLLOWS:  
- MEDIUM DENSE SANDY GRAVEL; VERY STIFF TO HARD SILTS AND CLAYS.
6. THE CONTRACTOR SHALL CHECK AND VERIFY ALL SITE CONDITIONS, CLEARANCES AND DIMENSIONS AT THE SITE AND REPORT ANY DISCREPANCIES TO THE ENGINEER BEFORE PROCEEDING WITH WORK.
7. SAGS & CLEARANCES ARE CHECKED AND CALCULATED FOR NEW ATTACHMENTS ONLY.
8. POLES NOT CHECKED FOR OVERALL LOADING. ADDITIONAL APPLIED LOADS ARE SHOWN ON THIS DRAWING DUE TO NEW ATTACHMENTS ONLY.
9. THE CONTRACTOR SHALL ENSURE THAT THE COMMUNICATION STRAND OR MESSENGER IS BONDED TO THE DISTRIBUTION SYSTEM NEUTRAL AT EVERY DIP LOCATION & EVERY 300 METRES.
10. VISIT THE SITE TO CHECK ON AVAILABLE ACCESS, STORAGE AND WORKING AREAS. DETERMINE ANY INTERFERENCE WITH EXISTING SERVICES.
11. SPIRAL WRAP AND TAG ALL EXPOSED FIBER OPTIC CABLE, INCLUDING: DRIP LOOPS, ENDS OF LOOPBACKS & DIPS ABOVE U-GUARDS.
12. AERIAL STRAND SHALL BE 1/4" EHS STRAND, 7-WIRE ZINC COATED, OR 3/8" EHS STRAND, 7-WIRE ZINC COATED, UNLESS NOTED OTHERWISE.
13. LOCATIONS AND DETAILS SHOWN ON THIS DRAWING ARE BASED ON THE BEST INFORMATION AVAILABLE AT TIME OF SURVEY. CONFIRM ALL LOCATIONS, CLEARANCES, AND INTERFERENCES ON SITE PRIOR TO BEGINNING WORK.
14. POLES WERE NOT VERIFIED FOR DECAY, OR DEFICIENCIES DUE TO THE INSTALLATION OF EXISTING ATTACHMENTS.
15. CONTRACTOR TO CONTACT THE ENGINEER IF THE HYDRO LINE ABOVE THE NEW ATTACHMENT HAS A SAG LARGER THAN 1000mm OR IF THE VOLTAGE IS HIGHER THAN 750V.
16. MAKE GOOD ALL EXISTING FINISHES WHEN WORK IS COMPLETE.
17. THE POSITION OF POLE LINES, CONDUITS, WATERMANS, SEWERS AND OTHER UNDERGROUND AND ABOVE GROUND UTILITIES AND STRUCTURES ARE NOT NECESSARILY SHOWN ON THE CONTRACT DRAWINGS, AND WHERE SHOWN, THE ACCURACY OF THE POSITION OF SUCH UTILITIES AND STRUCTURES IS NOT GUARANTEED. BEFORE STARTING WORK, THE CONTRACTOR SHALL CONFIRM THE EXACT LOCATION OF ALL SUCH UTILITIES AND STRUCTURES, AND SHALL ASSUME ALL LIABILITY FOR DAMAGE TO THEM.
18. ALL THE MATERIAL AND EQUIPMENT TO BE ESA AND CSA APPROVED.
19. CONTRACTOR TO USE DOWNGUY SPLITTERS AS REQUIRED IN ORDER TO AVOID CONTACT WITH POWER LINES.
20. ANALYSIS WAS PERFORMED USING THE DETERMINISTIC METHOD ASSUMING THAT THE HIGHEST VOLTAGE OF ANY OF THE EXISTING SUPPLY LINES IS LESS THAN 70 KV PHASE TO PHASE.
21. WHERE EXISTING COMMUNICATIONS ATTACHMENTS ARE SHOWN TO BE RELOCATED, THE THIRD PARTY OWNER OF THE ATTACHMENT MUST BE CONTACTED TO REVIEW AND ENSURE MINIMUM CLEARANCES ARE MAINTAINED IN ACCORDANCE WITH APPLICABLE STANDARDS.

RECORD OF INSPECTION BY CONSTRUCTOR		
AS CONSTRUCTED		
<input type="checkbox"/> Aerial Installation		
<input type="checkbox"/> U/G Installation		
With changes shown on this Drawing		
Attachment Owner	Permit #	Date
Company Name		
Print Name		
Position		
Signature		
<input type="checkbox"/> This is to certify that the construction as recorded in this drawing is consistent with the approved plan, Standard Designs, or work instruction and that approved equipment has been used.		

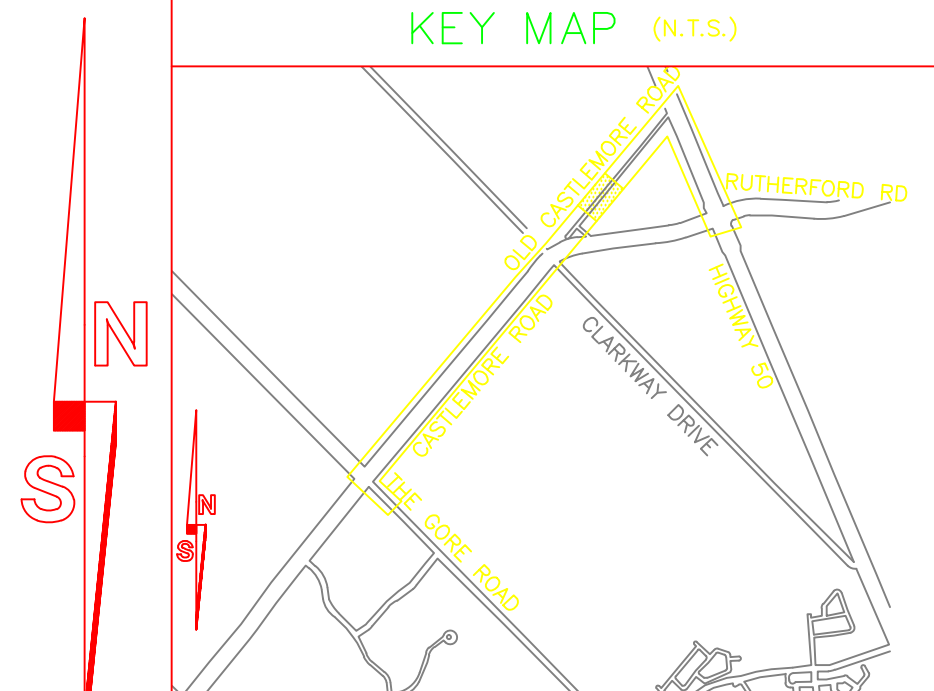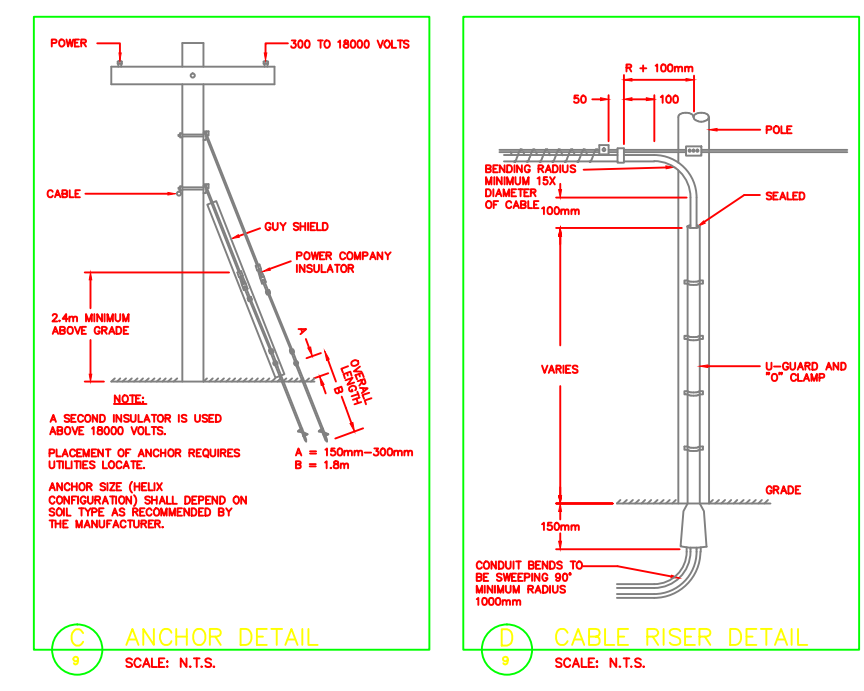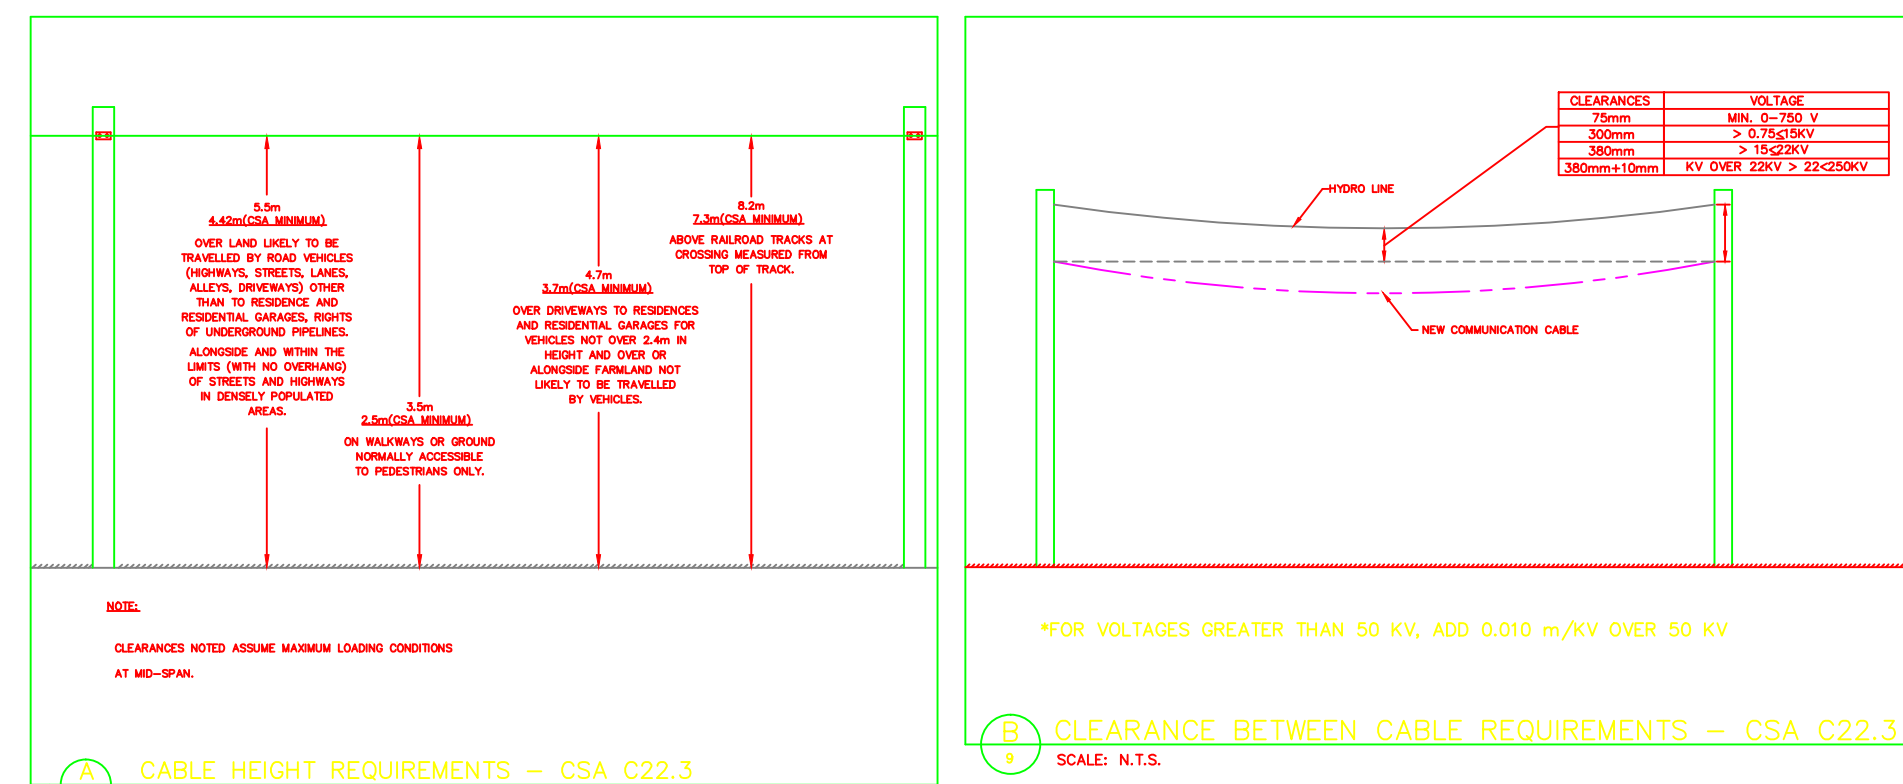


### HYDRO ONE TELECOM ATTACHMENT CERTIFICATE

THIS IS TO CERTIFY THAT THE CONSTRUCTION AS RECORDED IN THIS DRAWING MEETS THE APPLICABLE REQUIREMENTS OF THE SAFETY STANDARDS IN PART 4 OF REGULATION 22/04.

NAME \_\_\_\_\_ DATE \_\_\_\_\_

SIGNATURE & PROFESSIONAL DESIGNATION \_\_\_\_\_

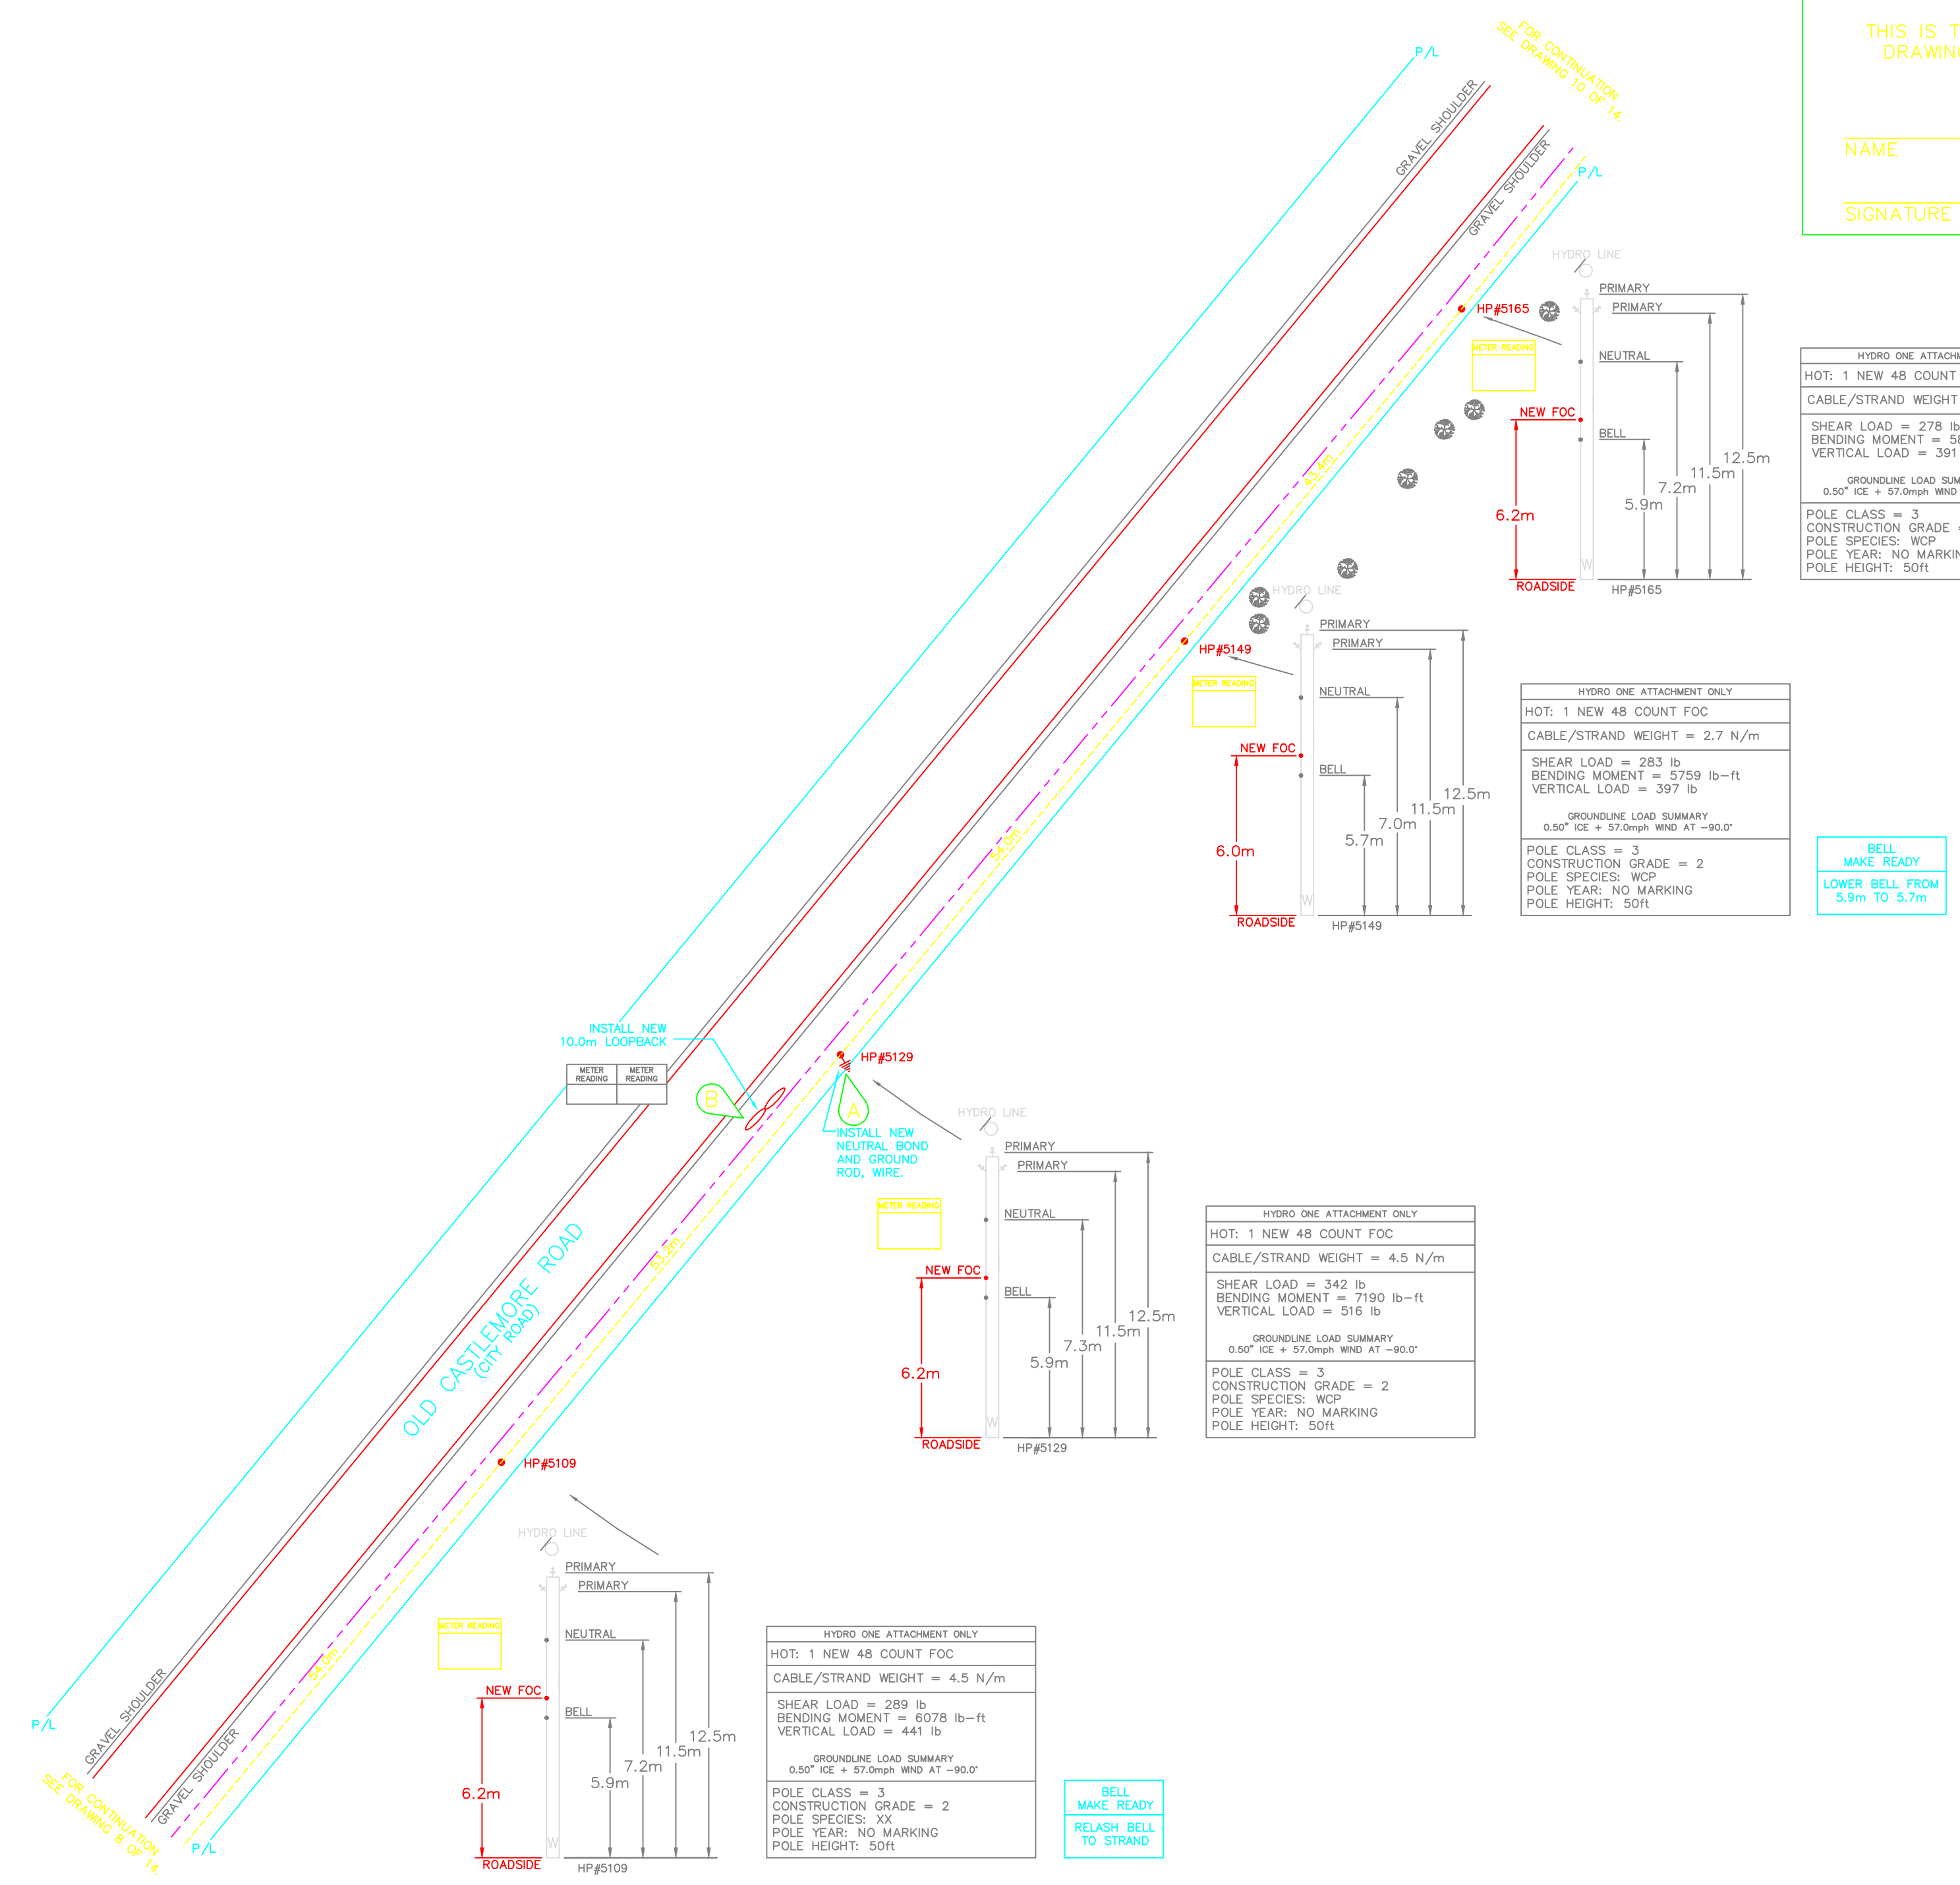

FOR NEW CABLE ATTACHMENT TO HYDRO POLE ONLY, INCLUDING:  
TENSIONING FOR CLEARANCES AND NEW CABLE LOADS



18 Automatic Road Suite 1C  
Brampton, Ontario L6S 5N5  
Telephone: (905) 799-8220

### CERTIFICATE OF APPROVAL

THE NEW INSTALLATION WORK COVERED BY THIS DOCUMENT MEETS THE SAFETY REQUIREMENTS OF SECTION 4 OF REGULATION 22/04, WITH CONSIDERATIONS OF THE FOLLOWING:

THE DESIGN CONFORMS TO CSA 22.3 NO 1-06 FOR HYDRO ONE TELECOM CLEARANCE, SEPARATION, GUYING AND STRAND TENSION. IT IS NOT INTENDED TO VERIFY THE INTEGRITY OF ATTACHMENTS, ANCHORING OR STRAND TENSIONS OF OTHERS, OR POLE STRENGTH.

POLES WERE NOT INVESTIGATED FOR DEFECTS/ROT.

NAME: \_\_\_\_\_ DATE: \_\_\_\_\_

SIGNATURE OF APPROVAL: \_\_\_\_\_

### REFERENCE DRAWINGS

CITY OF BRAMPTON

### LEGEND

NEW FIBER	
NEW STRAND	
OVERLASH	
EXISTING CONDUIT	
UNDERGROUND GAS LINE	
UNDERGROUND WATER	
UNDERGROUND HYDRO	
UNDERGROUND BELL	
UNDERGROUND CATV	
STORM SEWER	
SANITARY SEWER	
PROPERTY LINE	
FENCE	
DITCH	
EDGE OF PAVEMENT	
CURB	
GRAVEL SHOULDER	
NEW SPLICE	
EXISTING SPLICE	
VAULT	
BELL PEDESTAL	
CATV PEDESTAL	
TRANSFORMER	
CATCH BASIN	
WATER VALVE	
FIRE HYDRANT	
EXISTING POLE TO BE REMOVED	
STREET SIGN	
HYDRO POLE	
MANHOLE COVER	
MANHOLE & COVER	
LARGE ROCK	
TREE	
DIP LOCATION	
NEW DOWNGUY AND ANCHOR	
NEW SIDEWALK GUY	
NEW INTERIOR FIBER	
NEW BACKBOARD	
EXISTING BACKBOARD	
NEW PATCH PANEL	
EXISTING PATCH PANEL	
NEW EQUIPMENT RACK	
EXISTING EQUIPMENT RACK	
NEW FIBER COIL	

FIBER I.D.# (CABLE I.D.)-(FIBRE COUNT)

THESE DRAWINGS ARE COPYRIGHT AND THE PROPERTY OF MAGNATE ENGINEERING AND ASSOCIATES INC. REPRODUCTION OF THESE DRAWINGS WITHOUT THE CONSENT OF MAGNATE ENGINEERING AND ASSOCIATES INC. IS STRICTLY PROHIBITED. DO NOT SCALE THESE DRAWINGS, ANY ERRORS, OR DISCREPANCY IS TO BE REPORTED IMMEDIATELY TO MAGNATE ENGINEERING AND ASSOCIATES INC.

DATE	REVISION	BY
05/20/2009	ISSUED FOR PERMIT	YC

**hydro one**  
Hydro One Telecommunications

**MAGNATE**  
ENGINEERING AND ASSOCIATES INC.  
18 Automatic Road, Suite 1C  
Brampton, Ontario L6S 5N5  
Telephone: (905) 799-8220

CASTLEMORE RD - THE GORE RD TO HWY 50  
CITY OF BRAMPTON

PROJECT #	CONTRACTOR #	SCALE:
	9H005007P	1:500

APPROVED BY:	DATE:	DWG	OF
	05/20/09	9	14

DRAWING NUMBER:

### CONSTRUCTION NOTES

- 1 OVERLASH 108.8m OF 1-48 COUNT FIBER OPTIC CABLE ON EXISTING ASSUMED 1/4" EHS HOT STRAND.
- 2 INSTALL 2187.3m OF NEW 1/4" EHS STRAND, LASH 1-48 COUNT FIBER OPTIC CABLE.
- 3 INSTALL 545.3m OF NEW 1/4" EHS STRAND, LASH 1-48 COUNT FIBER OPTIC CABLE.
- 4
- 5
- A INSTALL NEW NEUTRAL BOND AND GROUND ROD, AND WIRE.
- B INSTALL NEW 10.0m LOOPBACK.
- C INSTALL NEW DOWNGUY AND ANCHOR.
- D INSTALL NEW RISER C/W U-GUARD.
- E INSTALL NEW HYDRO ONE SPlice ENCLOSURE.
- F INSTALL NEW 1/4" OVERHEAD GUY.

### SCOPE OF WORK

NEW OVERHEAD GUY	3=61.5m
NEW DOWNGUY AND ANCHOR	9
NEW 48 COUNT FIBER OPTIC CABLE	2896.2m
NEW OVERLASH	108.8m
NEW LASHWIRE	8524.2m
NEW 1/4" EHS STRAND	2732.6m
NEW CATV MAKE READY	3
NEW HOT MAKE READY	1
NEW BELL MAKE READY	12
NEW HYDRO MAKE READY	2
NEW RISER C/W U-GUARD	2
NEW SPlice ENCLOSURE	1
NEW GROUND ROD AND WIRE	11=110.0m

NOTE: INFORMATION WAS OBTAINED FROM DRAWINGS SUPPLIED BY:  
1. PHOTOGRAPHS OF PLAN AND PROFILE PROVIDED BY THE CITY OF BRAMPTON AND REGION OF PEEL.

**HYDRO ONE TELECOM CONTACT**  
IAN MITCHELL  
HYDRO ONE TELECOM INC  
65 KEELE STREET  
SCARBOROUGH, ONTARIO M1V 5A3  
PHONE: (416) 249-4370  
FAX: (416) 249-4370  
CELL: (416) 249-4370  
EMAIL: ian.mitchell@hydroone.com

### ANCHOR SPECIFICATIONS




ANCHOR TYPE	ANCHOR STRENGTH
SINGLE HELIX 8"	14000lbs
SINGLE HELIX 10"	20000lbs
SINGLE HELIX 12"	25000lbs
SINGLE HELIX 14"	31000lbs
TRIPLE HELIX, 8"-10"-12"	46000lbs

CALCULATION FOR REQUIRED STRENGTH OF ANCHOR IS BASED ON -20" WITH 0.5" OF ICE AND SOIL CLASS 4 (MEDIUM DENSE SANDY GRAVEL; VERY STIFF TO HARD SILTS AND CLAYS).

### GENERAL NOTES AERIAL DESIGN AND CONSTRUCTION

- ALL CONSTRUCTION WORK SHALL BE IN CONFORMANCE WITH CANADIAN, PROVINCIAL AND ONTARIO HYDRO SERVICES COMPANY SAFETY REQUIREMENTS. THESE INCLUDE: WITHOUT LIMITATION:
  - OHSC WORK PROTECTION CODE
  - OCCUPATIONAL HEALTH AND SAFETY ACT
  - THIS DESIGN CONFORMS TO CSA STANDARD C22.3 NO. 1-06.
- TAKE THE NECESSARY PRECAUTIONS TO PROTECT THE EXISTING INSTALLATION FROM DAMAGE. THE CONTRACTOR WILL BE RESPONSIBLE FOR ALL THE CLAIMS DUE TO DAMAGE.
- ALL REVISIONS MUST BE MADE PRIOR TO CONSTRUCTION.
- ALL BOLTS MUST PROVIDE FOR 25mm OF EXPOSED THREAD.
- ASSUME SOIL CONDITIONS AT ANCHOR POINT ARE AS FOLLOWS:
  - MEDIUM DENSE SANDY GRAVEL; VERY STIFF TO HARD SILTS AND CLAYS.
- THE CONTRACTOR SHALL CHECK AND VERIFY ALL SITE CONDITIONS, CLEARANCES AND DIMENSIONS AT THE SITE AND REPORT ANY DISCREPANCIES TO THE ENGINEER BEFORE PROCEEDING WITH WORK.
- SAGS & CLEARANCES ARE CHECKED AND CALCULATED FOR NEW ATTACHMENTS ONLY.
- POLES NOT CHECKED FOR OVERALL LOADING. ADDITIONAL APPLIED LOADS ARE SHOWN ON THIS DRAWING DUE TO NEW ATTACHMENTS ONLY.
- THE CONTRACTOR SHALL ENSURE THAT THE COMMUNICATION STRAND OR MESSENGER IS BONDED TO THE DISTRIBUTION SYSTEM NEUTRAL AT EVERY DIP LOCATION & EVERY 300 METRES.
- VISIT THE SITE TO CHECK ON AVAILABLE ACCESS, STORAGE AND WORKING AREAS. DETERMINE ANY INTERFERENCE WITH EXISTING SERVICES.
- SPIRAL WRAP AND TAG ALL EXPOSED FIBER OPTIC CABLE, INCLUDING: DRIP LOOPS, ENDS OF LOOPBACKS & DIPS ABOVE U-GUARDS.
- AERIAL STRAND SHALL BE 1/4" EHS STRAND, 7-WIRE ZINC COATED, OR 3/8" EHS STRAND, 7-WIRE ZINC COATED, UNLESS NOTED OTHERWISE.
- LOCATIONS AND DETAILS SHOWN ON THIS DRAWING ARE BASED ON THE BEST INFORMATION AVAILABLE AT TIME OF SURVEY. CONFIRM ALL LOCATIONS, CLEARANCES, AND INTERFERENCES ON SITE PRIOR TO BEGINNING WORK.
- POLES WERE NOT VERIFIED FOR DECAY, OR DEFICIENCIES DUE TO THE INSTALLATION OF EXISTING ATTACHMENTS.
- CONTRACTOR TO CONTACT THE ENGINEER IF THE HYDRO LINE ABOVE THE NEW ATTACHMENT HAS A SAG LARGER THAN 1000mm OR IF THE VOLTAGE IS HIGHER THAN 750V.
- MAKE GOOD ALL EXISTING FINISHES WHEN WORK IS COMPLETE.
- THE POSITION OF POLE LINES, CONDUITS, WATERMANS, SEWERS AND OTHER UNDERGROUND AND ABOVE GROUND UTILITIES AND STRUCTURES ARE NOT NECESSARILY SHOWN ON THE CONTRACT DRAWINGS, AND WHERE SHOWN, THE ACCURACY OF THE POSITION OF SUCH UTILITIES AND STRUCTURES IS NOT GUARANTEED. BEFORE STARTING WORK, THE CONTRACTOR SHALL CONFIRM THE EXACT LOCATION OF ALL SUCH UTILITIES AND STRUCTURES, AND SHALL ASSUME ALL LIABILITY FOR DAMAGE TO THEM.
- ALL THE MATERIAL AND EQUIPMENT TO BE ESA AND CSA APPROVED.
- CONTRACTOR TO USE DOWNGUY SPLITTERS AS REQUIRED IN ORDER TO AVOID CONTACT WITH POWER LINES.
- ANALYSIS WAS PERFORMED USING THE DETERMINISTIC METHOD ASSUMING THAT THE HIGHEST VOLTAGE OF ANY OF THE EXISTING SUPPLY LINES IS LESS THAN 70 KV PHASE TO PHASE.
- WHERE EXISTING COMMUNICATIONS ATTACHMENTS ARE SHOWN TO BE RELOCATED, THE THIRD PARTY OWNER OF THE ATTACHMENT MUST BE CONTACTED TO REVIEW AND ENSURE MINIMUM CLEARANCES ARE MAINTAINED IN ACCORDANCE WITH APPLICABLE STANDARDS.

RECORD OF INSPECTION BY CONTRACTOR		
AS CONSTRUCTED		
<input type="checkbox"/> Aerial Installation		
<input type="checkbox"/> U/G Installation		
With changes shown on this Drawing		
Attachment Owner	Permit #	Date
Company Name		
Print Name		
Position		
Signature		
<input type="checkbox"/> This is to certify that the construction as recorded in this drawing is consistent with the approved plan, Standard Designs, or work instruction and that approved equipment has been used.		

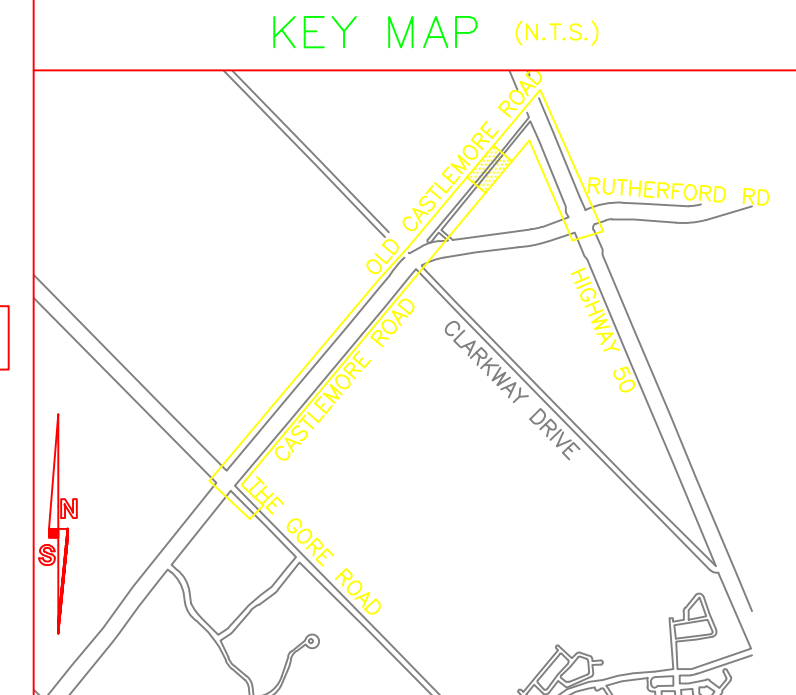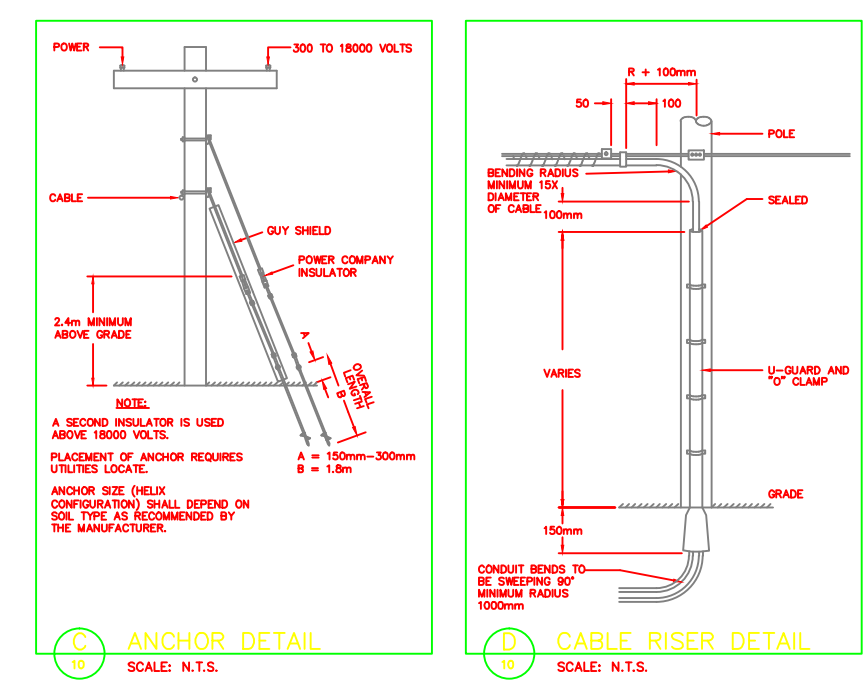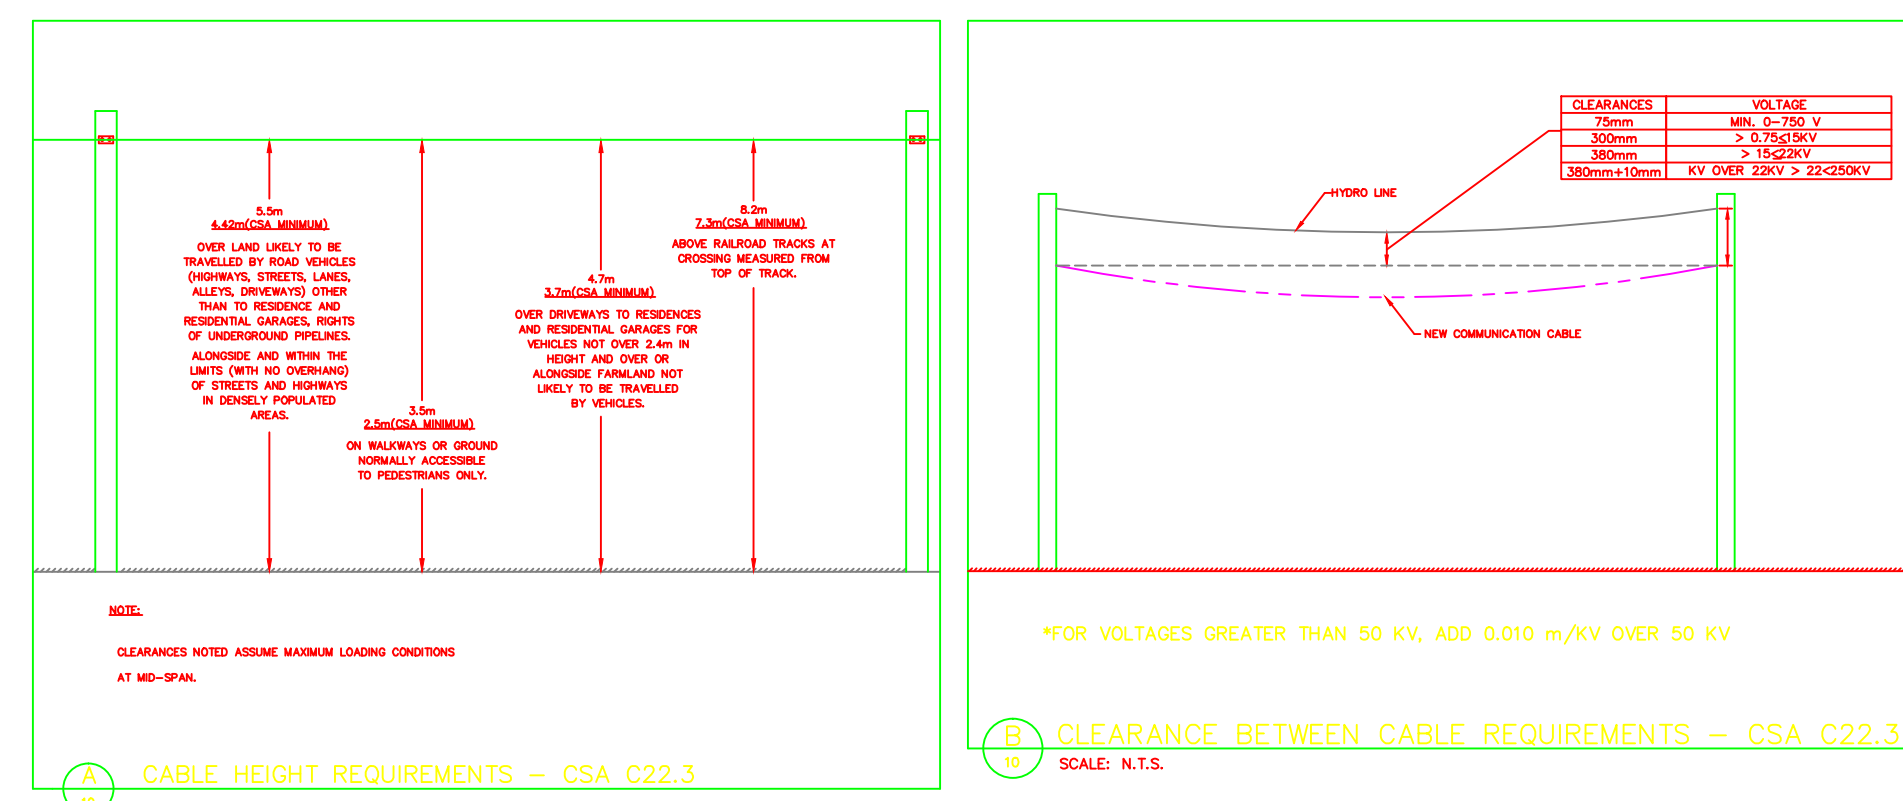


### HYDRO ONE TELECOM ATTACHMENT CERTIFICATE

THIS IS TO CERTIFY THAT THE CONSTRUCTION AS RECORDED IN THIS DRAWING MEETS THE APPLICABLE REQUIREMENTS OF THE SAFETY STANDARDS IN PART 4 OF REGULATION 22/04.

NAME: \_\_\_\_\_ DATE: \_\_\_\_\_

SIGNATURE & PROFESSIONAL DESIGNATION: \_\_\_\_\_

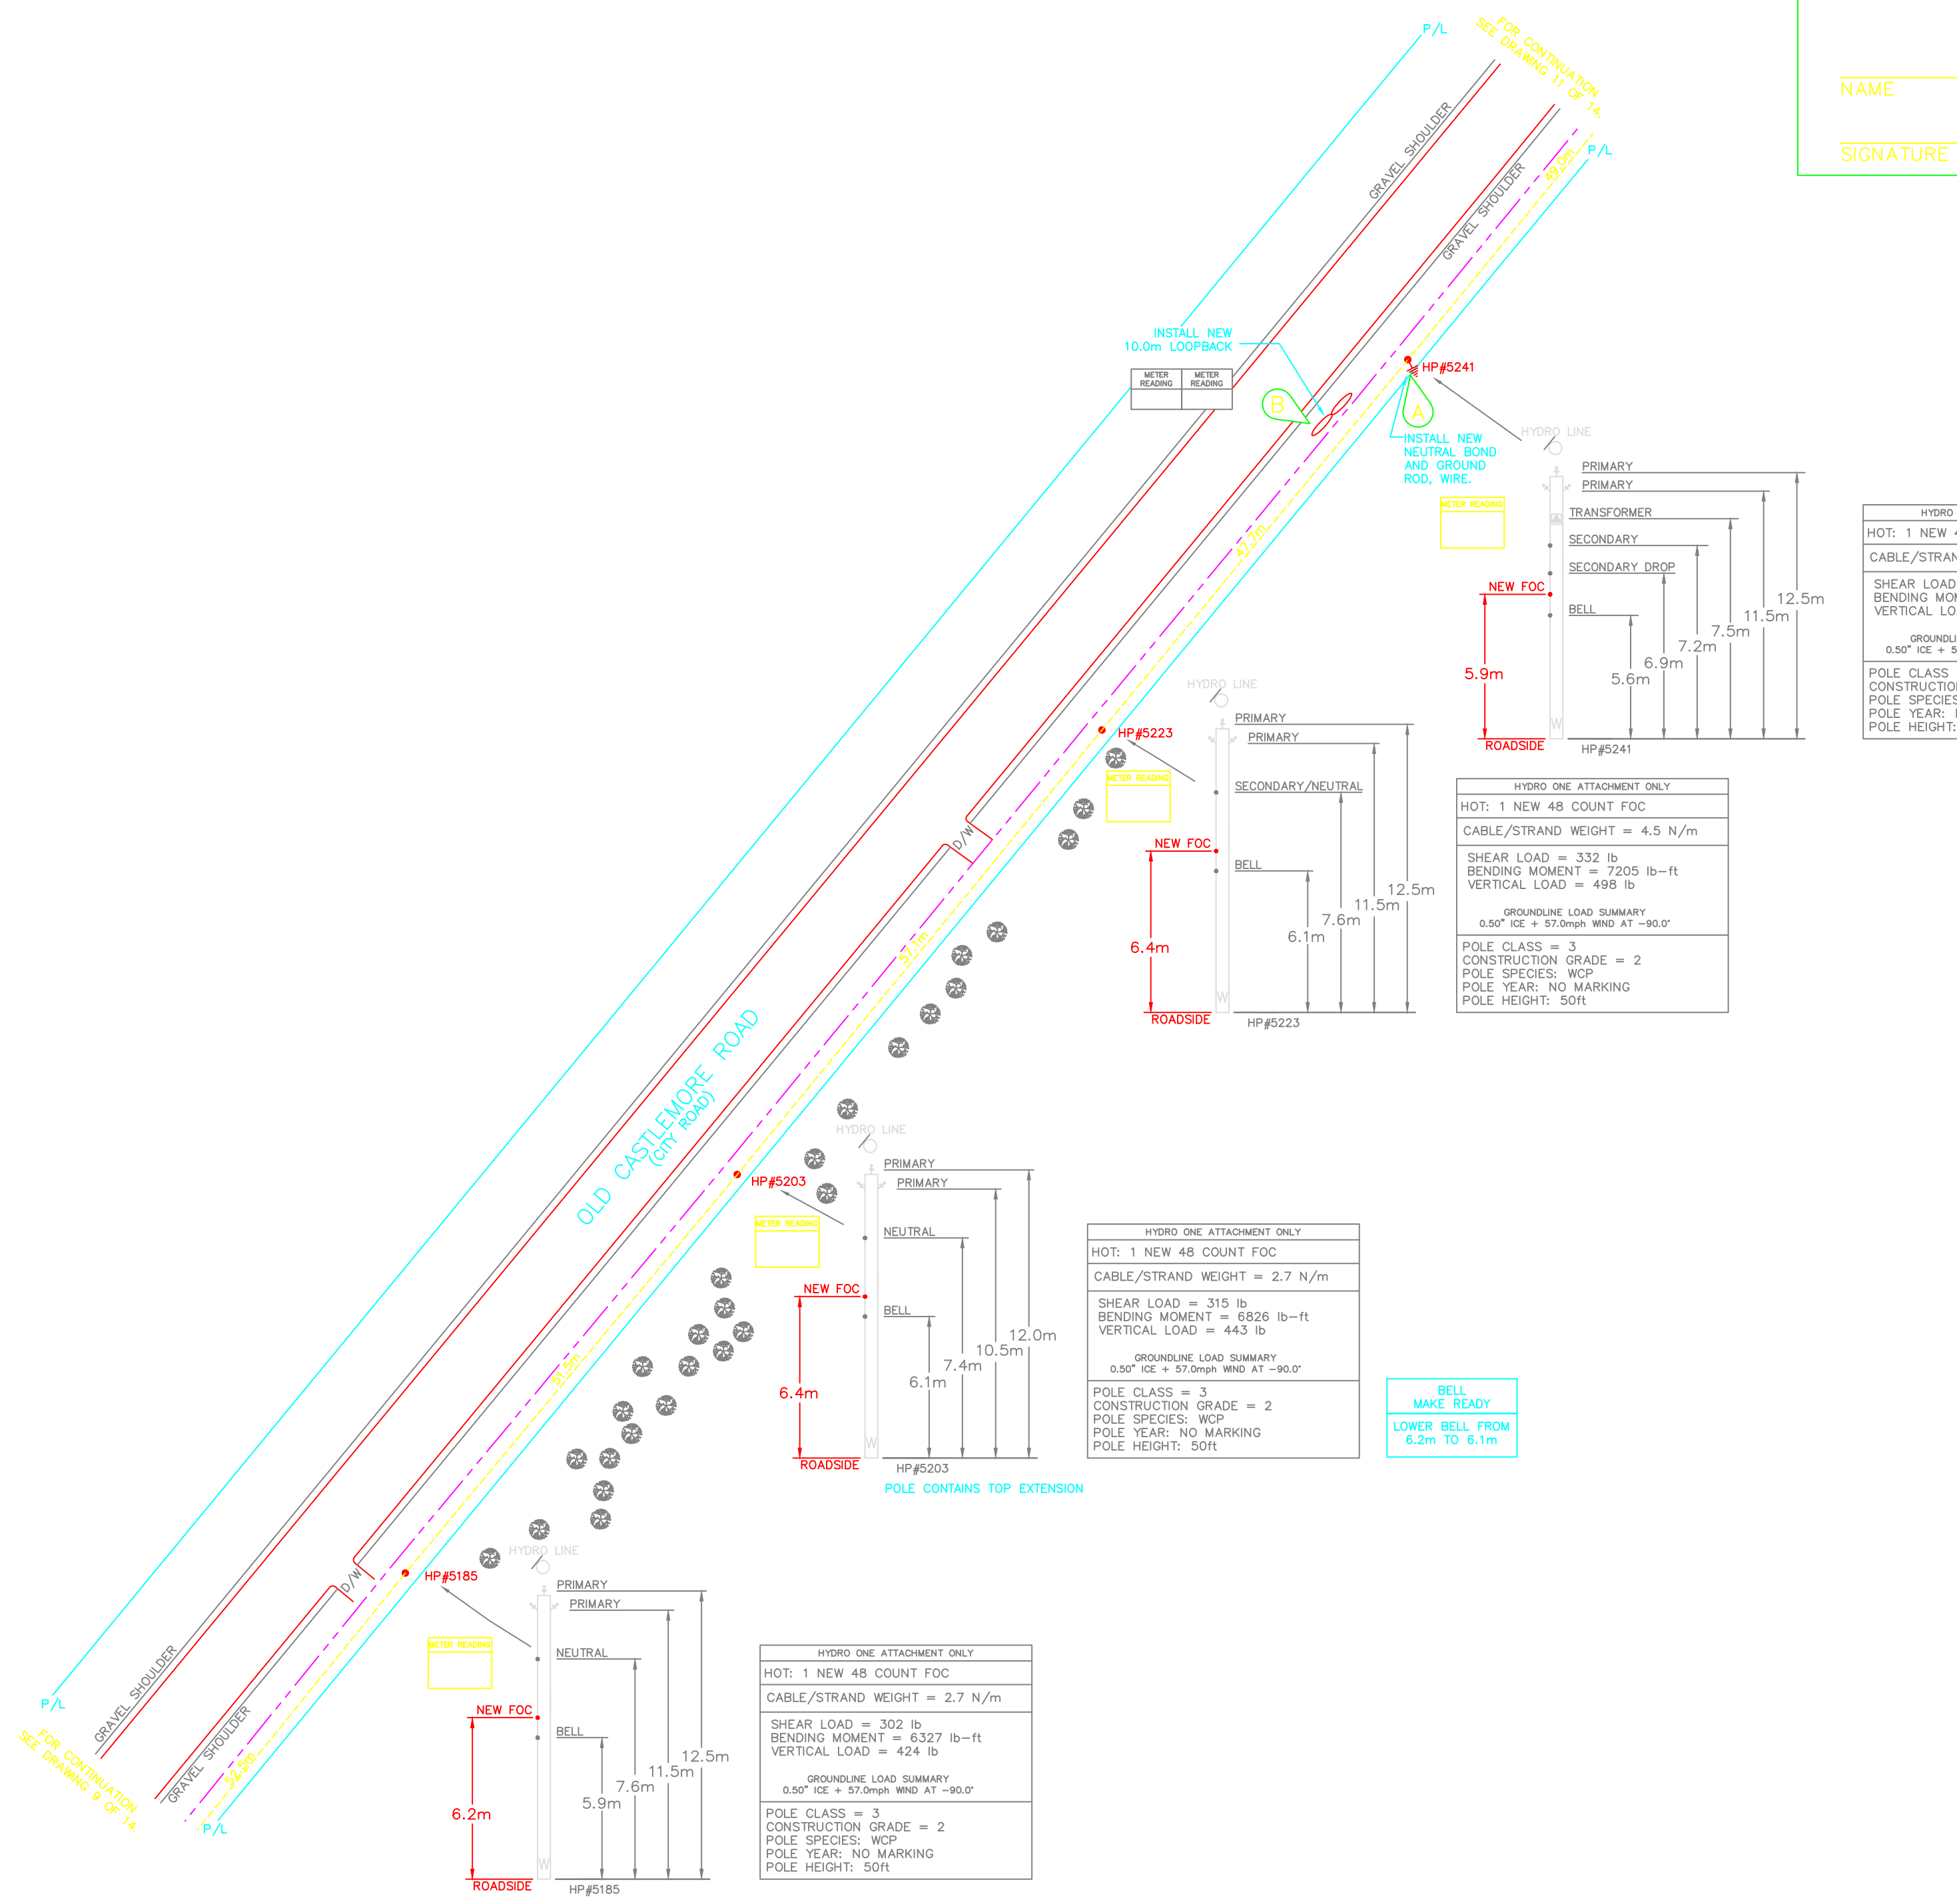

LICENSED PROFESSIONAL ENGINEER  
J.M. QUINTERO IRRATE  
100079653  
Province of Ontario

FOR NEW CABLE ATTACHMENT TO HYDRO POLE ONLY, INCLUDING:  
TENSIONING FOR CLEARANCES AND NEW CABLE LOADS

**MAGNATE**  
ENGINEERING AND ASSOCIATES INC.  
18 Automatic Road Suite 1C  
Brampton, Ontario L6S 5N5  
Telephone: (905) 799-8220

### CERTIFICATE OF APPROVAL

THE NEW INSTALLATION WORK COVERED BY THIS DOCUMENT MEETS THE SAFETY REQUIREMENTS OF SECTION 4 OF REGULATION 22/04, WITH CONSIDERATIONS OF THE FOLLOWING:

THE DESIGN CONFORMS TO CSA 22.3 NO 1-06 FOR HYDRO ONE TELECOM CLEARANCE, SEPARATION, GUYING AND STRAND TENSION. IT IS NOT INTENDED TO VERIFY THE INTEGRITY OF ATTACHMENTS, ANCHORING OR STRAND TENSIONS OF OTHERS, OR POLE STRENGTH.

POLES WERE NOT INVESTIGATED FOR DEFECTS/ROT.

NAME: \_\_\_\_\_ DATE: \_\_\_\_\_

SIGNATURE OF APPROVAL: \_\_\_\_\_

### REFERENCE DRAWINGS

CITY OF BRAMPTON

### LEGEND

NEW FIBER	
NEW STRAND	
OVERLASH	
EXISTING CONDUIT	
UNDERGROUND GAS LINE	
UNDERGROUND WATER	
UNDERGROUND HYDRO	
UNDERGROUND BELL	
UNDERGROUND CATV	
STORM SEWER	
SANITARY SEWER	
PROPERTY LINE	
FENCE	
DITCH	
EDGE OF PAVEMENT	
CURB	
GRAVEL SHOULDER	
NEW SPlice	
EXISTING SPlice	
VAULT	
BELL PEDESTAL	
CATV PEDESTAL	
TRANSFORMER	
CATCH BASIN	
WATER VALVE	
FIRE HYDRANT	
EXISTING POLE TO BE REMOVED	
STREET SIGN	
HYDRO POLE	
MANHOLE COVER	
MANHOLE & COVER	
LARGE ROCK	
TREE	
DIP LOCATION	
NEW DOWNGUY AND ANCHOR	
NEW SIDEWALK GUY	
NEW INTERIOR FIBER	
NEW BACKBOARD	
EXISTING BACKBOARD	
NEW PATCH PANEL	
EXISTING PATCH PANEL	
NEW EQUIPMENT RACK	
EXISTING EQUIPMENT RACK	
NEW FIBER COIL	

FIBER I.D.# BMTN-(CABLE I.D.)-(FIBRE COUNT)

THESE DRAWINGS ARE COPYRIGHT AND THE PROPERTY OF MAGNATE ENGINEERING AND ASSOCIATES INC. REPRODUCTION OF THESE DRAWINGS WITHOUT THE CONSENT OF MAGNATE ENGINEERING AND ASSOCIATES INC. IS STRICTLY PROHIBITED. DO NOT SCALE THESE DRAWINGS, ANY ERRORS, OR DISCREPANCY IS TO BE REPORTED IMMEDIATELY TO MAGNATE ENGINEERING AND ASSOCIATES INC.

DATE	REVISION	BY
05/20/2009	ISSUED FOR PERMIT	YC

**hydro one**  
Hydro One Telecommunications

Hydro One Telecom Inc.  
65 Keele Street  
Toronto, Ontario M3J 5A3

**MAGNATE**  
ENGINEERING AND ASSOCIATES INC.  
18 Automatic Road, Suite 1C  
Brampton, Ontario L6S 5N5  
Telephone: (905) 799-8220

CASTLEMORE RD - THE GORE RD TO HWY 50  
CITY OF BRAMPTON

PROJECT #	CONTRACTOR #	SCALE:
	9H005007P	1:500
APPROVED BY:	DATE:	DWG NO OF 14
	05/20/09	10 OF 14
DRAWING NUMBER:		

### CONSTRUCTION NOTES

- 1 OVERLASH 108.8m OF 1-48 COUNT FIBER OPTIC CABLE ON EXISTING ASSUMED 1/4" EHS HOT STRAND.
- 2 INSTALL 2187.3m OF NEW 1/4" EHS STRAND. LASH 1-48 COUNT FIBER OPTIC CABLE.
- 3 INSTALL 545.3m OF NEW 1/4" EHS STRAND. LASH 1-48 COUNT FIBER OPTIC CABLE.
- 4
- 5
- A INSTALL NEW NEUTRAL BOND AND GROUND ROD, AND WIRE.
- B INSTALL NEW 10.0m LOOPBACK.
- C INSTALL NEW DOWNGUY AND ANCHOR.
- D INSTALL NEW RISER C/W U-GUARD.
- E INSTALL NEW HYDRO ONE SPULCE ENCLOSURE.
- F INSTALL NEW 1/4" OVERHEAD GUY.

### SCOPE OF WORK

NEW OVERHEAD GUY	3=61.5m
NEW DOWNGUY AND ANCHOR	9
NEW 48 COUNT FIBER OPTIC CABLE	2896.2m
NEW OVERLASH	108.8m
NEW LASHWIRE	8524.2m
NEW 1/4" EHS STRAND	2732.6m
NEW CATV MAKE READY	3
NEW HOT MAKE READY	1
NEW BELL MAKE READY	12
NEW HYDRO MAKE READY	2
NEW RISER C/W U-GUARD	2
NEW SPULCE ENCLOSURE	1
NEW GROUND ROD AND WIRE	11=110.0m

NOTE: INFORMATION WAS OBTAINED FROM DRAWINGS SUPPLIED BY:  
1. PHOTOGRAPHS OF PLAN AND PROFILE PROVIDED BY THE CITY OF BRAMPTON AND REGION OF PEEL.

**HYDRO ONE TELECOM CONTACT**  
IAN MITCHELL  
HYDRO ONE TELECOM INC  
65 KEELEND STREET  
SCARBOROUGH, ONTARIO M1V 5A3  
PHONE: (416) 240-4370  
FAX: (416) 240-4300  
CELL: (416) 240-4370  
EMAIL: ian.mitchell@hydroone.com

### ANCHOR SPECIFICATIONS




ANCHOR TYPE	ANCHOR STRENGTH
SINGLE HELIX 8"	14000lbs
SINGLE HELIX 10"	20000lbs
SINGLE HELIX 12"	25000lbs
SINGLE HELIX 14"	31000lbs
TRIPLE HELIX, 8"-10"-12"	46000lbs

CALCULATION FOR REQUIRED STRENGTH OF ANCHOR IS BASED ON -20" WITH 0.5" OF ICE AND SOIL CLASS 4 (MEDIUM DENSE SANDY GRAVEL; VERY STIFF TO HARD SILTS AND CLAYS).

### GENERAL NOTES AERIAL DESIGN AND CONSTRUCTION

1. ALL CONSTRUCTION WORK SHALL BE IN CONFORMANCE WITH CANADIAN, PROVINCIAL AND ONTARIO HYDRO SERVICES COMPANY SAFETY REQUIREMENTS. THESE INCLUDES WITHOUT LIMITATION:
  - OHSC WORK PROTECTION CODE
  - OCCUPATIONAL HEALTH AND SAFETY ACT
  - THIS DESIGN CONFORMS TO CSA STANDARD C22.3 NO. 1-06.
2. TAKE THE NECESSARY PRECAUTIONS TO PROTECT THE EXISTING INSTALLATION FROM DAMAGE. THE CONTRACTOR WILL BE RESPONSIBLE FOR ALL THE CLAIMS DUE TO DAMAGE.
3. ALL REVISIONS MUST BE MADE PRIOR TO CONSTRUCTION.
4. ALL BOLTS MUST PROVIDE FOR 25mm OF EXPOSED THREAD.
5. ASSUME SOIL CONDITIONS AT ANCHOR POINT ARE AS FOLLOWS:
  - MEDIUM DENSE SANDY GRAVEL; VERY STIFF TO HARD SILTS AND CLAYS.
6. THE CONTRACTOR SHALL CHECK AND VERIFY ALL SITE CONDITIONS, CLEARANCES AND DIMENSIONS AT THE SITE AND REPORT ANY DISCREPANCIES TO THE ENGINEER BEFORE PROCEEDING WITH WORK.
7. SAGS & CLEARANCES ARE CHECKED AND CALCULATED FOR NEW ATTACHMENTS ONLY.
8. POLES NOT CHECKED FOR OVERALL LOADING. ADDITIONAL APPLIED LOADS ARE SHOWN ON THIS DRAWING DUE TO NEW ATTACHMENTS ONLY.
9. THE CONTRACTOR SHALL ENSURE THAT THE COMMUNICATION STRAND OR MESSENGER IS BONDED TO THE DISTRIBUTION SYSTEM NEUTRAL AT EVERY DIP LOCATION & EVERY 300 METRES.
10. VISIT THE SITE TO CHECK ON AVAILABLE ACCESS, STORAGE AND WORKING AREAS. DETERMINE ANY INTERFERENCE WITH EXISTING SERVICES.
11. SPIRAL WRAP AND TAG ALL EXPOSED FIBER OPTIC CABLE, INCLUDING: DRIP LOOPS, ENDS OF LOOPBACKS & DIPS ABOVE U-GUARDS.
12. AERIAL STRAND SHALL BE 1/4" EHS STRAND, 7-WIRE ZINC COATED, OR 3/8" EHS STRAND, 7-WIRE ZINC COATED, UNLESS NOTED OTHERWISE.
13. LOCATIONS AND DETAILS SHOWN ON THIS DRAWING ARE BASED ON THE BEST INFORMATION AVAILABLE AT TIME OF SURVEY. CONFIRM ALL LOCATIONS, CLEARANCES, AND INTERFERENCES ON SITE PRIOR TO BEGINNING WORK.
14. POLES WERE NOT VERIFIED FOR DECAY, OR DEFICIENCIES DUE TO THE INSTALLATION OF EXISTING ATTACHMENTS.
15. CONTRACTOR TO CONTACT THE ENGINEER IF THE HYDRO LINE ABOVE THE NEW ATTACHMENT HAS A SAG LARGER THAN 1000mm OR IF THE VOLTAGE IS HIGHER THAN 750V.
16. MAKE GOOD ALL EXISTING FINISHES WHEN WORK IS COMPLETE.
17. THE POSITION OF POLE LINES, CONDUITS, WATERMANS, SEWERS AND OTHER UNDERGROUND AND ABOVE GROUND UTILITIES AND STRUCTURES ARE NOT NECESSARILY SHOWN ON THE CONTRACT DRAWINGS, AND WHERE SHOWN, THE ACCURACY OF THE POSITION OF SUCH UTILITIES AND STRUCTURES IS NOT GUARANTEED. BEFORE STARTING WORK, THE CONTRACTOR SHALL CONFIRM THE EXACT LOCATION OF ALL SUCH UTILITIES AND STRUCTURES, AND SHALL ASSUME ALL LIABILITY FOR DAMAGE TO THEM.
18. ALL THE MATERIAL AND EQUIPMENT TO BE ESA AND CSA APPROVED.
19. CONTRACTOR TO USE DOWNGUY SPLITTERS AS REQUIRED IN ORDER TO AVOID CONTACT WITH POWER LINES.
20. ANALYSIS WAS PERFORMED USING THE DETERMINISTIC METHOD ASSUMING THAT THE HIGHEST VOLTAGE OF ANY OF THE EXISTING SUPPLY LINES IS LESS THAN 70 KV PHASE TO PHASE.
21. WHERE EXISTING COMMUNICATIONS ATTACHMENTS ARE SHOWN TO BE RELOCATED, THE THIRD PARTY OWNER OF THE ATTACHMENT MUST BE CONTACTED TO REVIEW AND ENSURE MINIMUM CLEARANCES ARE MAINTAINED IN ACCORDANCE WITH APPLICABLE STANDARDS.

RECORD OF INSPECTION BY CONSTRUCTOR	
AS CONSTRUCTED	<input type="checkbox"/> Aerial Installation
	<input type="checkbox"/> U/G Installation
With changes shown on this Drawing	
Attachment Owner	Permit #
	Date
	Company Name
	Print Name
	Position
	Signature
<input type="checkbox"/> This is to certify that the construction as recorded in this drawing is consistent with the approved plan, Standard Designs, or work instruction and that approved equipment has been used.	

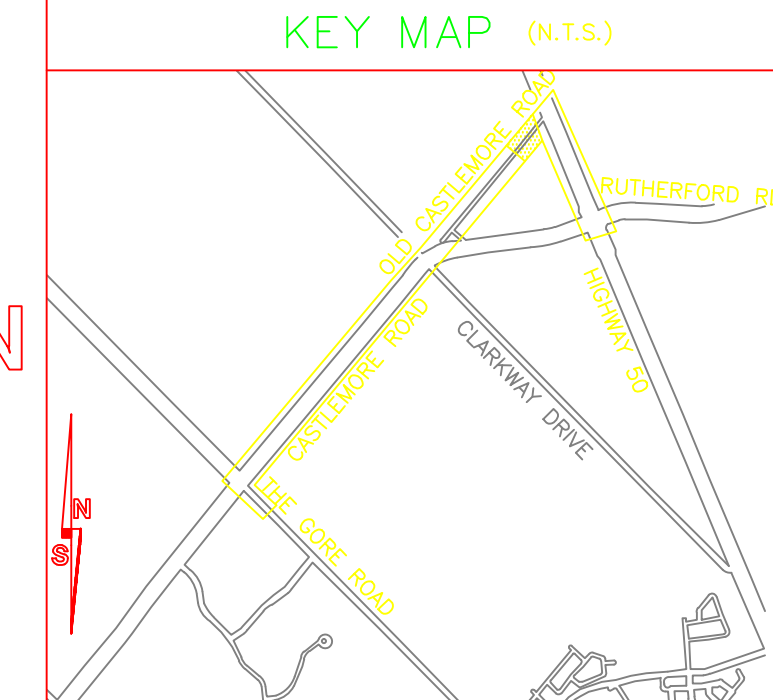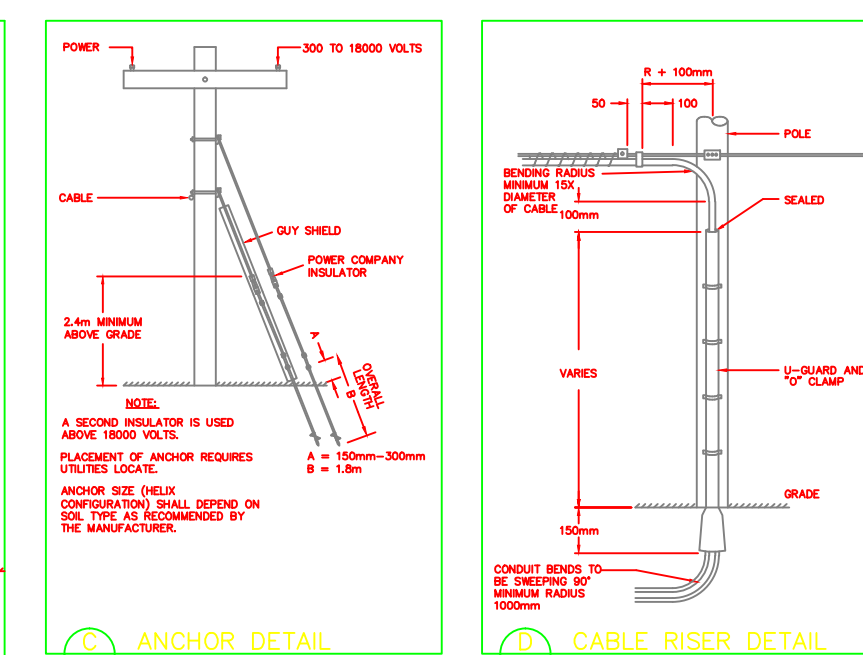
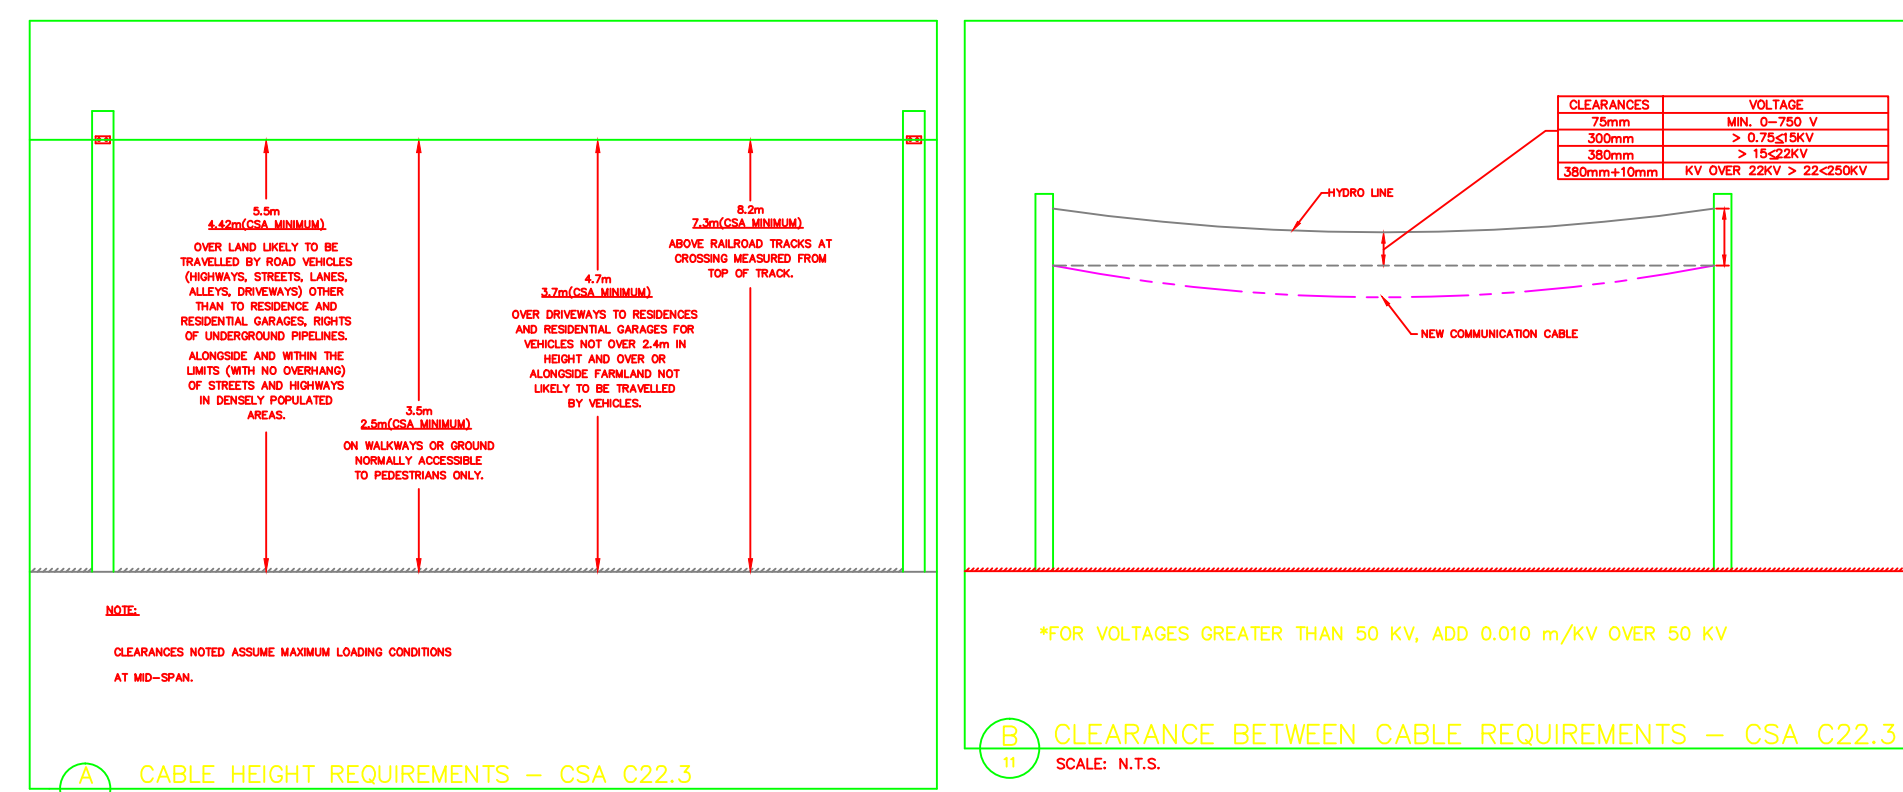


### HYDRO ONE TELECOM ATTACHMENT CERTIFICATE

THIS IS TO CERTIFY THAT THE CONSTRUCTION AS RECORDED IN THIS DRAWING MEETS THE APPLICABLE REQUIREMENTS OF THE SAFETY STANDARDS IN PART 4 OF REGULATION 22/04.

NAME \_\_\_\_\_ DATE \_\_\_\_\_

SIGNATURE & PROFESSIONAL DESIGNATION \_\_\_\_\_

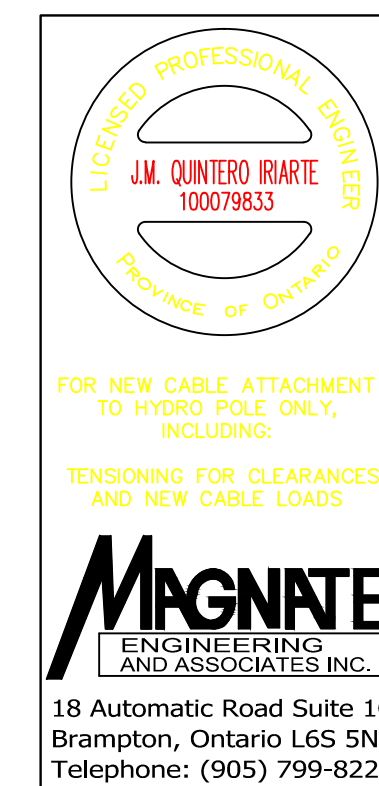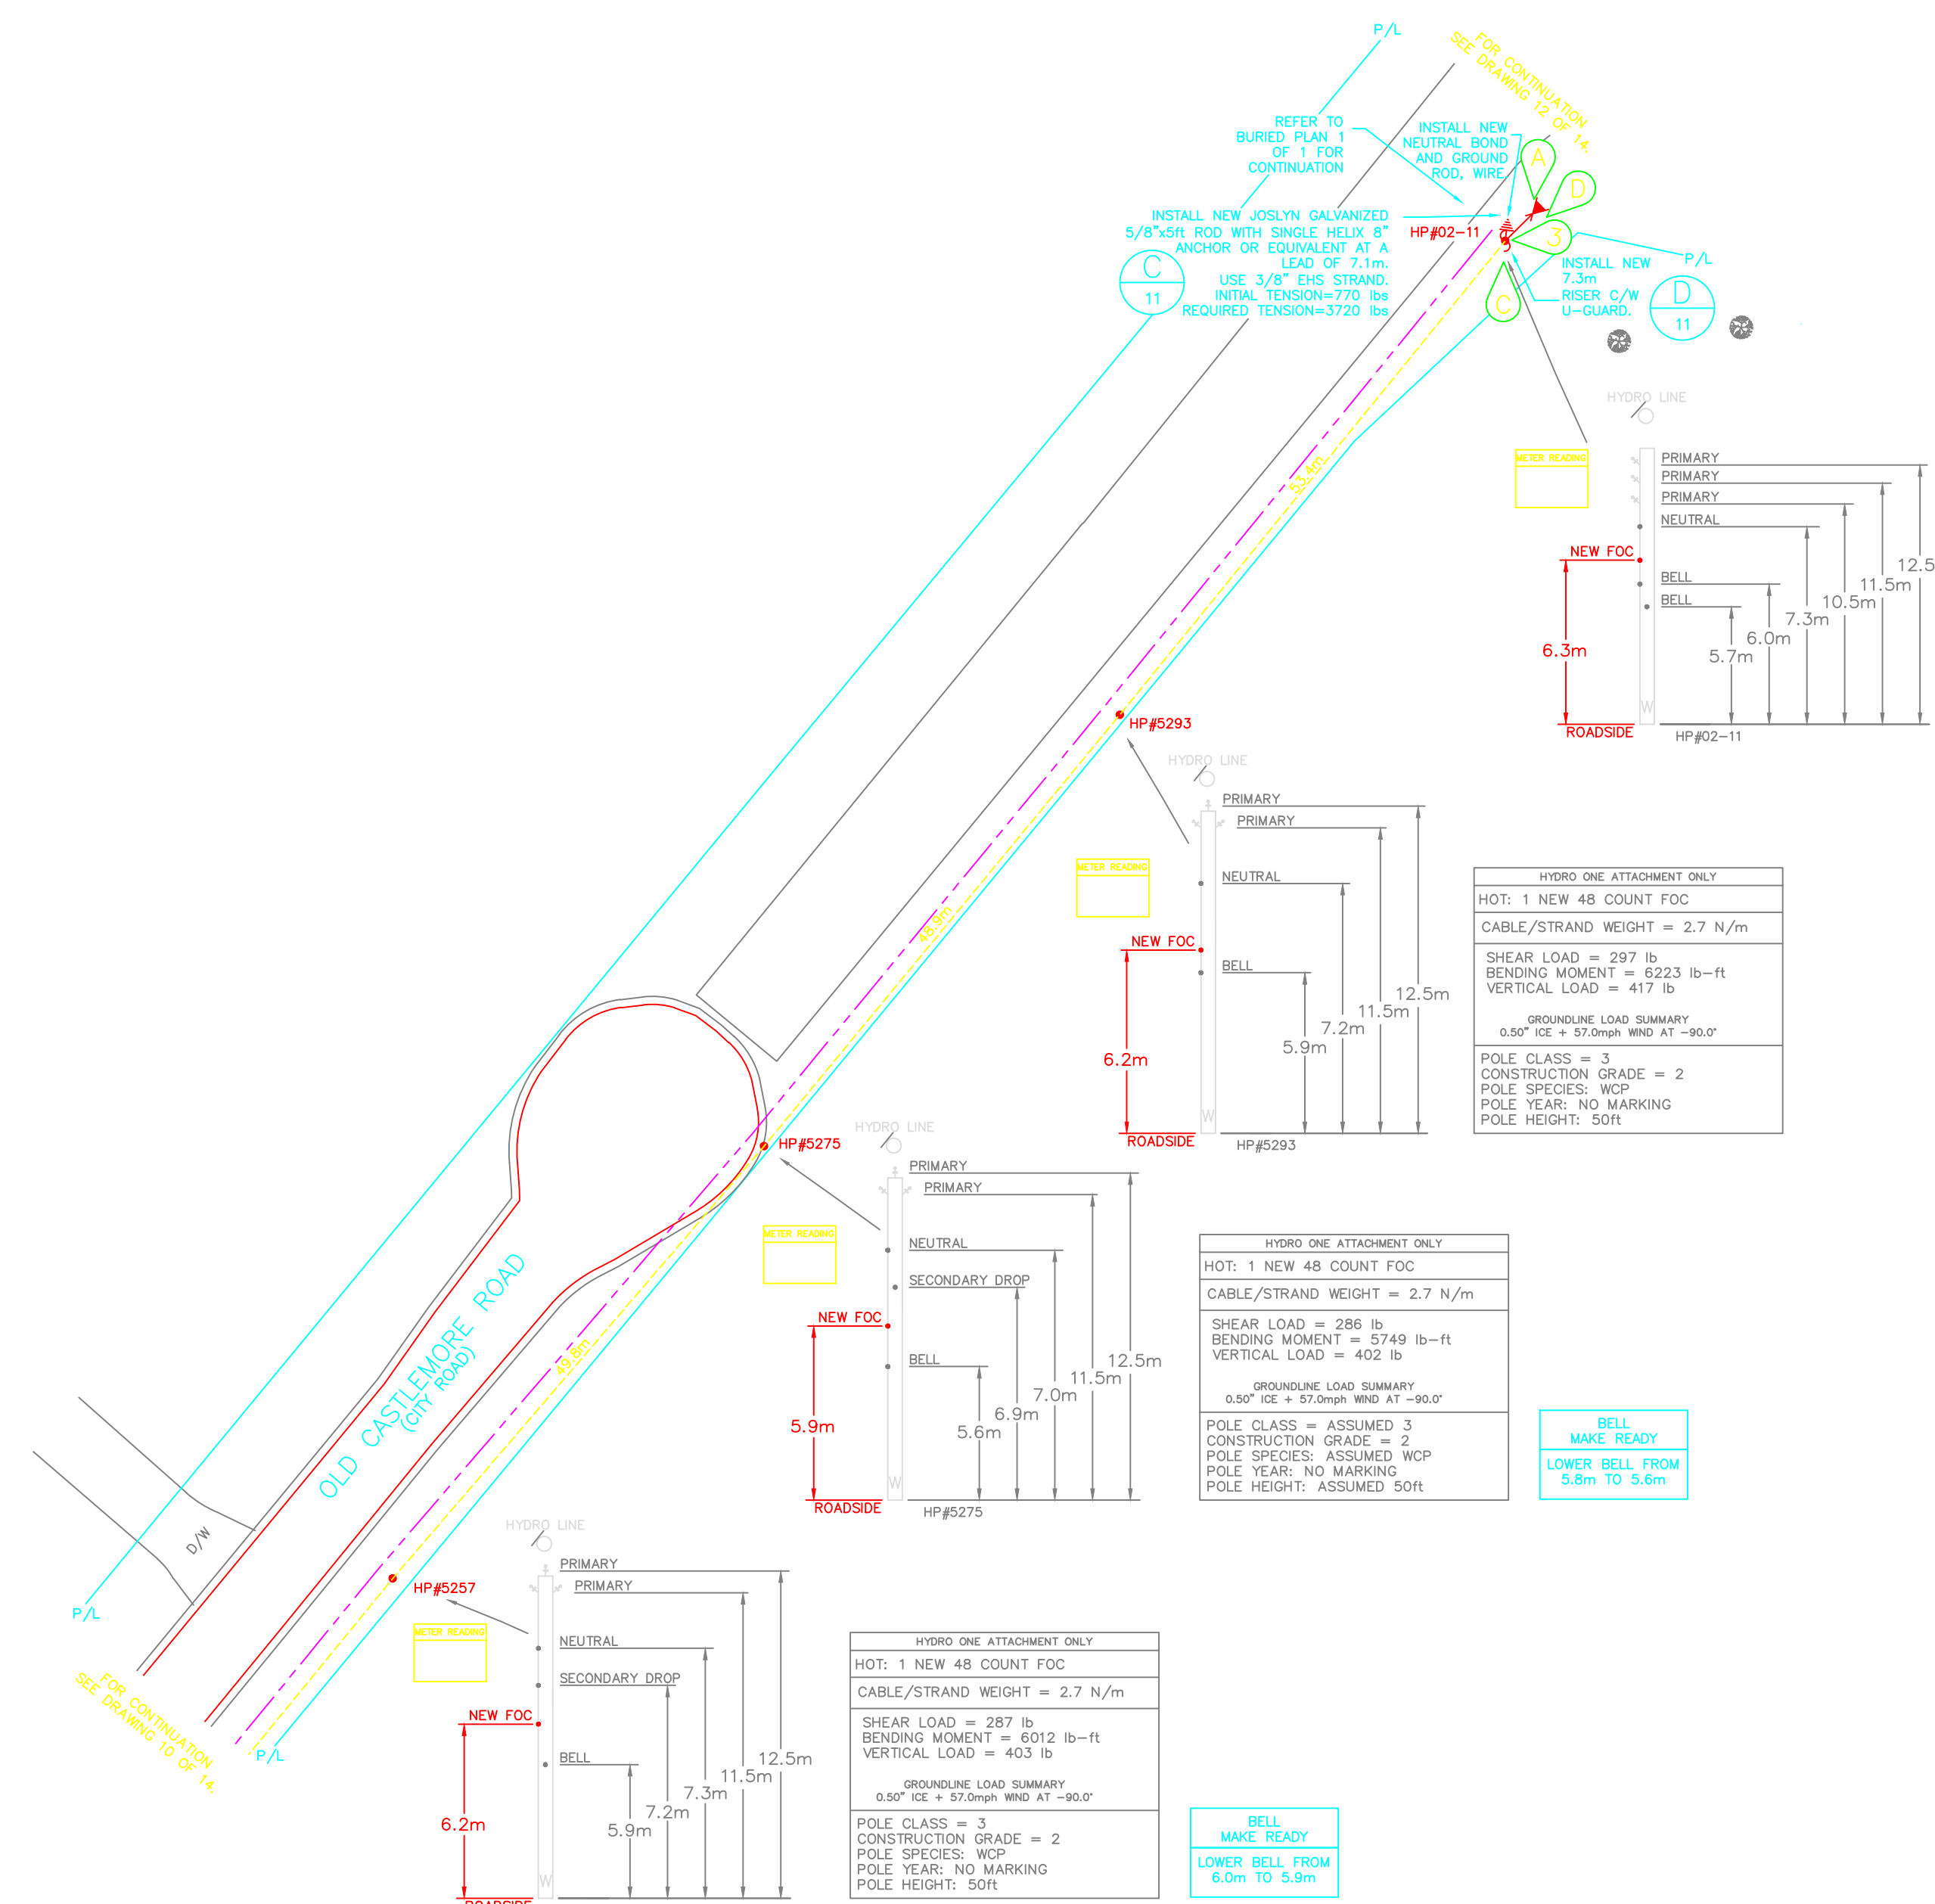

### CERTIFICATE OF APPROVAL

THE NEW INSTALLATION WORK COVERED BY THIS DOCUMENT MEETS THE SAFETY REQUIREMENTS OF SECTION 4 OF REGULATION 22/04, WITH CONSIDERATIONS OF THE FOLLOWING:

THE DESIGN CONFORMS TO CSA 22.3 NO 1-06 FOR HYDRO ONE TELECOM CLEARANCE, SEPARATION, GUYING AND STRAND TENSION. IT IS NOT INTENDED TO VERIFY THE INTEGRITY OF ATTACHMENTS, ANCHORING OR STRAND TENSIONS OF OTHERS, OR POLE STRENGTH.

POLES WERE NOT INVESTIGATED FOR DEFECTS/ROT.

NAME: \_\_\_\_\_ DATE: \_\_\_\_\_

SIGNATURE OF APPROVAL: \_\_\_\_\_

### REFERENCE DRAWINGS

CITY OF BRAMPTON

### LEGEND

NEW FIBER	
NEW STRAND	
OVERLASH	
EXISTING CONDUIT	
UNDERGROUND GAS LINE	
UNDERGROUND WATER	
UNDERGROUND HYDRO	
UNDERGROUND BELL	
UNDERGROUND CATV	
STORM SEWER	
SANITARY SEWER	
PROPERTY LINE	
FENCE	
DITCH	
EDGE OF PAVEMENT	
CURB	
GRAVEL SHOULDER	
NEW SPULCE	
EXISTING SPULCE	
VAULT	
BELL PEDESTAL	
CATV PEDESTAL	
TRANSFORMER	
CATCH BASIN	
WATER VALVE	
FIRE HYDRANT	
EXISTING POLE TO BE REMOVED	
STREET SIGN	
HYDRO POLE	
MANHOLE COVER	
MANHOLE & COVER	
LARGE ROCK	
TREE	
DIP LOCATION	
NEW DOWNGUY AND ANCHOR	
NEW SIDEWALK GUY	
NEW INTERIOR FIBER	
NEW BACKBOARD	
EXISTING BACKBOARD	
NEW PATCH PANEL	
EXISTING PATCH PANEL	
NEW EQUIPMENT RACK	
EXISTING EQUIPMENT RACK	
NEW FIBER COIL	

FIBER I.D.# (BTN)-(CABLE I.D.)-(FIBRE COUNT)

THESE DRAWINGS ARE COPYRIGHT AND THE PROPERTY OF MAGNATE ENGINEERING AND ASSOCIATES INC. REPRODUCTION OF THESE DRAWINGS WITHOUT THE CONSENT OF MAGNATE ENGINEERING AND ASSOCIATES INC. IS STRICTLY PROHIBITED. DO NOT SCALE THESE DRAWINGS. ANY ERRORS OR DISCREPANCY IS TO BE REPORTED IMMEDIATELY TO MAGNATE ENGINEERING AND ASSOCIATES INC.

DATE	REVISION	BY
05/20/2009	ISSUED FOR PERMIT	YC



**CASTLEMORE RD - THE GORE RD TO HWY 50**  
CITY OF BRAMPTON

PROJECT #	CONTRACTOR #	SCALE:
	9H005007P	1:500
APPROVED BY:	DATE:	DWG
	05/20/09	11 OF 14
DRAWING NUMBER:		

### CONSTRUCTION NOTES

- 1 OVERLASH 108.8m OF 1-48 COUNT FIBER OPTIC CABLE ON EXISTING ASSUMED 1/4" EHS HOT STRAND.
- 2 INSTALL 2187.3m OF NEW 1/4" EHS STRAND. LASH 1-48 COUNT FIBER OPTIC CABLE.
- 3 INSTALL 545.3m OF NEW 1/4" EHS STRAND. LASH 1-48 COUNT FIBER OPTIC CABLE.
- 4 INSTALL NEW NEUTRAL BOND AND GROUND ROD, AND WIRE.
- 5 INSTALL NEW 10.0m LOOPBACK.
- 6 INSTALL NEW DOWNGUY AND ANCHOR.
- 7 INSTALL NEW RISER C/W U-GUARD.
- 8 INSTALL NEW HYDRO ONE SPULCE ENCLOSURE.
- 9 INSTALL NEW 1/4" OVERHEAD GUY.

### SCOPE OF WORK

NEW OVERHEAD GUY	3=61.5m
NEW DOWNGUY AND ANCHOR	9
NEW 48 COUNT FIBER OPTIC CABLE	2896.2m
NEW OVERLASH	108.8m
NEW LASHWIRE	8524.2m
NEW 1/4" EHS STRAND	2732.6m
NEW CATV MAKE READY	3
NEW HOT MAKE READY	1
NEW BELL MAKE READY	12
NEW HYDRO MAKE READY	2
NEW RISER C/W U-GUARD	2
NEW SPULCE ENCLOSURE	1
NEW GROUND ROD AND WIRE	11=110.0m

NOTE: INFORMATION WAS OBTAINED FROM DRAWINGS SUPPLIED BY: 1. PHOTOGRAPHS OF PLAN AND PROFILE PROVIDED BY THE CITY OF BRAMPTON AND REGION OF PEEL.

**HYDRO ONE TELECOM CONTACT**  
IAN MITCHELL  
HYDRO ONE TELECOM INC  
65 KEELE STREET  
SCARBOROUGH, ONT. M1V 5A3  
PHONE: (416) 240-5700  
FAX: (416) 240-5700  
CELL: (416) 240-5700  
EMAIL: ian.mitchell@hydroone.com

### ANCHOR SPECIFICATIONS





ANCHOR TYPE	ANCHOR STRENGTH
SINGLE HELIX 8"	14000lbs
SINGLE HELIX 10"	20000lbs
SINGLE HELIX 12"	25000lbs
SINGLE HELIX 14"	31000lbs
TRIPLE HELIX, 8"-10"-12"	46000lbs

CALCULATION FOR REQUIRED STRENGTH OF ANCHOR IS BASED ON -20" WITH 0.5" OF ICE AND SOIL CLASS 4 (MEDIUM DENSE SANDY GRAVEL; VERY STIFF TO HARD SILTS AND CLAYS).

### GENERAL NOTES AERIAL DESIGN AND CONSTRUCTION

1. ALL CONSTRUCTION WORK SHALL BE IN CONFORMANCE WITH CANADIAN, PROVINCIAL AND ONTARIO HYDRO SERVICES COMPANY SAFETY REQUIREMENTS. THESE INCLUDES WITHOUT LIMITATION:
  - OHSC WORK PROTECTION CODE
  - OCCUPATIONAL HEALTH AND SAFETY ACT
  - THIS DESIGN CONFORMS TO CSA STANDARD C22.3 NO. 1-06.
2. TAKE THE NECESSARY PRECAUTIONS TO PROTECT THE EXISTING INSTALLATION FROM DAMAGE. THE CONTRACTOR WILL BE RESPONSIBLE FOR ALL THE CLAIMS DUE TO DAMAGE.
3. ALL REVISIONS MUST BE MADE PRIOR TO CONSTRUCTION.
4. ALL BOLTS MUST PROVIDE FOR 25mm OF EXPOSED THREAD.
5. ASSUME SOIL CONDITIONS AT ANCHOR POINT ARE AS FOLLOWS:
  - MEDIUM DENSE SANDY GRAVEL; VERY STIFF TO HARD SILTS AND CLAYS.
6. THE CONTRACTOR SHALL CHECK AND VERIFY ALL SITE CONDITIONS, CLEARANCES AND DIMENSIONS AT THE SITE AND REPORT ANY DISCREPANCIES TO THE ENGINEER BEFORE PROCEEDING WITH WORK.
7. SAGS & CLEARANCES ARE CHECKED AND CALCULATED FOR NEW ATTACHMENTS ONLY.
8. POLES NOT CHECKED FOR OVERALL LOADING. ADDITIONAL APPLIED LOADS ARE SHOWN ON THIS DRAWING DUE TO NEW ATTACHMENTS ONLY.
9. THE CONTRACTOR SHALL ENSURE THAT THE COMMUNICATION STRAND OR MESSENGER IS BONDED TO THE DISTRIBUTION SYSTEM NEUTRAL AT EVERY DIP LOCATION & EVERY 300 METRES.
10. VISIT THE SITE TO CHECK ON AVAILABLE ACCESS, STORAGE AND WORKING AREAS. DETERMINE ANY INTERFERENCE WITH EXISTING SERVICES.
11. SPIRAL WRAP AND TAG ALL EXPOSED FIBER OPTIC CABLE, INCLUDING: DRIP LOOPS, ENDS OF LOOPBACKS & DIPS ABOVE U-GUARDS.
12. AERIAL STRAND SHALL BE 1/4" EHS STRAND, 7-WIRE ZINC COATED, OR 3/8" EHS STRAND, 7-WIRE ZINC COATED, UNLESS NOTED OTHERWISE.
13. LOCATIONS AND DETAILS SHOWN ON THIS DRAWING ARE BASED ON THE BEST INFORMATION AVAILABLE AT TIME OF SURVEY. CONFIRM ALL LOCATIONS, CLEARANCES, AND INTERFERENCES ON SITE PRIOR TO BEGINNING WORK.
14. POLES WERE NOT VERIFIED FOR DECAY, OR DEFICIENCIES DUE TO THE INSTALLATION OF EXISTING ATTACHMENTS.
15. CONTRACTOR TO CONTACT THE ENGINEER IF THE HYDRO LINE ABOVE THE NEW ATTACHMENT HAS A SAG LARGER THAN 1000mm OR IF THE VOLTAGE IS HIGHER THAN 750V.
16. MAKE GOOD ALL EXISTING FINISHES WHEN WORK IS COMPLETE.
17. THE POSITION OF POLE LINES, CONDUITS, WATERMANS, SEWERS AND OTHER UNDERGROUND AND ABOVE GROUND UTILITIES AND STRUCTURES ARE NOT NECESSARILY SHOWN ON THE CONTRACT DRAWINGS, AND WHERE SHOWN, THE ACCURACY OF THE POSITION OF SUCH UTILITIES AND STRUCTURES IS NOT GUARANTEED. BEFORE STARTING WORK, THE CONTRACTOR SHALL CONFIRM THE EXACT LOCATION OF ALL SUCH UTILITIES AND STRUCTURES, AND SHALL ASSUME ALL LIABILITY FOR DAMAGE TO THEM.
18. ALL THE MATERIAL AND EQUIPMENT TO BE ESA AND CSA APPROVED.
19. CONTRACTOR TO USE DOWNGUY SPLITTERS AS REQUIRED IN ORDER TO AVOID CONTACT WITH POWER LINES.
20. ANALYSIS WAS PERFORMED USING THE DETERMINISTIC METHOD ASSUMING THAT THE HIGHEST VOLTAGE OF ANY OF THE EXISTING SUPPLY LINES IS LESS THAN 70 KV PHASE TO PHASE.
21. WHERE EXISTING COMMUNICATIONS ATTACHMENTS ARE SHOWN TO BE RELOCATED, THE THIRD PARTY OWNER OF THE ATTACHMENT MUST BE CONTACTED TO REVIEW AND ENSURE MINIMUM CLEARANCES ARE MAINTAINED IN ACCORDANCE WITH APPLICABLE STANDARDS.

RECORD OF INSPECTION BY CONTRACTOR	
AS CONSTRUCTED	<input type="checkbox"/> Aerial Installation
	<input type="checkbox"/> U/G Installation
With changes shown on this Drawing	
Attachment Owner	Permit #
	Date
	Company Name
	Print Name
	Position
	Signature
<input type="checkbox"/> This is to certify that the construction as recorded in this drawing is consistent with the approved plan, Standard Designs, or work instruction and that approved equipment has been used.	

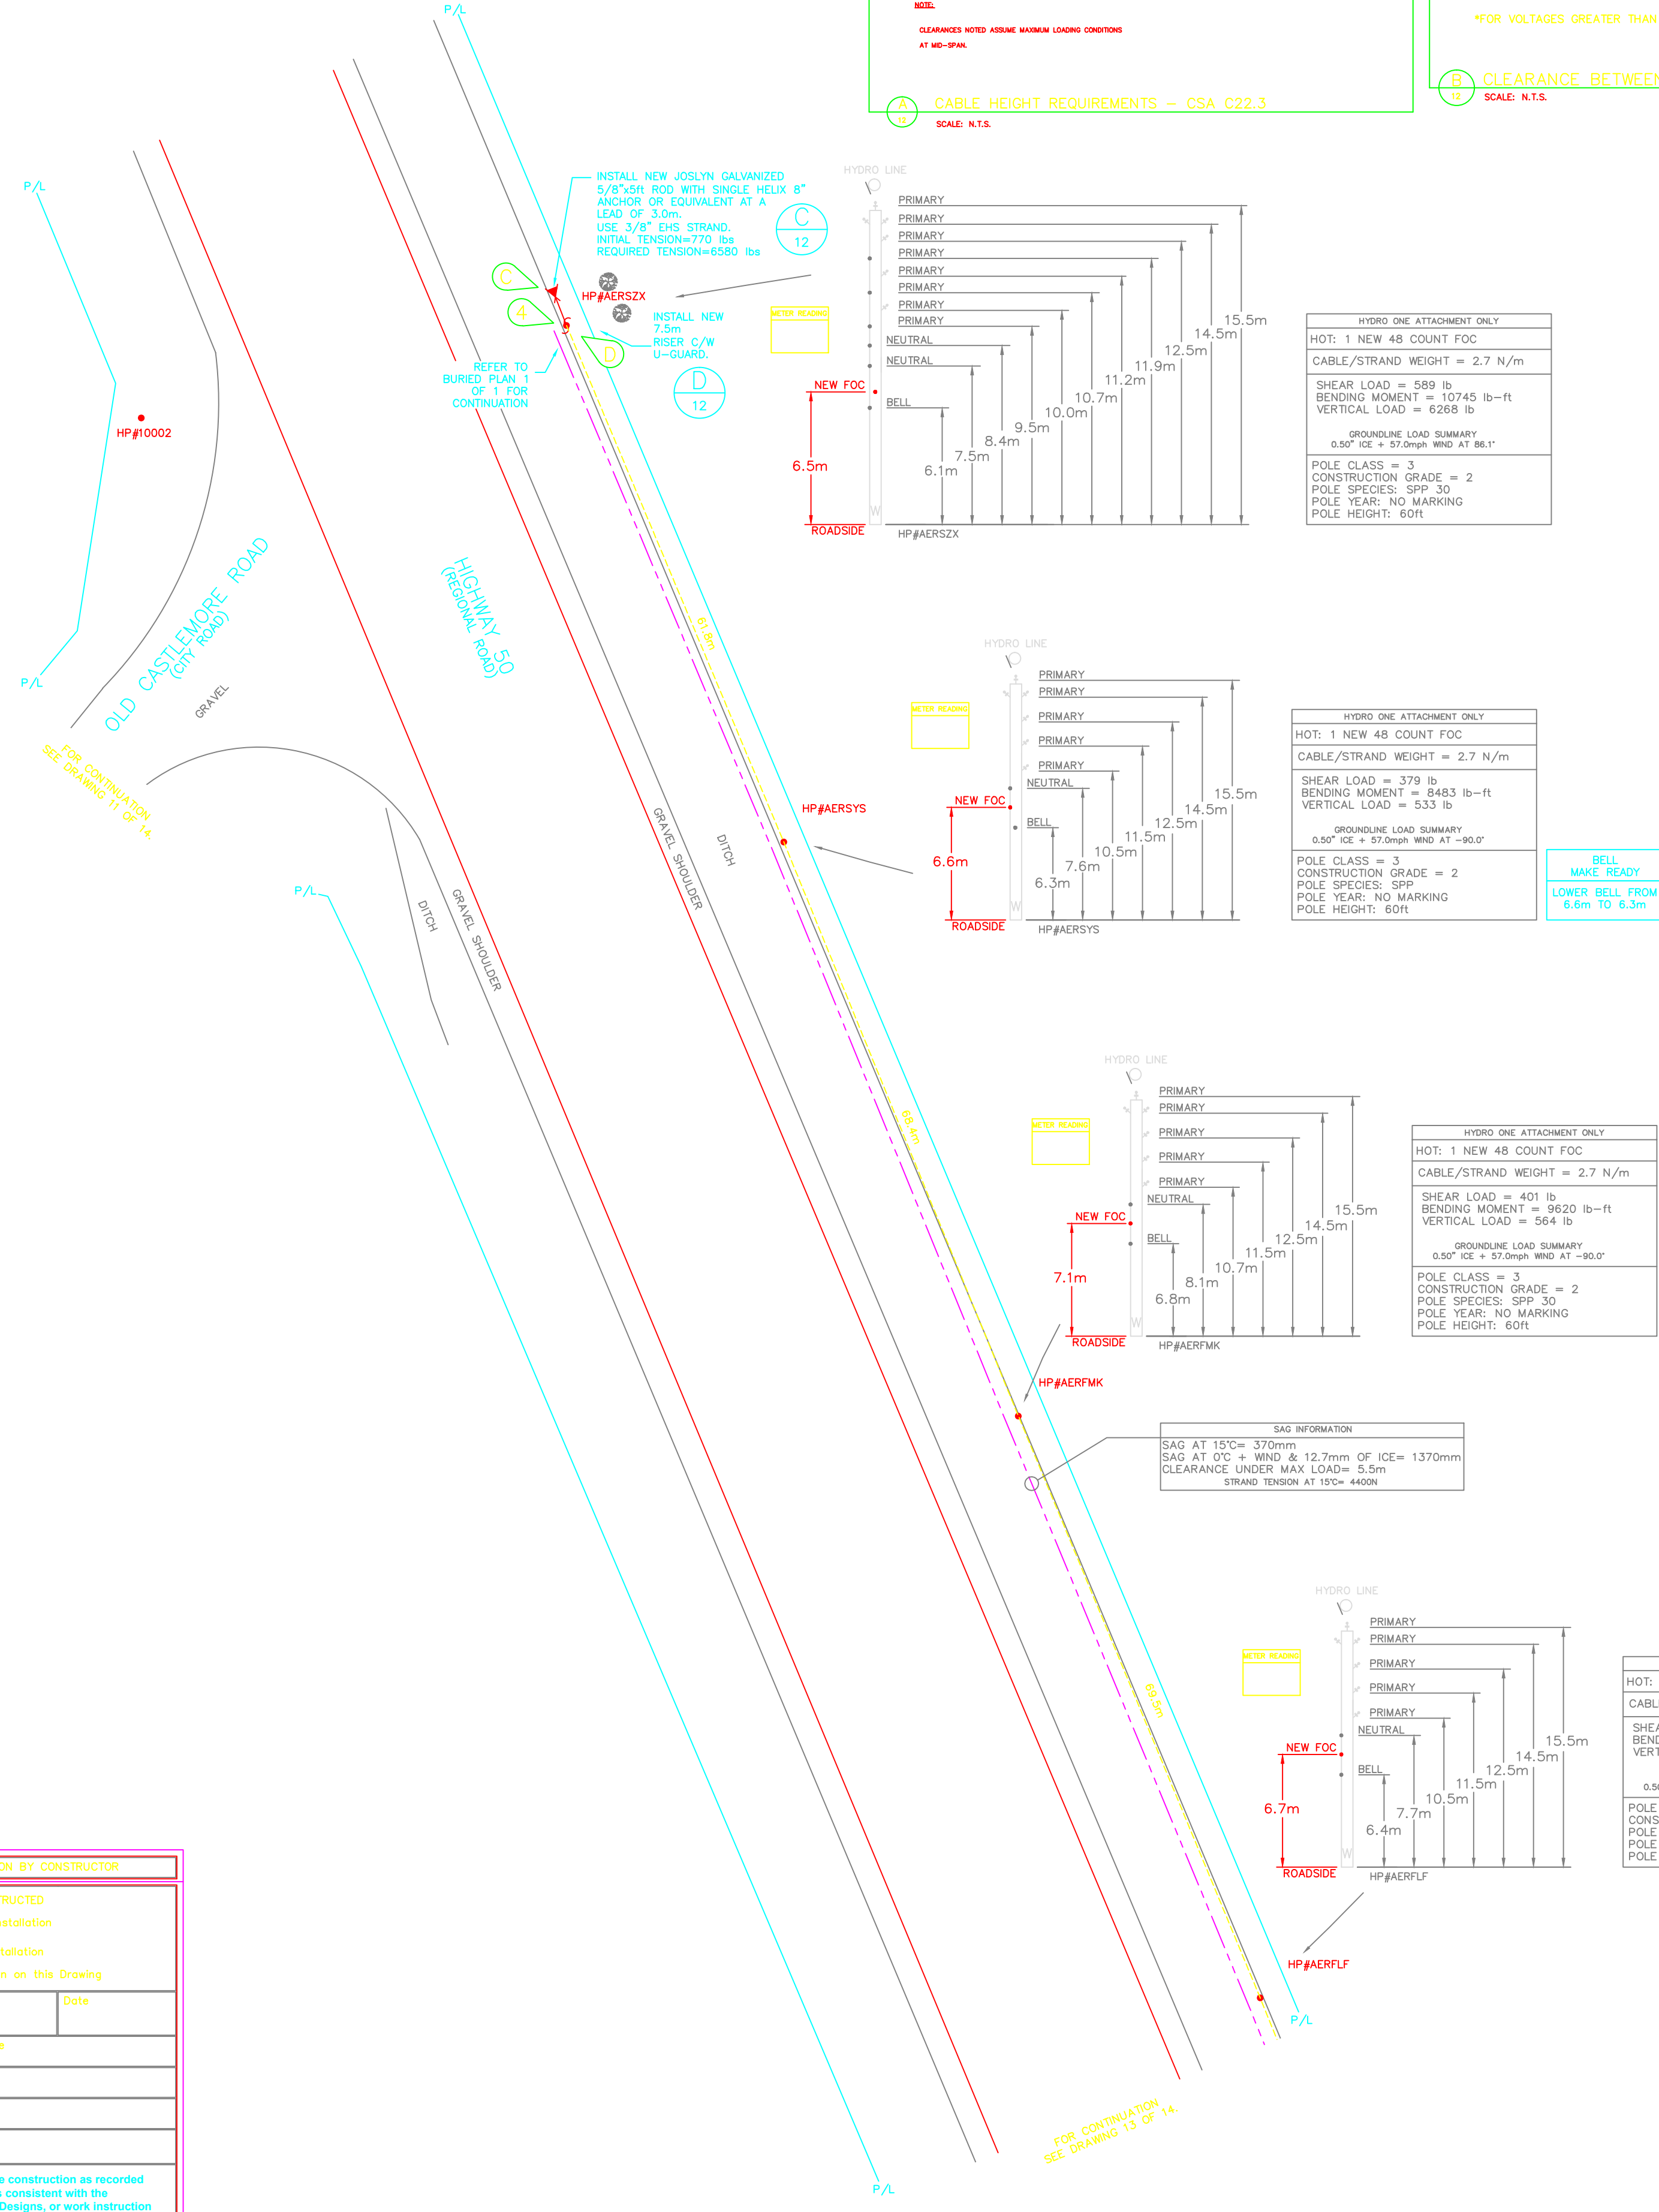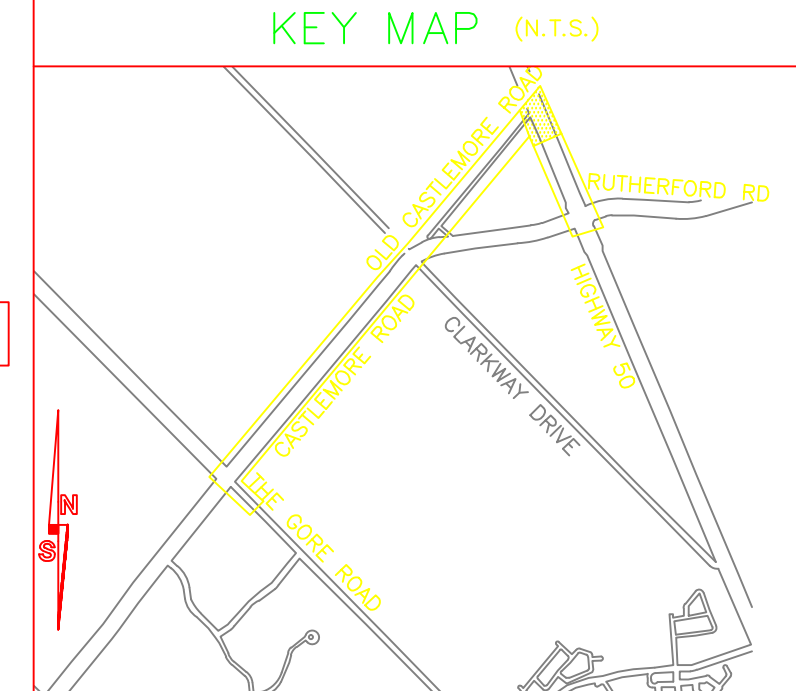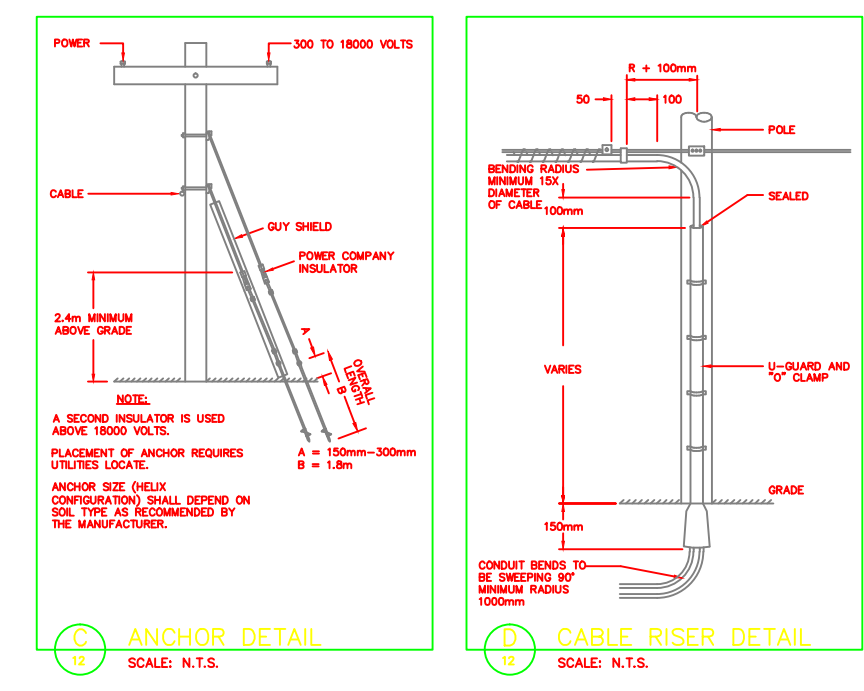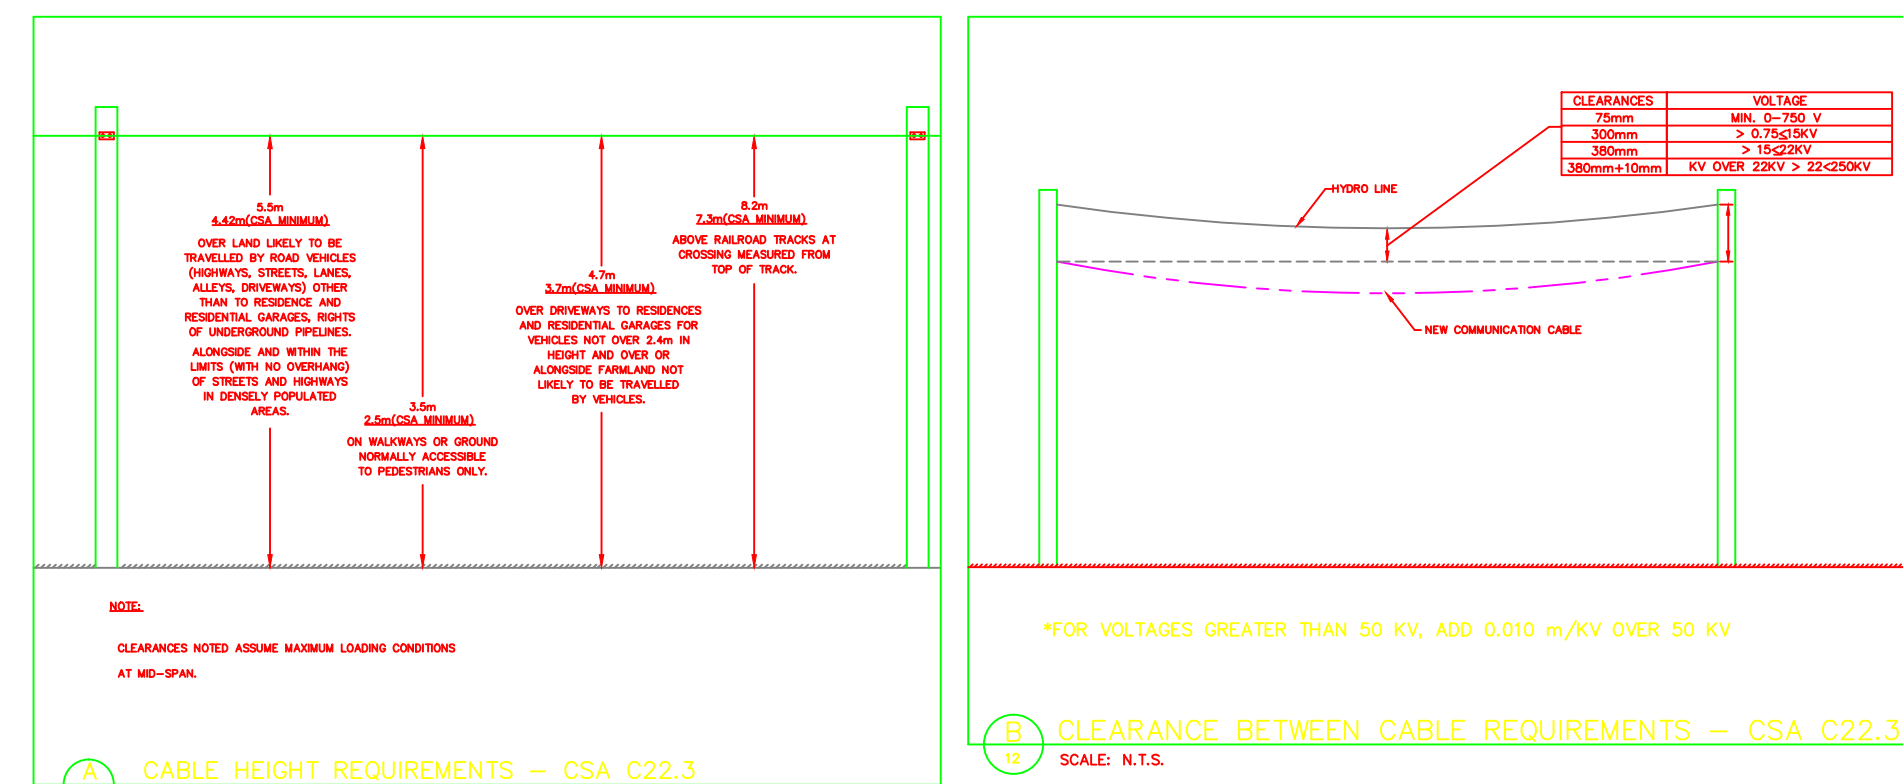

**HYDRO ONE TELECOM ATTACHMENT CERTIFICATE**

THIS IS TO CERTIFY THAT THE CONSTRUCTION AS RECORDED IN THIS DRAWING MEETS THE APPLICABLE REQUIREMENTS OF THE SAFETY STANDARDS IN PART 4 OF REGULATION 22/04.

NAME: \_\_\_\_\_ DATE: \_\_\_\_\_

SIGNATURE & PROFESSIONAL DESIGNATION: \_\_\_\_\_

### REFERENCE DRAWINGS

CITY OF BRAMPTON

### LEGEND

EXTERNAL	INTERNAL
NEW FIBER	NEW BACKBOARD
NEW STRAND	EXISTING BACKBOARD
OVERLASH	NEW PATCH PANEL
EXISTING CONDUIT	EXISTING PATCH PANEL
UNDERGROUND GAS LINE	NEW EQUIPMENT RACK
UNDERGROUND WATER	EXISTING EQUIPMENT RACK
UNDERGROUND HYDRO	EXISTING EQUIPMENT RACK
UNDERGROUND BELL	NEW FIBER COIL
UNDERGROUND CATV	
STORM SEWER	
SANITARY SEWER	
PROPERTY LINE	
FENCE	
DITCH	
EDGE OF PAVEMENT	
CURB	
GRAVEL SHOULDER	
NEW SPULCE	
EXISTING SPULCE	
VAULT	
BELL PEDESTAL	
CATV PEDESTAL	
TRANSFORMER	
CATCH BASIN	
WATER VALVE	
FIRE HYDRANT	
EXISTING POLE TO BE REMOVED	
STREET SIGN	
HYDRO POLE	
MANHOLE COVER	
MANHOLE & COVER	
LARGE ROCK	
TREE	
DIP LOCATION	
NEW DOWNGUY AND ANCHOR	
NEW SIDEWALK GUY	
NEW INTERIOR FIBER	
NEW FIBER COIL	

FIBER I.D.# BMTN-(CABLE I.D.)-(FIBRE COUNT)

THESE DRAWINGS ARE COPYRIGHT AND THE PROPERTY OF MAGNATE ENGINEERING AND ASSOCIATES INC. REPRODUCTION OF THESE DRAWINGS WITHOUT THE CONSENT OF MAGNATE ENGINEERING AND ASSOCIATES INC. IS STRICTLY PROHIBITED. DO NOT SCALE THESE DRAWINGS, ANY ERRORS, OR DISCREPANCY IS TO BE REPORTED IMMEDIATELY TO MAGNATE ENGINEERING AND ASSOCIATES INC.

DATE	REVISION	BY
05/20/2009	ISSUED FOR PERMIT	YC

**hydro one**  
Hydro One Telecommunications

Hydro One Telecom Inc.  
65 Keele Street  
Toronto, Ontario M3J 5A3

**MAGNATE**  
ENGINEERING AND ASSOCIATES INC.

18 Automatic Road, Suite 1C  
Brampton, Ontario L6S 5N5  
Telephone: (905) 799-8220

**CASTLEMORE RD - THE GORE RD TO HWY 50**  
CITY OF BRAMPTON

PROJECT #	CONTRACTOR #	SCALE
	9H005007P	1:500

APPROVED BY: \_\_\_\_\_ DATE: 05/20/09 DWG 12 OF 14

DRAWING NUMBER: \_\_\_\_\_

**CERTIFICATE OF APPROVAL**


THE NEW INSTALLATION WORK COVERED BY THIS DOCUMENT MEETS THE SAFETY REQUIREMENTS OF SECTION 4 OF REGULATION 22/04, WITH CONSIDERATIONS OF THE FOLLOWING:

THE DESIGN CONFORMS TO CSA C22.3 NO 1-06 FOR HYDRO ONE TELECOM CLEARANCE, SEPARATION, GUYING AND STRAND TENSION. IT IS NOT INTENDED TO VERIFY THE INTEGRITY OF ATTACHMENTS, ANCHORING OR STRAND TENSIONS OF OTHERS, OR POLE STRENGTH.

POLES WERE NOT INVESTIGATED FOR DEFECTS/ROT.

NAME: \_\_\_\_\_ DATE: \_\_\_\_\_

SIGNATURE OF APPROVAL: \_\_\_\_\_

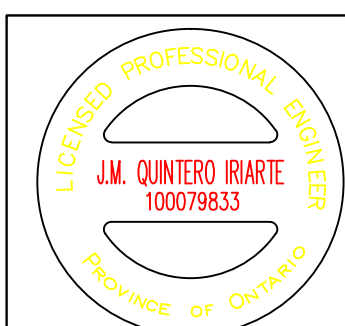

FOR NEW CABLE ATTACHMENT TO HYDRO POLE ONLY, INCLUDING: TENSIONING FOR CLEARANCES AND NEW CABLE LOADS



18 Automatic Road Suite 1C  
Brampton, Ontario L6S 5N5  
Telephone: (905) 799-8220

### CONSTRUCTION NOTES

- 1 OVERLASH 108.8m OF 1-48 COUNT FIBER OPTIC CABLE ON EXISTING ASSUMED 1/4" EHS HOT STRAND.
- 2 INSTALL 2187.3m OF NEW 1/4" EHS STRAND, LASH 1-48 COUNT FIBER OPTIC CABLE.
- 3 INSTALL 545.3m OF NEW 1/4" EHS STRAND, LASH 1-48 COUNT FIBER OPTIC CABLE.
- 4
- 5
- A INSTALL NEW NEUTRAL BOND AND GROUND ROD, AND WIRE.
- B INSTALL NEW 10.0m LOOPBACK.
- C INSTALL NEW DOWNGUY AND ANCHOR.
- D INSTALL NEW RISER C/W U-GUARD.
- E INSTALL NEW HYDRO ONE SPICE ENCLOSURE.
- F INSTALL NEW 1/4" OVERHEAD GUY.

### SCOPE OF WORK

NEW OVERHEAD GUY	3=61.5m
NEW DOWNGUY AND ANCHOR	2996.2m
NEW 48 COUNT FIBER OPTIC CABLE	108.8m
NEW OVERLASH	8524.2m
NEW LASHWIRE	2732.6m
NEW 1/4" EHS STRAND	3
NEW CATV MAKE READY	1
NEW HOT MAKE READY	12
NEW BELL MAKE READY	2
NEW HYDRO MAKE READY	1
NEW RISER C/W U-GUARD	2
NEW SPICE ENCLOSURE	1
NEW GROUND ROD AND WIRE	11=110.0m

NOTE: INFORMATION WAS OBTAINED FROM DRAWINGS SUPPLIED BY:  
1. PHOTOGRAPHS OF PLAN AND PROFILE PROVIDED BY THE CITY OF BRAMPTON AND REGION OF PEEL.

**HYDRO ONE TELECOM CONTACT**  
IAN MITCHELL  
HYDRO ONE TELECOM INC  
65 KEELEF STREET  
SCARBOROUGH, ONTARIO M1V 5A3  
PHONE: (416) 240-4300  
FAX: (416) 240-4300  
CELL: (416) 240-4300  
EMAIL: ian.mitchell@hydroone.com

### ANCHOR SPECIFICATIONS









ANCHOR TYPE	ANCHOR STRENGTH
SINGLE HELIX 8"	14000lbs
SINGLE HELIX 10"	20000lbs
SINGLE HELIX 12"	25000lbs
SINGLE HELIX 14"	31000lbs
TRIPLE HELIX, 8"-10"-12"	46000lbs

CALCULATION FOR REQUIRED STRENGTH OF ANCHOR IS BASED ON -20" WITH 0.5" OF ICE AND SOIL CLASS 4 (MEDIUM DENSE SANDY GRAVEL; VERY STIFF TO HARD SILTS AND CLAYS).

### GENERAL NOTES AERIAL DESIGN AND CONSTRUCTION

1. ALL CONSTRUCTION WORK SHALL BE IN CONFORMANCE WITH CANADIAN, PROVINCIAL AND ONTARIO HYDRO SERVICES COMPANY SAFETY REQUIREMENTS. THESE INCLUDES WITHOUT LIMITATION:  
- OHSC WORK PROTECTION CODE  
- OCCUPATIONAL HEALTH AND SAFETY ACT  
- THIS DESIGN CONFORMS TO CSA STANDARD C22.3 NO. 1-06.
2. TAKE THE NECESSARY PRECAUTIONS TO PROTECT THE EXISTING INSTALLATION FROM DAMAGE. THE CONTRACTOR WILL BE RESPONSIBLE FOR ALL THE CLAIMS DUE TO DAMAGE.
3. ALL REVISIONS MUST BE MADE PRIOR TO CONSTRUCTION.
4. ALL BOLTS MUST PROVIDE FOR 25mm OF EXPOSED THREAD.
5. ASSUME SOIL CONDITIONS AT ANCHOR POINT ARE AS FOLLOWS:  
- MEDIUM DENSE SANDY GRAVEL; VERY STIFF TO HARD SILTS AND CLAYS.
6. THE CONTRACTOR SHALL CHECK AND VERIFY ALL SITE CONDITIONS, CLEARANCES AND DIMENSIONS AT THE SITE AND REPORT ANY DISCREPANCIES TO THE ENGINEER BEFORE PROCEEDING WITH WORK.
7. SAGS & CLEARANCES ARE CHECKED AND CALCULATED FOR NEW ATTACHMENTS ONLY.
8. POLES NOT CHECKED FOR OVERALL LOADING. ADDITIONAL APPLIED LOADS ARE SHOWN ON THIS DRAWING DUE TO NEW ATTACHMENTS ONLY.
9. THE CONTRACTOR SHALL ENSURE THAT THE COMMUNICATION STRAND OR MESSENGER IS BONDED TO THE DISTRIBUTION SYSTEM NEUTRAL AT EVERY DIP LOCATION & EVERY 300 METRES.
10. VISIT THE SITE TO CHECK ON AVAILABLE ACCESS, STORAGE AND WORKING AREAS. DETERMINE ANY INTERFERENCE WITH EXISTING SERVICES.
11. SPIRAL WRAP AND TAG ALL EXPOSED FIBER OPTIC CABLE, INCLUDING: DRIP LOOPS, ENDS OF LOOPBACKS & DIPS ABOVE U-GUARDS.
12. AERIAL STRAND SHALL BE 1/4" EHS STRAND, 7-WIRE ZINC COATED, OR 3/8" EHS STRAND, 7-WIRE ZINC COATED, UNLESS NOTED OTHERWISE.
13. LOCATIONS AND DETAILS SHOWN ON THIS DRAWING ARE BASED ON THE BEST INFORMATION AVAILABLE AT TIME OF SURVEY. CONFIRM ALL LOCATIONS, CLEARANCES, AND INTERFERENCES ON SITE PRIOR TO BEGINNING WORK.
14. POLES WERE NOT VERIFIED FOR DECAY, OR DEFICIENCIES DUE TO THE INSTALLATION OF EXISTING ATTACHMENTS.
15. CONTRACTOR TO CONTACT THE ENGINEER IF THE HYDRO LINE ABOVE THE NEW ATTACHMENT HAS A SAG LARGER THAN 1000mm OR IF THE VOLTAGE IS HIGHER THAN 750V.
16. MAKE GOOD ALL EXISTING FINISHES WHEN WORK IS COMPLETE.
17. THE POSITION OF POLE LINES, CONDUITS, WATERMANS, SEWERS AND OTHER UNDERGROUND AND ABOVE GROUND UTILITIES AND STRUCTURES ARE NOT NECESSARILY SHOWN ON THE CONTRACT DRAWINGS, AND WHERE SHOWN, THE ACCURACY OF THE POSITION OF SUCH UTILITIES AND STRUCTURES IS NOT GUARANTEED. BEFORE STARTING WORK, THE CONTRACTOR SHALL CONFIRM THE EXACT LOCATION OF ALL SUCH UTILITIES AND STRUCTURES, AND SHALL ASSUME ALL LIABILITY FOR DAMAGE TO THEM.
18. ALL THE MATERIAL AND EQUIPMENT TO BE ESA AND CSA APPROVED.
19. CONTRACTOR TO USE DOWNGUY SPLITTERS AS REQUIRED IN ORDER TO AVOID CONTACT WITH POWER LINES.
20. ANALYSIS WAS PERFORMED USING THE DETERMINISTIC METHOD ASSUMING THAT THE HIGHEST VOLTAGE OF ANY OF THE EXISTING SUPPLY LINES IS LESS THAN 70 KV PHASE TO PHASE.
21. WHERE EXISTING COMMUNICATIONS ATTACHMENTS ARE SHOWN TO BE RELOCATED, THE THIRD PARTY OWNER OF THE ATTACHMENT MUST BE CONTACTED TO REVIEW AND ENSURE MINIMUM CLEARANCES ARE MAINTAINED IN ACCORDANCE WITH APPLICABLE STANDARDS.

RECORD OF INSPECTION BY CONSTRUCTOR	
AS CONSTRUCTED	<input type="checkbox"/> Aerial Installation
	<input type="checkbox"/> U/G Installation
With changes shown on this Drawing	
Attachment Owner	Permit #
	Date
	Company Name
	Print Name
	Position
	Signature
<input type="checkbox"/> This is to certify that the construction as recorded in this drawing is consistent with the approved plan, Standard Designs, or work instruction and that approved equipment has been used.	

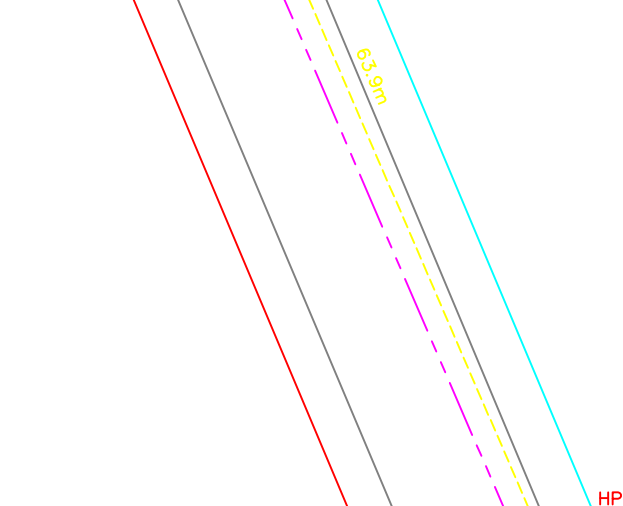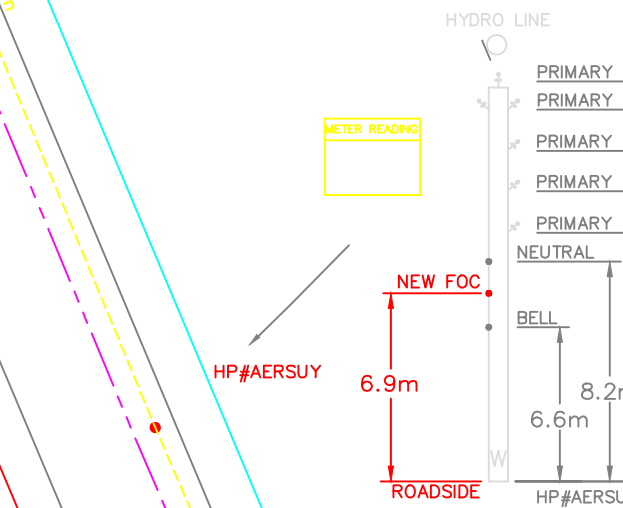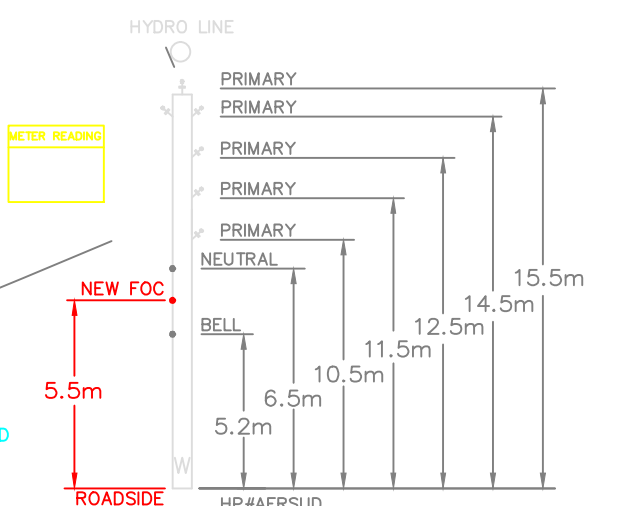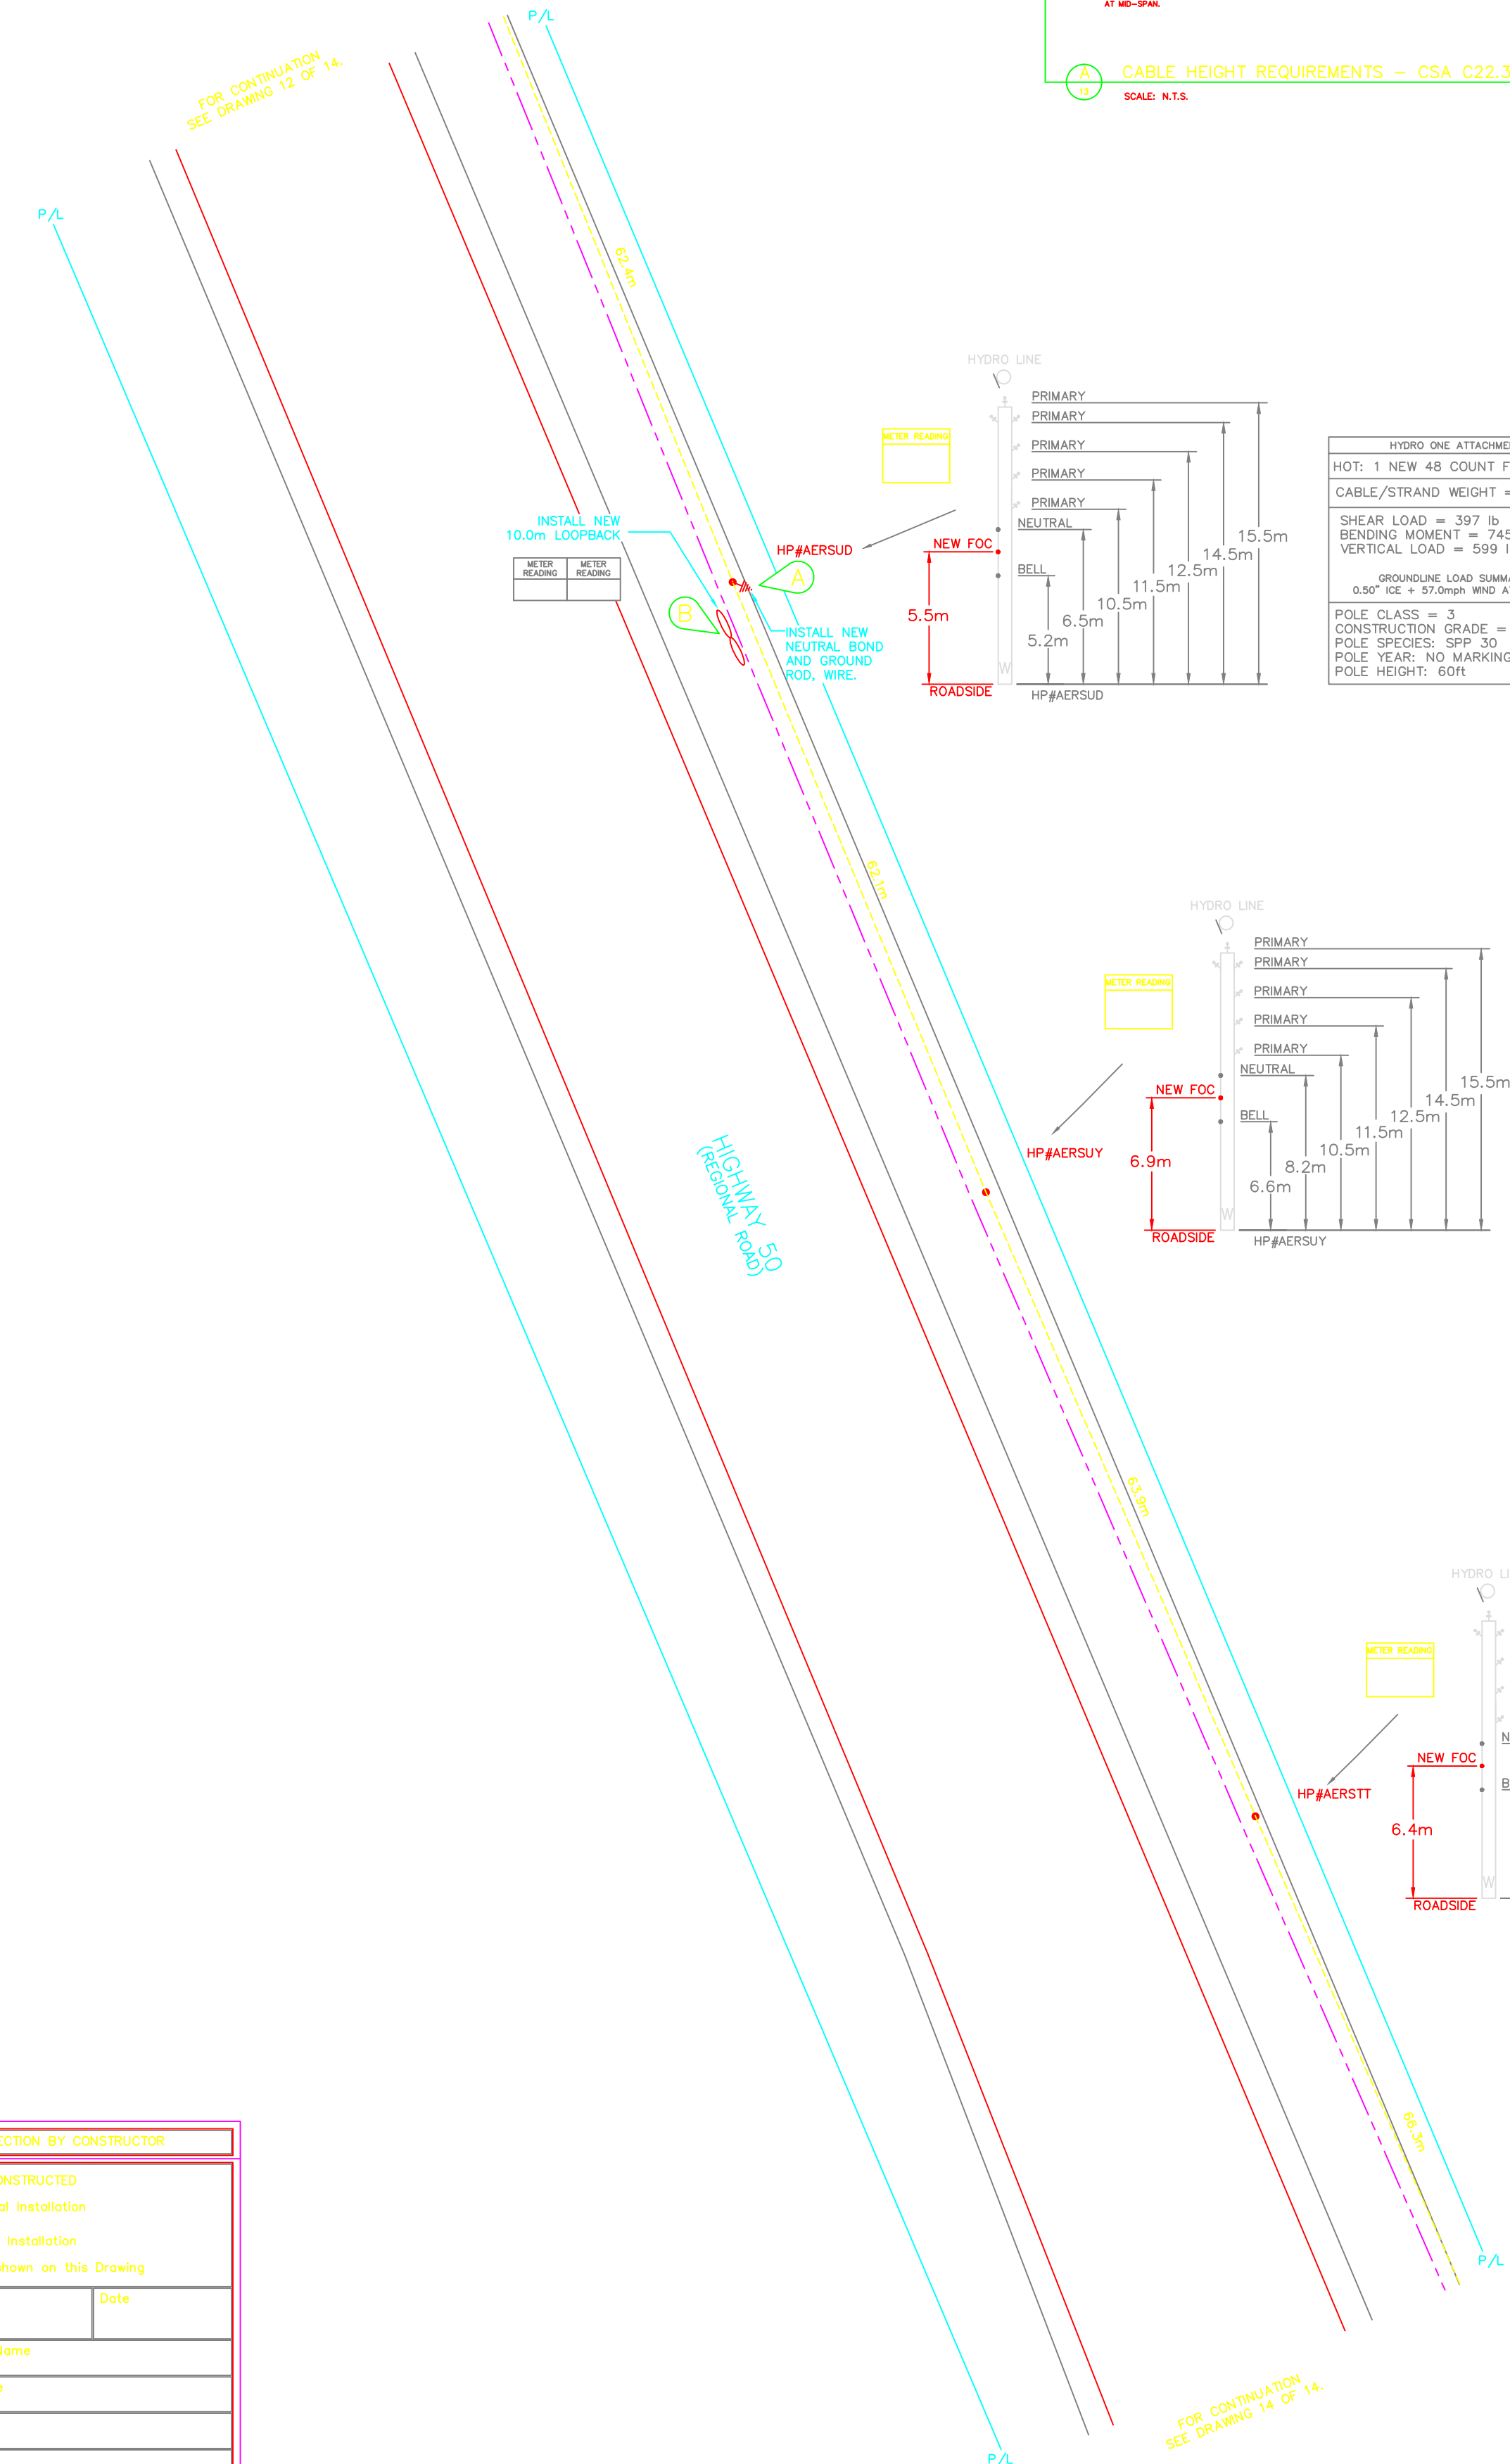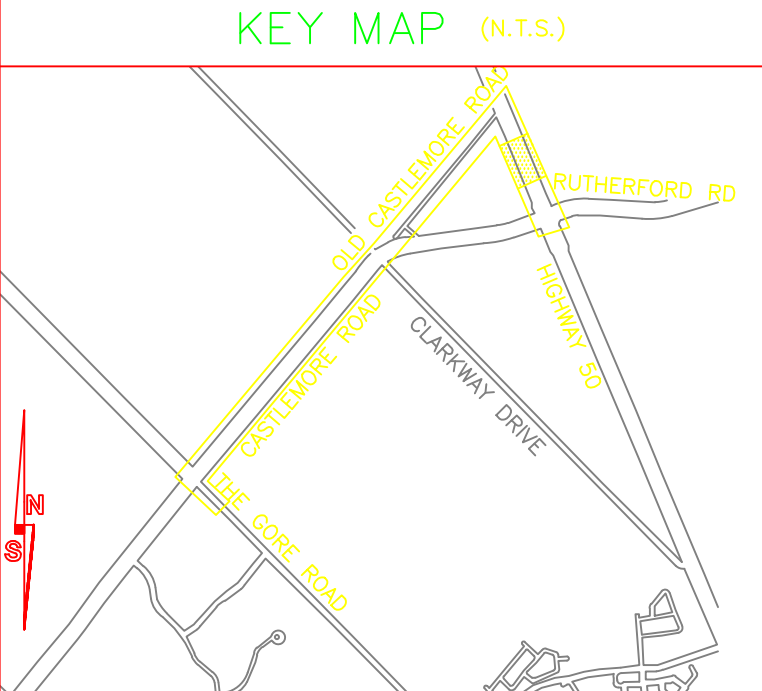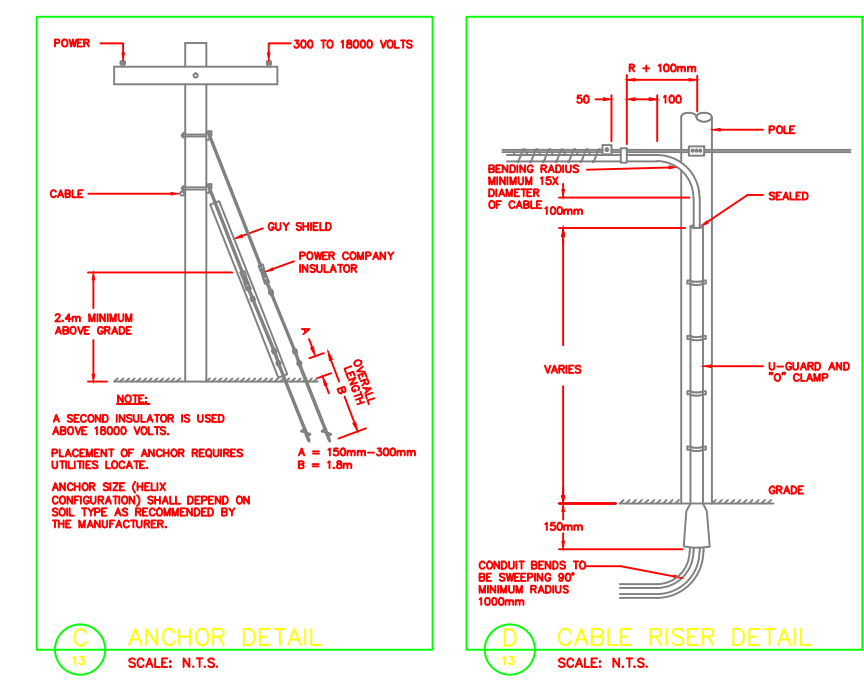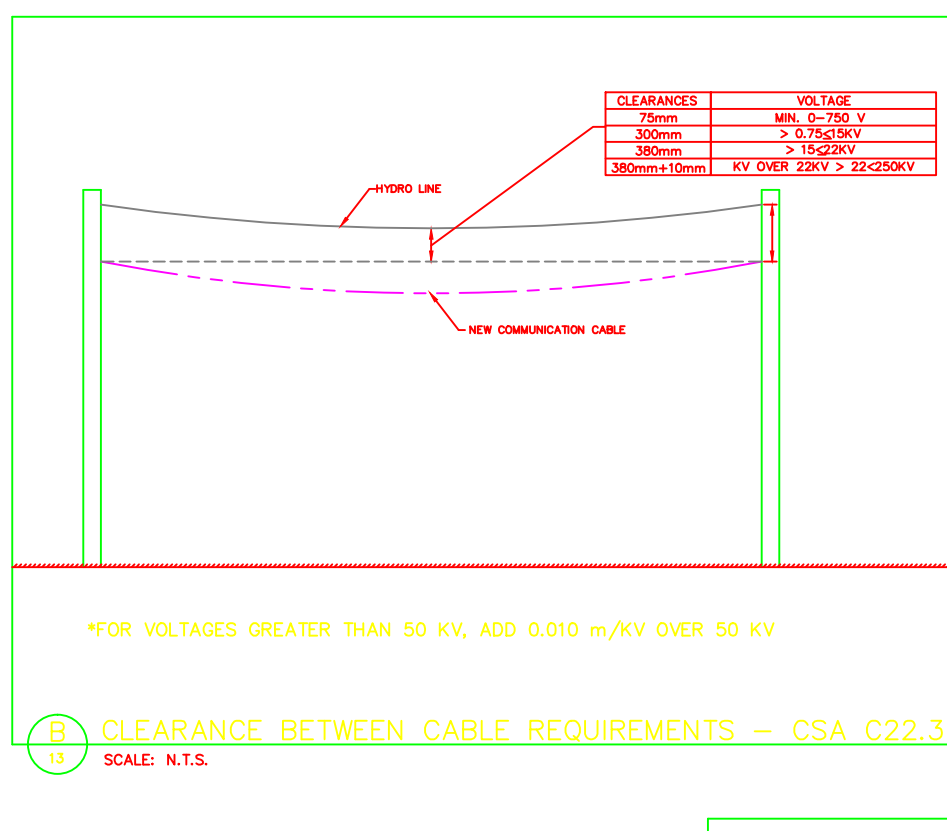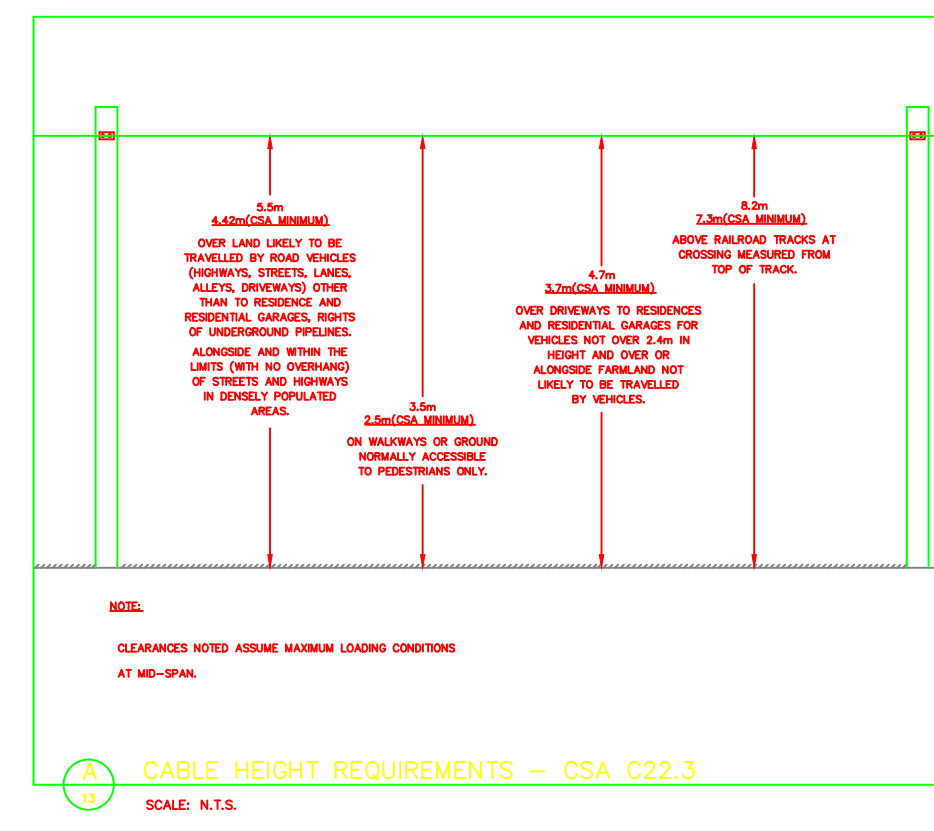

HYDRO ONE ATTACHMENT ONLY  
HOT: 1 NEW 48 COUNT FOC  
CABLE/STRAND WEIGHT = 4.5 N/m  
SHEAR LOAD = 397 lb  
BENDING MOMENT = 7452 lb-ft  
VERTICAL LOAD = 599 lb  
GROUNDLINE LOAD SUMMARY  
0.50" ICE + 37.0mph WIND AT -80.0'  
POLE CLASS = 3  
CONSTRUCTION GRADE = 2  
POLE SPECIES: SPP 30  
POLE YEAR: NO MARKING  
POLE HEIGHT: 60ft

HYDRO ONE ATTACHMENT ONLY  
HOT: 1 NEW 48 COUNT FOC  
CABLE/STRAND WEIGHT = 4.5 N/m  
SHEAR LOAD = 401 lb  
BENDING MOMENT = 9366 lb-ft  
VERTICAL LOAD = 605 lb  
GROUNDLINE LOAD SUMMARY  
0.50" ICE + 37.0mph WIND AT -80.0'  
POLE CLASS = 3  
CONSTRUCTION GRADE = 2  
POLE SPECIES: SPP 30  
POLE YEAR: NO MARKING  
POLE HEIGHT: 60ft

HYDRO ONE ATTACHMENT ONLY  
HOT: 1 NEW 48 COUNT FOC  
CABLE/STRAND WEIGHT = 2.7 N/m  
SHEAR LOAD = 378 lb  
BENDING MOMENT = 8187 lb-ft  
VERTICAL LOAD = 531 lb  
GROUNDLINE LOAD SUMMARY  
0.50" ICE + 37.0mph WIND AT -80.0'  
POLE CLASS = 3  
CONSTRUCTION GRADE = 2  
POLE SPECIES: SPP  
POLE YEAR: NO MARKING  
POLE HEIGHT: ASSUMED 60ft

**HYDRO ONE TELECOM ATTACHMENT CERTIFICATE**

THIS IS TO CERTIFY THAT THE CONSTRUCTION AS RECORDED IN THIS DRAWING MEETS THE APPLICABLE REQUIREMENTS OF THE SAFETY STANDARDS IN PART 4 OF REGULATION 22/04.

NAME: \_\_\_\_\_ DATE: \_\_\_\_\_

SIGNATURE & PROFESSIONAL DESIGNATION: \_\_\_\_\_

### REFERENCE DRAWINGS

CITY OF BRAMPTON

### LEGEND

NEW FIBER	
NEW STRAND	
OVERLASH	
EXISTING CONDUIT	
UNDERGROUND GAS LINE	
UNDERGROUND WATER	
UNDERGROUND HYDRO	
UNDERGROUND BELL	
UNDERGROUND CATV	
STORM SEWER	
SANITARY SEWER	
PROPERTY LINE	
FENCE	
DITCH	
EDGE OF PAVEMENT	
CURB	
GRAVEL SHOULDER	
NEW SPLICE	
EXISTING SPLICE	
VAULT	
BELL PEDESTAL	
CATV PEDESTAL	
TRANSFORMER	
CATCH BASIN	
WATER VALVE	
FIRE HYDRANT	
EXISTING POLE TO BE REMOVED	
STREET SIGN	
HYDRO POLE	
MANHOLE COVER	
MANHOLE & COVER	
LARGE ROCK	
TREE	
DIP LOCATION	
NEW DOWNGUY AND ANCHOR	
NEW SIDEWALK GUY	
NEW INTERIOR FIBER	
NEW BACKBOARD	
EXISTING BACKBOARD	
NEW PATCH PANEL	
EXISTING PATCH PANEL	
NEW EQUIPMENT RACK	
EXISTING EQUIPMENT RACK	
NEW FIBER COIL	

FIBER I.D.# BMTN-(CABLE I.D.)-(FIBRE COUNT)

THESE DRAWINGS ARE COPYRIGHT AND THE PROPERTY OF MAGNATE ENGINEERING AND ASSOCIATES INC. REPRODUCTION OF THESE DRAWINGS WITHOUT THE CONSENT OF MAGNATE ENGINEERING AND ASSOCIATES INC. IS STRICTLY PROHIBITED. DO NOT SCALE THESE DRAWINGS, ANY ERRORS OR DISCREPANCY IS TO BE REPORTED IMMEDIATELY TO MAGNATE ENGINEERING AND ASSOCIATES INC.

DATE	REVISION	BY
05/20/2009	ISSUED FOR PERMIT	YC

Hydro One Telecommunications

18 Automatic Road, Suite 1C  
Brampton, Ontario L6S 5N5  
Telephone: (905) 799-8220

CASTLEMORE RD - THE GORE RD TO HWY 50  
CITY OF BRAMPTON

PROJECT #	CONTRACTOR #	SCALE:
9H005007P		1:500
APPROVED BY:	DATE:	DWG
	05/20/09	13 OF 14
DRAWING NUMBER:		

**CERTIFICATE OF APPROVAL**

THE NEW INSTALLATION WORK COVERED BY THIS DOCUMENT MEETS THE SAFETY REQUIREMENTS OF SECTION 4 OF REGULATION 22/04, WITH CONSIDERATIONS OF THE FOLLOWING:

THE DESIGN CONFORMS TO CSA 22.3 NO 1-06 FOR HYDRO ONE TELECOM CLEARANCE, SEPARATION, GUYING AND STRAND TENSION. IT IS NOT INTENDED TO VERIFY THE INTEGRITY OF ATTACHMENTS, ANCHORING OR STRAND TENSIONS OF OTHERS, OR POLE STRENGTH.

POLES WERE NOT INVESTIGATED FOR DEFECTS/ROT.

NAME: \_\_\_\_\_ DATE: \_\_\_\_\_

SIGNATURE OF APPROVAL: \_\_\_\_\_

LICENSED PROFESSIONAL ENGINEER  
J.M. QUINTERO IRIARTE  
100079633  
Province of Ontario

FOR NEW CABLE ATTACHMENT TO HYDRO POLE ONLY, INCLUDING:  
TENSIONING FOR CLEARANCES AND NEW CABLE LOADS

18 Automatic Road Suite 1C  
Brampton, Ontario L6S 5N5  
Telephone: (905) 799-8220

### CONSTRUCTION NOTES

- 1 OVERLASH 108.8m OF 1-48 COUNT FIBER OPTIC CABLE ON EXISTING ASSUMED 1/4" EHS HOT STRAND.
- 2 INSTALL 2187.3m OF NEW 1/4" EHS STRAND, LASH 1-48 COUNT FIBER OPTIC CABLE.
- 3 INSTALL 545.3m OF NEW 1/4" EHS STRAND, LASH 1-48 COUNT FIBER OPTIC CABLE.
- 4
- 5
- A INSTALL NEW NEUTRAL BOND AND GROUND ROD, AND WIRE.
- B INSTALL NEW 10.0m LOOPBACK.
- C INSTALL NEW DOWNGUY AND ANCHOR.
- D INSTALL NEW RISER C/W U-GUARD.
- E INSTALL NEW HYDRO ONE SPULSE ENCLOSURE.
- F INSTALL NEW 1/4" OVERHEAD GUY.

### SCOPE OF WORK

NEW OVERHEAD GUY	3=61.5m
NEW DOWNGUY AND ANCHOR	9
NEW 48 COUNT FIBER OPTIC CABLE	2896.2m
NEW OVERLASH	108.8m
NEW LASHWIRE	8524.2m
NEW 1/4" EHS STRAND	2732.6m
NEW CATV MAKE READY	3
NEW HOT MAKE READY	1
NEW BELL MAKE READY	12
NEW HYDRO MAKE READY	2
NEW RISER C/W U-GUARD	2
NEW SPULSE ENCLOSURE	1
NEW GROUND ROD AND WIRE	11=110.0m

NOTE: INFORMATION WAS OBTAINED FROM DRAWINGS SUPPLIED BY:  
1. PHOTOGRAPHS OF PLAN AND PROFILE PROVIDED BY THE CITY OF BRAMPTON AND REGION OF PEEL.

**HYDRO ONE TELECOM CONTACT**  
IAN MITCHELL  
HYDRO ONE TELECOM INC  
65 KEELE STREET  
SCARBOROUGH, ONT. M1V 5A3  
PHONE: (416) 245-4370  
FAX: (416) 245-4320  
CELL: (416) 245-4320  
EMAIL: ian.mitchell@hydroone.com

### ANCHOR SPECIFICATIONS







ANCHOR TYPE	ANCHOR STRENGTH
SINGLE HELIX 8"	14000lbs
SINGLE HELIX 10"	20000lbs
SINGLE HELIX 12"	25000lbs
SINGLE HELIX 14"	31000lbs
TRIPLE HELIX, 8"-10"-12"	46000lbs

CALCULATION FOR REQUIRED STRENGTH OF ANCHOR IS BASED ON -20" WITH 0.5" OF ICE AND SOIL CLASS 4 (MEDIUM DENSE SANDY GRAVEL; VERY STIFF TO HARD SILTS AND CLAYS).

### GENERAL NOTES AERIAL DESIGN AND CONSTRUCTION

1. ALL CONSTRUCTION WORK SHALL BE IN CONFORMANCE WITH CANADIAN, PROVINCIAL AND ONTARIO HYDRO SERVICES COMPANY SAFETY REQUIREMENTS. THESE INCLUDE: WITHOUT LIMITATION:
  - OHSC WORK PROTECTION CODE
  - OCCUPATIONAL HEALTH AND SAFETY ACT
  - THIS DESIGN CONFORMS TO CSA STANDARD C22.3 NO. 1-06.
2. TAKE THE NECESSARY PRECAUTIONS TO PROTECT THE EXISTING INSTALLATION FROM DAMAGE. THE CONTRACTOR WILL BE RESPONSIBLE FOR ALL THE CLAIMS DUE TO DAMAGE.
3. ALL REVISIONS MUST BE MADE PRIOR TO CONSTRUCTION.
4. ALL BOLTS MUST PROVIDE FOR 25mm OF EXPOSED THREAD.
5. ASSUME SOIL CONDITIONS AT ANCHOR POINT ARE AS FOLLOWS:
  - MEDIUM DENSE SANDY GRAVEL; VERY STIFF TO HARD SILTS AND CLAYS.
6. THE CONTRACTOR SHALL CHECK AND VERIFY ALL SITE CONDITIONS, CLEARANCES AND DIMENSIONS AT THE SITE AND REPORT ANY DISCREPANCIES TO THE ENGINEER BEFORE PROCEEDING WITH WORK.
7. SAGS & CLEARANCES ARE CHECKED AND CALCULATED FOR NEW ATTACHMENTS ONLY.
8. POLES NOT CHECKED FOR OVERALL LOADING. ADDITIONAL APPLIED LOADS ARE SHOWN ON THIS DRAWING DUE TO NEW ATTACHMENTS ONLY.
9. THE CONTRACTOR SHALL ENSURE THAT THE COMMUNICATION STRAND OR MESSENGER IS BONDED TO THE DISTRIBUTION SYSTEM NEUTRAL AT EVERY DIP LOCATION & EVERY 300 METRES.
10. VISIT THE SITE TO CHECK ON AVAILABLE ACCESS, STORAGE AND WORKING AREAS. DETERMINE ANY INTERFERENCE WITH EXISTING SERVICES.
11. SPIRAL WRAP AND TAG ALL EXPOSED FIBER OPTIC CABLE, INCLUDING: DRIP LOOPS, ENDS OF LOOPBACKS & DIPS ABOVE U-GUARDS.
12. AERIAL STRAND SHALL BE 1/4" EHS STRAND, 7-WIRE ZINC COATED, OR 3/8" EHS STRAND, 7-WIRE ZINC COATED, UNLESS NOTED OTHERWISE.
13. LOCATIONS AND DETAILS SHOWN ON THIS DRAWING ARE BASED ON THE BEST INFORMATION AVAILABLE AT TIME OF SURVEY. CONFIRM ALL LOCATIONS, CLEARANCES, AND INTERFERENCES ON SITE PRIOR TO BEGINNING WORK.
14. POLES WERE NOT VERIFIED FOR DECAY, OR DEFICIENCIES DUE TO THE INSTALLATION OF EXISTING ATTACHMENTS.
15. CONTRACTOR TO CONTACT THE ENGINEER IF THE HYDRO LINE ABOVE THE NEW ATTACHMENT HAS A SAG LARGER THAN 1000mm OR IF THE VOLTAGE IS HIGHER THAN 750V.
16. MAKE GOOD ALL EXISTING FINISHES WHEN WORK IS COMPLETE.
17. THE POSITION OF POLE LINES, CONDUITS, WATERMANS, SEWERS AND OTHER UNDERGROUND AND ABOVE GROUND UTILITIES AND STRUCTURES ARE NOT NECESSARILY SHOWN ON THE CONTRACT DRAWINGS, AND WHERE SHOWN, THE ACCURACY OF THE POSITION OF SUCH UTILITIES AND STRUCTURES IS NOT GUARANTEED. BEFORE STARTING WORK, THE CONTRACTOR SHALL CONFIRM THE EXACT LOCATION OF ALL SUCH UTILITIES AND STRUCTURES, AND SHALL ASSUME ALL LIABILITY FOR DAMAGE TO THEM.
18. ALL THE MATERIAL AND EQUIPMENT TO BE ESA AND CSA APPROVED.
19. CONTRACTOR TO USE DOWNGUY SPLITTERS AS REQUIRED IN ORDER TO AVOID CONTACT WITH POWER LINES.
20. ANALYSIS WAS PERFORMED USING THE DETERMINISTIC METHOD ASSUMING THAT THE HIGHEST VOLTAGE OF ANY OF THE EXISTING SUPPLY LINES IS LESS THAN 70 KV PHASE TO PHASE.
21. WHERE EXISTING COMMUNICATIONS ATTACHMENTS ARE SHOWN TO BE RELOCATED, THE THIRD PARTY OWNER OF THE ATTACHMENT MUST BE CONTACTED TO REVIEW AND ENSURE MINIMUM CLEARANCES ARE MAINTAINED IN ACCORDANCE WITH APPLICABLE STANDARDS.

RECORD OF INSPECTION BY CONSTRUCTOR	
AS CONSTRUCTED	<input type="checkbox"/> Aerial Installation
	<input type="checkbox"/> U/G Installation
With changes shown on this Drawing	
Attachment Owner	Permit #
	Date
	Company Name
	Print Name
	Position
	Signature
<input type="checkbox"/> This is to certify that the construction as recorded in this drawing is consistent with the approved plan, Standard Designs, or work instruction and that approved equipment has been used.	

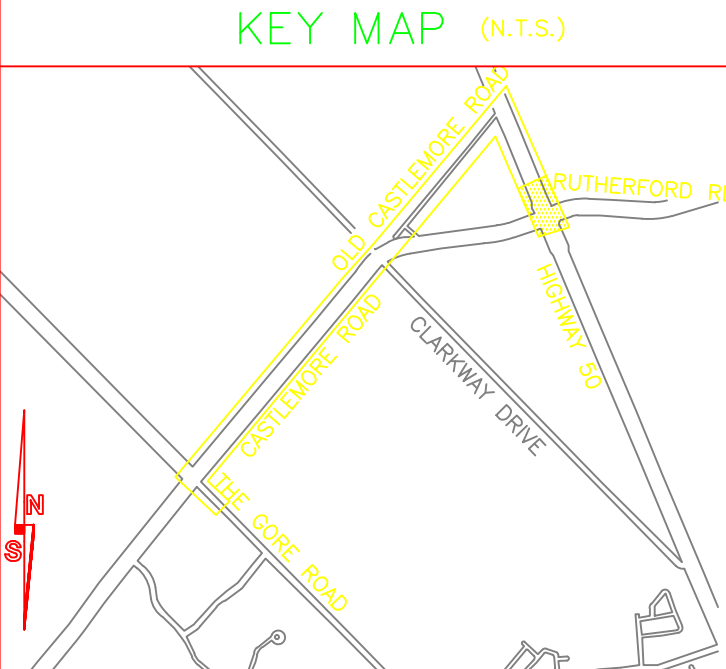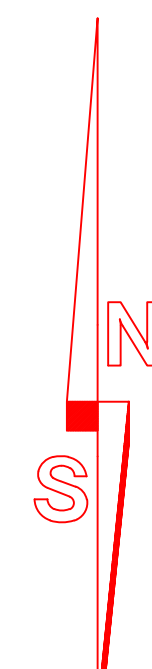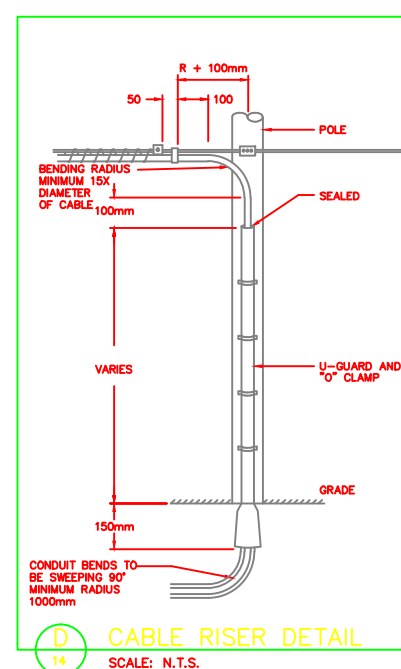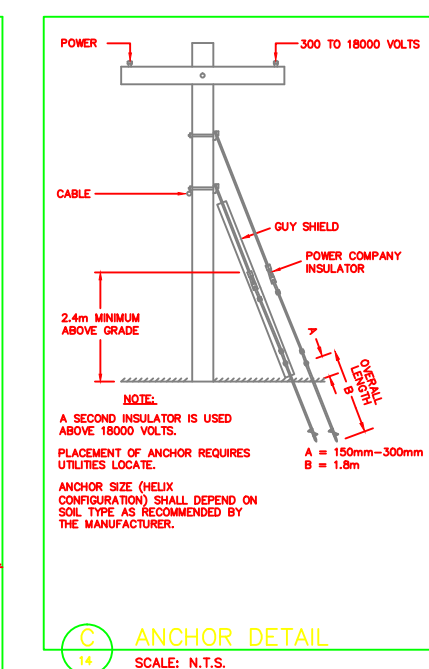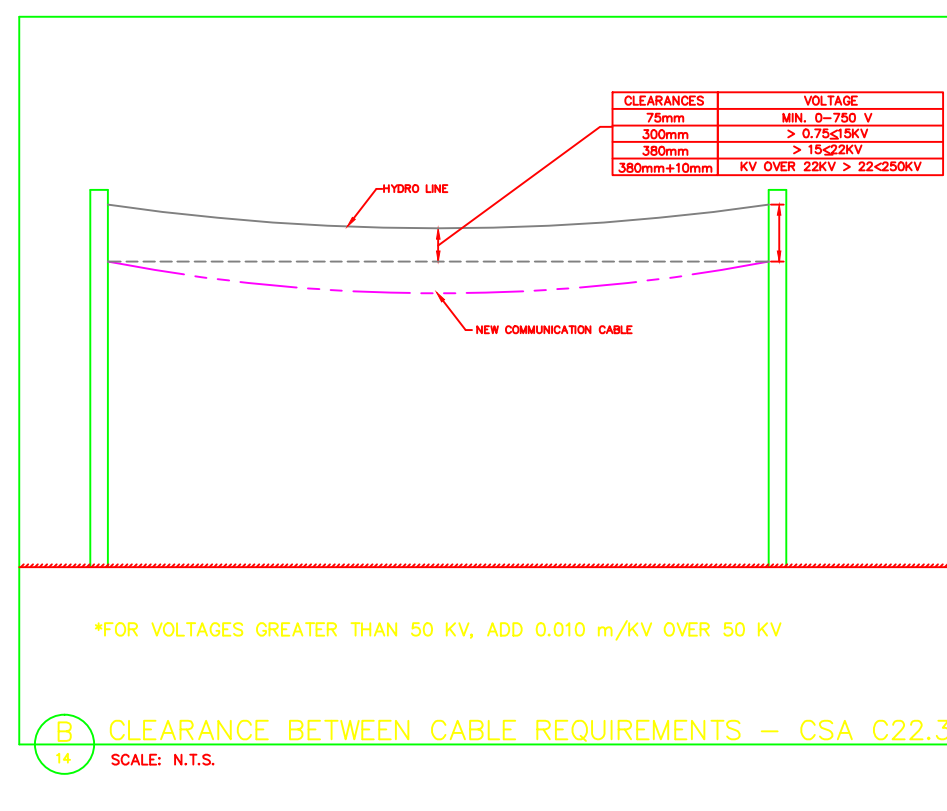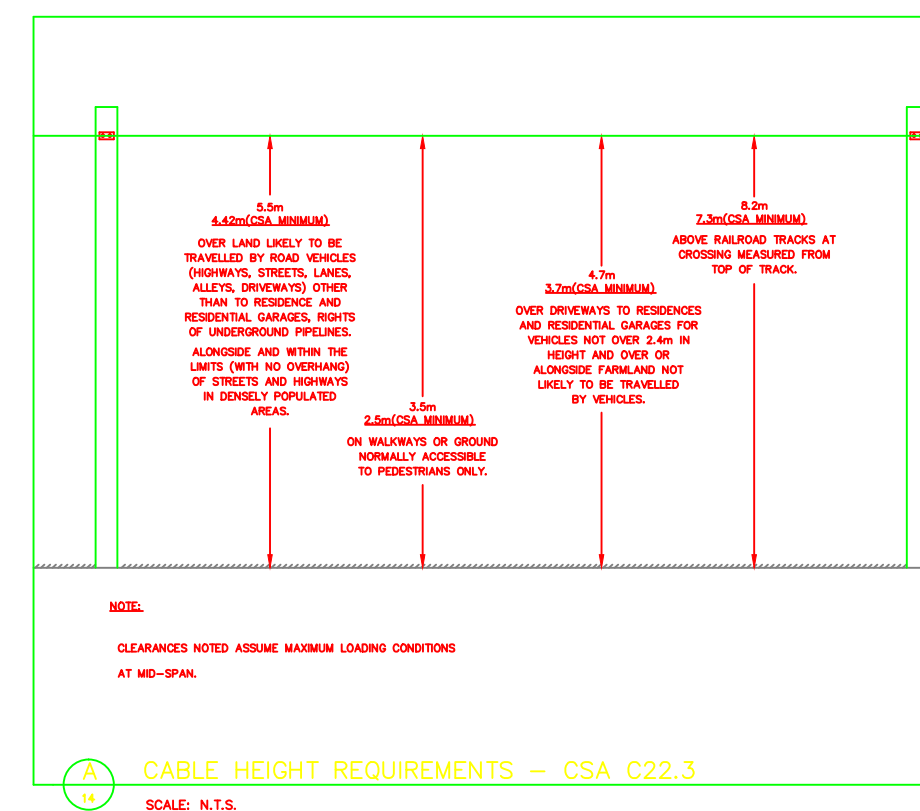


### REFERENCE DRAWINGS

CITY OF BRAMPTON

### LEGEND

NEW FIBER	---
NEW STRAND	-----
OVERLASH	=====
EXISTING CONDUIT	-----
UNDERGROUND GAS LINE	-G-
UNDERGROUND WATER	-W-
UNDERGROUND HYDRO	-H-
UNDERGROUND BELL	-BC-
UNDERGROUND CATV	-MC-
STORM SEWER	-ST-
SANITARY SEWER	-SS-
PROPERTY LINE	-P/L-
FENCE	---
DITCH	---
EDGE OF PAVEMENT	-E/P-
CURB	---
GRAVEL SHOULDER	---
NEW SPLICE	▶▶
EXISTING SPLICE	◀◀
VAULT	◻
BELL PEDESTAL	■
CATV PEDESTAL	■
TRANSFORMER	■
CATCH BASIN	■
WATER VALVE	■
FIRE HYDRANT	■
EXISTING POLE TO BE REMOVED	⊙
STREET SIGN	⊙
HYDRO POLE	⊙
MANHOLE COVER	⊙
MANHOLE & COVER	⊙
LARGE ROCK	⊙
TREE	⊙
DIP LOCATION	⊙
NEW DOWNGUY AND ANCHOR	▶
NEW SIDEWALK GUY	▶
NEW INTERIOR FIBER	---
NEW BACKBOARD	---
EXISTING BACKBOARD	---
NEW PATCH PANEL	---
EXISTING PATCH PANEL	---
NEW EQUIPMENT RACK	---
EXISTING EQUIPMENT RACK	---
NEW FIBER COIL	---

EXTERNAL  
INTERNAL

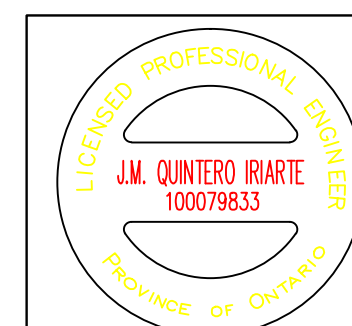

FOR NEW CABLE ATTACHMENT TO HYDRO POLE ONLY, INCLUDING:  
TENSIONING FOR CLEARANCES AND NEW CABLE LOADS




18 Automatic Road Suite 1C  
Brampton, Ontario L6S 5N5  
Telephone: (905) 799-8220

### HYDRO ONE TELECOM ATTACHMENT CERTIFICATE

THIS IS TO CERTIFY THAT THE CONSTRUCTION AS RECORDED IN THIS DRAWING MEETS THE APPLICABLE REQUIREMENTS OF THE SAFETY STANDARDS IN PART 4 OF REGULATION 22/04.

NAME \_\_\_\_\_ DATE \_\_\_\_\_

SIGNATURE & PROFESSIONAL DESIGNATION \_\_\_\_\_

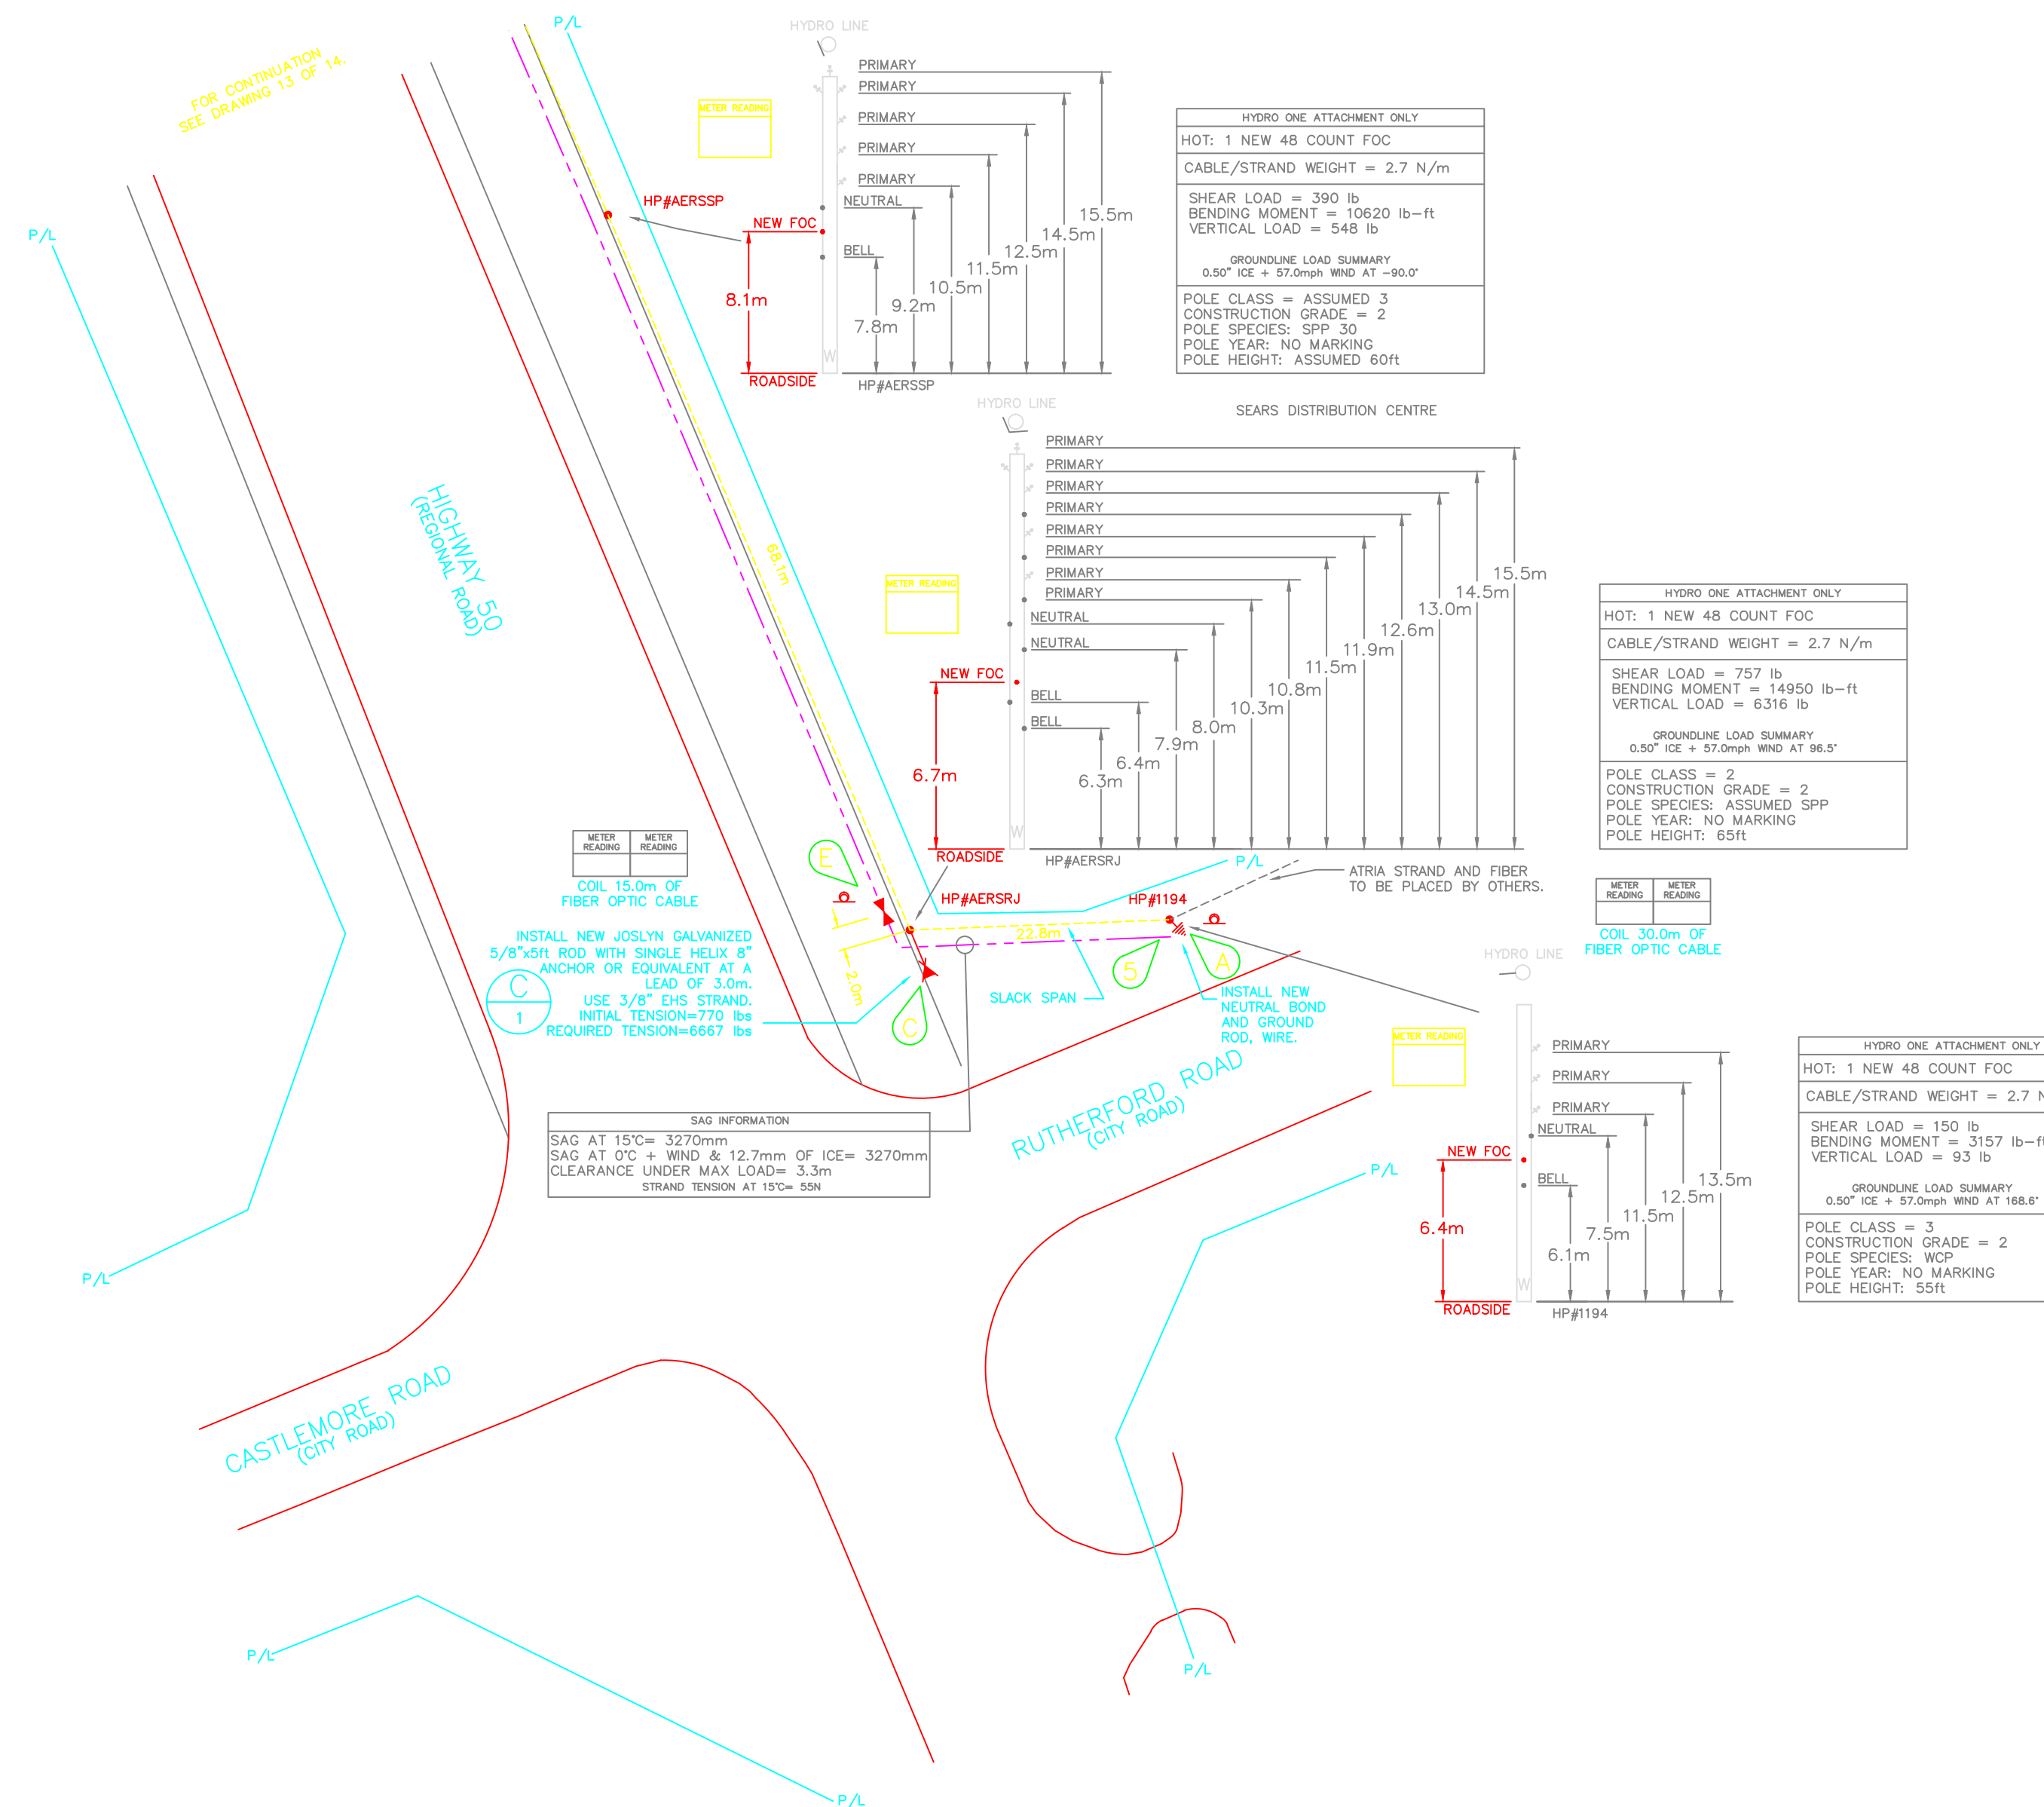

### CERTIFICATE OF APPROVAL

THE NEW INSTALLATION WORK COVERED BY THIS DOCUMENT MEETS THE SAFETY REQUIREMENTS OF SECTION 4 OF REGULATION 22/04, WITH CONSIDERATIONS OF THE FOLLOWING:

THE DESIGN CONFORMS TO CSA 22.3 NO. 1-06 FOR HYDRO ONE TELECOM CLEARANCE, SEPARATION, GUYING AND STRAND TENSION. IT IS NOT INTENDED TO VERIFY THE INTEGRITY OF ATTACHMENTS, ANCHORING OR STRAND TENSIONS OF OTHERS, OR POLE STRENGTH.

POLES WERE NOT INVESTIGATED FOR DEFECTS/ROT.

NAME: \_\_\_\_\_ DATE: \_\_\_\_\_

SIGNATURE OF APPROVAL: \_\_\_\_\_



18 Automatic Road, Suite 1C  
Brampton, Ontario L6S 5N5  
Telephone: (905) 799-8220

CASTLEMORE RD - THE GORE RD TO HWY 50  
CITY OF BRAMPTON

PROJECT #	CONTRACTOR #	SCALE
05/20/2009	9H005007P	1:500
APPROVED BY:	DATE:	DWG
	05/20/09	14 OF 14
DRAWING NUMBER:		

## CONSTRUCTION NOTES

- DIRECTIONAL BORE 100.2m AND INSTALL 1-38mm HDPE CONDUIT WITH 1-48 COUNT FIBER OPTIC CABLE. PLACE TRACE WIRE.

## SCOPE OF WORK

NEW 48 COUNT FIBER OPTIC CABLE	100.2m
NEW 38mm HDPE CONDUIT	100.2m
NEW DIRECTIONAL BORE	100.2m






NOTE:  
 INFORMATION WAS OBTAINED FROM DRAWINGS SUPPLIED BY:  
 1. PHOTOGRAPHS OF PLANS AND PROFILES PROVIDED BY THE CITY OF BRAMPTON AND REGION OF PEEL.

**HYDRO ONE TELECOM CONTACT**  
 IAN MITCHELL  
 HYDRO ONE TELECOM INC  
 65 KEELEF STREET  
 REGINALE, ONT, M9W 5A3  
 PHONE: (416) 240-8700  
 FAX: (416) 240-8700  
 CELL: (647) 287-3007  
 EMAIL: ian.mitchell@hydroone.com

NOTE:  
 1. DO NOT EXCAVATE OR DISTURB EXISTING GROUND SURFACES PRIOR TO OBTAINING LOCATES AND CLEARANCES FOR ALL EXISTING SERVICES, INCLUDING SERVICES ON PRIVATE PROPERTY.  
 2. LOCATIONS AND DETAILS SHOWN ON THIS DRAWING ARE BASED ON THE BEST INFORMATION AVAILABLE AT TIME OF SURVEY. CONFIRM ALL LOCATIONS, CLEARANCES, AND INTERFERENCES ON SITE PRIOR TO BEGINNING WORK.

## GENERAL NOTES UNDERGROUND DESIGN AND CONSTRUCTION

- ALL CONSTRUCTION WORK SHALL BE IN CONFORMANCE WITH CANADIAN, PROVINCIAL AND ONTARIO HYDRO SERVICES COMPANY SAFETY REQUIREMENTS. THESE INCLUDE WITHOUT LIMITATION:
  - OHSC WORK PROTECTION CODE
  - OCCUPATIONAL HEALTH AND SAFETY ACT
  - THIS DESIGN CONFORMS TO CSA STANDARD C22.3 NO. 7-06.
- TAKE THE NECESSARY PRECAUTIONS TO PROTECT THE EXISTING INSTALLATION FROM DAMAGE. THE CONTRACTOR WILL BE RESPONSIBLE FOR ALL THE CLAIMS DUE TO DAMAGE.
- ALL DIMENSIONS MUST BE VERIFIED ON SITE BEFORE WORK COMMENCES.
- ALL WORK TO BE PERFORMED IN ACCORDANCE WITH SPECIFICATIONS AND DRAWINGS.
- ALL REVISIONS MUST BE MADE PRIOR TO CONSTRUCTION.
- THE CONTRACTOR SHALL CHECK AND VERIFY ALL SITE CONDITIONS, CLEARANCES AND DIMENSIONS AT THE SITE AND REPORT ANY DISCREPANCIES TO THE ENGINEER BEFORE PROCEEDING WITH WORK.
- VISIT THE SITE TO CHECK ON AVAILABLE ACCESS, STORAGE AND WORKING AREAS. DETERMINE ANY INTERFERENCE WITH EXISTING SERVICES.
- SPIRAL WRAP AND TAG ALL EXPOSED FIBER OPTIC CABLE IN MANHOLES OR HANDHOLES.
- ALL DUCT BENDS ARE SWEEP 90 DEGREES, MINIMUM RADIUS IS 300mm.
- DO NOT EXCAVATE OR DISTURB EXISTING GROUND SURFACES PRIOR TO OBTAINING LOCATES AND CLEARANCES FOR ALL EXISTING SERVICES, INCLUDING SERVICES ON PRIVATE PROPERTY.
- LOCATIONS AND DETAILS SHOWN ON THIS DRAWING ARE BASED ON THE BEST INFORMATION AVAILABLE AT TIME OF SURVEY. CONFIRM ALL LOCATIONS, CLEARANCES, AND INTERFERENCES ON SITE PRIOR TO BEGINNING WORK.
- MAKE GOOD ALL EXISTING FINISHES WHEN WORK IS COMPLETE.
- THE POSITION OF POLE LINES, CONDUITS, WATERMANS, SEWERS AND OTHER UNDERGROUND AND ABOVE GROUND UTILITIES AND STRUCTURES ARE NOT NECESSARILY SHOWN ON THE CONTRACT DRAWINGS, AND WHERE SHOWN, THE ACCURACY OF THE POSITION OF SUCH UTILITIES AND STRUCTURES IS NOT GUARANTEED. BEFORE STARTING WORK, THE CONTRACTOR SHALL CONFIRM THE EXACT LOCATION OF ALL SUCH UTILITIES AND STRUCTURES, AND SHALL ASSUME ALL LIABILITY FOR DAMAGE TO THEM.

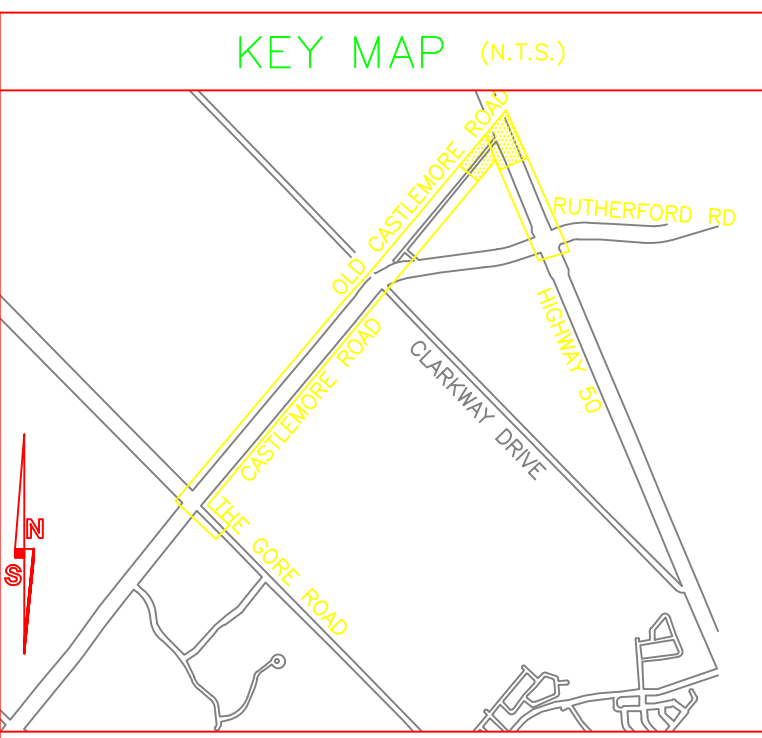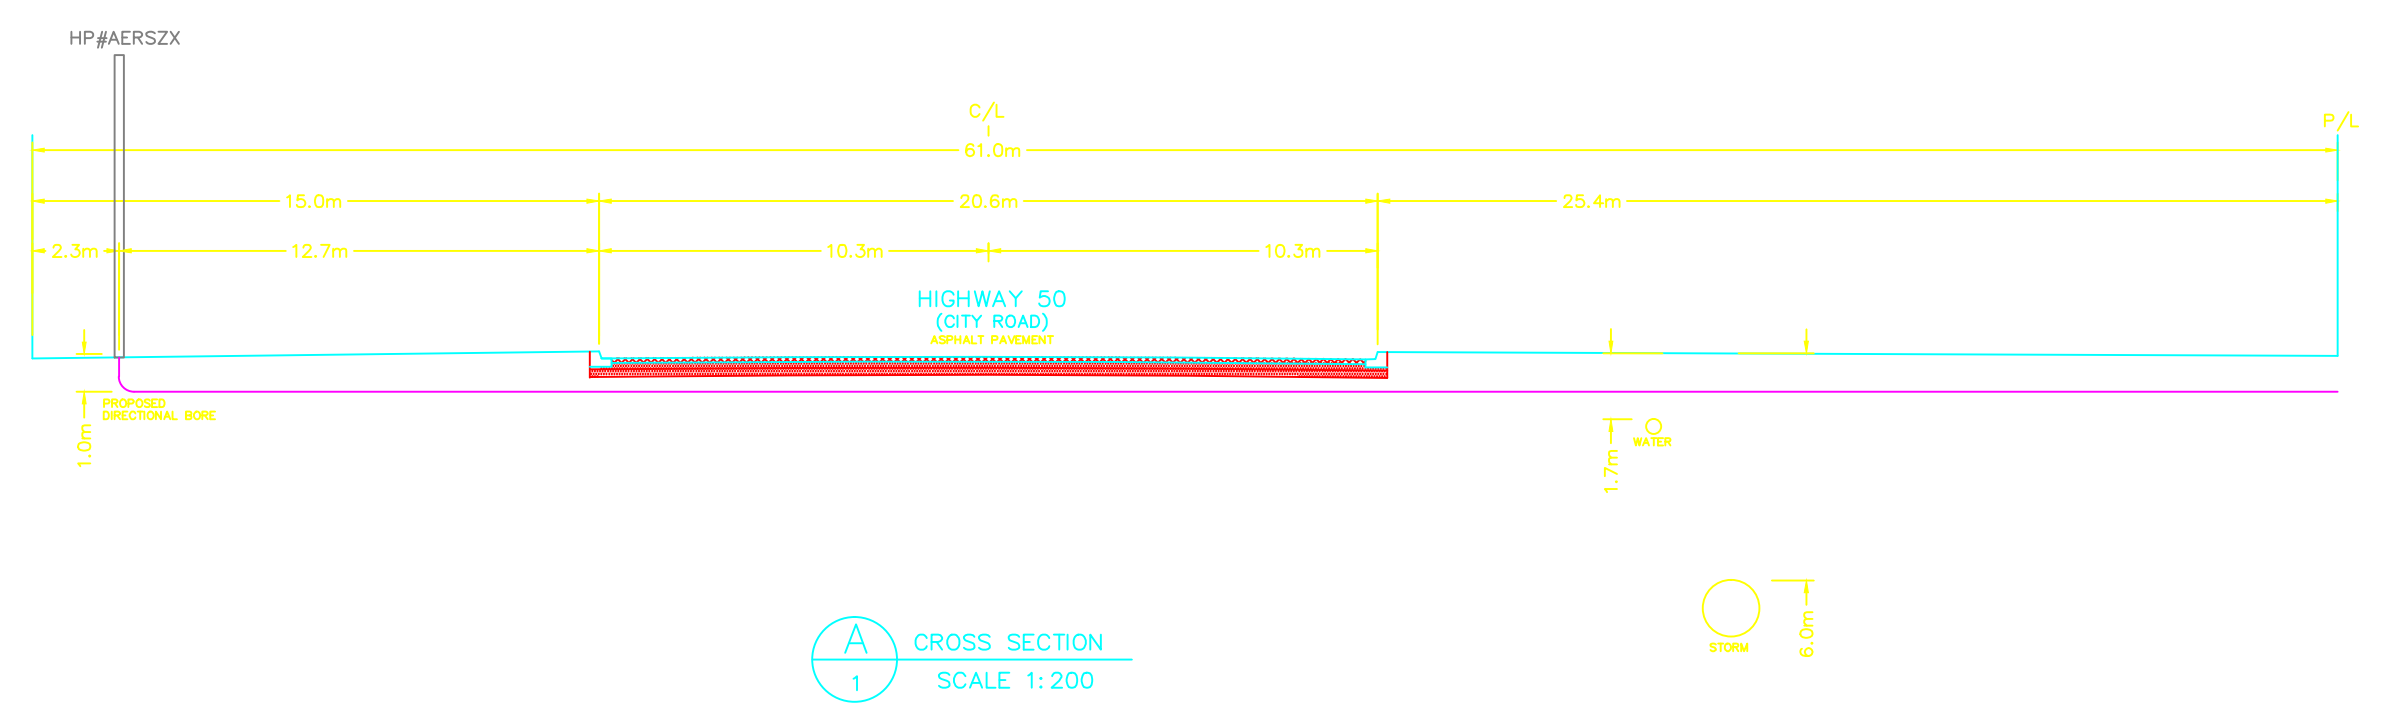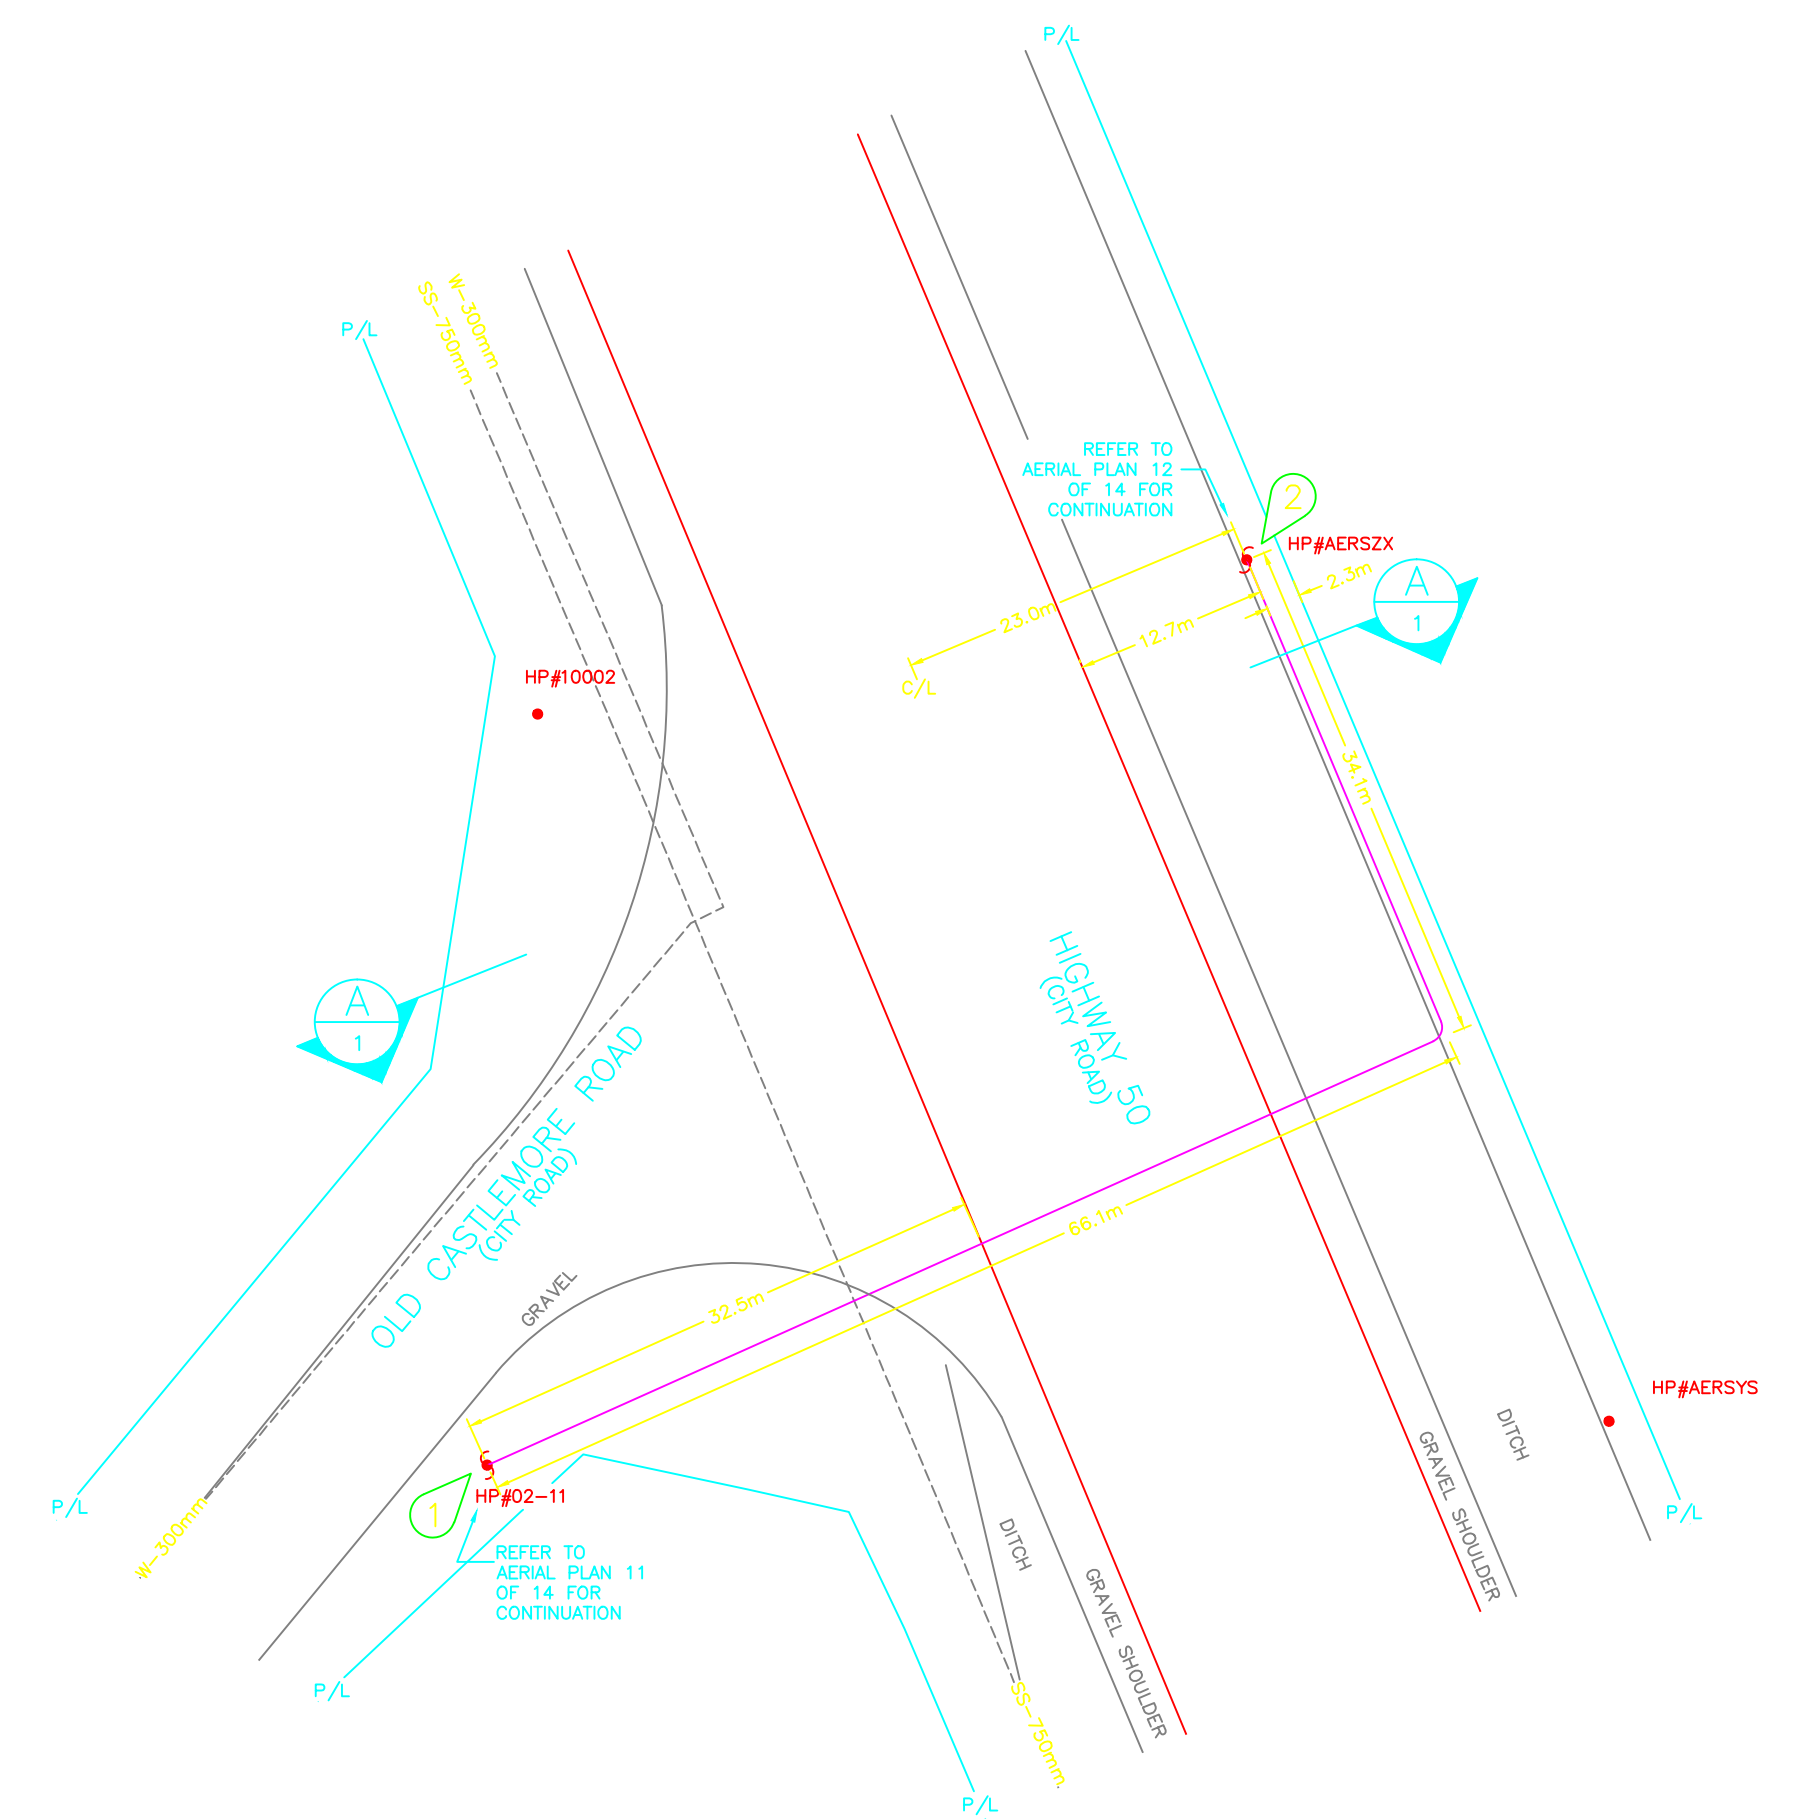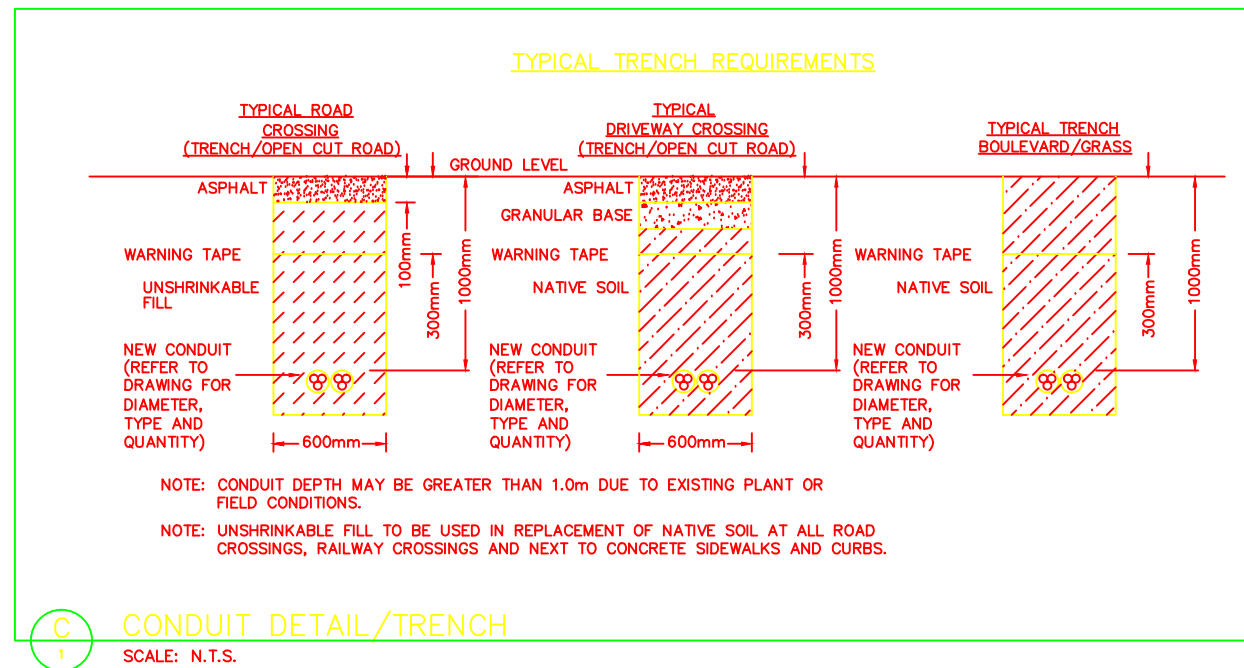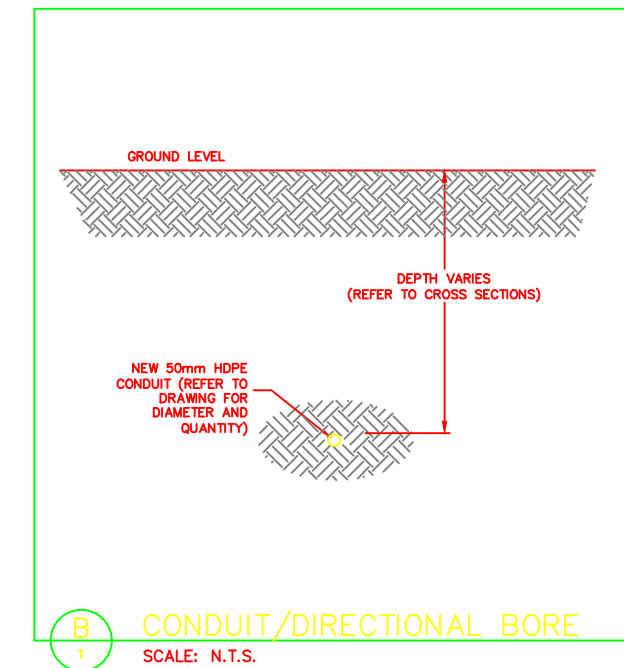

## REFERENCE DRAWINGS

CITY OF BRAMPTON

## LEGEND

NEW FIBER	---
NEW STRAND	----
OVERLASH	----
EXISTING CONDUIT	----
UNDERGROUND GAS LINE	-G-
UNDERGROUND WATER	-W-
UNDERGROUND HYDRO	-H-
UNDERGROUND BELL	-BC-
UNDERGROUND CATV	-BC-
STORM SEWER	-ST-
SANITARY SEWER	-SS-
PROPERTY LINE	-P/L-
FENCE	---
DITCH	---
EDGE OF PAVEMENT	-E/P-
CURB	---
GRAVEL SHOULDER	---
NEW SPLICE	⊕
EXISTING SPLICE	⊕
VAULT	⊕
BELL PEDESTAL	⊕
CATV PEDESTAL	⊕
TRANSFORMER	⊕
CATCH BASIN	⊕
WATER VALVE	⊕
FIRE HYDRANT	⊕
EXISTING POLE TO BE REMOVED	⊕
STREET SIGN	⊕
HYDRO POLE	⊕
MANHOLE COVER	⊕
MANHOLE & COVER	⊕
LARGE ROCK	⊕
TREE	⊕
DIP LOCATION	⊕
NEW DOWNGUY AND ANCHOR	⊕
NEW SIDEWALK GUY	⊕
NEW INTERIOR FIBER	---
NEW BACKBOARD	---
EXISTING BACKBOARD	---
NEW PATCH PANEL	---
EXISTING PATCH PANEL	---
NEW EQUIPMENT RACK	---
EXISTING EQUIPMENT RACK	---
NEW FIBER COIL	---

FIBER I.D.# BMTN-(CABLE I.D.)-(FIBRE COUNT)  
 THESE DRAWINGS ARE COPYRIGHT AND THE PROPERTY OF MAGNATE ENGINEERING AND ASSOCIATES INC. REPRODUCTION OF THESE DRAWINGS WITHOUT THE CONSENT OF MAGNATE ENGINEERING AND ASSOCIATES INC. IS STRICTLY PROHIBITED. DO NOT SCALE THESE DRAWINGS, ANY ERRORS, OR DISCREPANCY IS TO BE REPORTED IMMEDIATELY TO MAGNATE ENGINEERING AND ASSOCIATES INC.

05/20/2009	ISSUED FOR PERMIT	YC
DATE	REVISION	BY

**hydro one**  
 Hydro One Telecommunications  
 Hydro One Telecom Inc.  
 65 Keele Street  
 Toronto, Ontario, M9W 5A3

**MAGNATE**  
 ENGINEERING AND ASSOCIATES INC.  
 18 Automatic Road, Suite 1C  
 Brampton, Ontario L6S 5N5  
 Telephone: (905) 799-8220

## OLD CASTLEMORE RD & HWY 50 CITY OF BRAMPTON

PROJECT #	CONTRACTOR #	SCALE:
	9H005007P	1:500
APPROVED BY:	DATE:	DWG 1 OF 1
	05/20/09	
DRAWING NUMBER:		



**Hydro One Telecom Inc.**  
65 Kelfield Street  
Rexdale, Ontario M9W 5A3  
www.HydroOne.com



August 10, 2011

Attn: Nathalie Baudais, P.Eng.  
Project Coordinator  
HDR\iTRANS  
100 York Blvd. Suite 300  
Richmond Hill, ON L4B 1J8

**RE: Notification of Potential Utility Impacts  
Hwy 50, Castlemore Rd to Mayfield Rd  
Mayfield Rd, Coleraine Dr to Hwy 50  
Class Environmental Assessment Study**

---

Hydro One Telecom has U/G fiber optic cable only at Castlemore Rd & Hwy 50 intersection, as per attached plans. No future work is planned in this area.


Please contact the undersigned should you have any questions or need additional information with regard to this project.

Yours truly,

A handwritten signature in cursive script that reads "B. Mahon".

Barbara Mahon  
PUCC Coordinator  
Hydro One Telecom  
Tel: 416-240-6842  
Fax: 416-240-6790



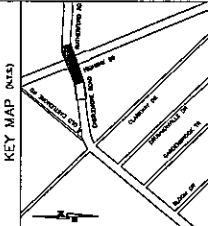

REFERENCE DRAWINGS  
CITY OF BRAMPTON




LEGEND

NEW PAVEMENT	EXISTING PAVEMENT
NEW DRIVE	EXISTING DRIVE
NEW SIDEWALK	EXISTING SIDEWALK
NEW BIKEWAY	EXISTING BIKEWAY
NEW STREET LIGHT	EXISTING STREET LIGHT
NEW STOP SIGN	EXISTING STOP SIGN
NEW SIGN	EXISTING SIGN
NEW LIGHT FIXTURE	EXISTING LIGHT FIXTURE
NEW ELECTRICAL	EXISTING ELECTRICAL
NEW TELEPHONE	EXISTING TELEPHONE
NEW FIBER OPTIC	EXISTING FIBER OPTIC
NEW SANITARY	EXISTING SANITARY
NEW WATER	EXISTING WATER
NEW GAS	EXISTING GAS
NEW CABLE TV	EXISTING CABLE TV
NEW POWER	EXISTING POWER
NEW TELEVISION	EXISTING TELEVISION
NEW COMMUNICATIONS	EXISTING COMMUNICATIONS
NEW SECURITY	EXISTING SECURITY
NEW SATELLITE	EXISTING SATELLITE
NEW RADIOTELEPHONE	EXISTING RADIOTELEPHONE
NEW WIRELESS	EXISTING WIRELESS
NEW MOBILE	EXISTING MOBILE
NEW PERSONAL	EXISTING PERSONAL
NEW COMMERCIAL	EXISTING COMMERCIAL
NEW INDUSTRIAL	EXISTING INDUSTRIAL
NEW RESIDENTIAL	EXISTING RESIDENTIAL
NEW MUNICIPAL	EXISTING MUNICIPAL
NEW CITY	EXISTING CITY
NEW STATE	EXISTING STATE
NEW FEDERAL	EXISTING FEDERAL
NEW TRANSFORMER	EXISTING TRANSFORMER
NEW METER	EXISTING METER
NEW VALVE	EXISTING VALVE
NEW TAP	EXISTING TAP
NEW PUMP	EXISTING PUMP
NEW STORAGE	EXISTING STORAGE
NEW DISTRIBUTION	EXISTING DISTRIBUTION
NEW COLLECTION	EXISTING COLLECTION
NEW TREATMENT	EXISTING TREATMENT
NEW CONDUIT	EXISTING CONDUIT
NEW MANHOLE	EXISTING MANHOLE
NEW JUNCTION	EXISTING JUNCTION
NEW CROSSING	EXISTING CROSSING
NEW OVERPASS	EXISTING OVERPASS
NEW UNDERPASS	EXISTING UNDERPASS
NEW BRIDGE	EXISTING BRIDGE
NEW TUNNEL	EXISTING TUNNEL
NEW STRUCTURE	EXISTING STRUCTURE
NEW FOUNDATION	EXISTING FOUNDATION
NEW WALL	EXISTING WALL
NEW FENCE	EXISTING FENCE
NEW GATE	EXISTING GATE
NEW SIGNAGE	EXISTING SIGNAGE
NEW LIGHTING	EXISTING LIGHTING
NEW SOUNDING	EXISTING SOUNDING
NEW VIBRATION	EXISTING VIBRATION
NEW THERMAL	EXISTING THERMAL
NEW ACoustic	EXISTING ACoustic
NEW ELECTRICAL	EXISTING ELECTRICAL
NEW TELEPHONE	EXISTING TELEPHONE
NEW FIBER OPTIC	EXISTING FIBER OPTIC
NEW SANITARY	EXISTING SANITARY
NEW WATER	EXISTING WATER
NEW GAS	EXISTING GAS
NEW CABLE TV	EXISTING CABLE TV
NEW POWER	EXISTING POWER
NEW TELEVISION	EXISTING TELEVISION
NEW RADIOTELEPHONE	EXISTING RADIOTELEPHONE
NEW WIRELESS	EXISTING WIRELESS
NEW MOBILE	EXISTING MOBILE
NEW PERSONAL	EXISTING PERSONAL
NEW COMMERCIAL	EXISTING COMMERCIAL
NEW INDUSTRIAL	EXISTING INDUSTRIAL
NEW RESIDENTIAL	EXISTING RESIDENTIAL
NEW MUNICIPAL	EXISTING MUNICIPAL
NEW CITY	EXISTING CITY
NEW STATE	EXISTING STATE
NEW FEDERAL	EXISTING FEDERAL

hydro one  
Hydro One Telecommunications

GENIVAR

CASTLEMORE RD AND HWY 50  
CITY OF BRAMPTON  
PROJECT # 160800082  
DATE 04/05/11  
DWS 2 OF 3

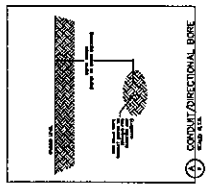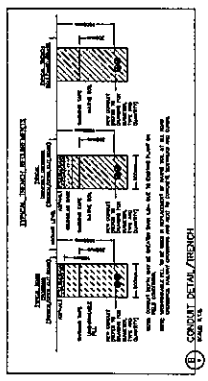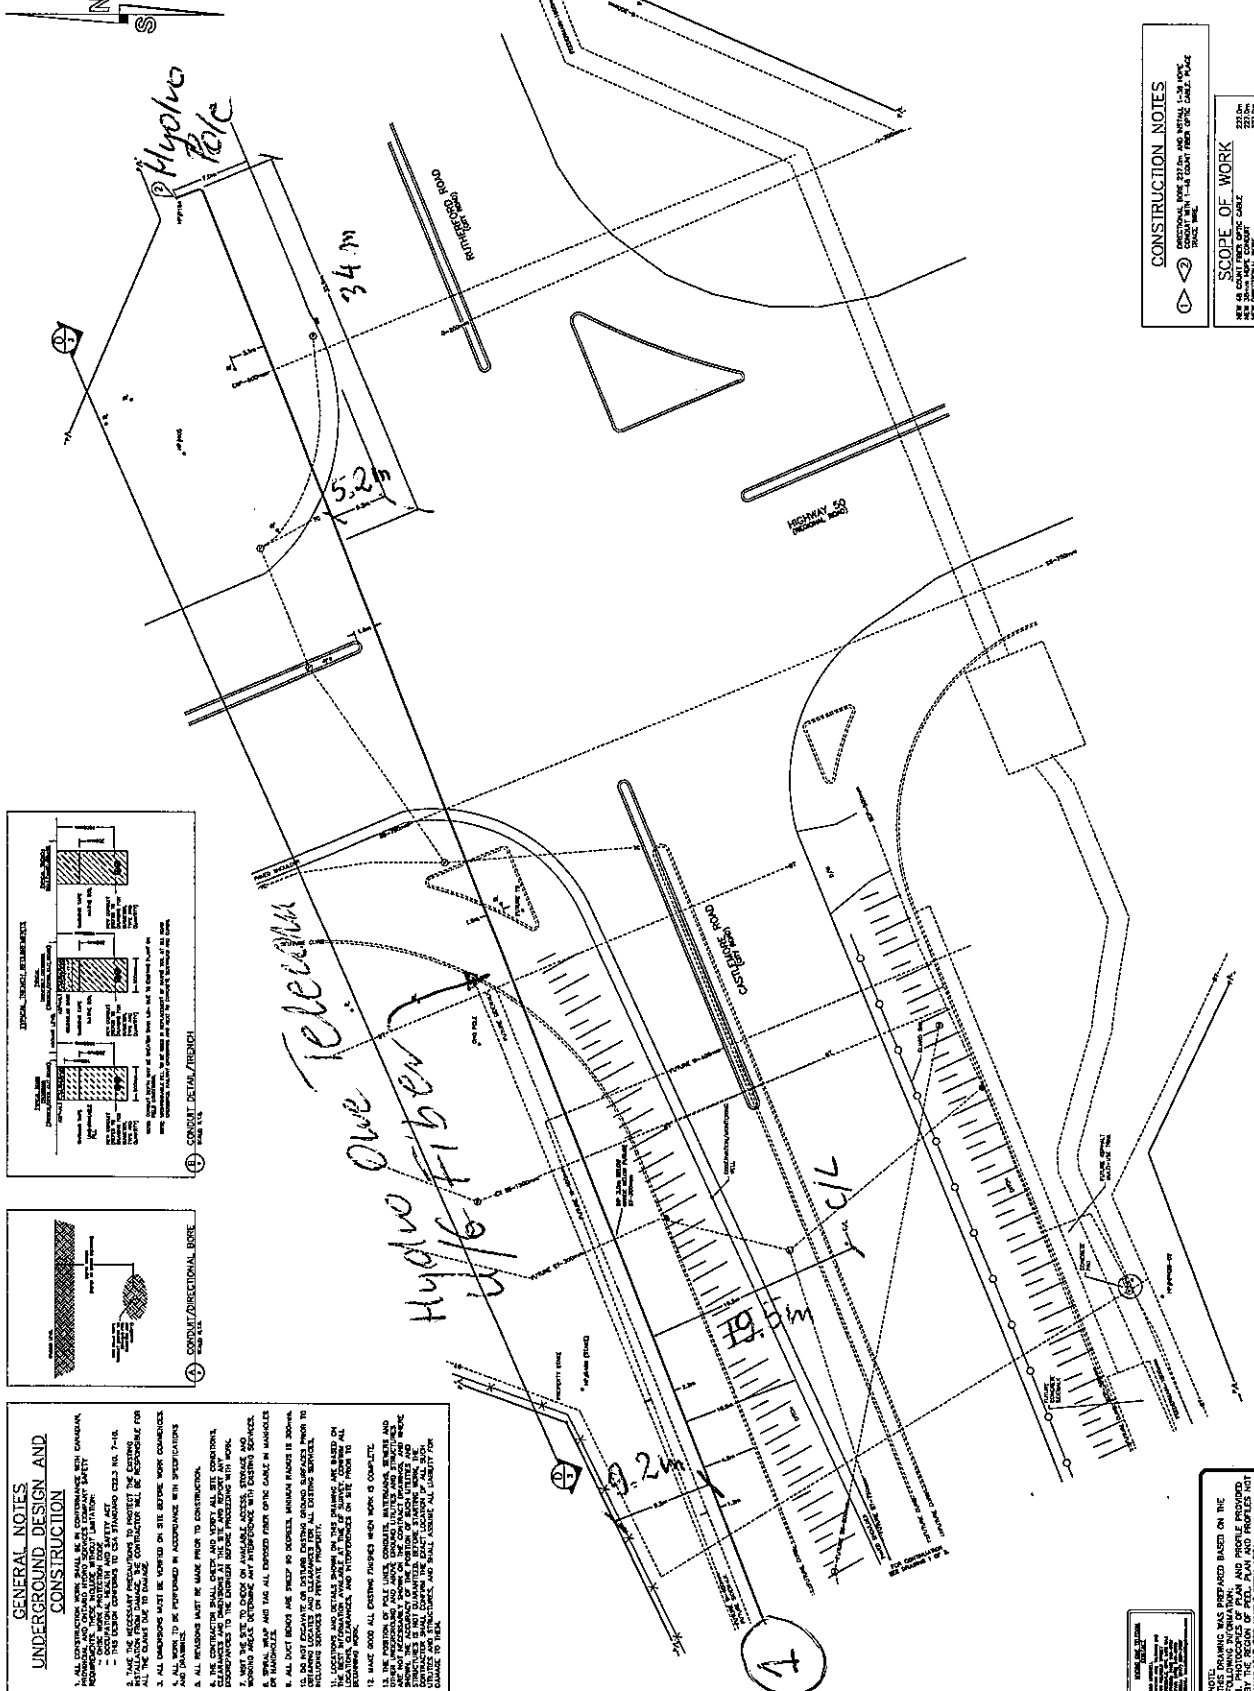

**GENERAL NOTES**  
**UNDERGROUND DESIGN AND CONSTRUCTION**

1. ALL CONSTRUCTION WORK SHALL BE IN ACCORDANCE WITH CANADIAN STANDARDS ASSOCIATION (CSA) STANDARDS AND THE CITY OF BRAMPTON STANDARD SPECIFICATIONS FOR UNDERGROUND UTILITIES.
2. THE DESIGN CONFORMS TO CANADIAN STANDARDS ASSOCIATION (CSA) STANDARDS FOR UNDERGROUND UTILITIES.
3. ALL WORK SHALL BE PERFORMED IN ACCORDANCE WITH SPECIFICATIONS AND STANDARDS.
4. ALL WORK SHALL BE PERFORMED IN ACCORDANCE WITH SPECIFICATIONS AND STANDARDS.
5. ALL WORK SHALL BE PERFORMED IN ACCORDANCE WITH SPECIFICATIONS AND STANDARDS.
6. ALL WORK SHALL BE PERFORMED IN ACCORDANCE WITH SPECIFICATIONS AND STANDARDS.
7. ALL WORK SHALL BE PERFORMED IN ACCORDANCE WITH SPECIFICATIONS AND STANDARDS.
8. ALL WORK SHALL BE PERFORMED IN ACCORDANCE WITH SPECIFICATIONS AND STANDARDS.
9. ALL WORK SHALL BE PERFORMED IN ACCORDANCE WITH SPECIFICATIONS AND STANDARDS.
10. ALL WORK SHALL BE PERFORMED IN ACCORDANCE WITH SPECIFICATIONS AND STANDARDS.
11. LOCATIONS AND DETAILS SHOWN ON THIS DRAWING ARE BASED ON THE INFORMATION PROVIDED BY THE CLIENT AND ARE SUBJECT TO VERIFICATION BY THE CONTRACTOR.
12. MAKE SURE ALL EXISTING UTILITIES ARE PROTECTED AND NOT DAMAGED TO REMAIN.

**CONSTRUCTION NOTES**

- 1. CONSTRUCTION SHALL BE IN ACCORDANCE WITH CANADIAN STANDARDS ASSOCIATION (CSA) STANDARDS AND THE CITY OF BRAMPTON STANDARD SPECIFICATIONS FOR UNDERGROUND UTILITIES.

**SCOPE OF WORK**

- 1. INSTALLATION OF NEW HYDRO ONE TELECOMMUNICATIONS CONDUITS AND MANHOLES.
- 2. INSTALLATION OF NEW HYDRO ONE TELECOMMUNICATIONS CONDUITS AND MANHOLES.
- 3. INSTALLATION OF NEW HYDRO ONE TELECOMMUNICATIONS CONDUITS AND MANHOLES.

NOTES:  
1. THIS DRAWING IS PREPARED BASED ON THE INFORMATION PROVIDED BY THE CLIENT AND IS SUBJECT TO VERIFICATION BY THE CONTRACTOR.  
2. THE CONTRACTOR SHALL BE RESPONSIBLE FOR OBTAINING ALL NECESSARY PERMITS AND APPROVALS.  
3. THE CONTRACTOR SHALL BE RESPONSIBLE FOR PROTECTING ALL EXISTING UTILITIES AND STRUCTURES.  
4. THE CONTRACTOR SHALL BE RESPONSIBLE FOR MAINTAINING ACCESS TO ALL ADJACENT PROPERTIES AND SERVICES.  
5. THE CONTRACTOR SHALL BE RESPONSIBLE FOR CLEANING UP ALL WORK AREAS AND RESTORING THEM TO ORIGINAL CONDITION.



## Noss, Melissa

---

**From:** Keen, Stephen  
**Sent:** Monday, June 14, 2010 10:30 AM  
**To:** McLaughlin, Barry  
**Subject:** FW: Highway 50 and Mayfield Road Improvements Class EA

**Follow Up Flag:** Follow up  
**Flag Status:** Completed

---

**From:** Zia, Solmaz [<mailto:Solmaz.Zia@peelregion.ca>]  
**Sent:** Thursday, June 10, 2010 2:55 PM  
**To:** Keen, Stephen  
**Subject:** FW: Highway 50 and Mayfield Road Improvements Class EA

Steve,

fyi

**Solmaz Zia, P.Eng.**  
Project Manager  
Transportation Program Planning  
Public Works, Region of Peel  
Tel: (905) 791-7800 ext. 7845  
[Solmaz.Zia@peelregion.ca](mailto:Solmaz.Zia@peelregion.ca)

---

**From:** [Jennifer.Long@HydroOne.com](mailto:Jennifer.Long@HydroOne.com) [<mailto:Jennifer.Long@HydroOne.com>]  
**Sent:** June 4, 2010 9:17 AM  
**To:** Zia, Solmaz  
**Cc:** [ierullo@HydroOne.com](mailto:ierullo@HydroOne.com)  
**Subject:** Highway 50 and Mayfield Road Improvements Class EA

Dear Ms. Zia,

In our initial review, we can confirm that there are no Hydro One Transmission Facilities in the subject area. Please find our response form in the attachment.

Please be advised that this is only a preliminary assessment based on current information. No further consultation with Hydro One Networks Inc. is required if no changes are made to the current information.

If you have any further questions or concerns, please feel free to contact me.

Regards,

**Jen Long**  
Transmission Lines Sustainment  
System Investment, Asset Management  
**Hydro One Networks Inc.**  
Tel: 416-345-4421  
[Jennifer.Long@HydroOne.com](mailto:Jennifer.Long@HydroOne.com)

November 26, 2010  
Project No. 09-4390

Hydro One Networks Inc.  
West Central Zone 2

40 Olympic Drive  
Box 585  
Dundas, On  
L9H 7P5  
Attn, Scheduling

Re: Highway 50 from Castlemore Road/Rutherford Road to Mayfield Road/Albion  
Vaughan Road, and Mayfield Road from Hwy 50 to Coleraine Drive in the City of  
Brampton, City of Vaughan and Town of Caledon, Region of Peel and Region of York

---

Dear Sir / Madam,

The Region of Peel along with York Region is undertaking a Class C Environmental  
Assessment (EA) Study for the above noted project.

Please be advised that HDR/ iTrans is undertaking the EA including the preliminary  
design on behalf of the Municipalities of Peel and York for the identification of utility  
relocations involved with this project.

As per the EA recommendation, widening of Highway 50 and Mayfield Road to 6 and 4  
lanes respectively is proposed which requires a number of Hydro poles relocation.

We are at the third phase of the EA and the preliminary design for the noted corridor has  
been developed. We will mail 1 set of our preliminary design drawings under separate  
cover. Please review them and provide us with the existing plants along the noted road  
and your future plans for this corridor.

We request that you provide us with a preliminary estimate for the proposed relocation.

We would like to offer a meeting with you to review the conceptual relocation  
requirements. Please advise when your staff is available to meet with us.

The anticipated detailed design schedule is summer 2011 and utility relocation is 2015.

Your co-operation in providing the information required is anticipated and appreciated.

If you have any questions, do not hesitate to contact the undersigned.

---

**Public Works**

9445 Airport Road, 3<sup>rd</sup> Floor, Brampton, ON. L6S 4J3  
Telephone: 905-791-7800 / [www.peelregion.ca](http://www.peelregion.ca)

Regards,



Solmaz Zia, P.Eng.  
Project Manager  
Transportation Program Planning  
Public Works, Region of Peel  
Tel: (905) 791-7800 ext. 7845  
Fax: 905-791-1442  
[Solmaz.Zia@peelregion.ca](mailto:Solmaz.Zia@peelregion.ca)

CC: Edward Chiu, York Region  
Steve Keen, HDR/iTrans

March 15, 2011  
Project No. 09-4390

Hydro One Networks Inc.  
West Central Zone 2

40 Olympic Drive  
Box 585  
Dundas, On  
L9H 7P5  
Attn, Scheduling

Re: Highway 50 from Castlemore Road/Rutherford Road to Mayfield Road/Albion  
Vaughan Road, and Mayfield Road from Hwy 50 to Coleraine Drive in the City of  
Brampton, City of Vaughan and Town of Caledon, Region of Peel and Region of York

---

Dear Sir / Madam,

We provided, under separate cover, 1 set of plans of the above described work project, with existing utilities and anticipated conflicts based on our initial preliminary design review.

Please examine the noted plans for corrections or omissions, and conflicts with proposed construction. We also request to plot your proposed relocation and return sets of plans to Steve Keen's attention at HDR|iTrans office (144 Front Street W, Suite 655, Toronto, ON, M5H 2L7) giving existing and proposed depth of plant, where applicable.

Include in your submission, a preliminary cost estimate in order that we may establish a cost effective relocation strategy. It is anticipated the utility relocation to take place by 2014/2015.

Hydro One Brampton is notified of the utility relocation requirement.

Regards,



Solmaz Zia, P.Eng.  
Project Manager, Transportation Division

CC: Edward Chiu, York Region  
Steve Keen, HDR|iTrans  
Richard Sparham, Peel Region

---

**Public Works**

9445 Airport Road, 3<sup>rd</sup> Floor, Brampton, ON. L6S 4J3  
Telephone: 905-791-7800 / [www.peelregion.ca](http://www.peelregion.ca)



## Noss, Melissa

---

**From:** Lamontagne, Larry  
**Sent:** Monday, October 31, 2011 1:10 PM  
**To:** Baudais, Nathalie  
**Cc:** Keen, Stephen  
**Subject:** FW: Hwy 50 / Mayfield Road Utility Conflict Plan

- Utility contact tacking log has been updated as per below.
- Still waiting on Hydro One Brampton for both Hwy 50 and Sandalwood plans. I will contract Emil and see when he will be delivering his design.

LARRY LAMONTAGNE,  
DIPL. T.

**HDR Corporation**  
Sr. Transportation Designer

100 York Blvd., Suite 300 | Richmond Hill, ON L4B 1J8  
905.882.4100 x 5348  
[larry.lamontagne@hdrinc.com](mailto:larry.lamontagne@hdrinc.com) | [hdrinc.com](http://hdrinc.com)

Follow Us – Architizer | Facebook | Twitter | YouTube | Flickr

---

**From:** Telus Utility Markups [<mailto:telusutilitymarkups@prestigetel.com>]  
**Sent:** Monday, October 31, 2011 12:11 PM  
**To:** Lamontagne, Larry  
**Subject:** RE: Hwy 50 / Mayfield Road Utility Conflict Plan

TELUS has no infrastructure along the proposed route or area within a radius of 2.0m. Prestige File No. 2735545-3555.

Thanks & Regards,  
**Prathibha Parameswaran**  
MOC CAD TECH  
**Prestige Telecom Inc.**

200 Town Centre Blvd, Suite 300, Markham, Ontario L3R 8G5  
Ph: (905) 470-2112 Ext: 40257  
Fax: (905) 470-8956

Email: [telusutilitymarkups@prestigetel.com](mailto:telusutilitymarkups@prestigetel.com) ( TELUS MARKUPS )

Email: [prathibha.parameswaran@prestigetel.com](mailto:prathibha.parameswaran@prestigetel.com)



**Man has infinite power within himself & he can realise it - Swami Vivenkananda**

---

**From:** Lamontagne, Larry [<mailto:Laurent.Lamontagne@hdrinc.com>]  
**Sent:** Wednesday, October 12, 2011 2:11 PM  
**To:** Telus Utility Markups  
**Cc:** Baudais, Nathalie; Keen, Stephen  
**Subject:** Hwy 50 / Mayfield Road Utility Conflict Plan

Telus Utility Markup Personnel,

HDR requested utility conflict mark-up plans by letter and CD on July 29, 2011 for Hwy 50 and Mayfield Road and to this day we have not received the requested plans.

I have tried to contact Stephen Hoy but with no success.

I have attached PDF's of HDR's design for your reference.

Please advise on the status of our request.

Your immediate attention to this matter is greatly appreciated.

Thank you

**LARRY LAMONTAGNE,  
DIPL. T.**

**HDR Corporation**  
Sr. Transportation Designer

100 York Blvd., Suite 300 | Richmond Hill, ON L4B 1J8  
905.882.4100 x 5348  
[larry.lamontagne@hdrinc.com](mailto:larry.lamontagne@hdrinc.com) | [hdrinc.com](http://hdrinc.com)

Follow Us – Architizer | Facebook | Twitter | YouTube | Flickr